

**BCA** architecture planning interiors

200 Howard Ave.  
Fremont, California 94555  
(415) 854-1000  
(415) 854-1005


Title: DOOR MODIFICATION

Project Name: CANADA COLLEGE - BUILDINGS 5 & 6 RENOVATIONS  
SAN MATEO COUNTY COMMUNITY COLLEGE DISTRICT  
4200 FARM HILL BOULEVARD  
REDWOOD CITY, CA 94061  
FILE NO. 43-C1 APPL. 01-110074

Date: 12/20/10  
Scale: AS NOTED  
Project Number: 0703

Revision: RFP: 57

Drawing Number: ASK-27B

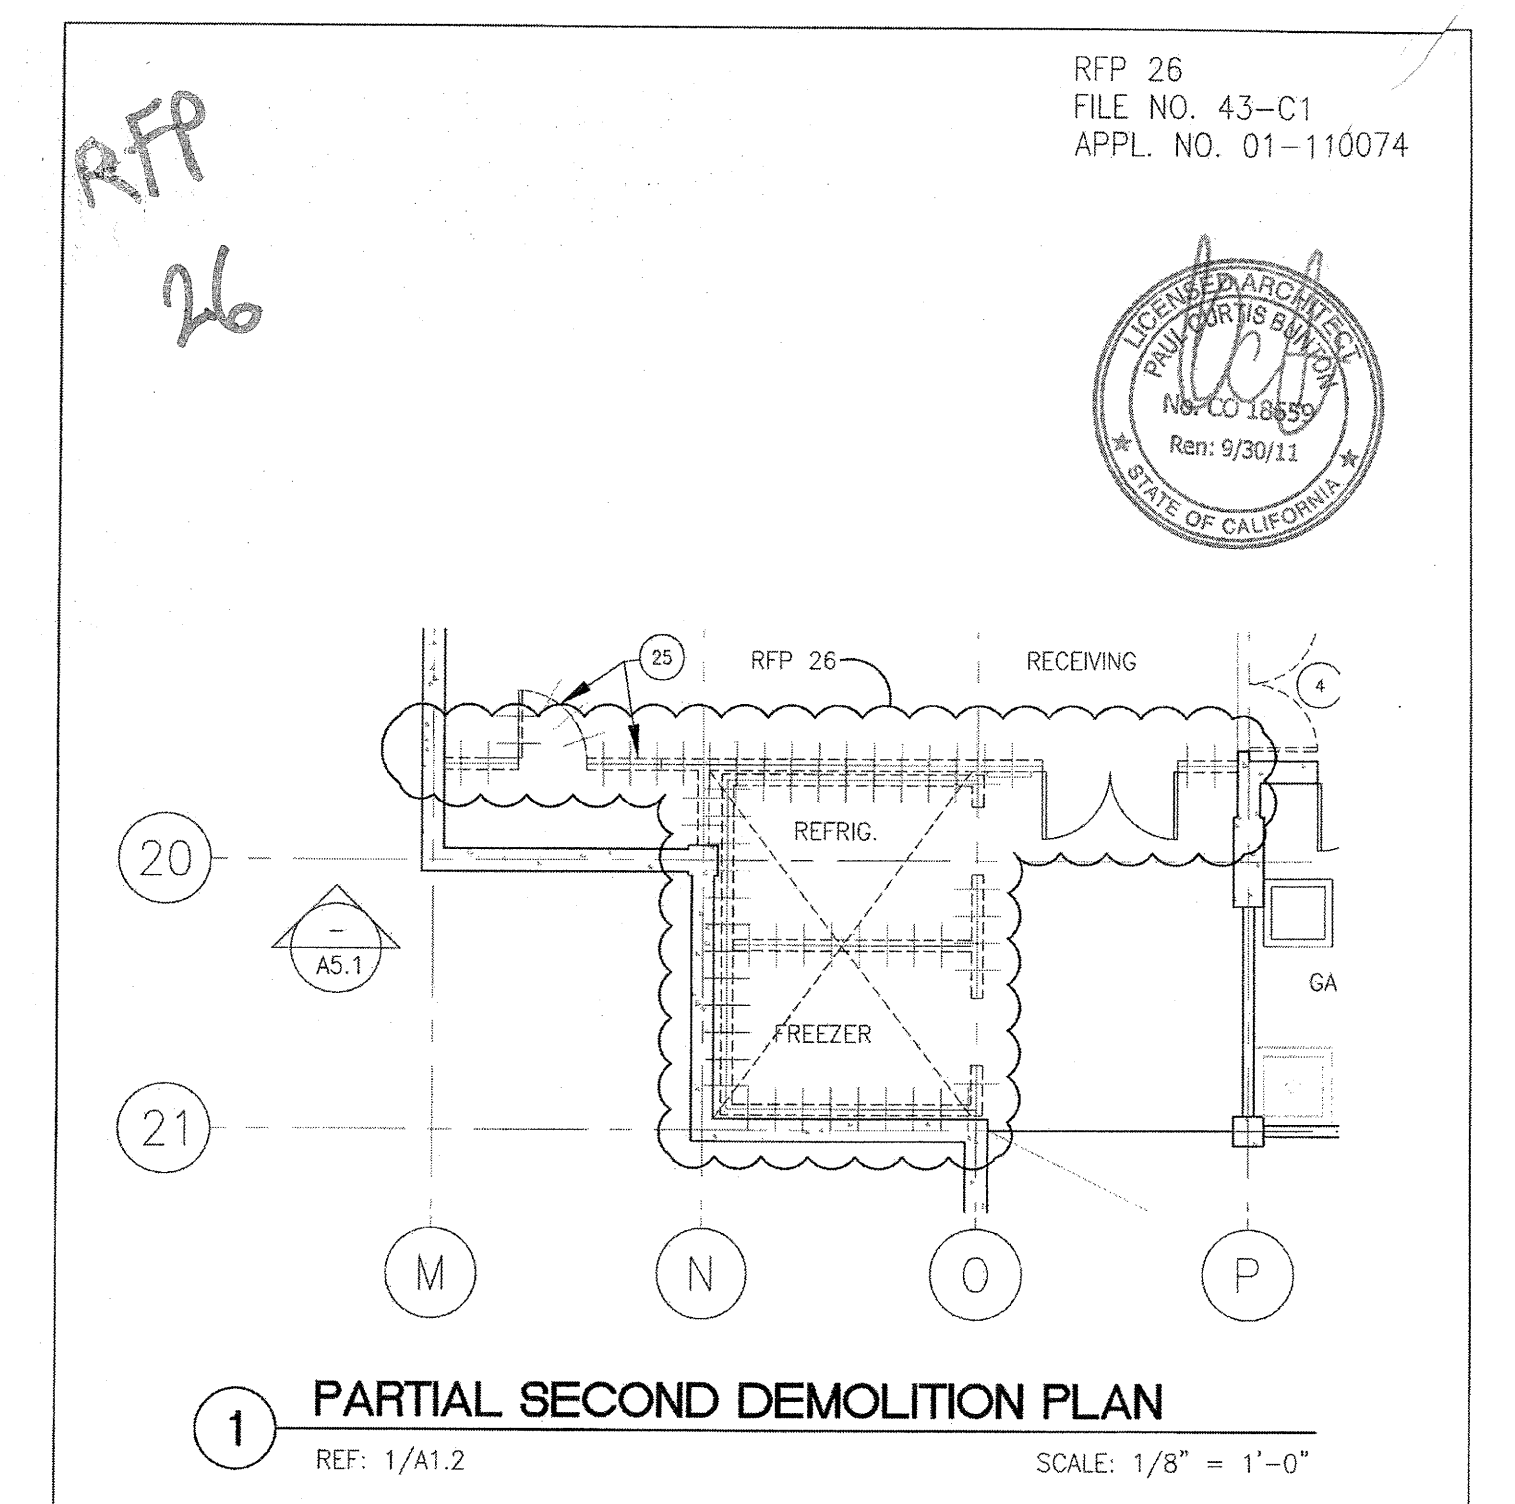

**BCA** architecture planning interiors

200 Howard Ave.  
Fremont, California 94555  
(415) 854-1000  
(415) 854-1005

Title: ELECTRICAL ROOM

Project Name: CANADA COLLEGE - BUILDINGS 5 & 6 RENOVATIONS  
SAN MATEO COUNTY COMMUNITY COLLEGE DISTRICT  
4200 FARM HILL BOULEVARD  
REDWOOD CITY, CA 94061  
FILE NO. 43-C1 APPL. 01-110074

Date: 06/29/10  
Scale: AS NOTED  
Project Number: 0703

Revision:

Drawing Number: ASK-15A