


BCA architecture planning interiors 200 S. Main St. San Mateo, California 94401 (415) 451-2800 (415) 451-2801	Project Name: CANADA COLLEGE - BUILDINGS 5 & 6 RENOVATIONS SAN MATEO COUNTY COMMUNITY COLLEGE DISTRICT 4200 FARM HILL BOULEVARD REDWOOD CITY, CA 94061 FILE NO. 43-C1 APPL. 01-110074	Date: 05/07/11 Scale: AS NOTED Project Number: 0703	Revision: RFP No.: 68 Drawing Number: ASK-32
---	--	--	--

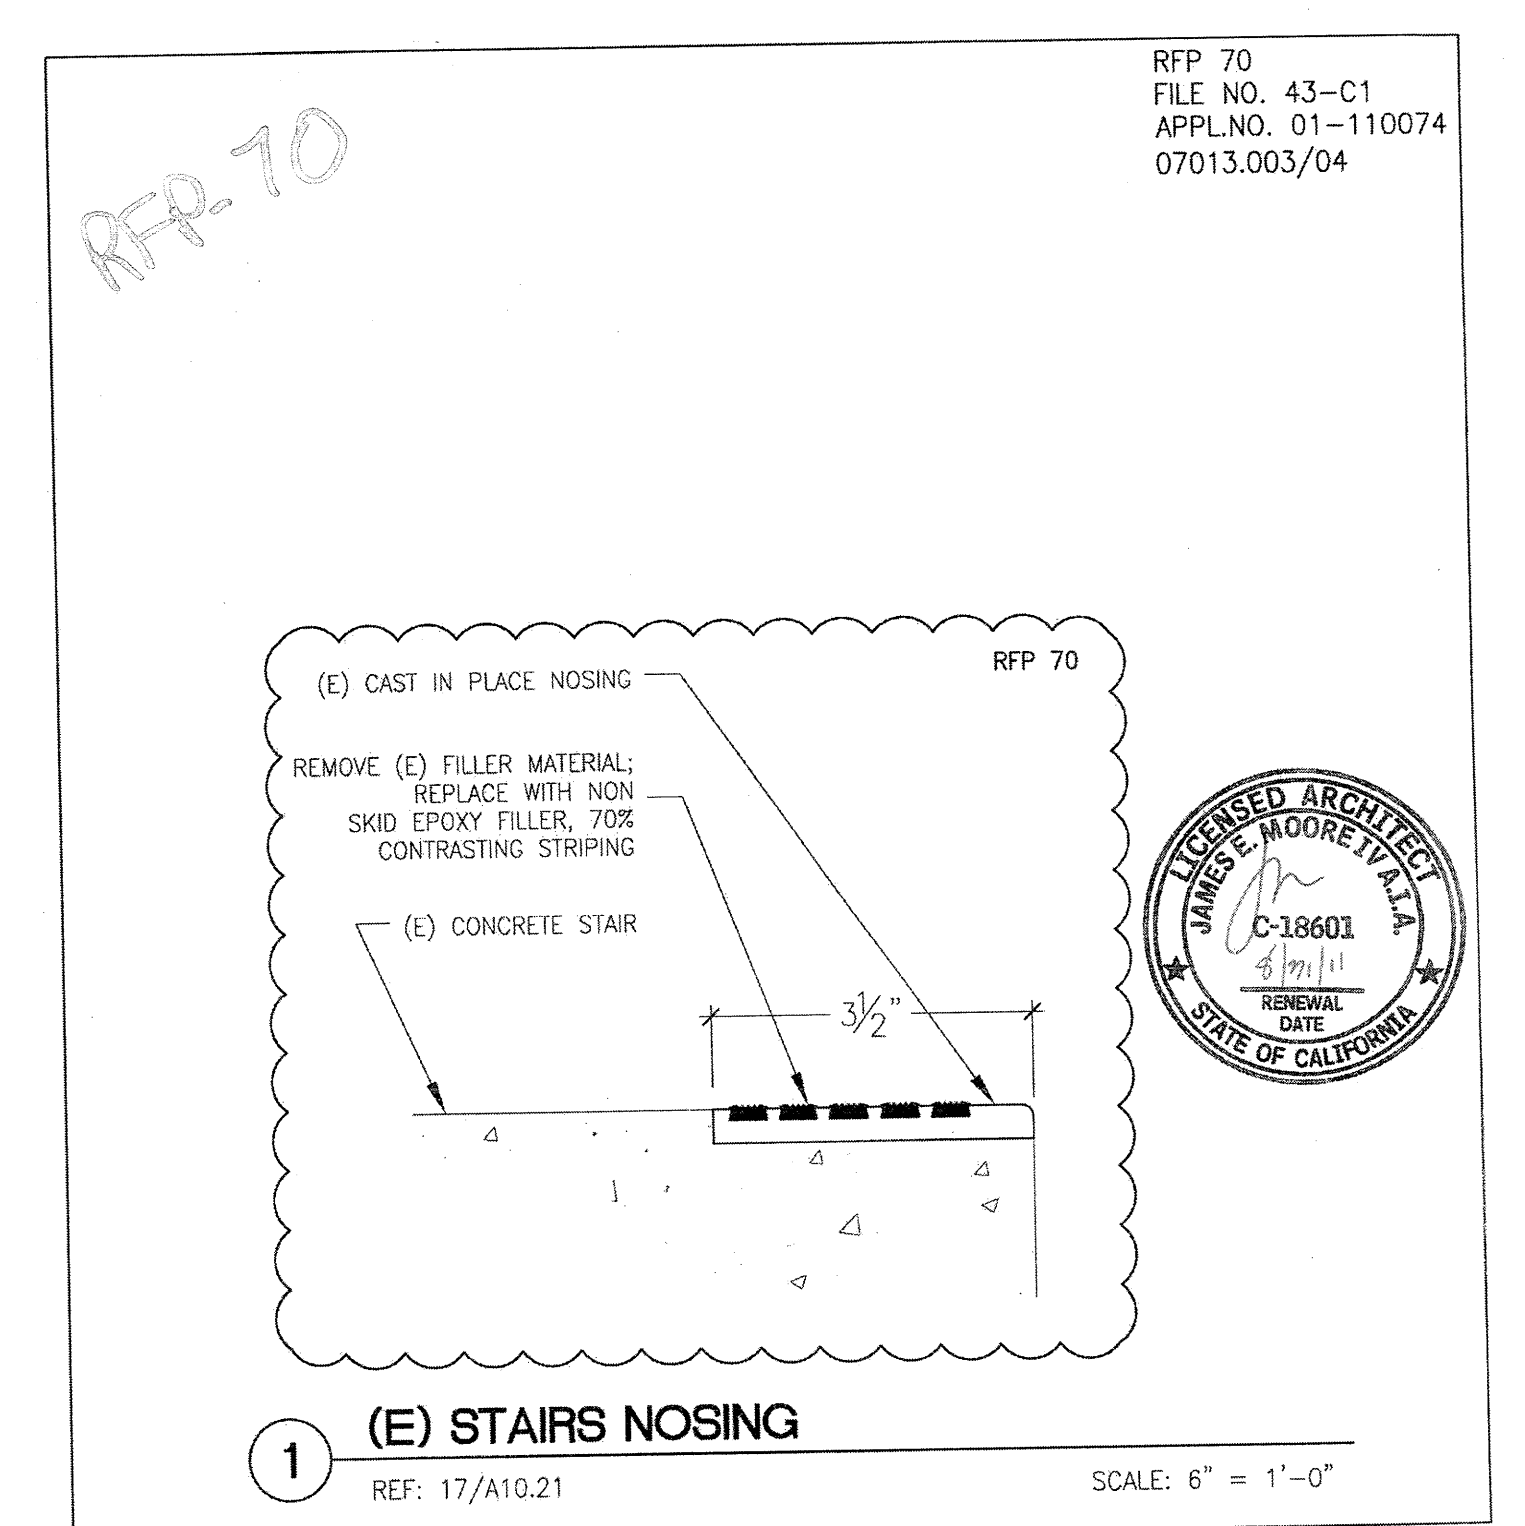

BCA architecture planning interiors 200 S. Main St. San Mateo, California 94401 (415) 451-2800 (415) 451-2801	Project Name: CANADA COLLEGE - BUILDINGS 5 & 6 RENOVATIONS SAN MATEO COUNTY COMMUNITY COLLEGE DISTRICT 4200 FARM HILL BOULEVARD REDWOOD CITY, CA 94061 FILE NO. 43-C1 APPL. 01-110074	Date: 05/11/11 Scale: AS NOTED Project Number: 0703	Revision: RFP No.: 70 Drawing Number: ASK-33
---	--	--	--