




BCA Title: DOOR & HARDWARE MODIFICATION Revision: RFP-52
 Project Name: CANADA COLLEGE - BUILDINGS 5 & 6 RENOVATIONS
 SAN MATEO COUNTY COMMUNITY COLLEGE DISTRICT
 4200 FARM HILL BOULEVARD
 REDWOOD CITY, CA 94061
 FILE NO. 43-C1 APPL. 01-110074
 Date: 08/10/10
 Scale: AS NOTED
 Project Number: 0193
 Drawing Number: ASK-24

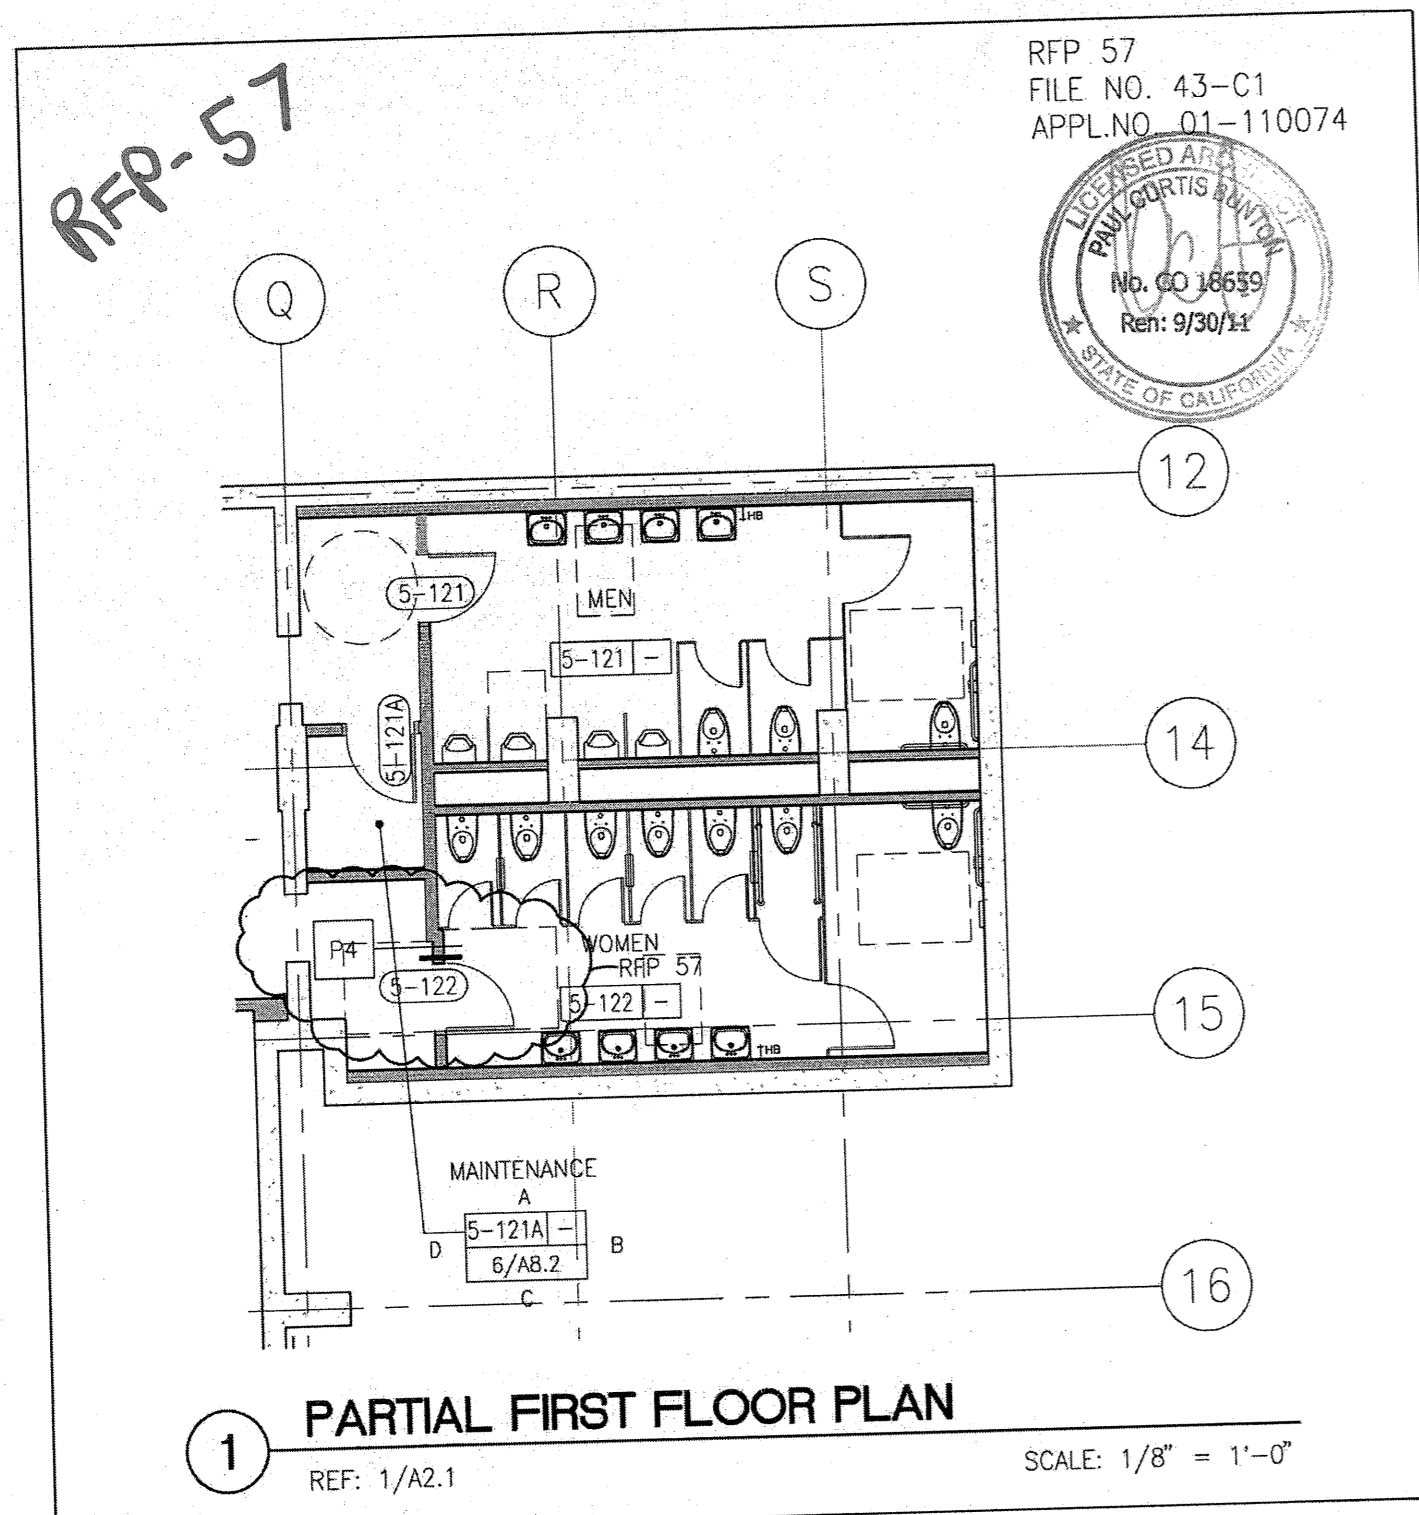


BCA Title: DOOR MODIFICATION Revision: RFP-57
 Project Name: CANADA COLLEGE - BUILDINGS 5 & 6 RENOVATIONS
 SAN MATEO COUNTY COMMUNITY COLLEGE DISTRICT
 4200 FARM HILL BOULEVARD
 REDWOOD CITY, CA 94061
 FILE NO. 43-C1 APPL. 01-110074
 Date: 08/10/10
 Scale: AS NOTED
 Project Number: 0193
 Drawing Number: ASK-27C

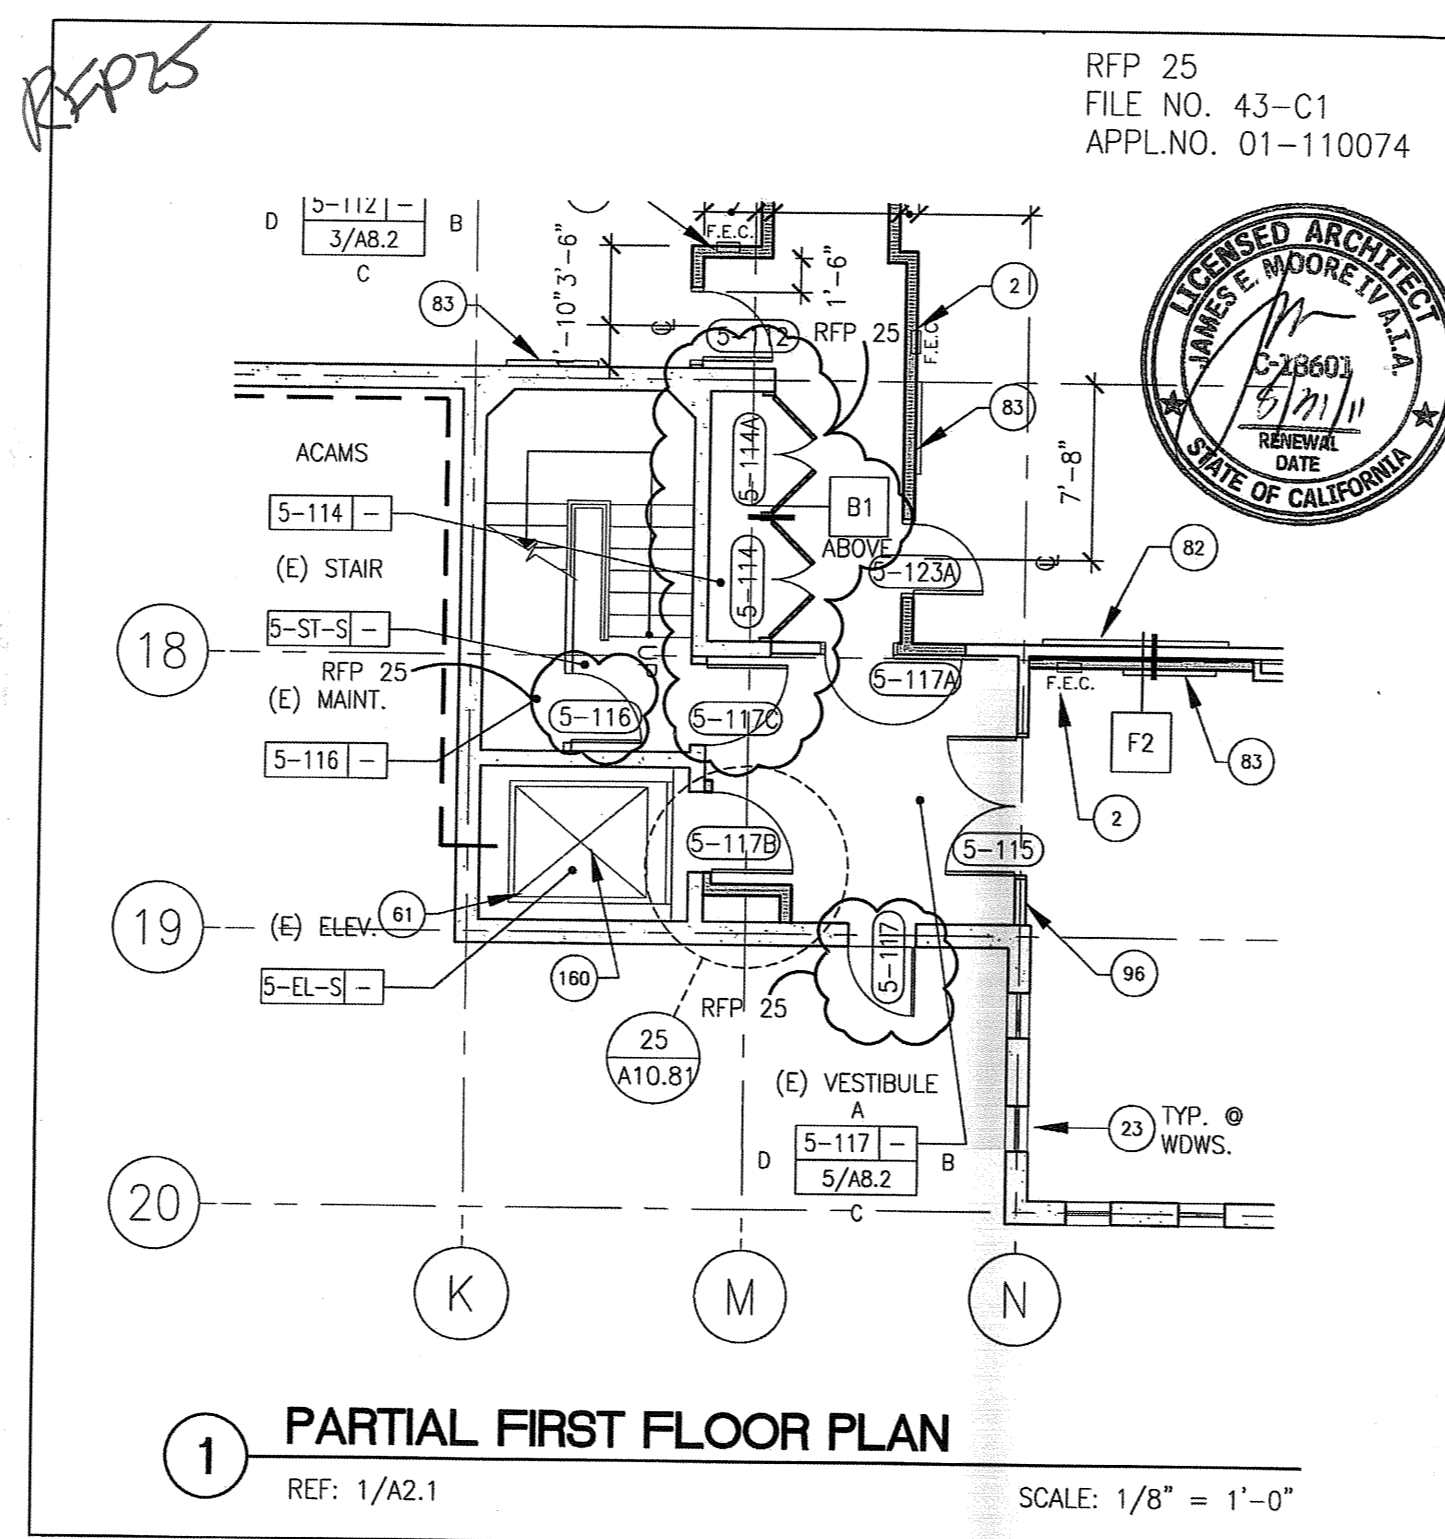


BCA Title: NEW DOORS Revision: RFP-25
 Project Name: CANADA COLLEGE - BUILDINGS 5 & 6 RENOVATIONS
 SAN MATEO COUNTY COMMUNITY COLLEGE DISTRICT
 4200 FARM HILL BOULEVARD
 REDWOOD CITY, CA 94061
 FILE NO. 43-C1 APPL. 01-110074
 Date: 08/10/10
 Scale: AS NOTED
 Project Number: 0193
 Drawing Number: ASK-14D

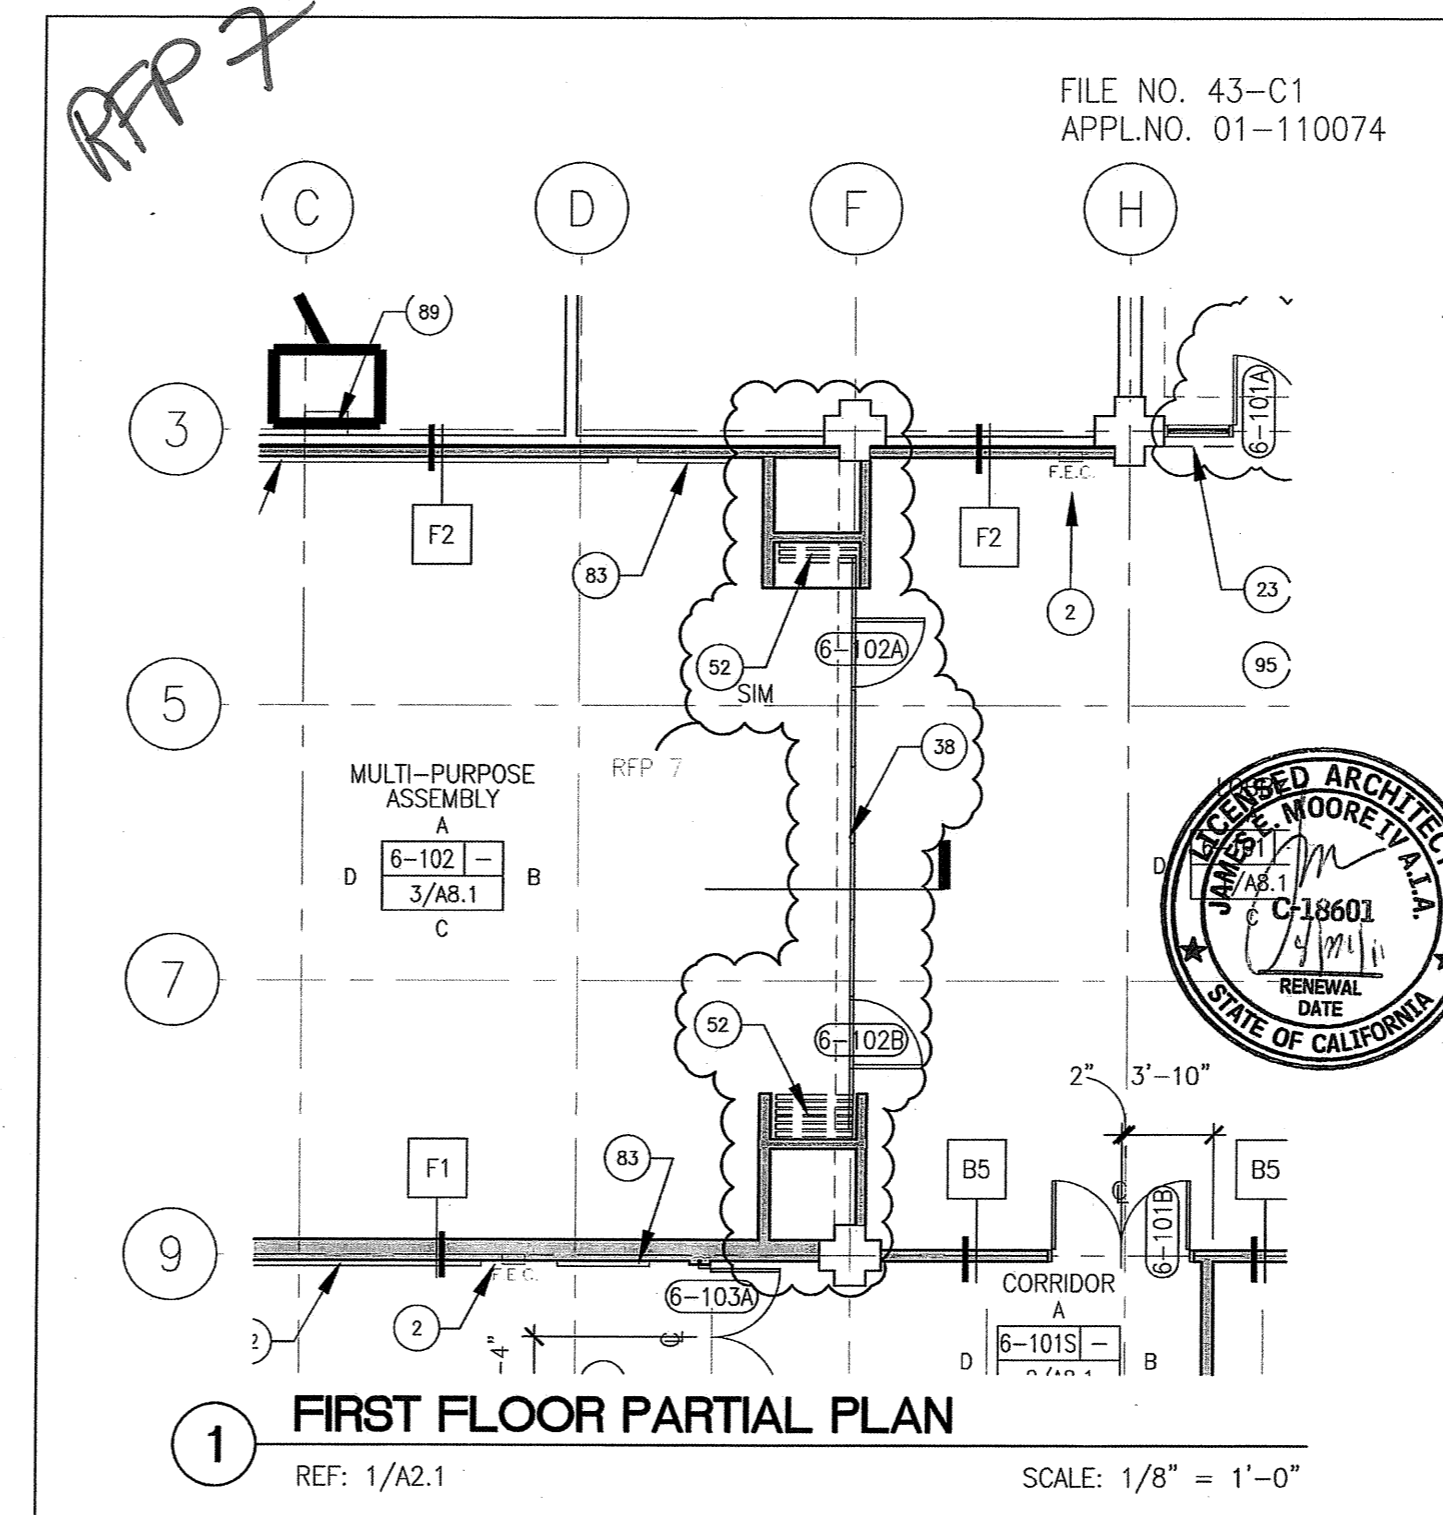


BCA Title: MECHANICAL CHASE WALLS Revision: RFP-7
 Project Name: CANADA COLLEGE - BUILDINGS 5 & 6 RENOVATIONS
 SAN MATEO COUNTY COMMUNITY COLLEGE DISTRICT
 4200 FARM HILL BOULEVARD
 REDWOOD CITY, CA 94061
 FILE NO. 43-C1 APPL. 01-110074
 Date: 08/10/10
 Scale: AS NOTED
 Project Number: 0193
 Drawing Number: ASK-02

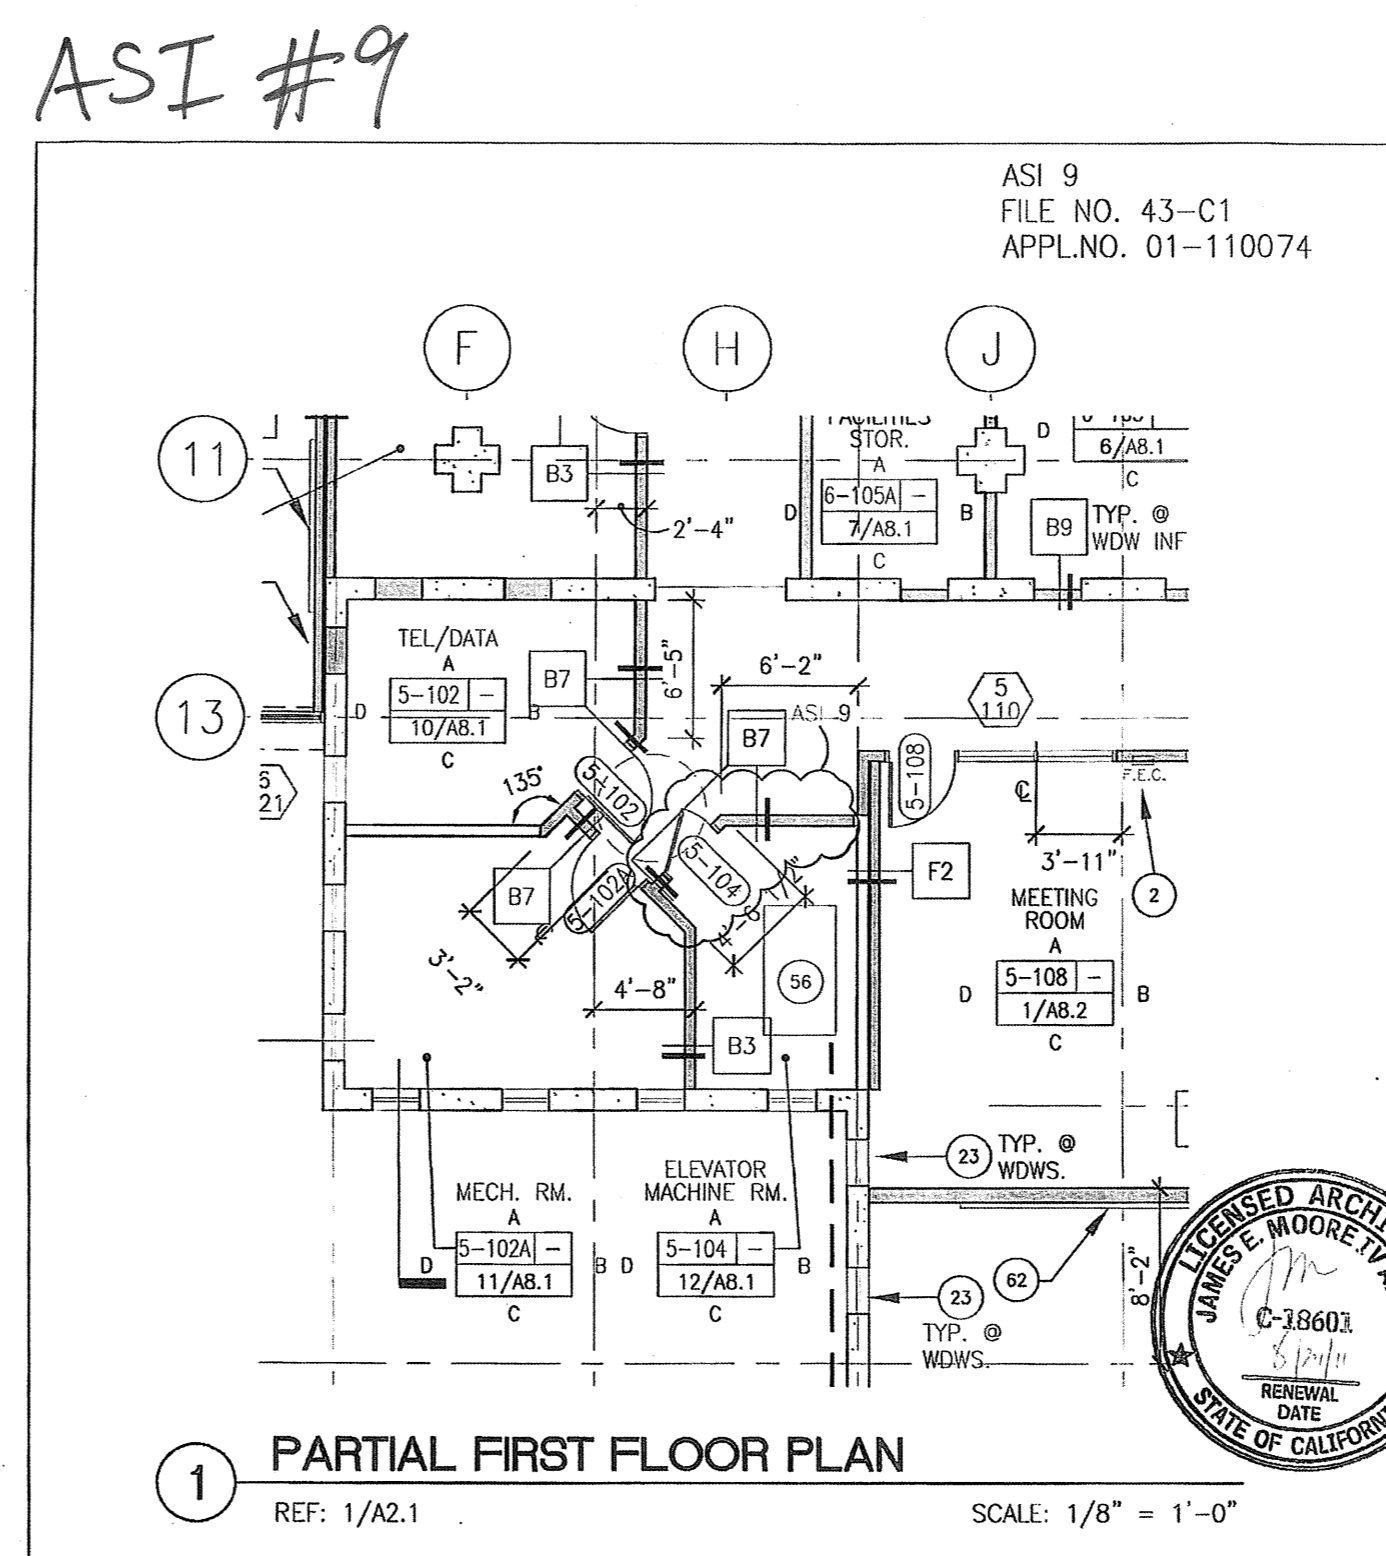

BCA Title: DOOR AT ELEVATOR EQUIPMENT ROOM Revision: ASI #9
 Project Name: CANADA COLLEGE - BUILDINGS 5 & 6 RENOVATIONS
 SAN MATEO COUNTY COMMUNITY COLLEGE DISTRICT
 4200 FARM HILL BOULEVARD
 REDWOOD CITY, CA 94061
 FILE NO. 43-C1 APPL. 01-110074
 Date: 08/10/10
 Scale: AS NOTED
 Project Number: 0193
 Drawing Number: ASK-03

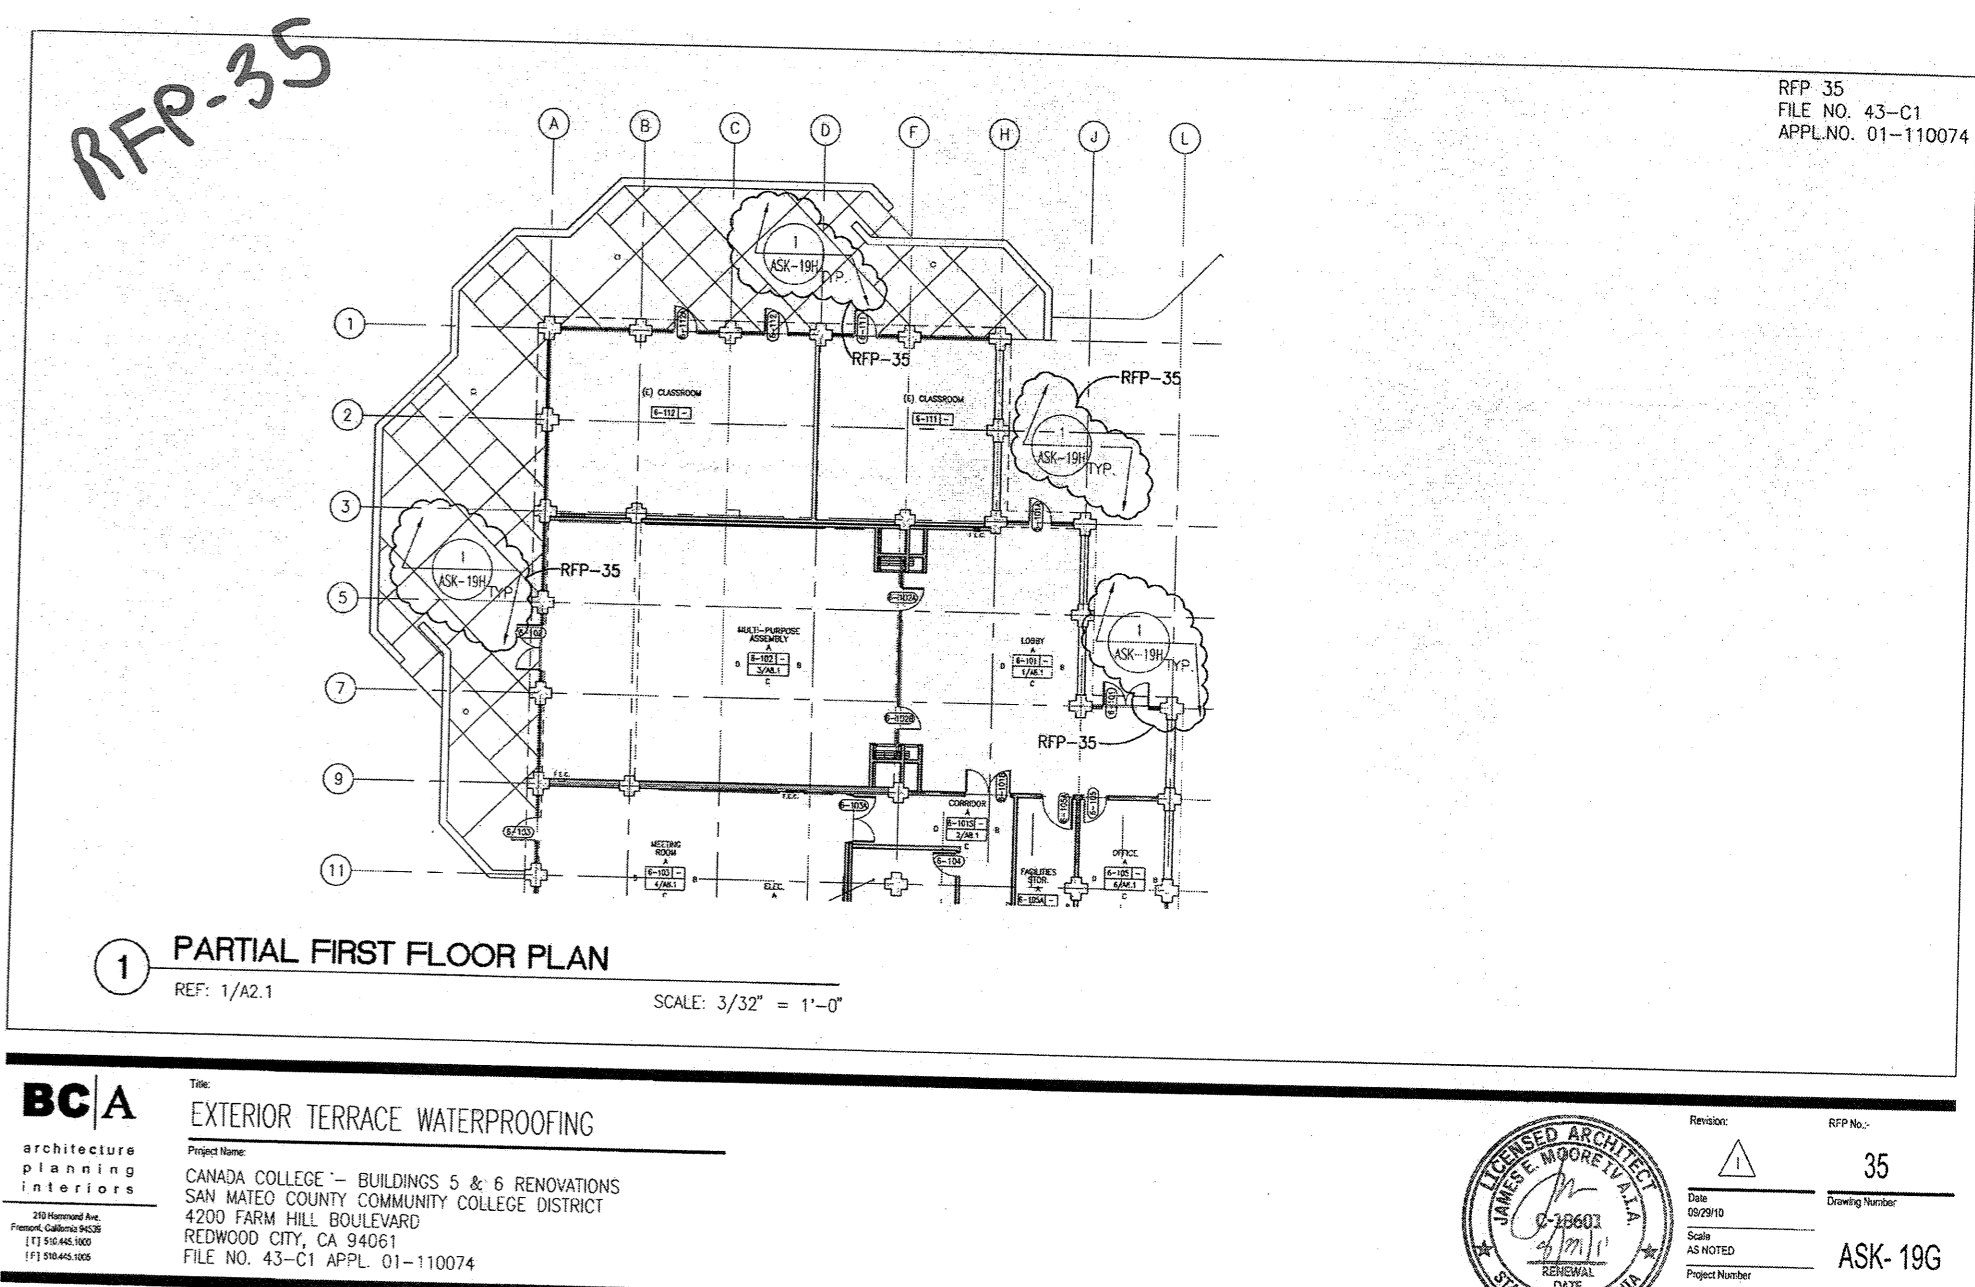

BCA Title: EXTERIOR TERRACE WATERPROOFING Revision: RFP-35
 Project Name: CANADA COLLEGE - BUILDINGS 5 & 6 RENOVATIONS
 SAN MATEO COUNTY COMMUNITY COLLEGE DISTRICT
 4200 FARM HILL BOULEVARD
 REDWOOD CITY, CA 94061
 FILE NO. 43-C1 APPL. 01-110074
 Scale: AS NOTED
 Project Number: 0193
 Drawing Number: ASK-19G

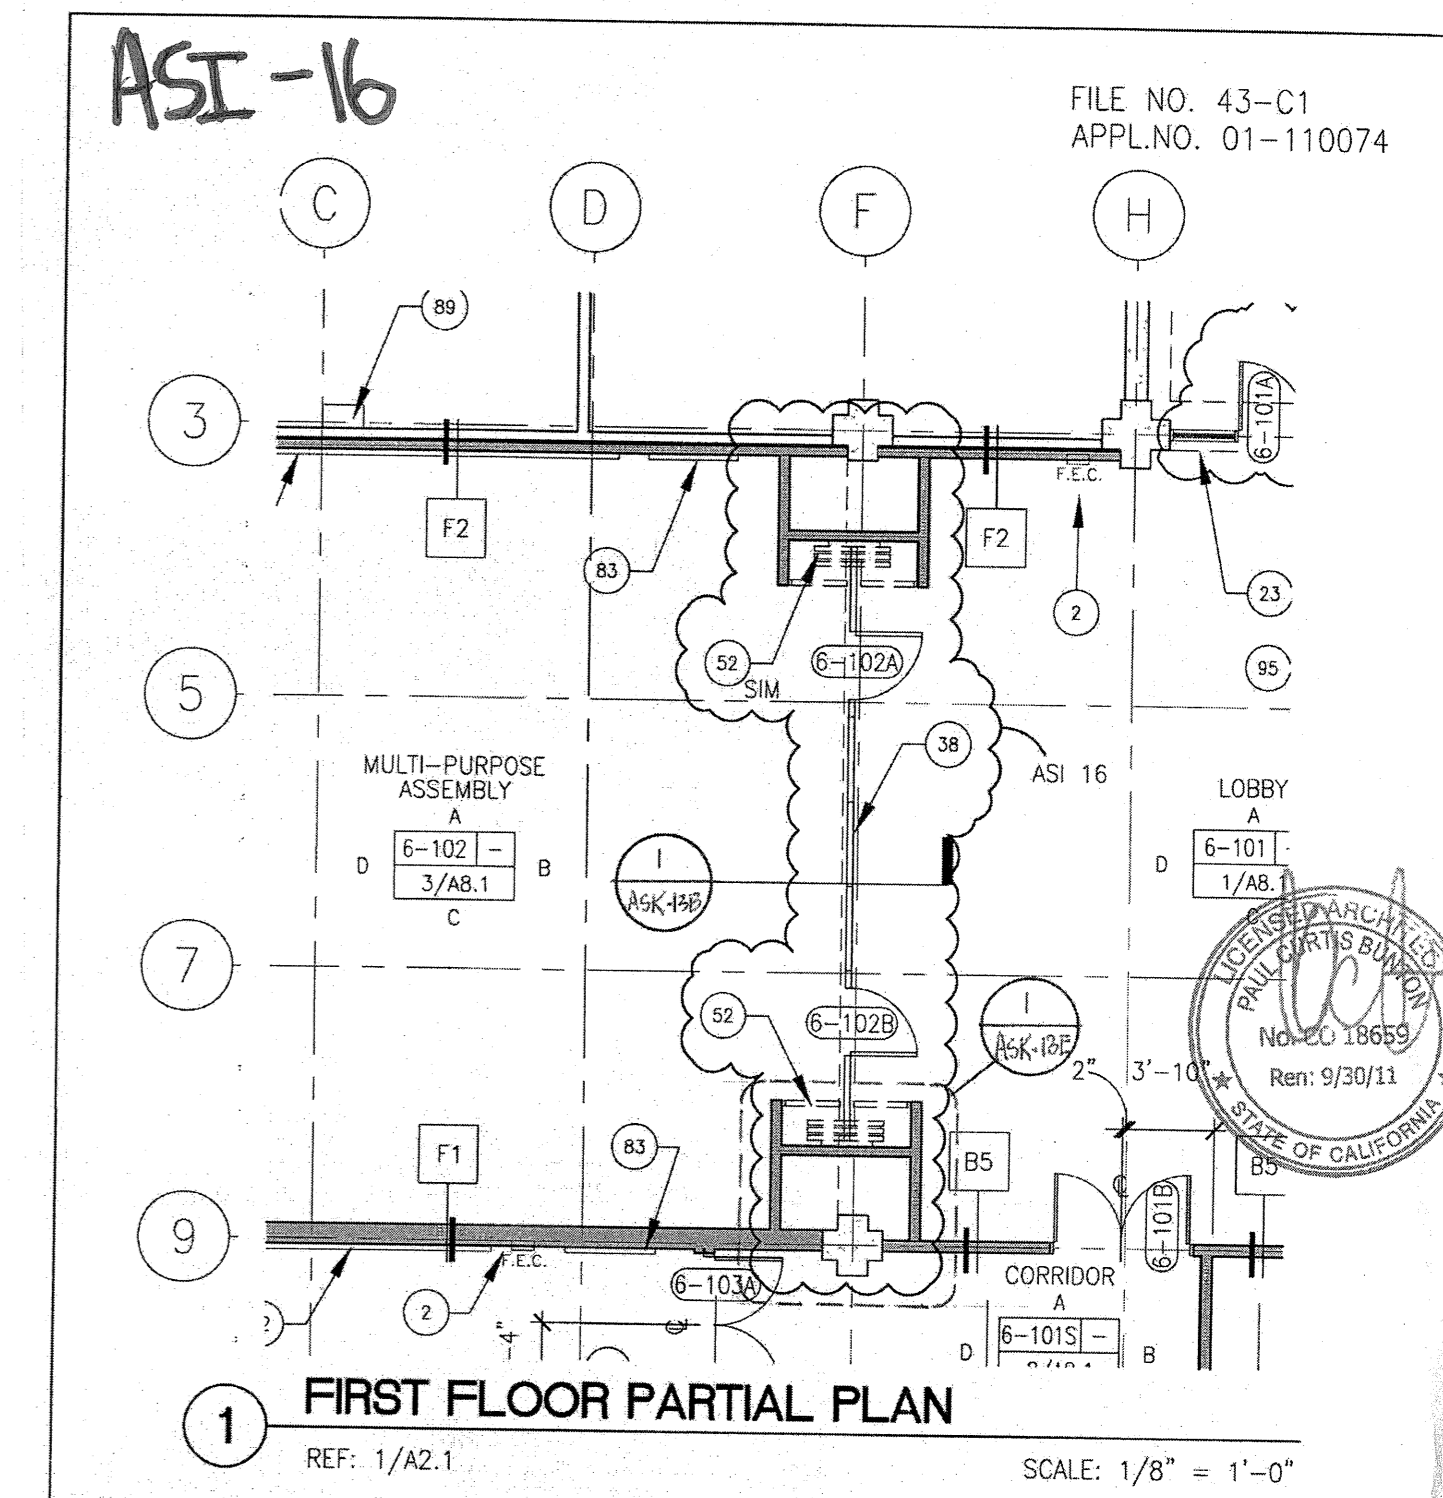

BCA Title: FOLDING PARTITION LAYOUT Revision: ASI-16
 Project Name: CANADA COLLEGE - BUILDINGS 5 & 6 RENOVATIONS
 SAN MATEO COUNTY COMMUNITY COLLEGE DISTRICT
 4200 FARM HILL BOULEVARD
 REDWOOD CITY, CA 94061
 FILE NO. 43-C1 APPL. 01-110074
 Date: 08/10/10
 Scale: AS NOTED
 Project Number: 0193
 Drawing Number: ASK-13A