



**BCA** architecture planning interiors  
 Project Name: MECHANICAL ROOM WALL - 2ND FLOOR  
 Client: CANADA COLLEGE - BUILDINGS 5 & 6 RENOVATIONS  
 SAN MATEO COUNTRY COMMUNITY COLLEGE DISTRICT  
 4200 FARM HILL BOULEVARD  
 REDWOOD CITY, CA 94061  
 FILE NO. 43-C1 APPL. 01-110074

Scale: AS NOTED  
 Date: 08/20/10  
 Project Number: 0203  
 Drawing Number: ASK-7

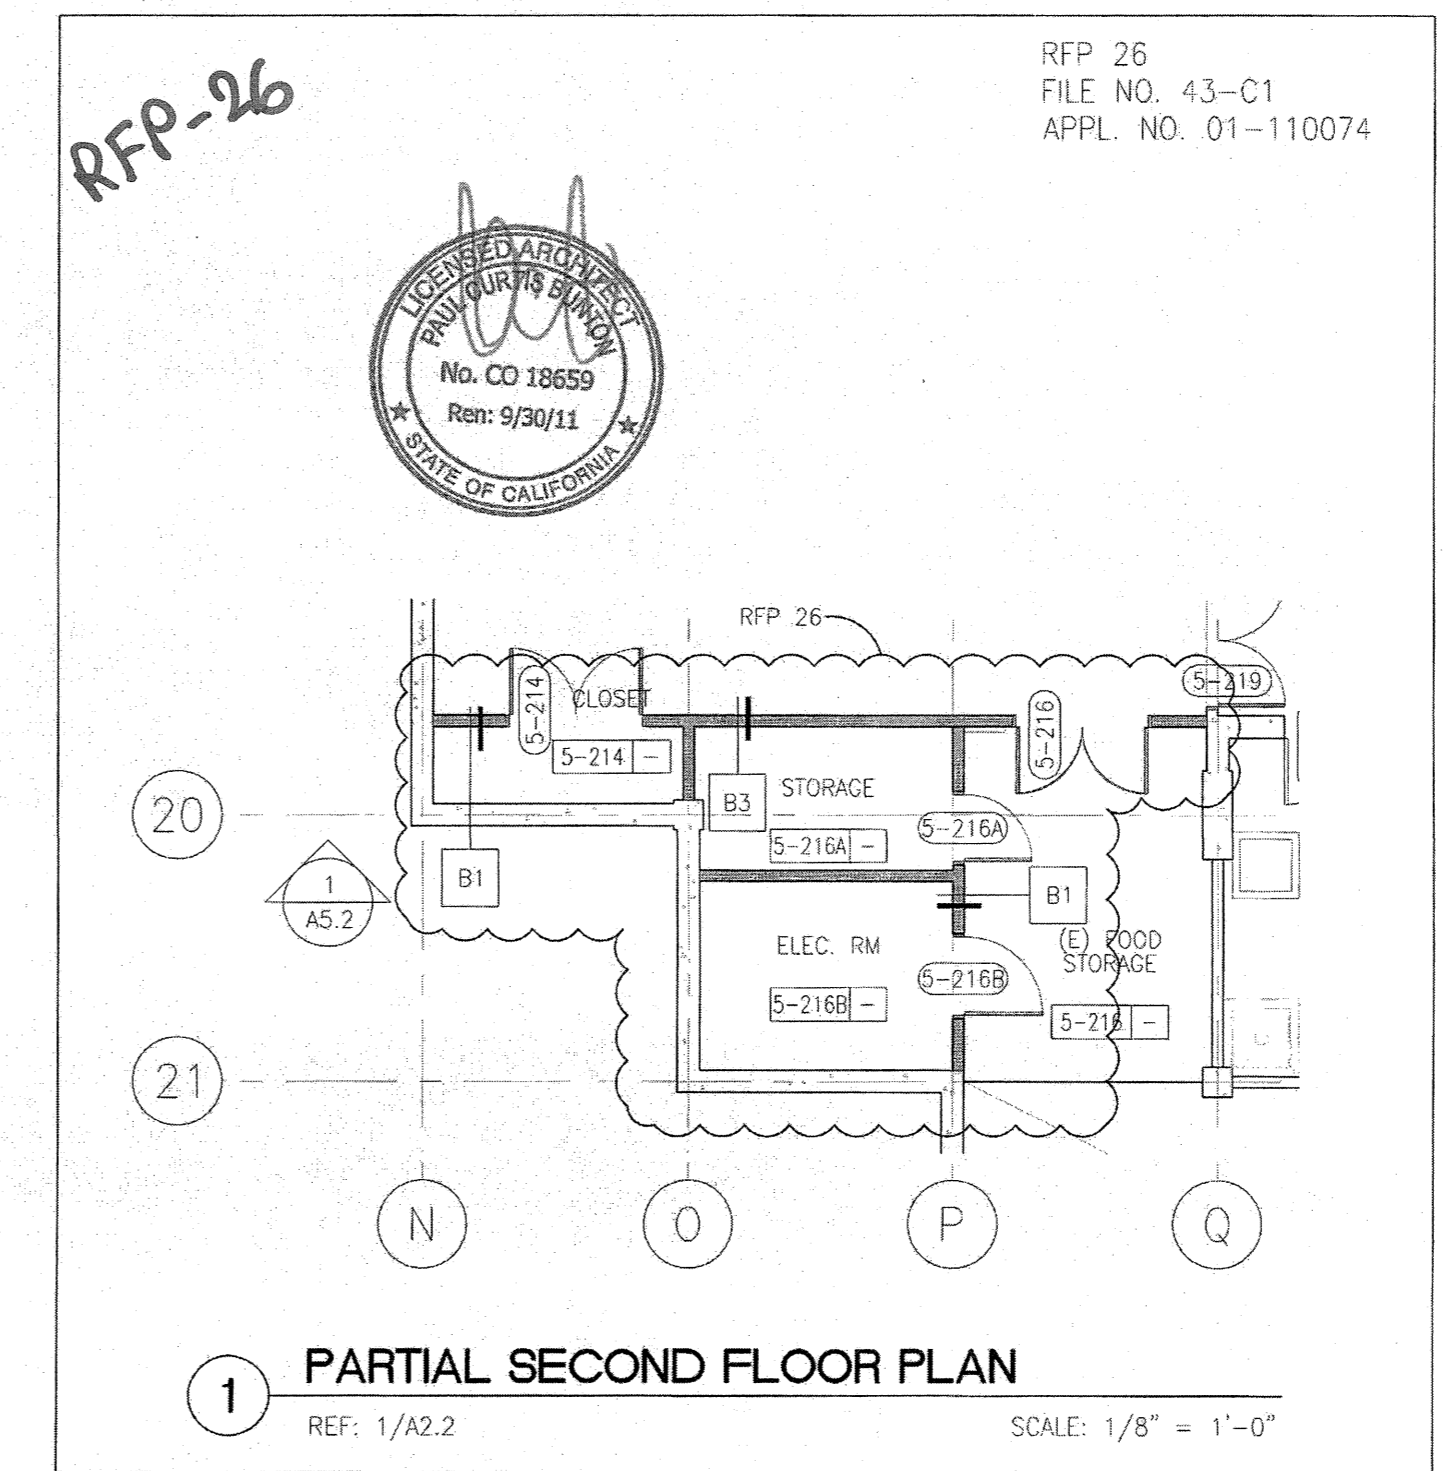


**BCA** architecture planning interiors  
 Project Name: ELECTRICAL ROOM  
 Client: CANADA COLLEGE - BUILDINGS 5 & 6 RENOVATIONS  
 SAN MATEO COUNTRY COMMUNITY COLLEGE DISTRICT  
 4200 FARM HILL BOULEVARD  
 REDWOOD CITY, CA 94061  
 FILE NO. 43-C1 APPL. 01-110074

Scale: AS NOTED  
 Date: 08/20/10  
 Project Number: 0203  
 Drawing Number: ASK-15B

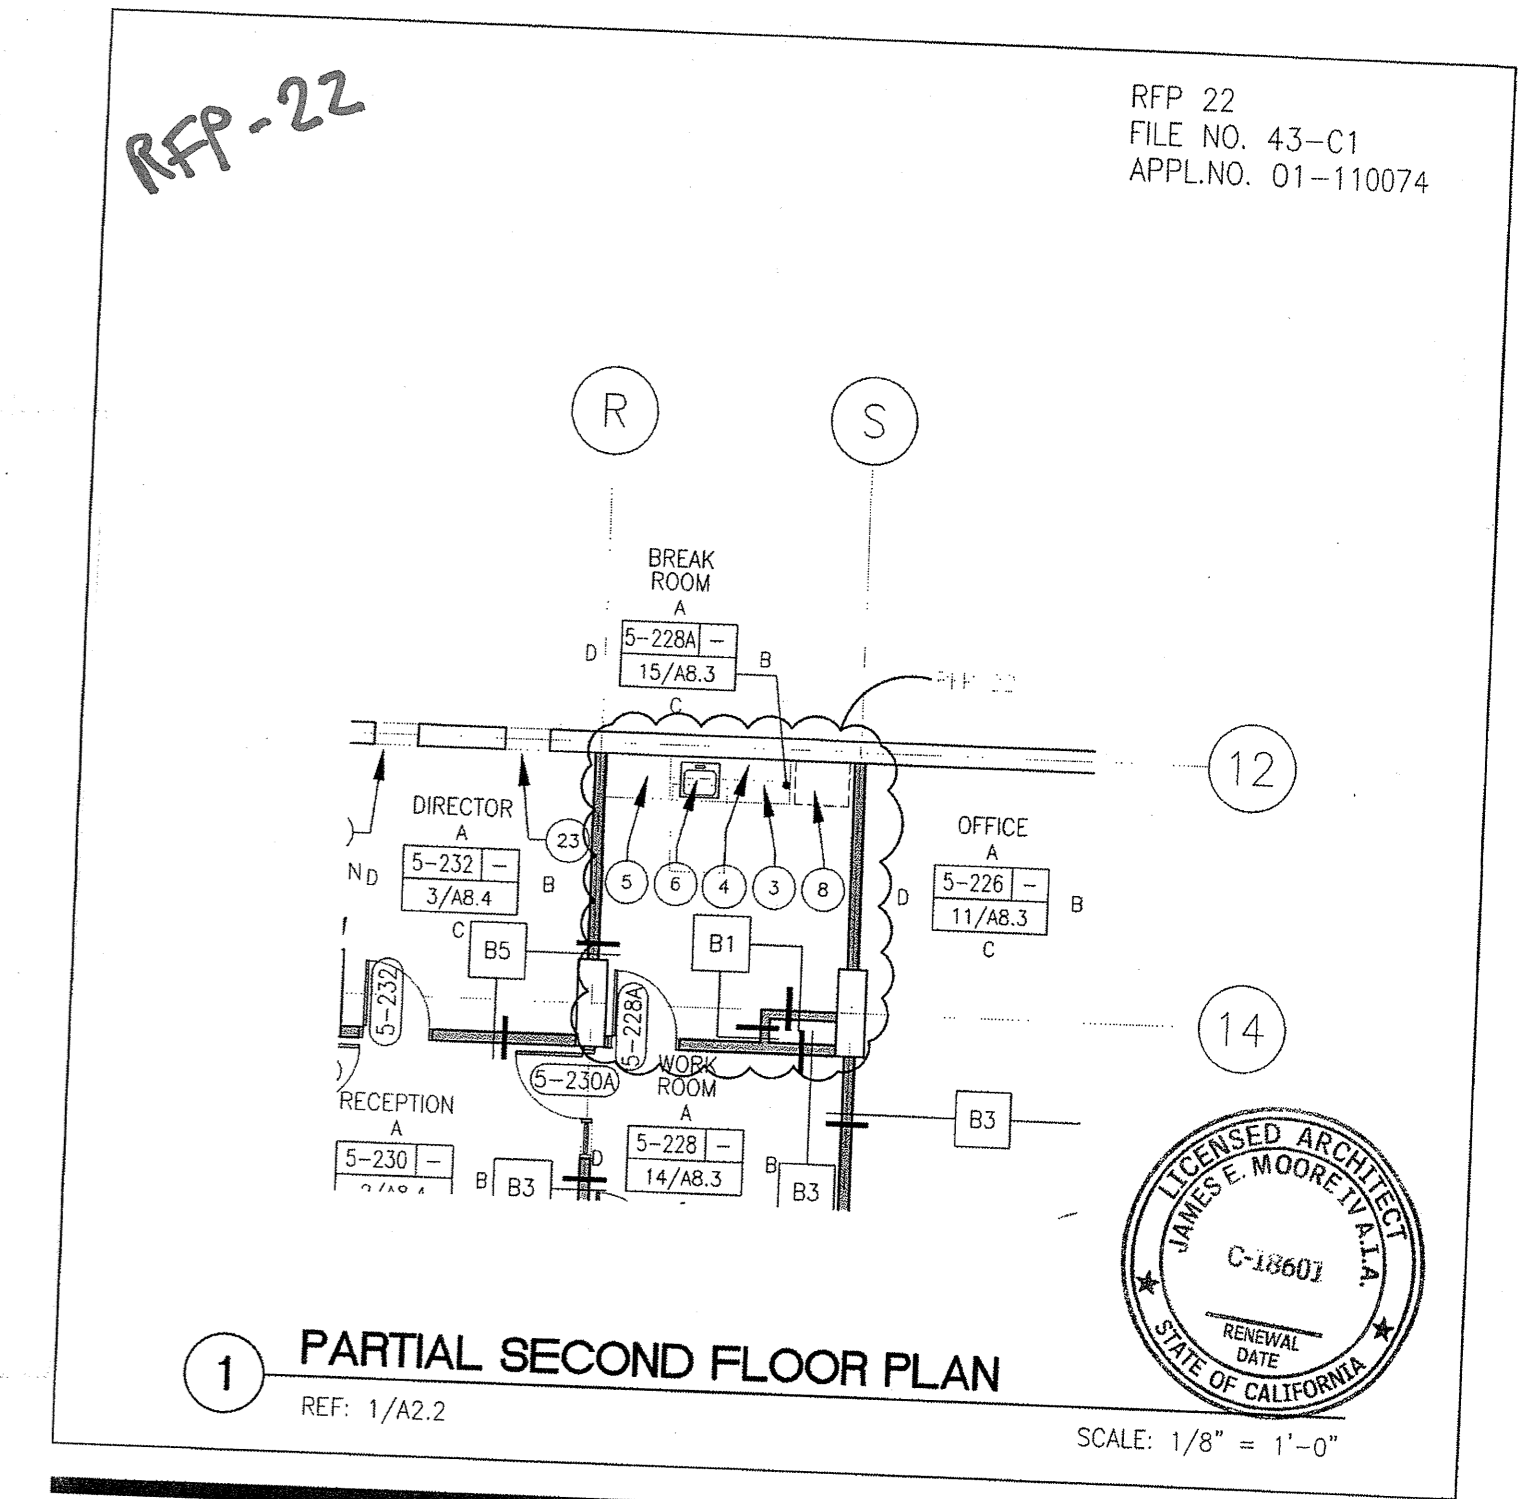


**BCA** architecture planning interiors  
 Project Name: BREAK ROOM - 2ND FLOOR  
 Client: CANADA COLLEGE - BUILDINGS 5 & 6 RENOVATIONS  
 SAN MATEO COUNTRY COMMUNITY COLLEGE DISTRICT  
 4200 FARM HILL BOULEVARD  
 REDWOOD CITY, CA 94061  
 FILE NO. 43-C1 APPL. 01-110074

Scale: AS NOTED  
 Date: 08/20/10  
 Project Number: 0203  
 Drawing Number: RFP 22 116

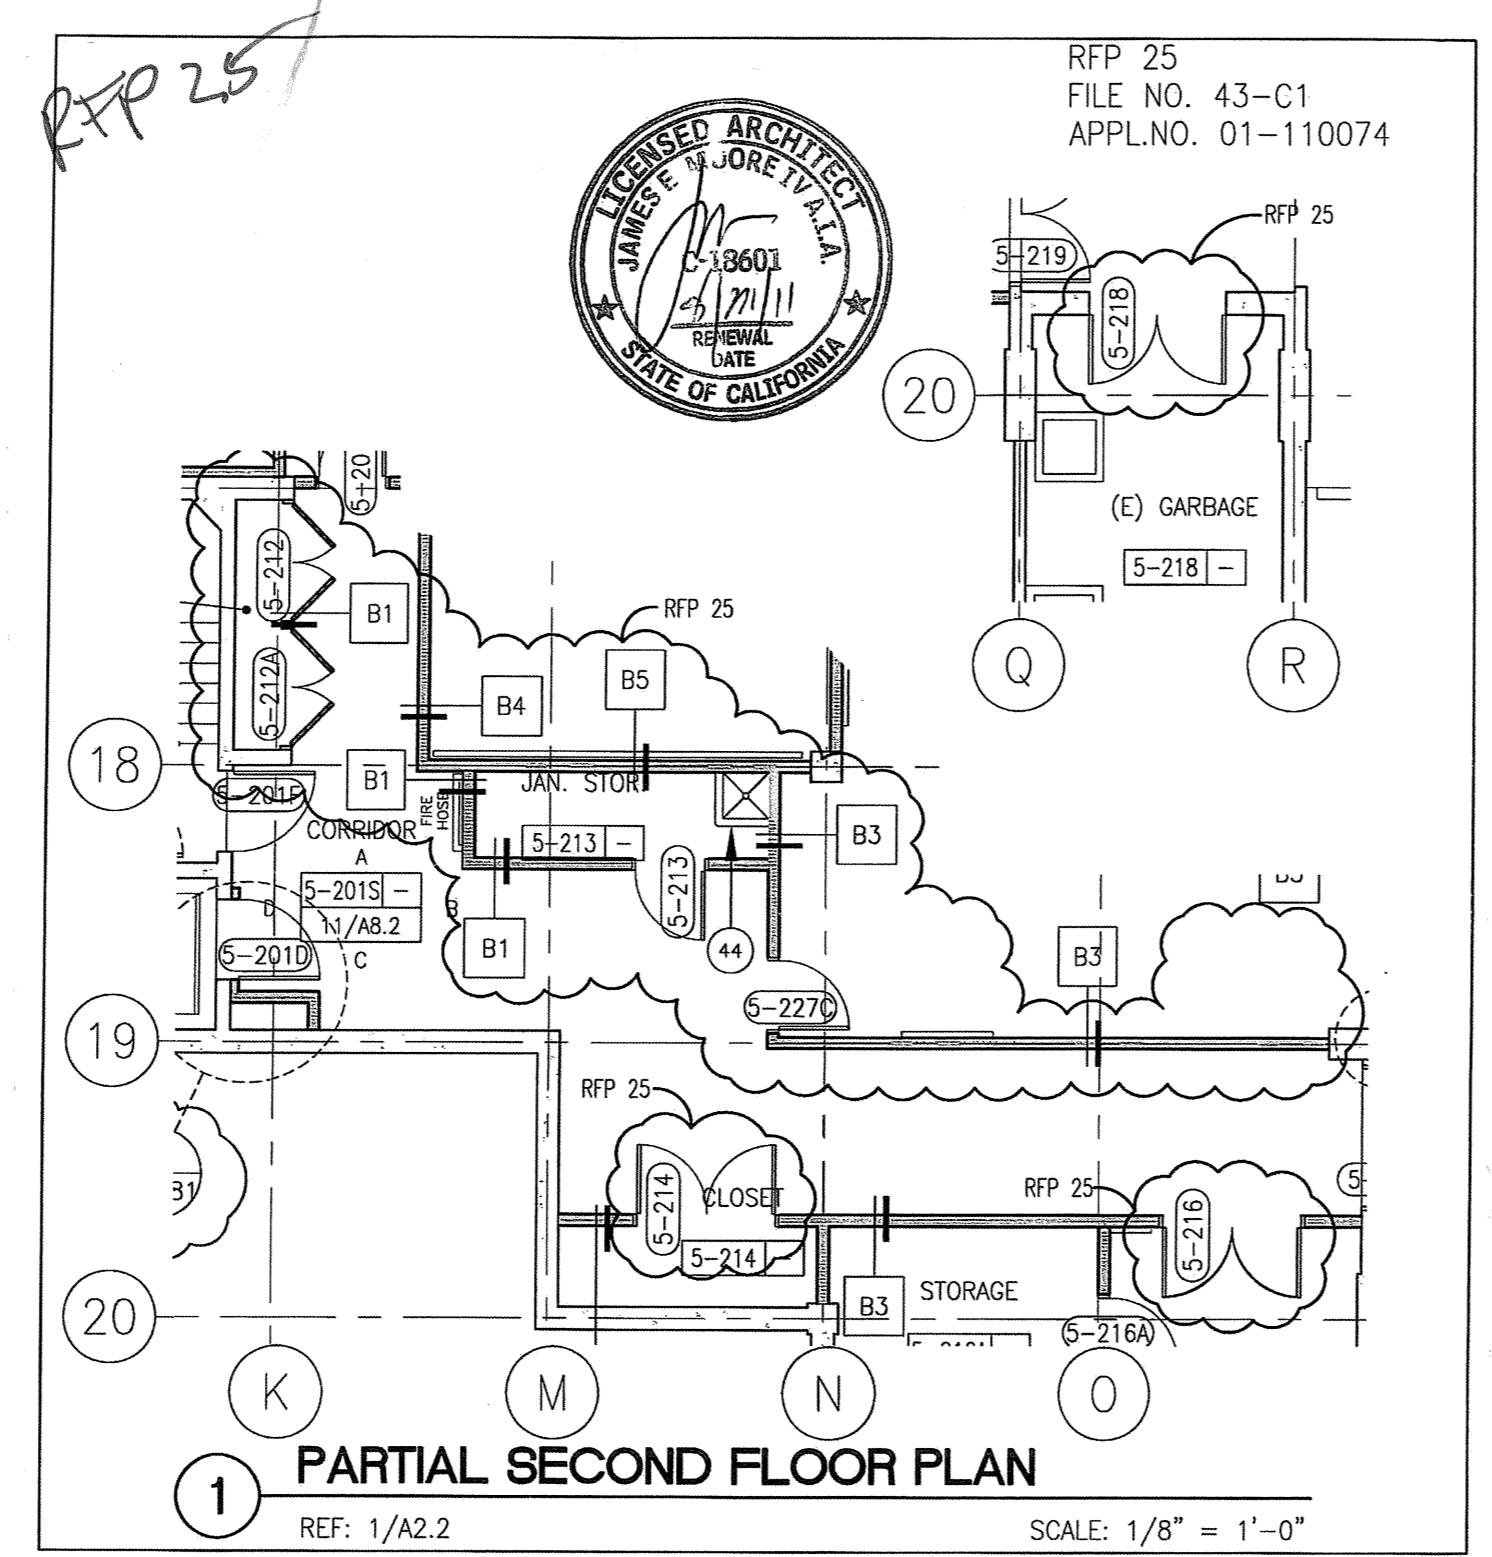


**BCA** architecture planning interiors  
 Project Name: NEW DOORS  
 Client: CANADA COLLEGE - BUILDINGS 5 & 6 RENOVATIONS  
 SAN MATEO COUNTRY COMMUNITY COLLEGE DISTRICT  
 4200 FARM HILL BOULEVARD  
 REDWOOD CITY, CA 94061  
 FILE NO. 43-C1 APPL. 01-110074

Scale: AS NOTED  
 Date: 08/20/10  
 Project Number: 0203  
 Drawing Number: 25

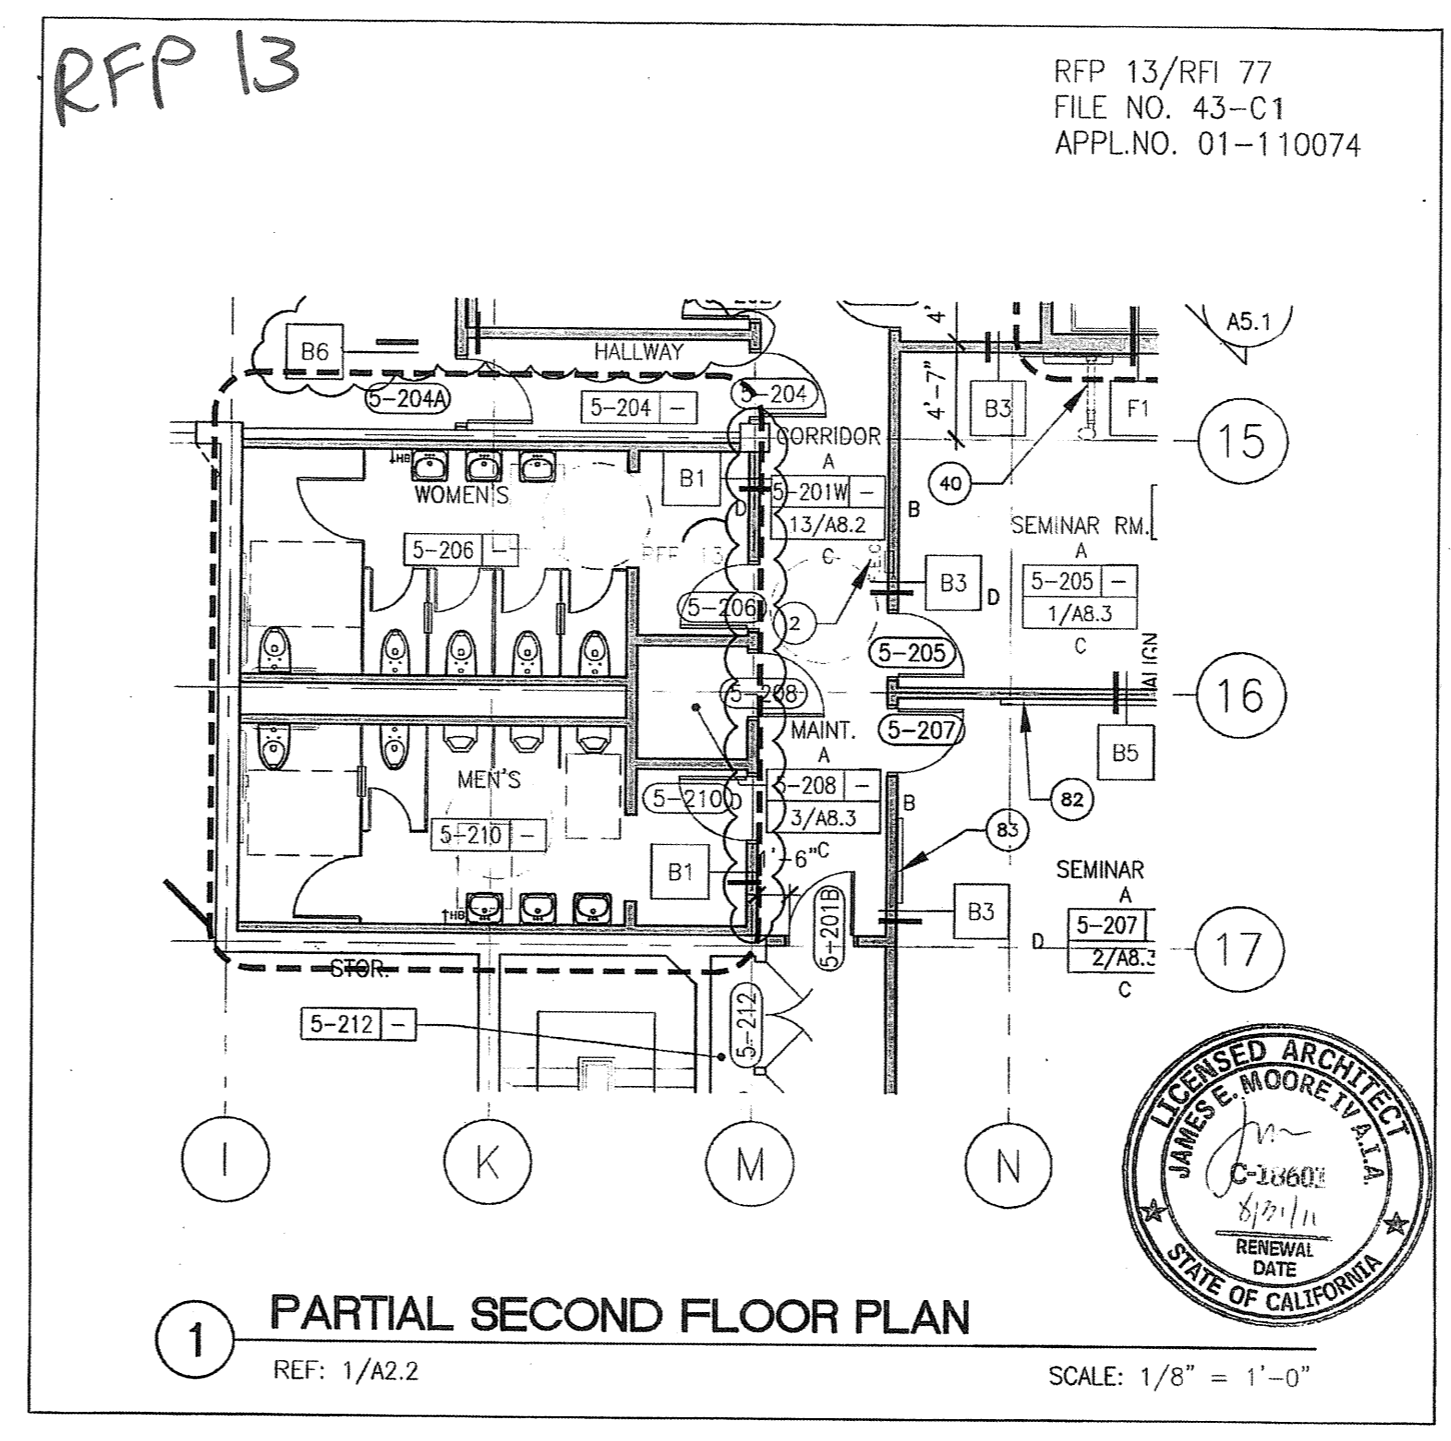

**BCA** architecture planning interiors  
 Project Name: RESTROOMS WALL  
 Client: CANADA COLLEGE - BUILDINGS 5 & 6 RENOVATIONS  
 SAN MATEO COUNTRY COMMUNITY COLLEGE DISTRICT  
 4200 FARM HILL BOULEVARD  
 REDWOOD CITY, CA 94061  
 FILE NO. 43-C1 APPL. 01-110074


Scale: AS NOTED  
 Date: 08/20/10  
 Project Number: 0203  
 Drawing Number: ASK-5B

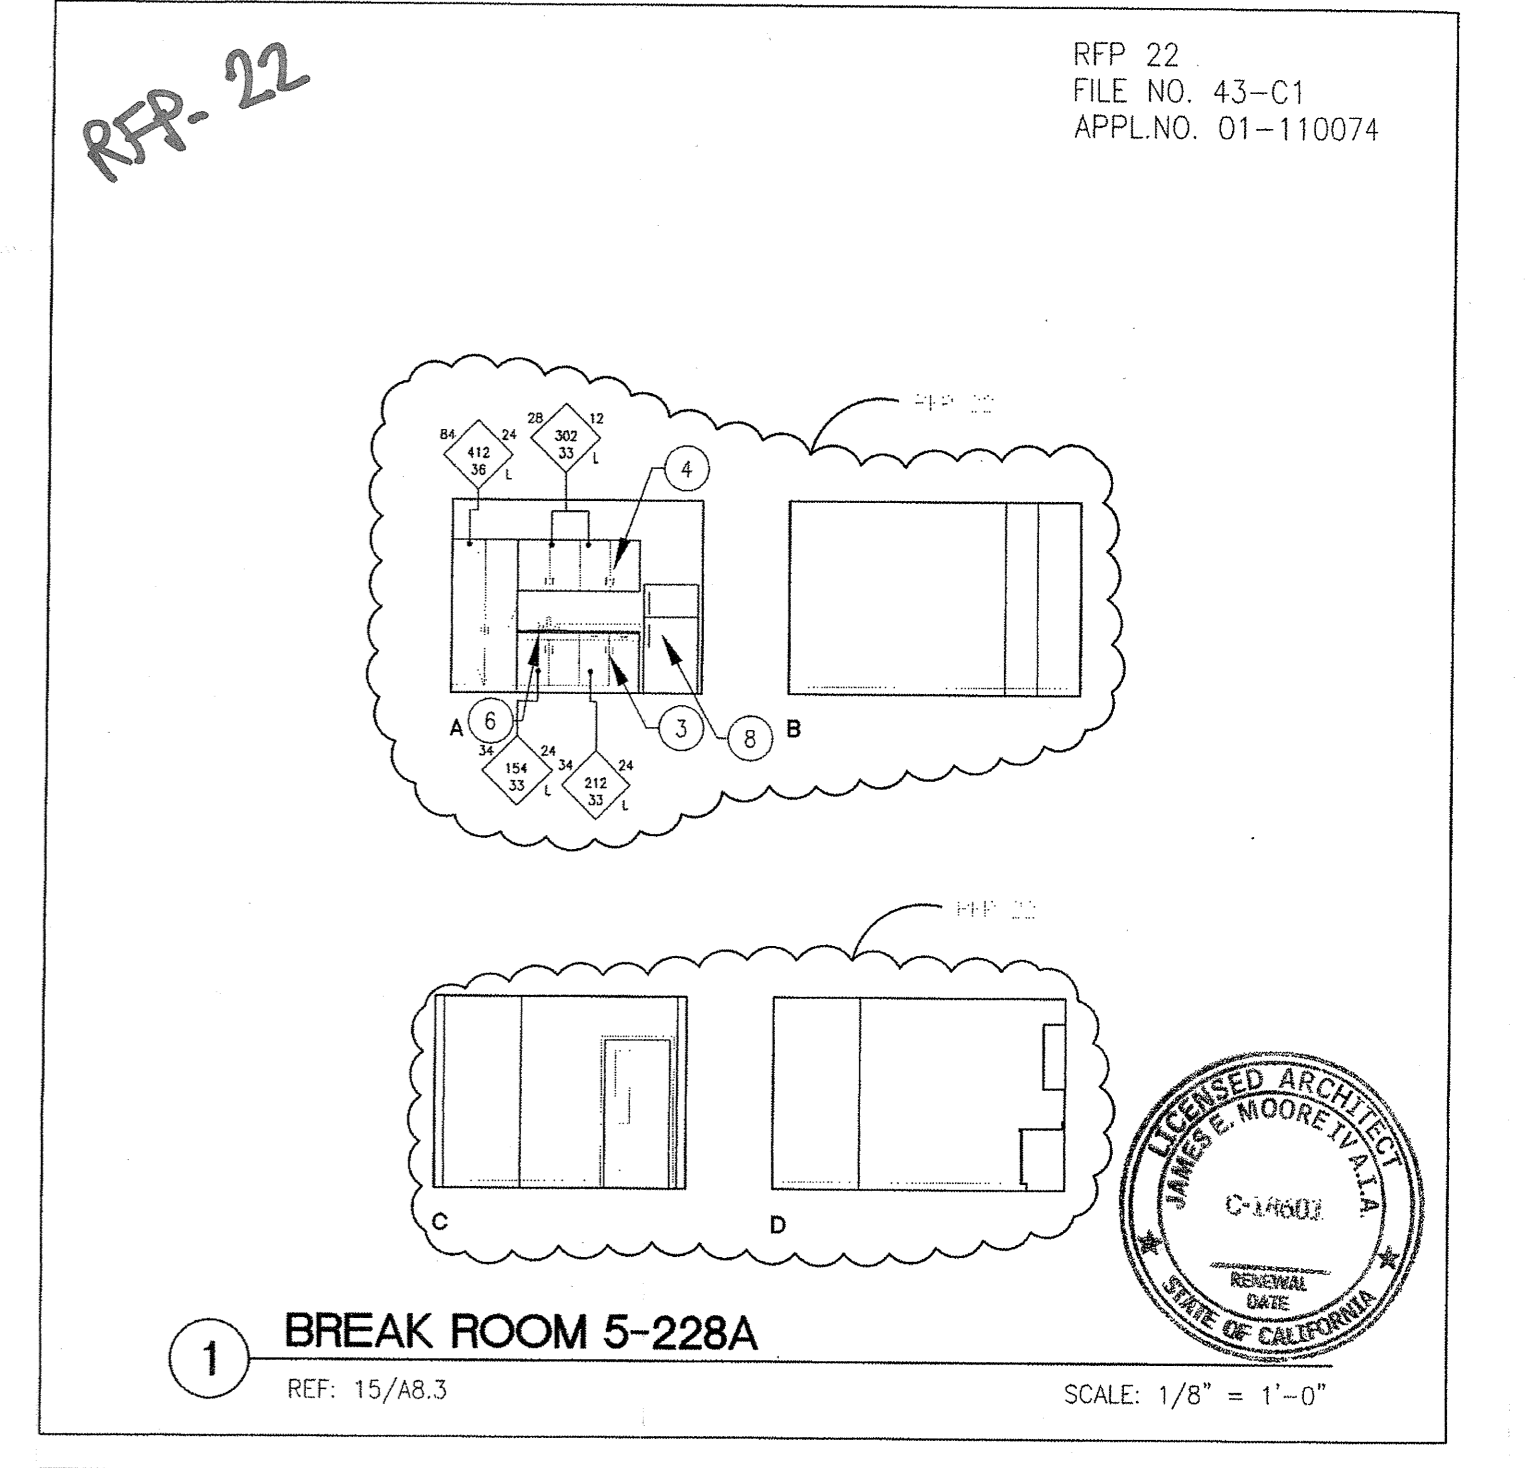

**BCA** architecture planning interiors  
 Project Name: BREAK ROOM - 2ND FLOOR  
 Client: CANADA COLLEGE - BUILDINGS 5 & 6 RENOVATIONS  
 SAN MATEO COUNTRY COMMUNITY COLLEGE DISTRICT  
 4200 FARM HILL BOULEVARD  
 REDWOOD CITY, CA 94061  
 FILE NO. 43-C1 APPL. 01-110074

Scale: AS NOTED  
 Date: 08/20/10  
 Project Number: 0203  
 Drawing Number: RFP 22 116

RFP-116

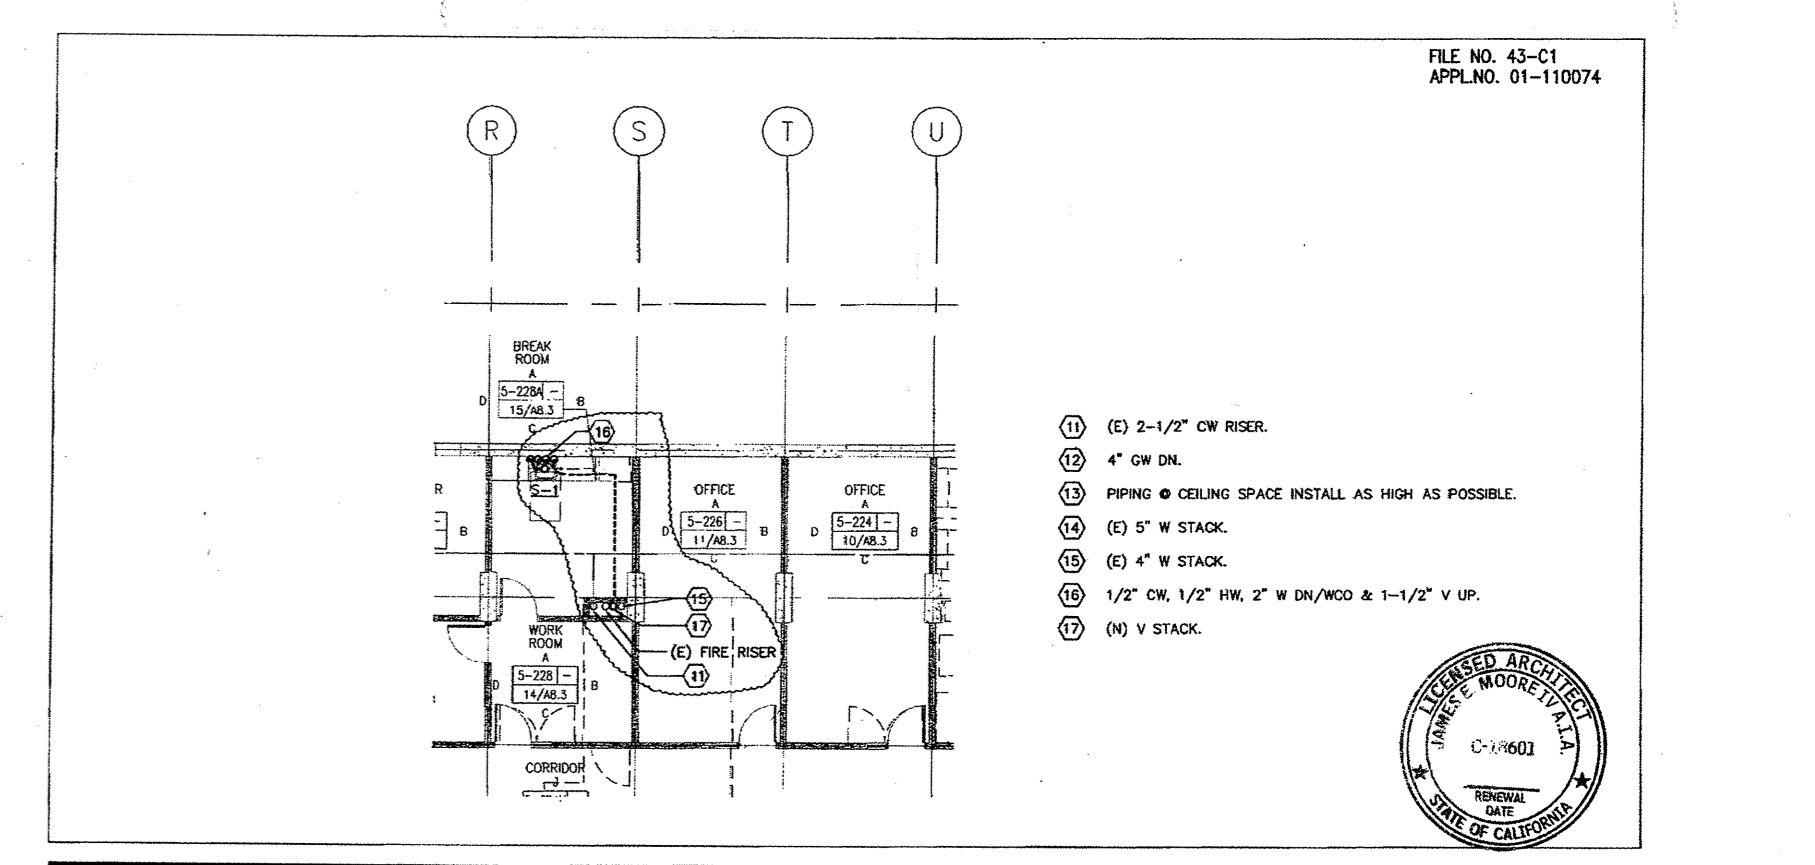

**BCA** architecture planning interiors  
 Project Name: BREAK ROOM 5-228A - PLUMBING - SECOND FLOOR  
 Client: CANADA COLLEGE - BUILDINGS 5 & 6 RENOVATIONS  
 SAN MATEO COUNTRY COMMUNITY COLLEGE DISTRICT  
 4200 FARM HILL BOULEVARD  
 REDWOOD CITY, CA 94061  
 FILE NO. 43-C1 APPL. 01-110074

Scale: AS NOTED  
 Date: 08/20/10  
 Project Number: 0203  
 Drawing Number: RFP-116