




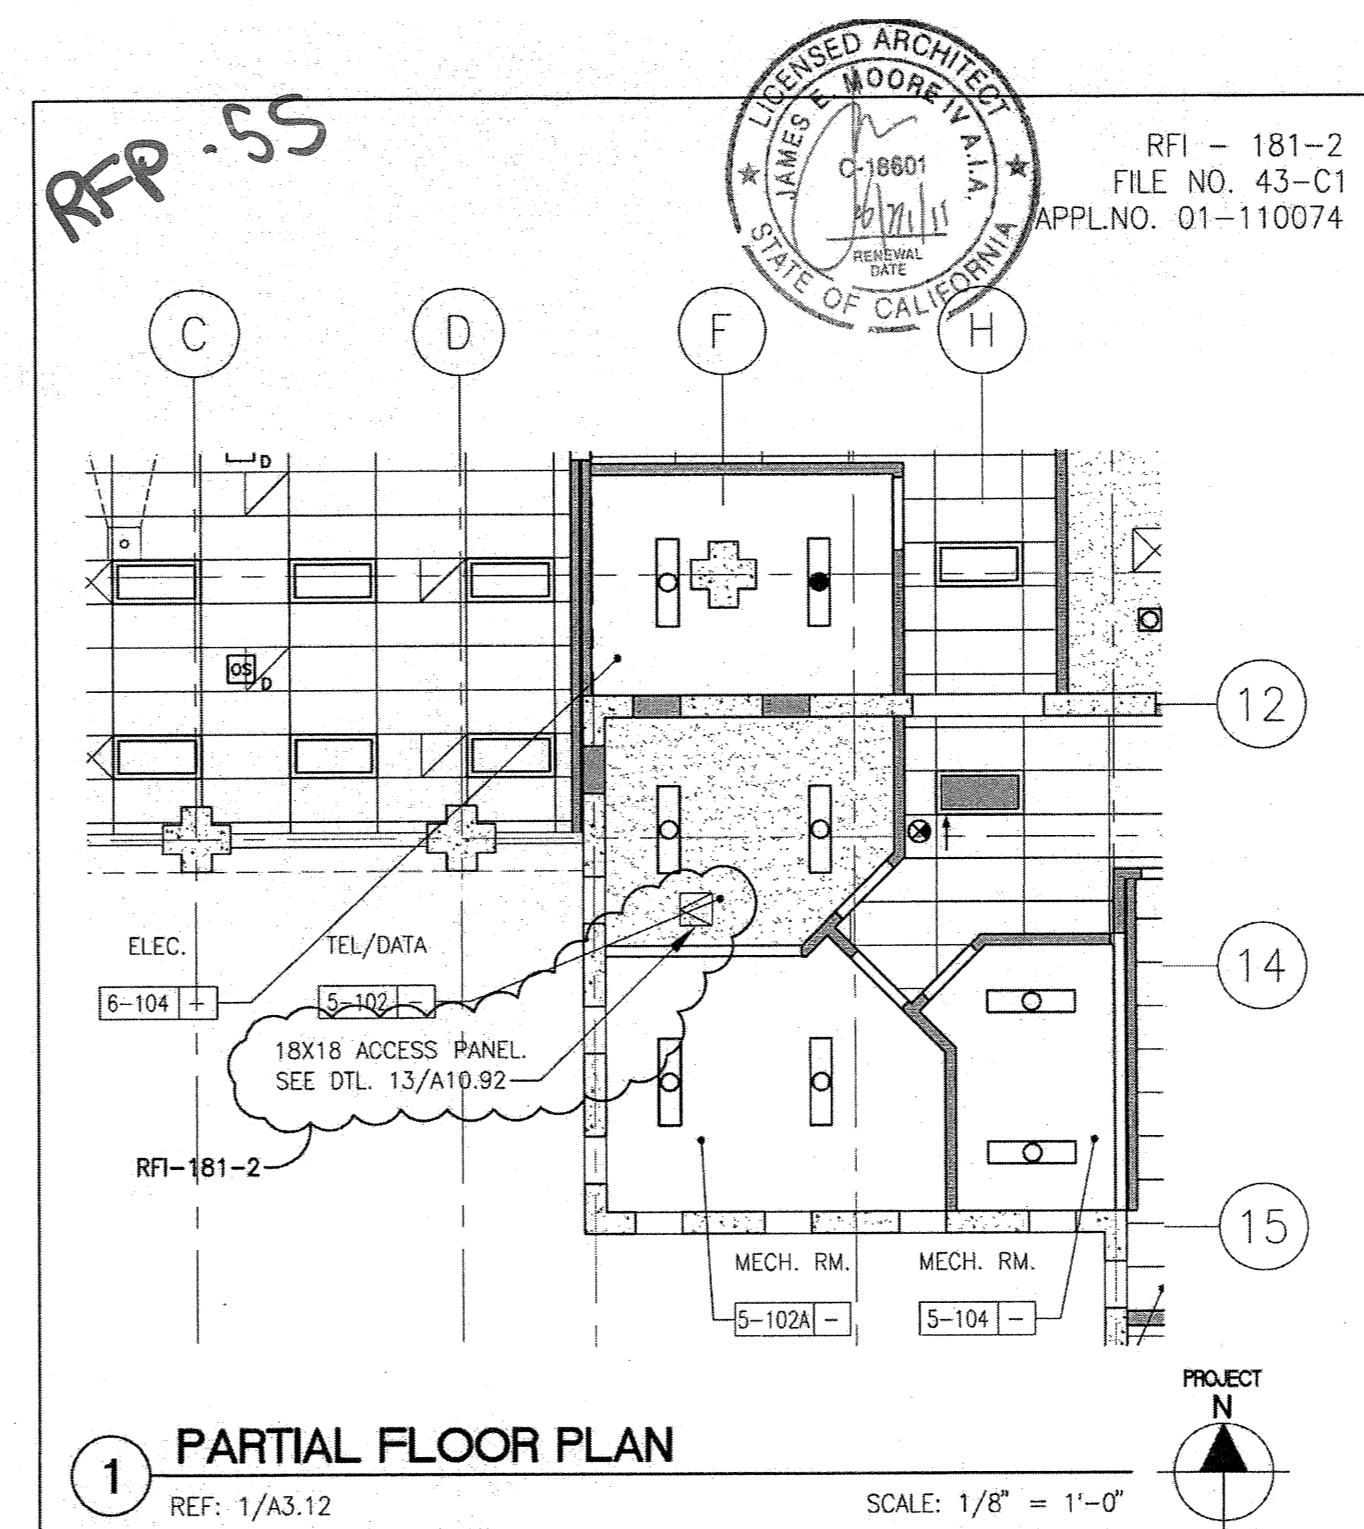

BCA architecture planning interiors 303 S. Main St. San Mateo, California 94401 (415) 948-3800 www.bcaarchitect.com	Title:	Partial Floor Plan	Revision:	181-2
	Project Name:	CARADA COLLEGE - BUILDINGS 5 & 6 RENOVATIONS SAN MATEO COUNTY COMMUNITY COLLEGE DISTRICT FILE NO. 43-C1 APPL. 01-110074	Date:	10.26.2010
	Scale:	AS NOTED	Project Number:	ASK-26
	Sheet Number:	0210		

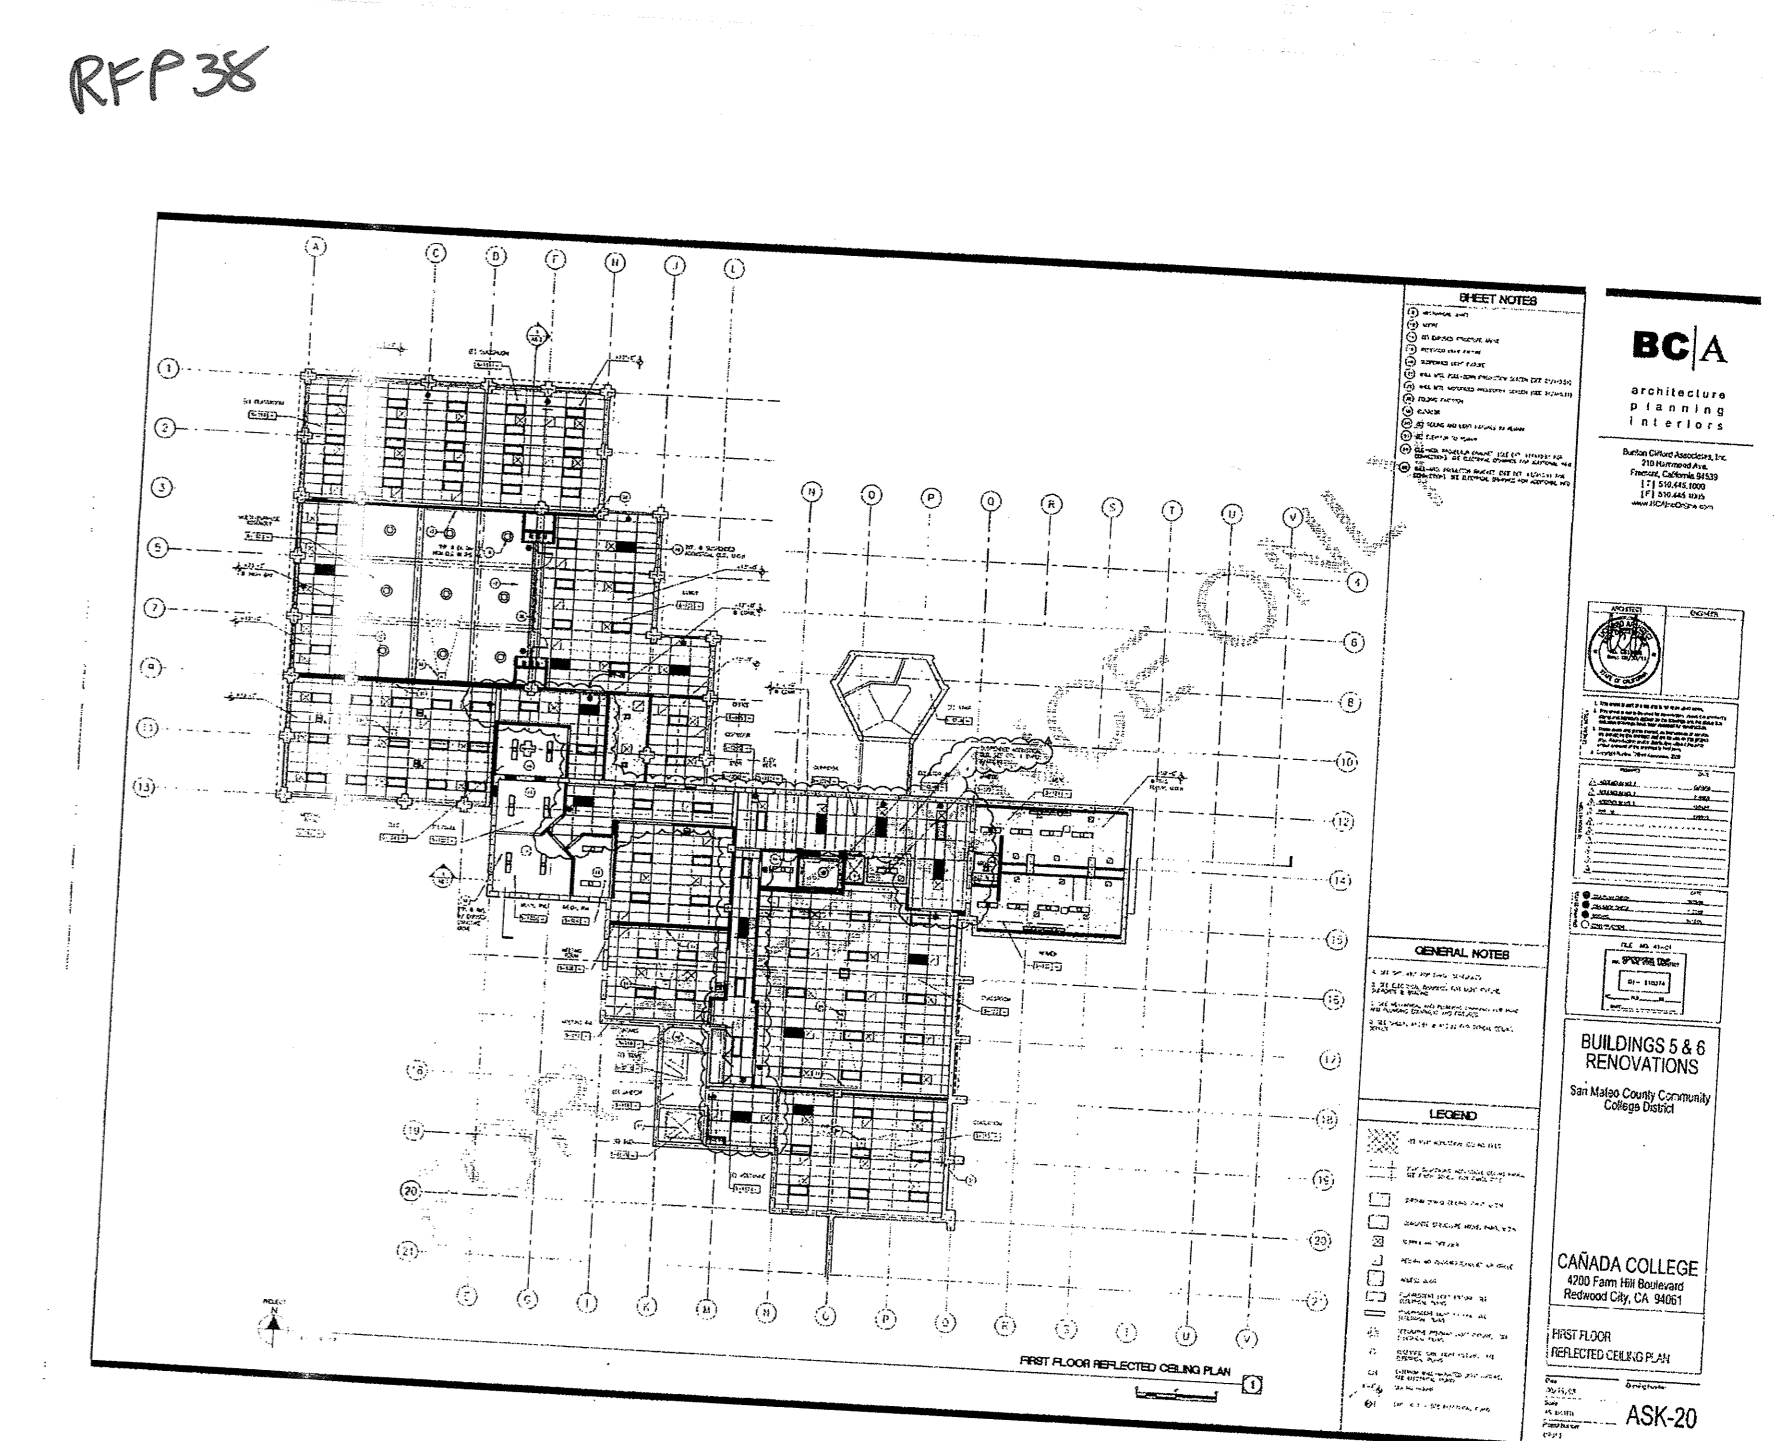

