
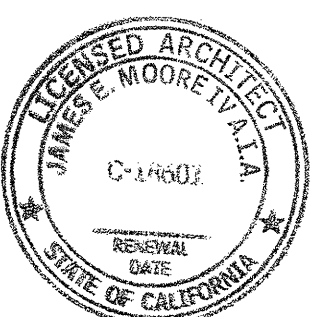
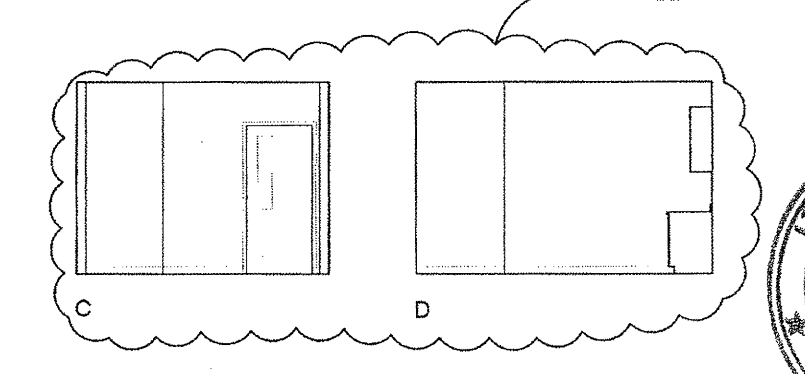


RFP-22

RFP 22
FILE NO. 43-C1
APPL. NO. 01-110074

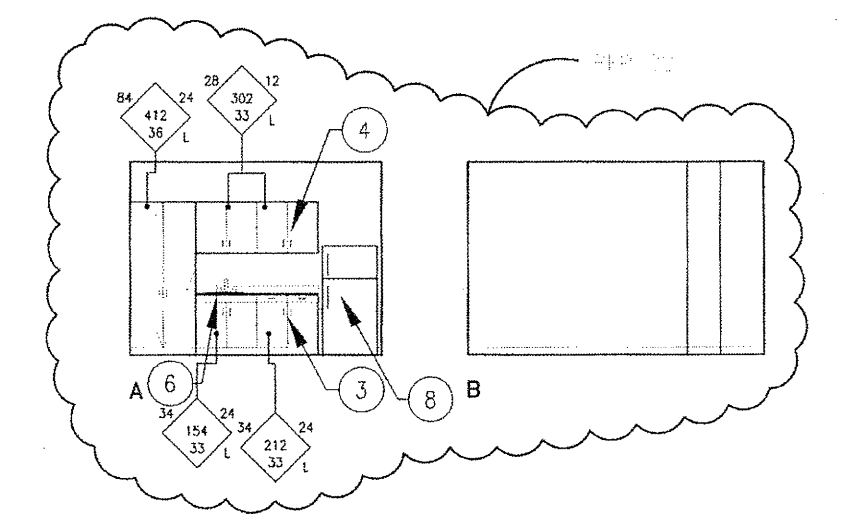

1 BREAK ROOM 5-228A

REF: 15/AB.3

SCALE: 1/8" = 1'-0"

BCA architecture planning interiors 125 Townsend St. Emeryville, CA 94608 (415) 440-0000 www.bca.com	Project Name BREAK ROOM - 2ND FLOOR	Revision RFP 22	Sheet 116	
	Project Location CANADA COLLEGE - BUILDINGS 5 & 6 RENOVATIONS SAN MATEO COUNTY COMMUNITY COLLEGE DISTRICT 4200 FARM HILL BOULEVARD REDWOOD CITY, CA 94061	Date 02/09/10	Drawing Number ASK-12B	
	Project Number FILE NO. 43-C1 APPL. 01-110074	Scale AS NOTED	Project Name CANADA COLLEGE	
			Project Number 0169	