


RFP-24

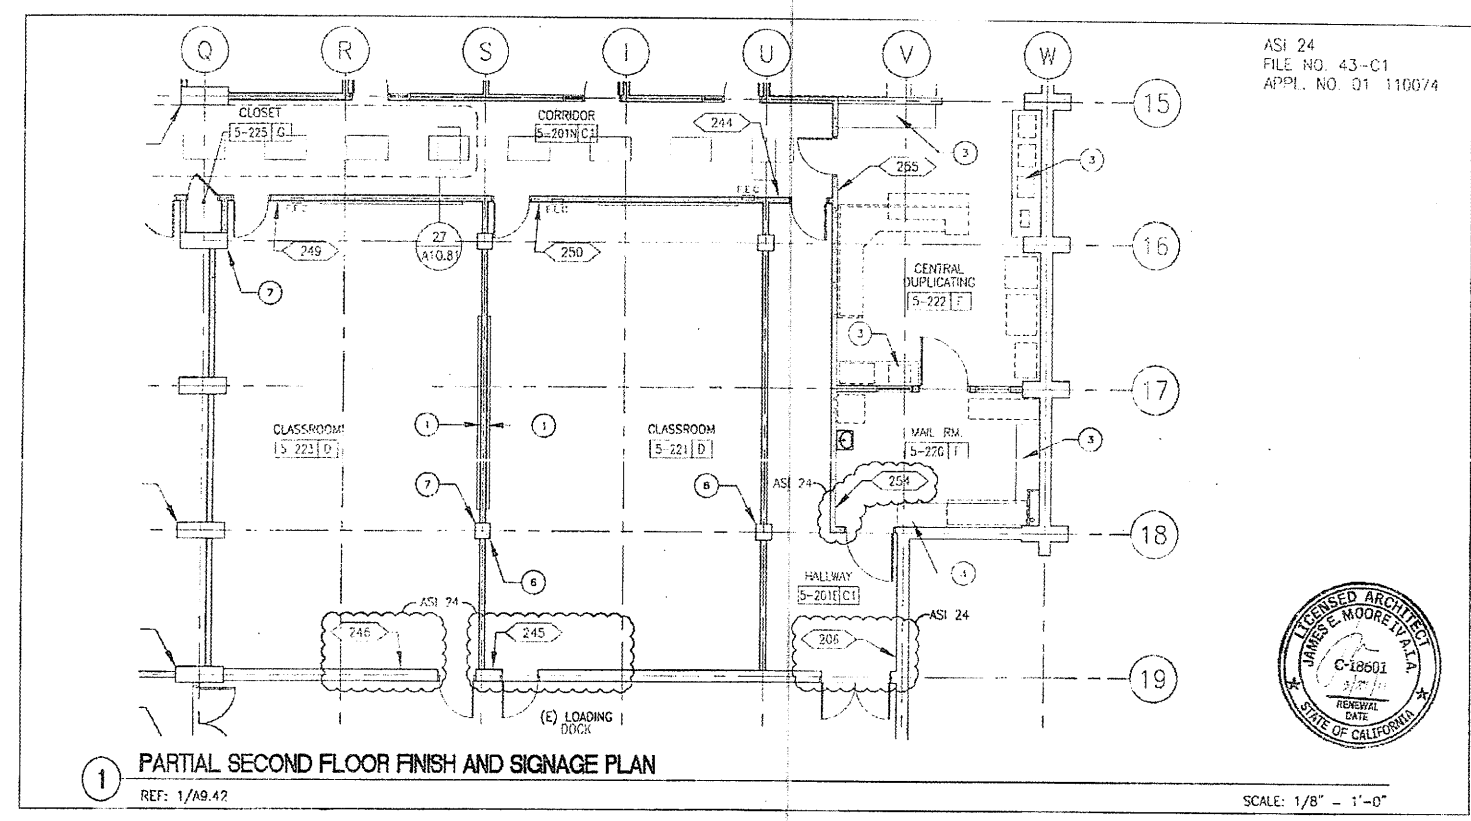

1 PARTIAL SECOND FLOOR FINISH AND SIGNAGE PLAN
REF: 1/A9.42 SCALE: 1/8" = 1'-0"



BCA ARCHITECTURE
PROJECT: CANADA COLLEGE - BUILDINGS 5 & 6 RENOVATIONS
4200 FARM HILL BOULEVARD
REDWOOD CITY, CA 94061
FILE NO. 43-C1 APPL. 01-110074

ASK-300

RFP 25-R



CAN 5 Second Floor

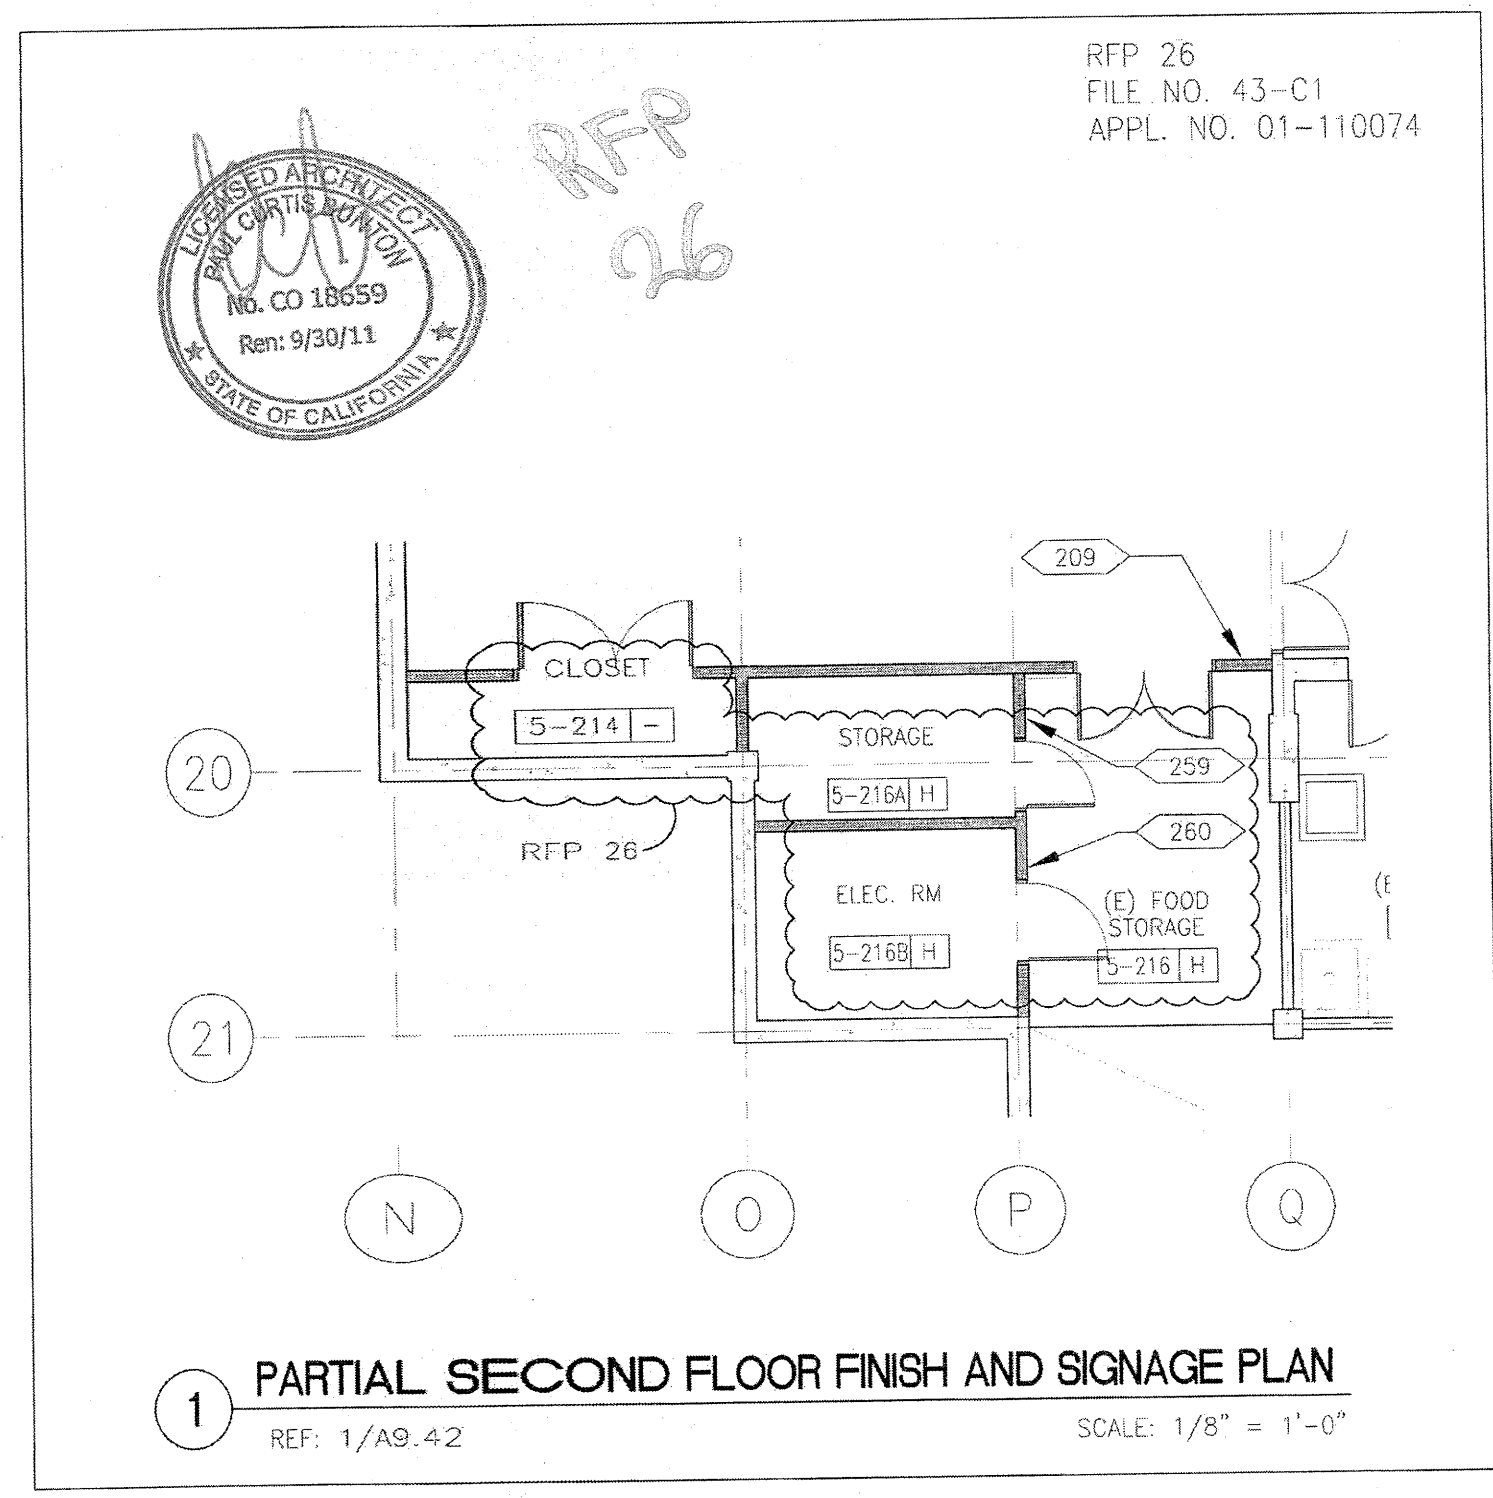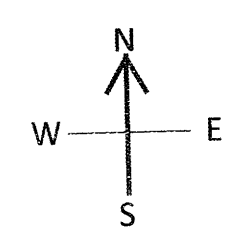

1 PARTIAL SECOND FLOOR FINISH AND SIGNAGE PLAN
REF: 1/A9.42 SCALE: 1/8" = 1'-0"

BCA ARCHITECTURE
PROJECT: CANADA COLLEGE - BUILDINGS 5 & 6 RENOVATIONS
4200 FARM HILL BOULEVARD
REDWOOD CITY, CA 94061
FILE NO. 43-C1 APPL. 01-110074

ELECTRICAL ROOM

ASK-15E