RFP 39

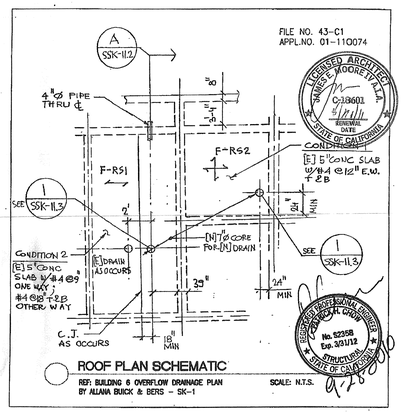

ROOF PLAN SCHEMATIC

REF: BUILDING 6 OVERFLOW DRAINAGE PLAN
BY ALIANA BUICK & BERS – SK-1

SCALE: N.T.S.

BC|A architecture planning interiors
210 Hammond Ave.
Fremont, California 94539
[T] 510.445.1000
[F] 510.445.1005

Title: ROOF DRAINS INSTALLATION

Project Name:
CANADA COLLEGE – BUILDINGS 5 & 6 RENOVATIONS
SAN MATEO COUNTY COMMUNITY COLLEGE DISTRICT
4200 FARM HILL BOULEVARD
REDWOOD CITY, CA 94061
FILE NO. 43-C1 APPL. 01-110074

Revision: –
Date: 09/29/10
Scale: AS NOTED
Project Number: 07013
Drawing Number: SSK-11.1

RFP 39

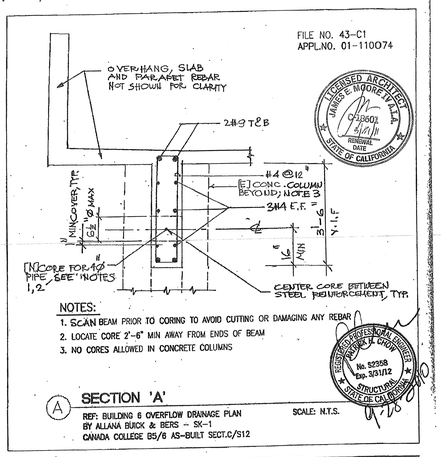

A SECTION 'A'

REF: BUILDING 6 OVERFLOW DRAINAGE PLAN
BY ALIANA BUICK & BERS – SK-1
CANADA COLLEGE B5/6 AS-BUILT SECT.C/S12

SCALE: N.T.S.

BC|A architecture planning interiors
210 Hammond Ave.
Fremont, California 94539
[T] 510.445.1000
[F] 510.445.1005

Title: ROOF DRAINS INSTALLATION

Project Name:
CANADA COLLEGE – BUILDINGS 5 & 6 RENOVATIONS
SAN MATEO COUNTY COMMUNITY COLLEGE DISTRICT
4200 FARM HILL BOULEVARD
REDWOOD CITY, CA 94061
FILE NO. 43-C1 APPL. 01-110074

Revision: –
Date: 09/29/10
Scale: AS NOTED
Project Number: 07013
Drawing Number: SSK-11.2

RFP 39

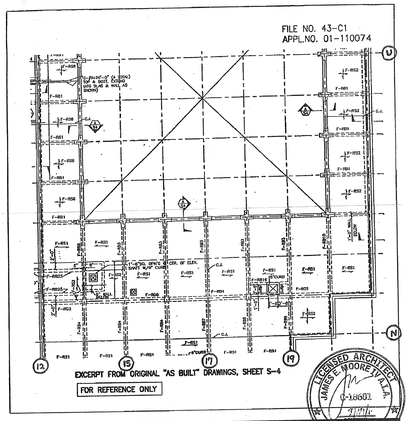

BC|A architecture planning interiors
210 Hammond Ave.
Fremont, California 94539
[T] 510.445.1000
[F] 510.445.1005

Title: ROOF DRAINS INSTALLATION

Project Name:
CANADA COLLEGE – BUILDINGS 5 & 6 RENOVATIONS
SAN MATEO COUNTY COMMUNITY COLLEGE DISTRICT
4200 FARM HILL BOULEVARD
REDWOOD CITY, CA 94061
FILE NO. 43-C1 APPL. 01-110074

Revision: –
Date: 09/29/10
Scale: AS NOTED
Project Number: 07013
Drawing Number: SSK-11.4

RFP 39

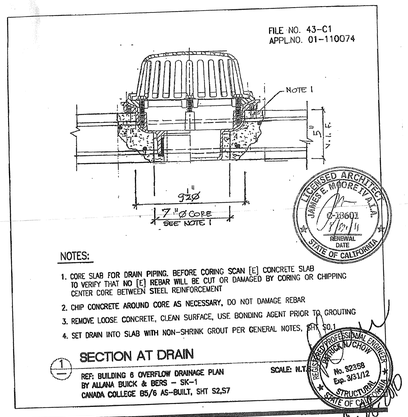

NOTES:

1. CORE SLAB FOR DRAIN PIPING. BEFORE CORING SCAN [E] CONCRETE SLAB TO VERIFY THAT NO [E] REBAR WILL BE CUT OR DAMAGED BY CORING OR CHIPPING CENTER CORE BETWEEN STEEL REINFORCEMENT
2. CHIP CONCRETE AROUND CORE AS NECESSARY, DO NOT DAMAGE REBAR
3. REMOVE LOOSE CONCRETE, CLEAN SURFACE, USE BONDING AGENT PRIOR TO GROUTING
4. SET DRAIN INTO SLAB WITH NON-SHRINK GROUT PER GENERAL NOTES, SHT S0.1

1 SECTION AT DRAIN

REF: BUILDING 6 OVERFLOW DRAINAGE PLAN
BY ALIANA BUICK & BERS – SK-1
CANADA COLLEGE B5/6 AS-BUILT, SHT S2.57

SCALE: N.T.S.

BC|A architecture planning interiors
210 Hammond Ave.
Fremont, California 94539
[T] 510.445.1000
[F] 510.445.1005

Title: ROOF DRAINS INSTALLATION

Project Name:
CANADA COLLEGE – BUILDINGS 5 & 6 RENOVATIONS
SAN MATEO COUNTY COMMUNITY COLLEGE DISTRICT
4200 FARM HILL BOULEVARD
REDWOOD CITY, CA 94061
FILE NO. 43-C1 APPL. 01-110074

Revision: –
Date: 09/29/10
Scale: AS NOTED
Project Number: 07013
Drawing Number: SSK-11.3