

BCA ARCHITECTURE PLANNING INTERIORS
 210 Hammond Ave., Fremont, CA 94539
 TEL: 916.448.1000 FAX: 916.448.1000

PROJECT: 2007-0731
CONTRACT: Ben Cao


PROJECT NAME: CANADA COLLEGE - BUILDINGS 5 & 6 RENOVATIONS
PROJECT ADDRESS: SAN MATEO COUNTY COMMUNITY COLLEGE DISTRICT
 4200 FARM HILL BOULEVARD
 REDWOOD CITY, CA 94061
FILE NO. 43-C1 APPL. 01-110074

REVISION: DRAWING 02.23
NO.: ASI-003
DATE: 05/21/10
SCALE: 1/8" = 1'-0"

DRAWING NUMBER: MSK-18
PROJECT NUMBER: 07013
DATE SIGNED: 5/21/10

MECHANICAL ENGINEER: L. JAMES R. LAMBERT
 No. 030802
 State of California
 Date Signed: 5/21/10

INTERFACE ENGINEERING
 717 Market Street, Suite 500, San Francisco, CA 94103
 www.interfaceengineering.com

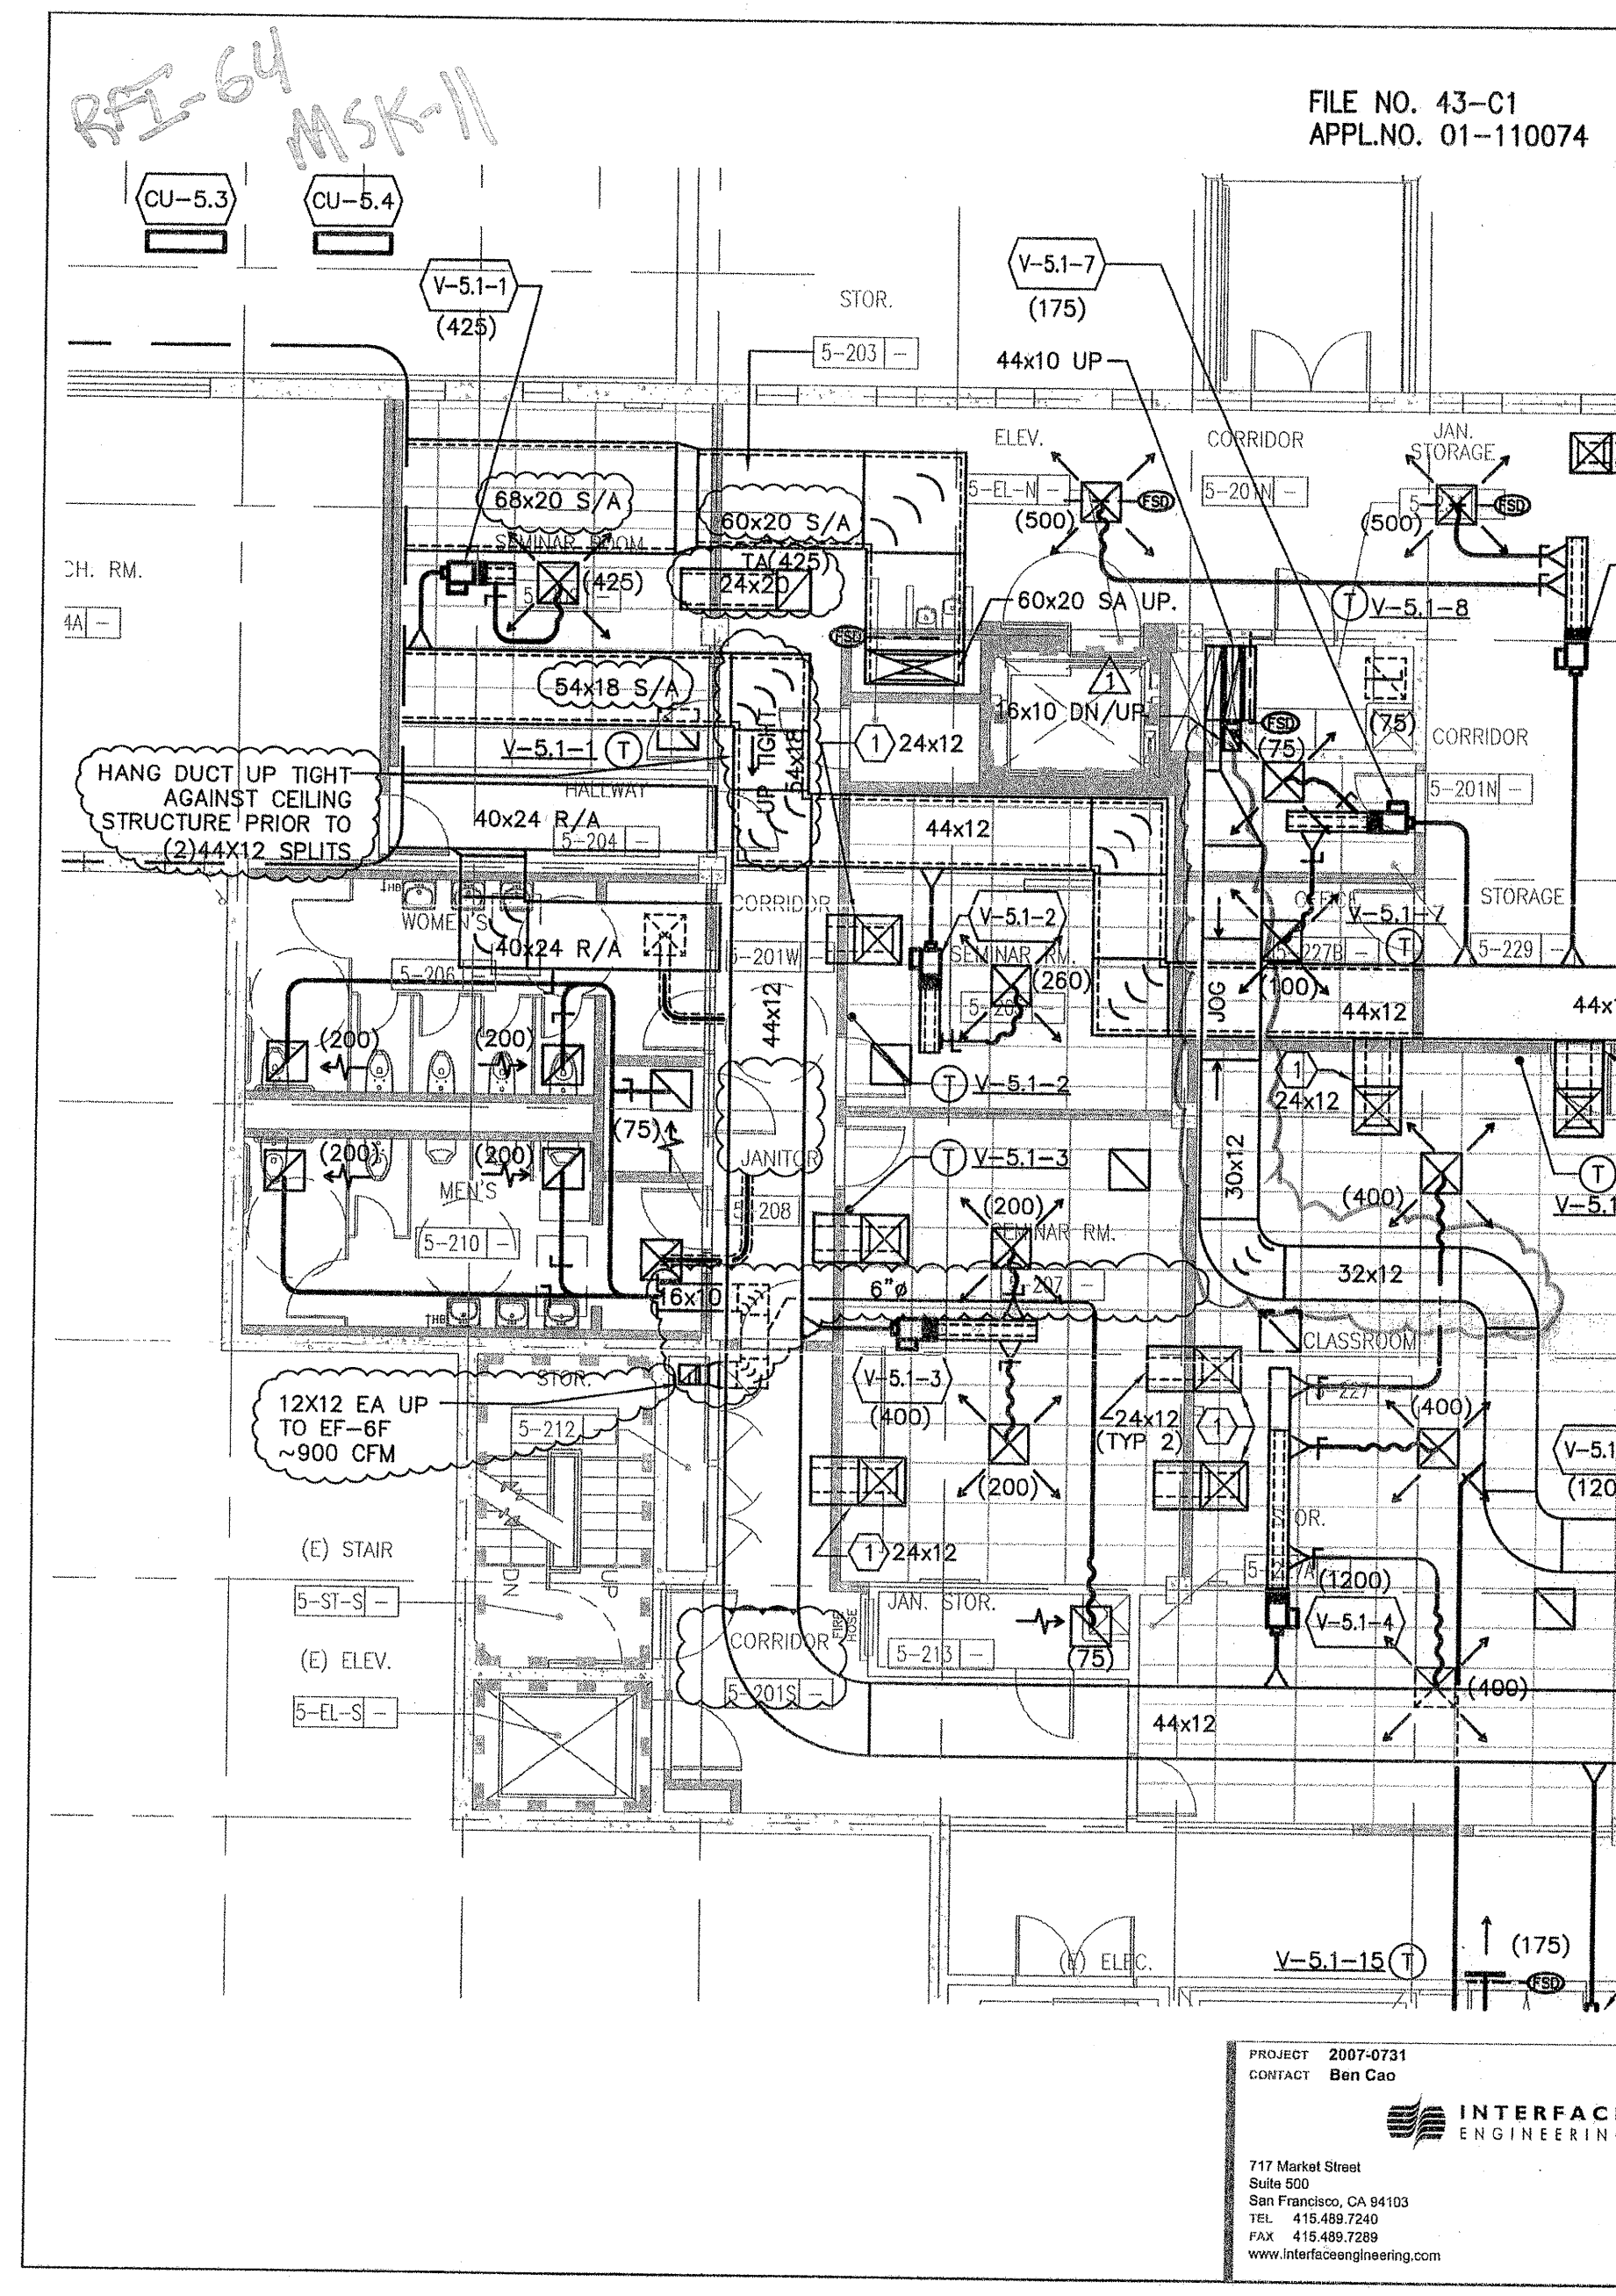

BCA ARCHITECTURE PLANNING INTERIORS
 210 Hammond Ave., Fremont, CA 94539
 TEL: 916.448.1000 FAX: 916.448.1000

PROJECT: 2007-0731
CONTRACT: Ben Cao


PROJECT NAME: CANADA COLLEGE - BUILDINGS 5 & 6 RENOVATIONS
PROJECT ADDRESS: SAN MATEO COUNTY COMMUNITY COLLEGE DISTRICT
 4200 FARM HILL BOULEVARD
 REDWOOD CITY, CA 94061
FILE NO. 43-C1 APPL. 01-110074

REVISION: DRAWING 02.23
NO.: RFI-004 & RFI-0014
DATE: 04/21/10
SCALE: 1/8" = 1'-0"

DRAWING NUMBER: MSK-11
PROJECT NUMBER: 07013
DATE SIGNED: 5/21/10

MECHANICAL ENGINEER: L. JAMES R. LAMBERT
 No. 030802
 State of California
 Date Signed: 5/21/10

INTERFACE ENGINEERING
 717 Market Street, Suite 500, San Francisco, CA 94103
 www.interfaceengineering.com

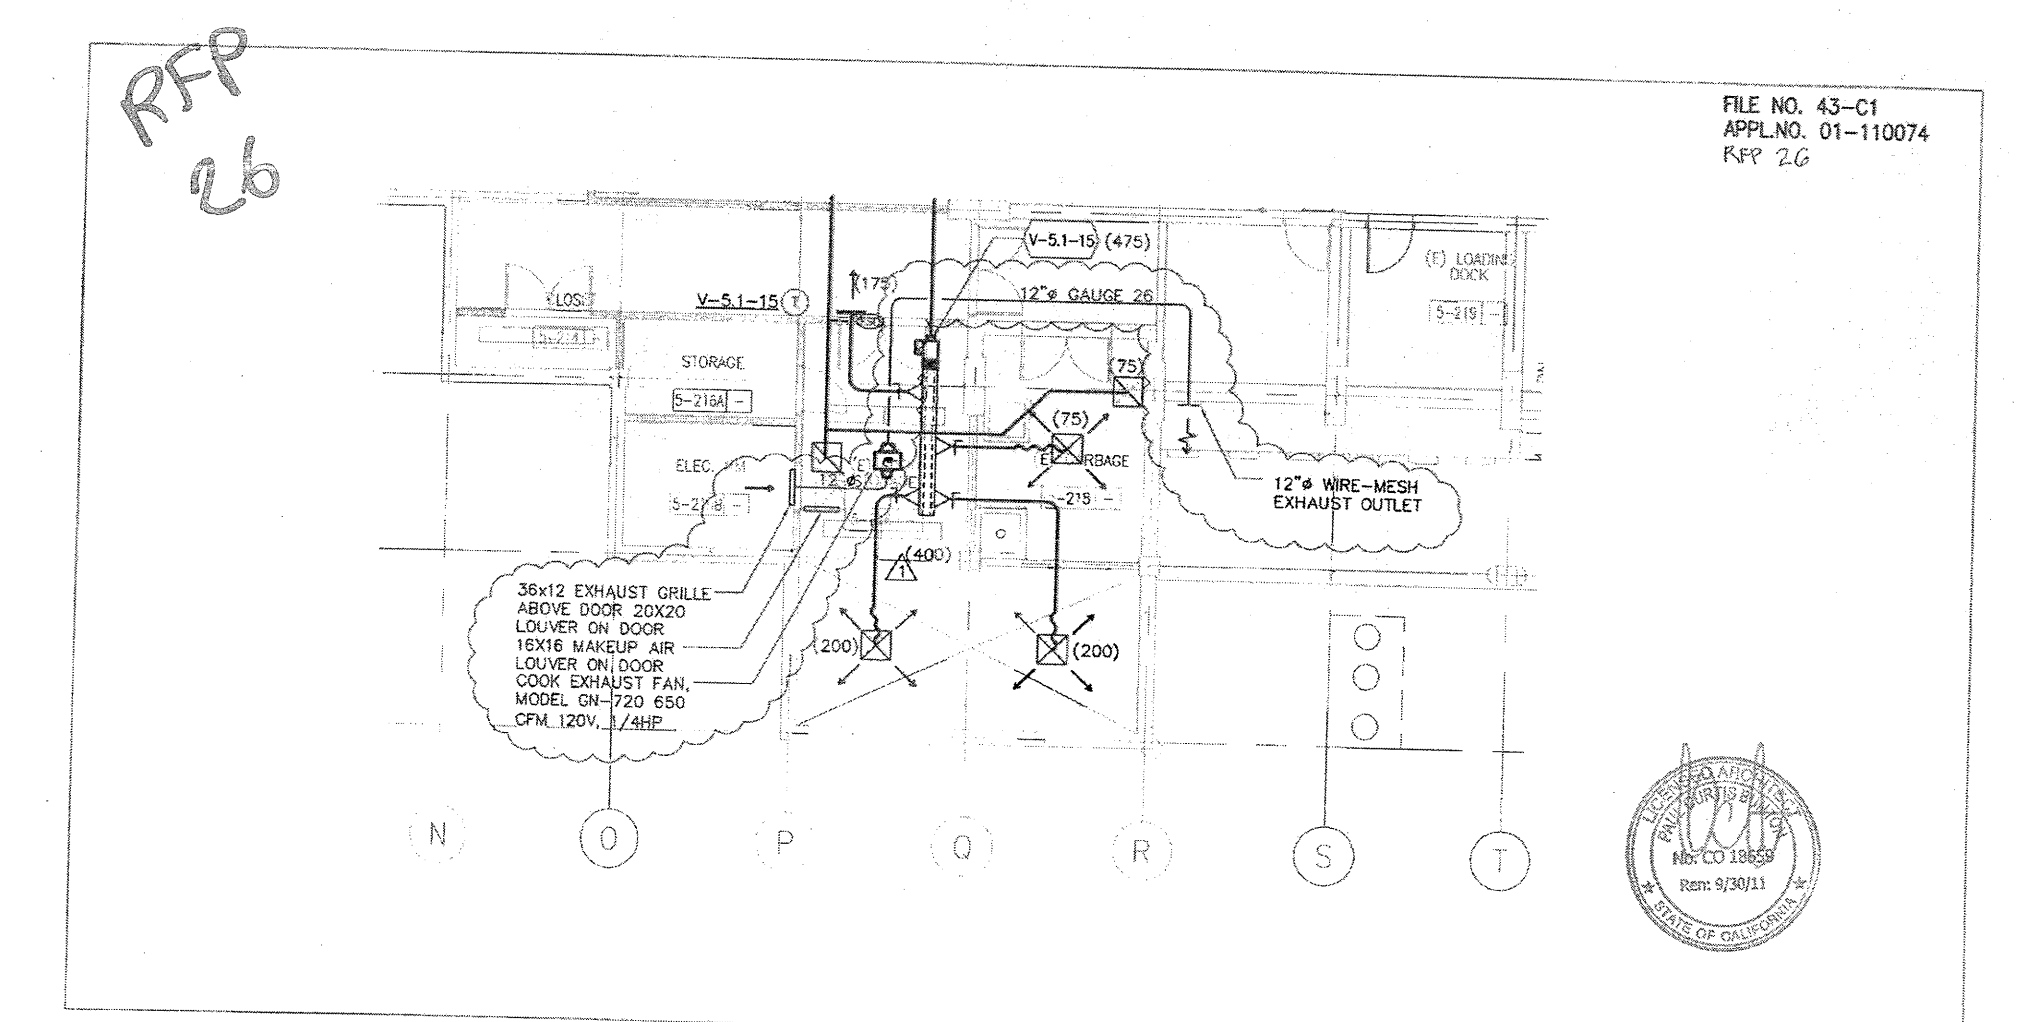

BCA ARCHITECTURE PLANNING INTERIORS
 210 Hammond Ave., Fremont, CA 94539
 TEL: 916.448.1000 FAX: 916.448.1000

PROJECT: 2007-0731
CONTRACT: Ben Cao


PROJECT NAME: CANADA COLLEGE - BUILDINGS 5 & 6 RENOVATIONS
PROJECT ADDRESS: SAN MATEO COUNTY COMMUNITY COLLEGE DISTRICT
 4200 FARM HILL BOULEVARD
 REDWOOD CITY, CA 94061
FILE NO. 43-C1 APPL. 01-110074

REVISION: DRAWING 02.23
NO.: MSK-22
DATE: 05/11/10
SCALE: 1/8" = 1'-0"

DRAWING NUMBER: MSK-22
PROJECT NUMBER: 07013
DATE SIGNED: 5/21/10

MECHANICAL ENGINEER: L. JAMES R. LAMBERT
 No. 030802
 State of California
 Date Signed: 5/21/10

INTERFACE ENGINEERING
 717 Market Street, Suite 500, San Francisco, CA 94103
 www.interfaceengineering.com

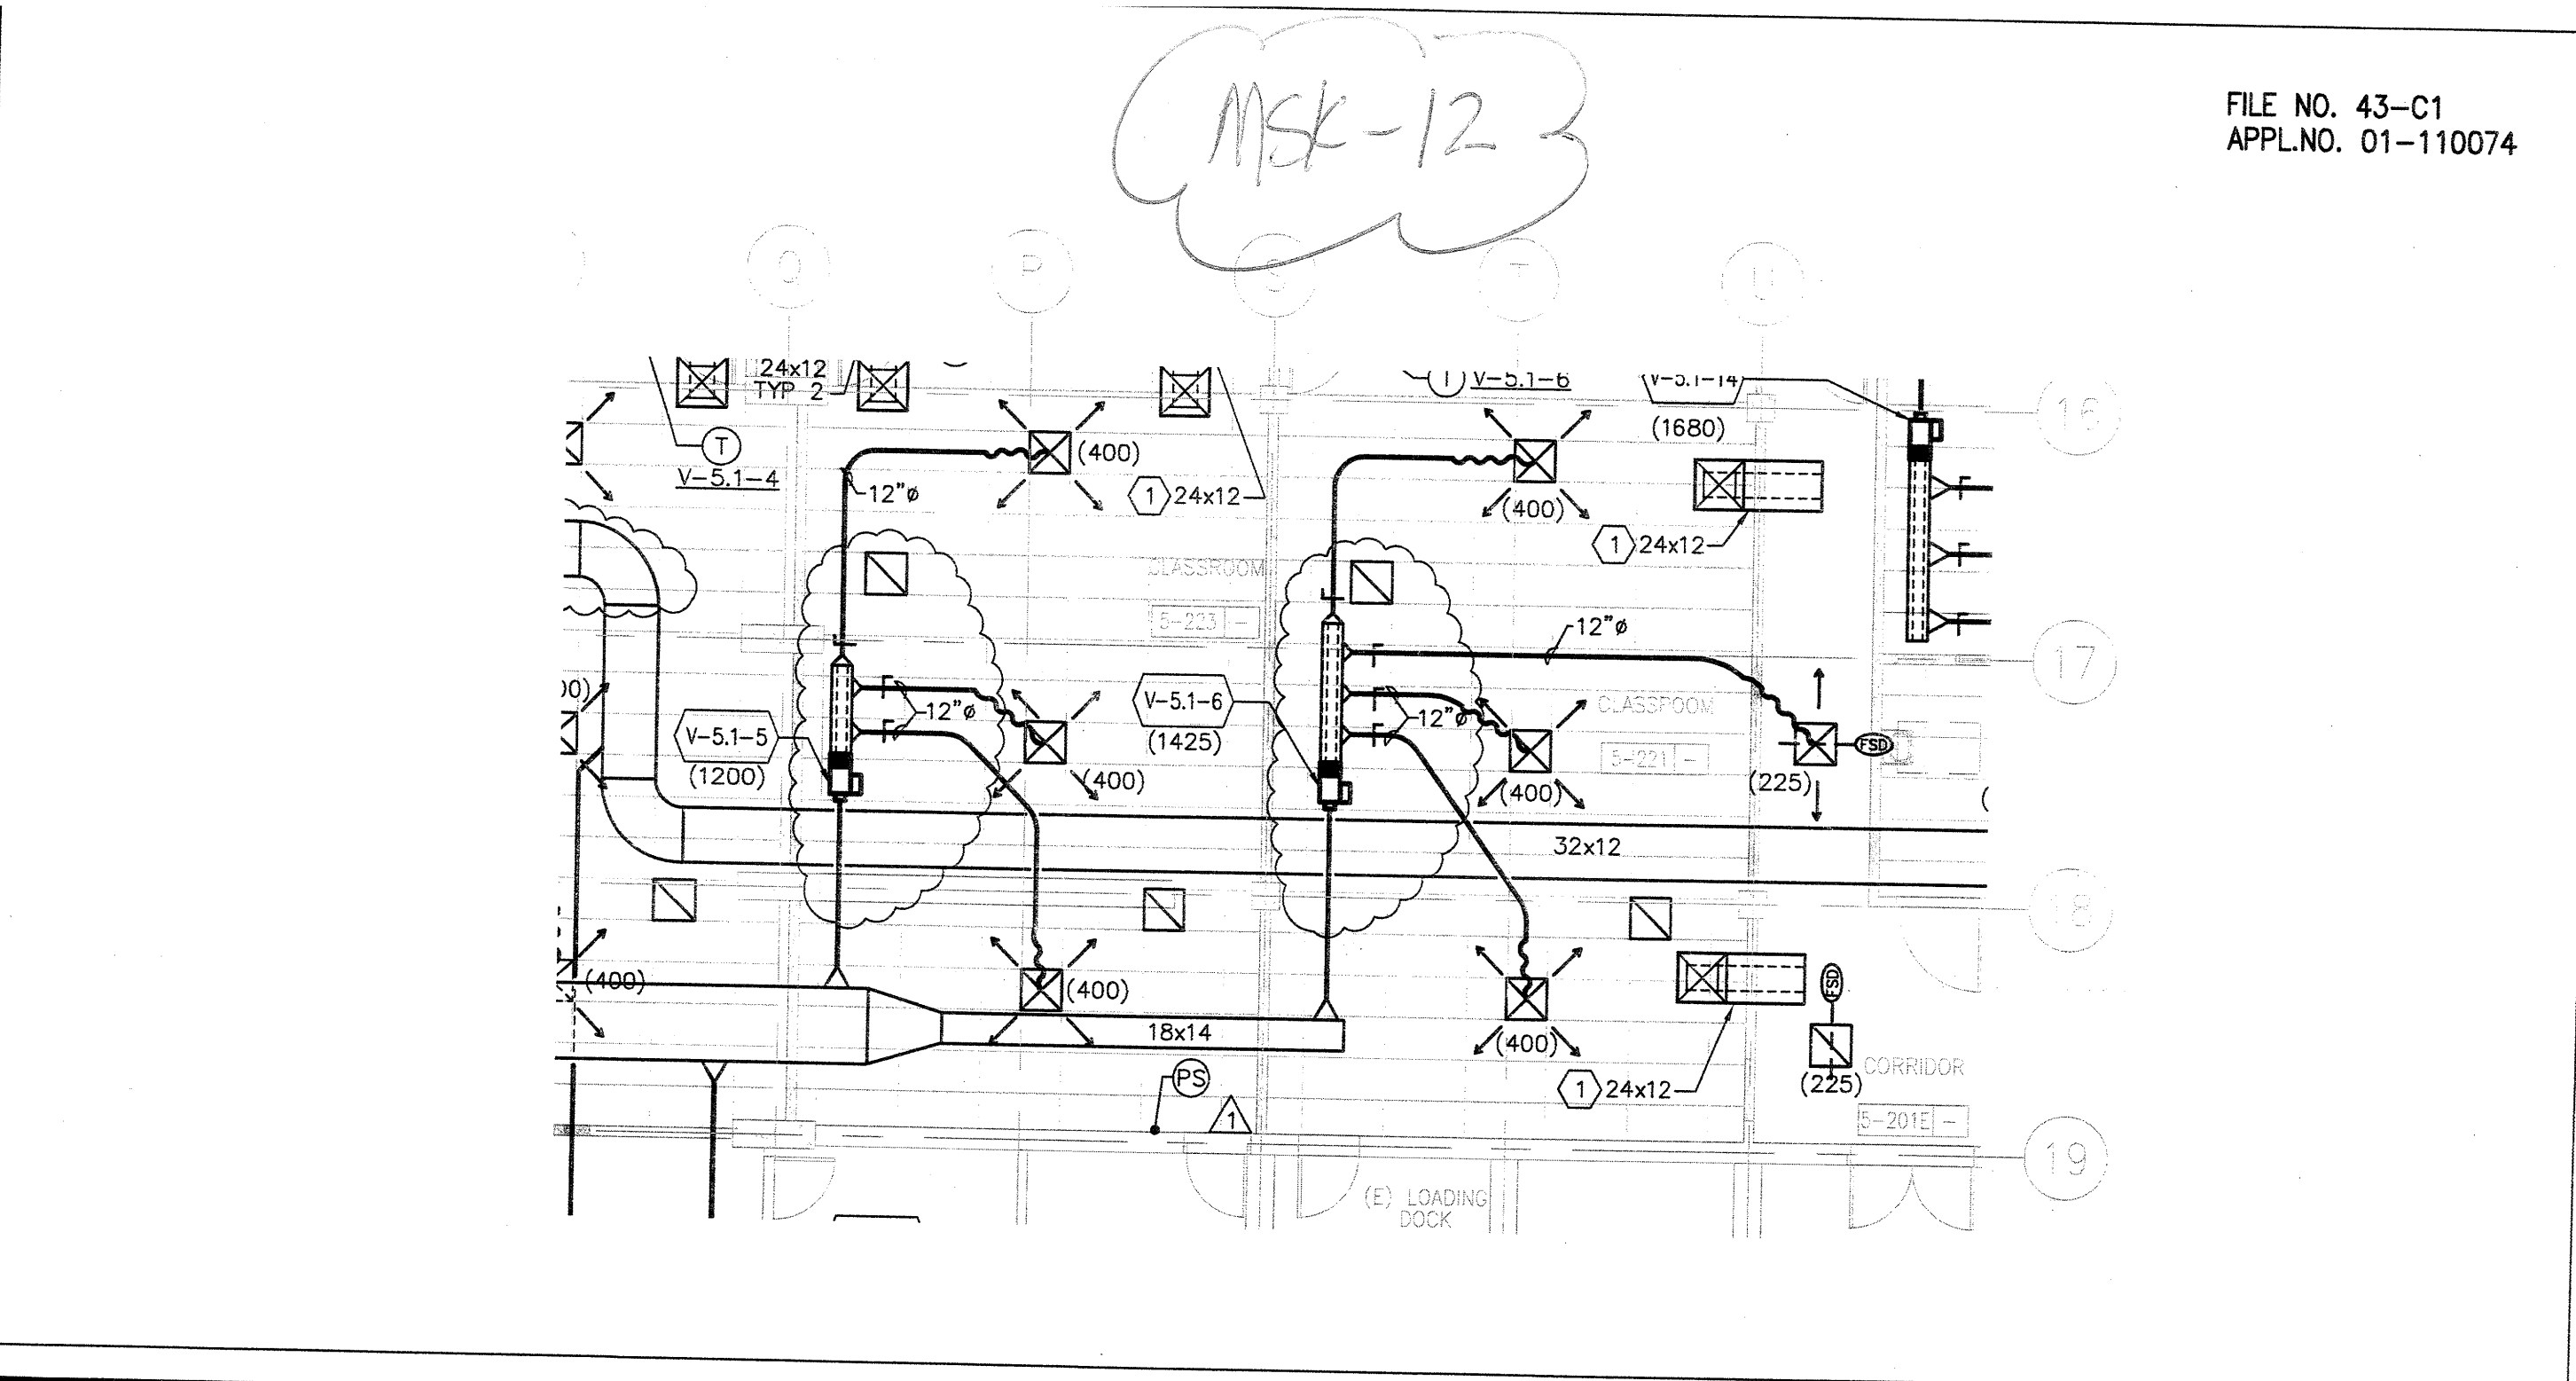

BCA ARCHITECTURE PLANNING INTERIORS
 210 Hammond Ave., Fremont, CA 94539
 TEL: 916.448.1000 FAX: 916.448.1000

PROJECT: 2007-0731
CONTRACT: Ben Cao


PROJECT NAME: CANADA COLLEGE - BUILDINGS 5 & 6 RENOVATIONS
PROJECT ADDRESS: SAN MATEO COUNTY COMMUNITY COLLEGE DISTRICT
 4200 FARM HILL BOULEVARD
 REDWOOD CITY, CA 94061
FILE NO. 43-C1 APPL. 01-110074

REVISION: DRAWING 02.23
NO.: CLARIFICATION
DATE: 04/21/10
SCALE: 1/8" = 1'-0"

DRAWING NUMBER: MSK-12
PROJECT NUMBER: 07013
DATE SIGNED: 5/11/10

MECHANICAL ENGINEER: L. JAMES R. LAMBERT
 No. 030802
 State of California
 Date Signed: 5/11/10

INTERFACE ENGINEERING
 717 Market Street, Suite 500, San Francisco, CA 94103
 www.interfaceengineering.com

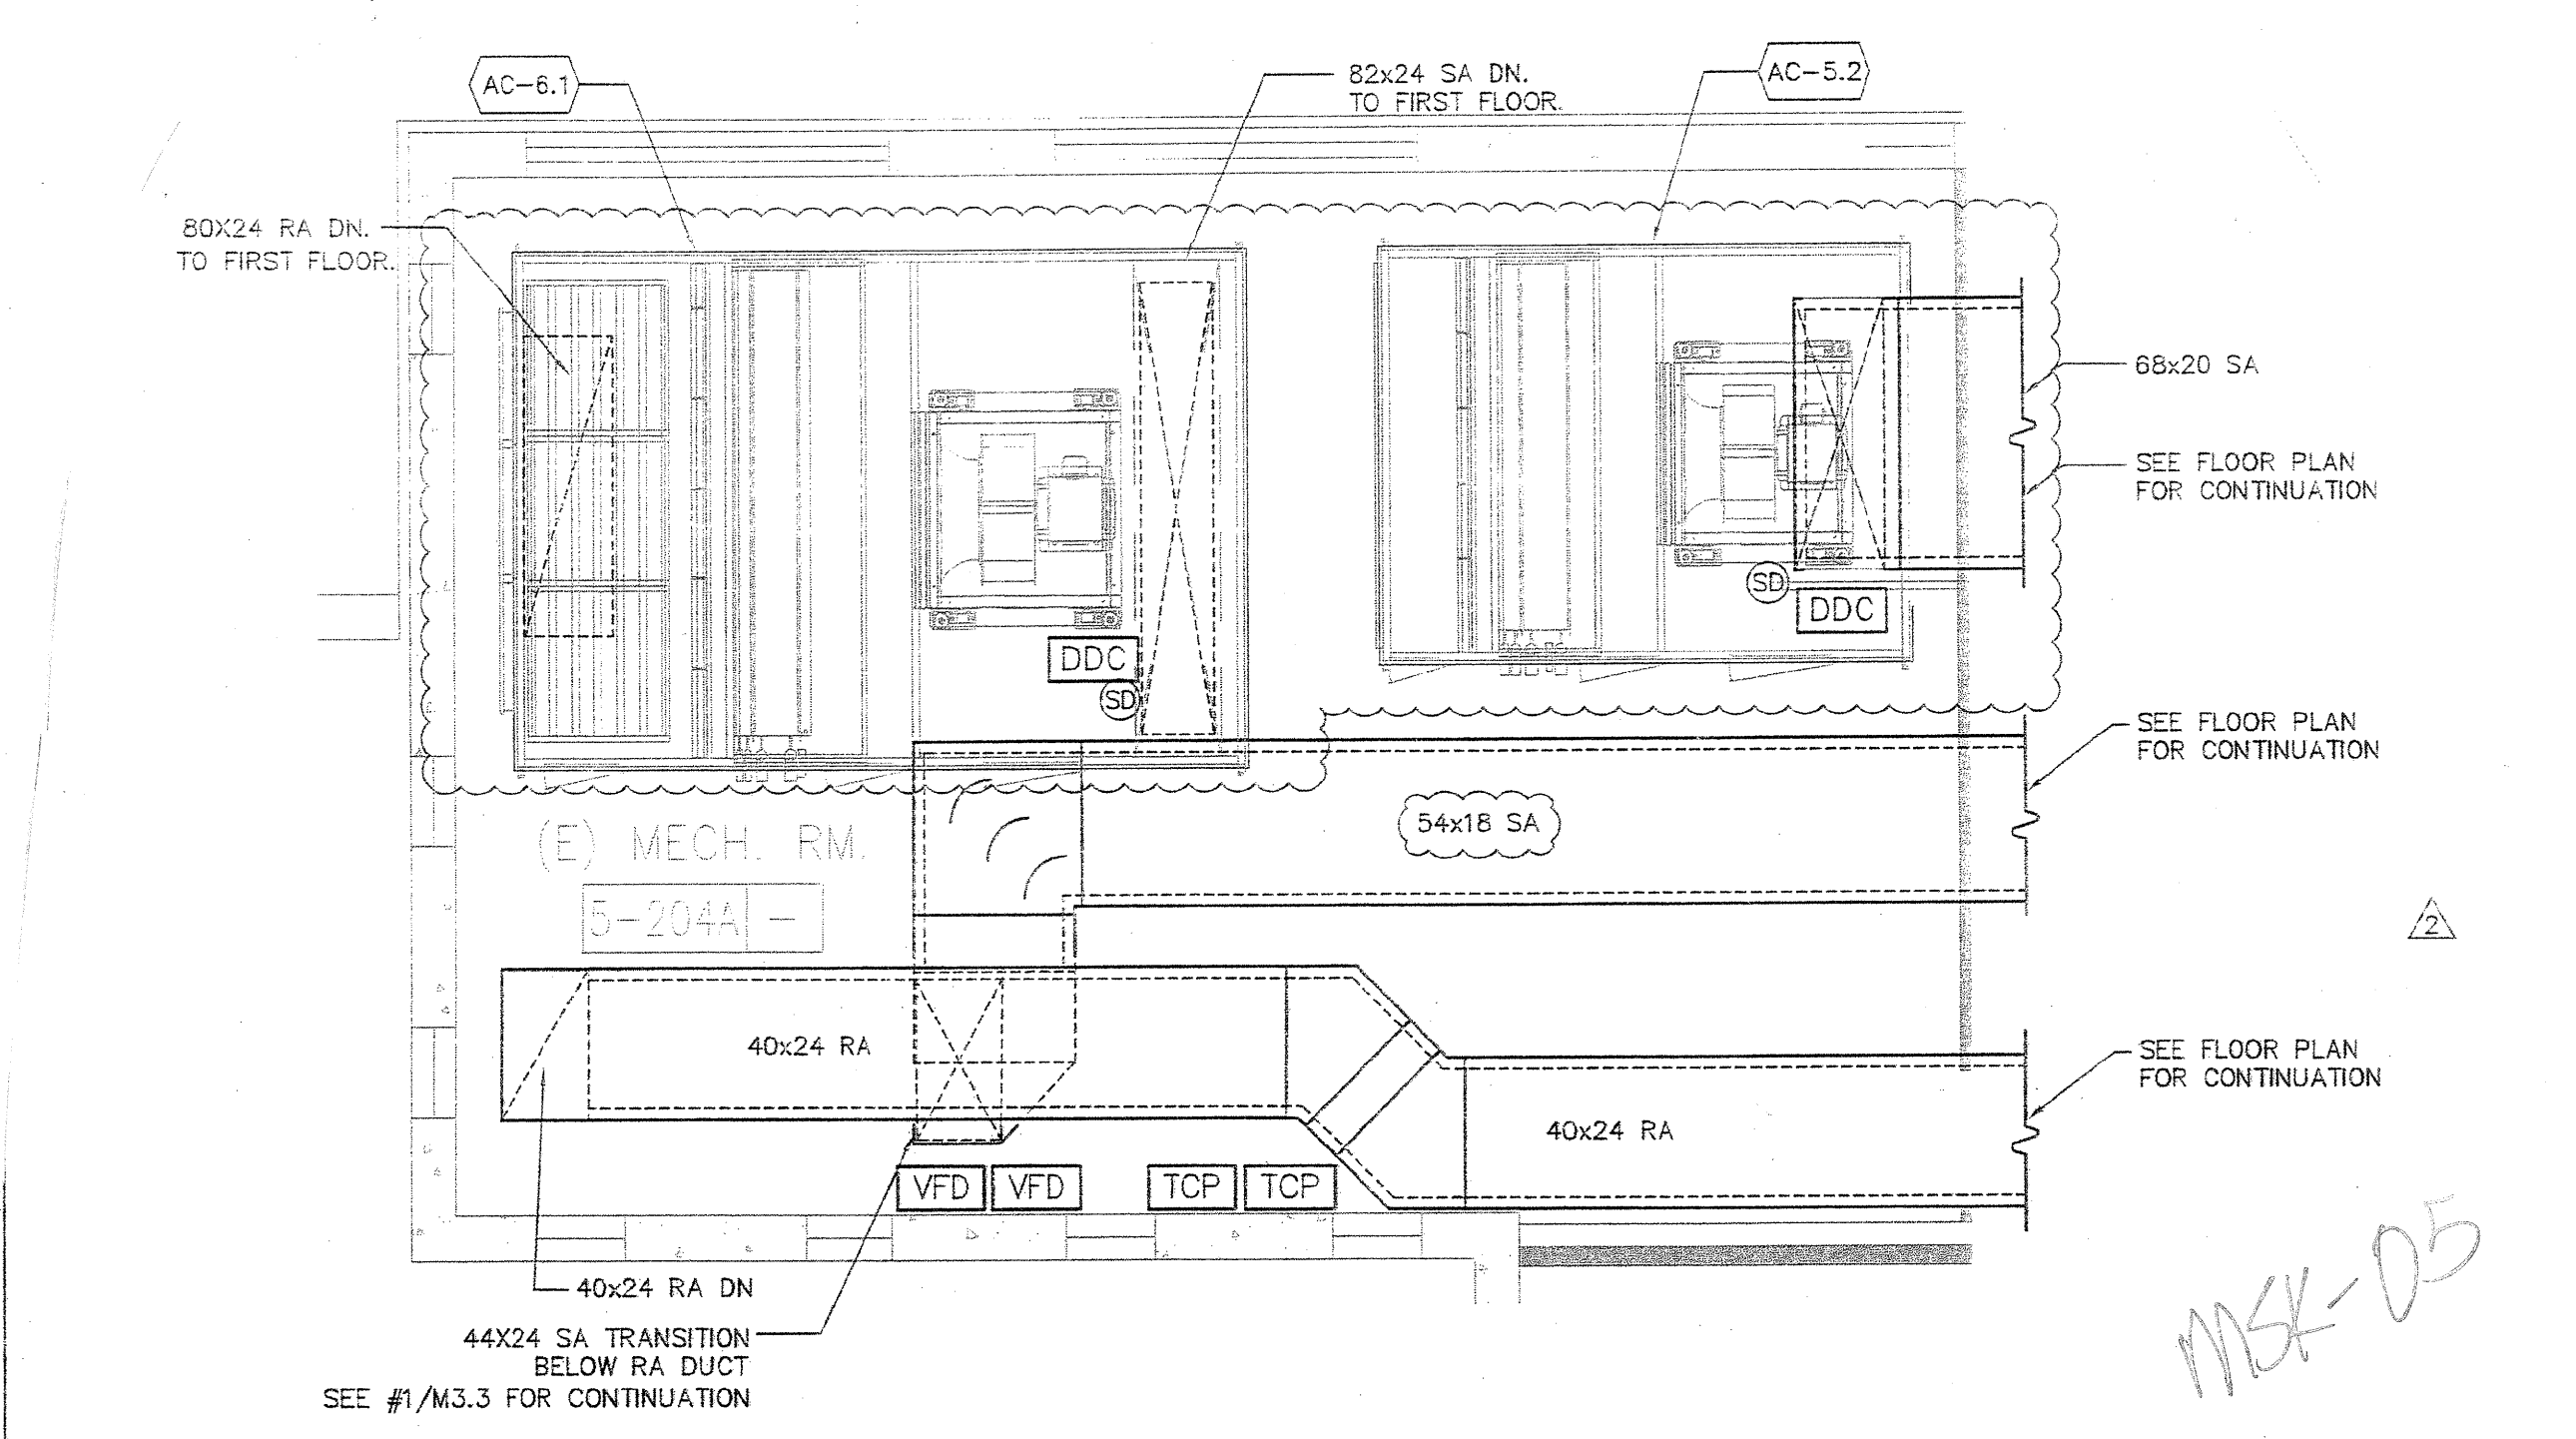

BCA ARCHITECTURE PLANNING INTERIORS
 210 Hammond Ave., Fremont, CA 94539
 TEL: 916.448.1000 FAX: 916.448.1000

PROJECT: 2007-0731
CONTRACT: Ben Cao

PROJECT NAME: CANADA COLLEGE - BUILDINGS 5 & 6 RENOVATIONS
PROJECT ADDRESS: SAN MATEO COUNTY COMMUNITY COLLEGE DISTRICT
 4200 FARM HILL BOULEVARD
 REDWOOD CITY, CA 94061
FILE NO. 43-C1 APPL. 01-110074

REVISION: DRAWING 02.23
NO.: MSK-05
DATE: 05/11/10
SCALE: 1/8" = 1'-0"

DRAWING NUMBER: MSK-05
PROJECT NUMBER: 07013
DATE SIGNED: 5/25/10

MECHANICAL ENGINEER: L. JAMES R. LAMBERT
 No. 030802
 State of California
 Date Signed: 5/25/10

INTERFACE ENGINEERING
 717 Market Street, Suite 500, San Francisco, CA 94103
 TEL: 415.488.7340 FAX: 415.488.7350
 www.interfaceengineering.com