


**SHEET KEYNOTES**

- 1 REMOVE (E) WALL MOUNTED WATER CLOSET INCLUDING CARRIER, FLUSHMETER VALVE, TOILET SEAT AND RELATED PIPING. CAP (E) WASTE PIPE BELOW THE FLOOR AND CAP VENT PIPE ABOVE THE FLOOR INSIDE THE WALL.
- 2 REMOVE (E) URINAL INCLUDING STOP VALVES AND RELATED PIPING. CAP (E) WASTE PIPE BELOW THE FLOOR AND CAP VENT PIPE ABOVE THE FLOOR INSIDE THE WALL.
- 3 REMOVE (E) WALL MOUNTED LAVATORY INCLUDING DRAIN, P-TRAP, SUPPLY TUBING, STOP VALVES AND RELATED PIPING. CAP (E) WASTE PIPE BELOW THE FLOOR AND CAP VENT PIPE ABOVE THE FLOOR INSIDE THE WALL. PATCH HOLE TO MATCH (E) WALL.
- 4 (E) FD AND RELATED PIPING TO BE REMOVED, PATCH FLOOR SLAB TO MATCH (E) FLOOR SLAB.
- 5 (E) PIPING TO REMAIN.
- 6 REMOVE (E) HOSE BIBB AND RELATED PIPING.
- 7 (E) PIPE RISER TO REMAIN.
- 8 (E) FD TO REMAIN.
- 9 REMOVE (E) KITCHEN UNIT AND ASSOCIATED APPURTENANCES, CAP PIPING AND CONCEALED TO WALL, PATCH HOLE TO MATCH (E) FINISHED FLOOR/WALL.
- 10 REMOVE (E) HOT WATER GENERATOR, HOT WATER CIRCULATING PUMP AND ASSOCIATED APPURTENANCES.
- 11 (E) HOSE BIBB TO REMAIN.
- 12 REMOVE (E) FCO.
- 13 PROVIDE CAP ON (E) PIPING.
- 14 REMOVE (E) DF INCLUDING DRAIN, P-TRAP & PROVIDE CAPS ON (E) CW, W, & V PIPING FOR (N) DF.
- 15 (E) JANITOR SINK TO REMAIN.

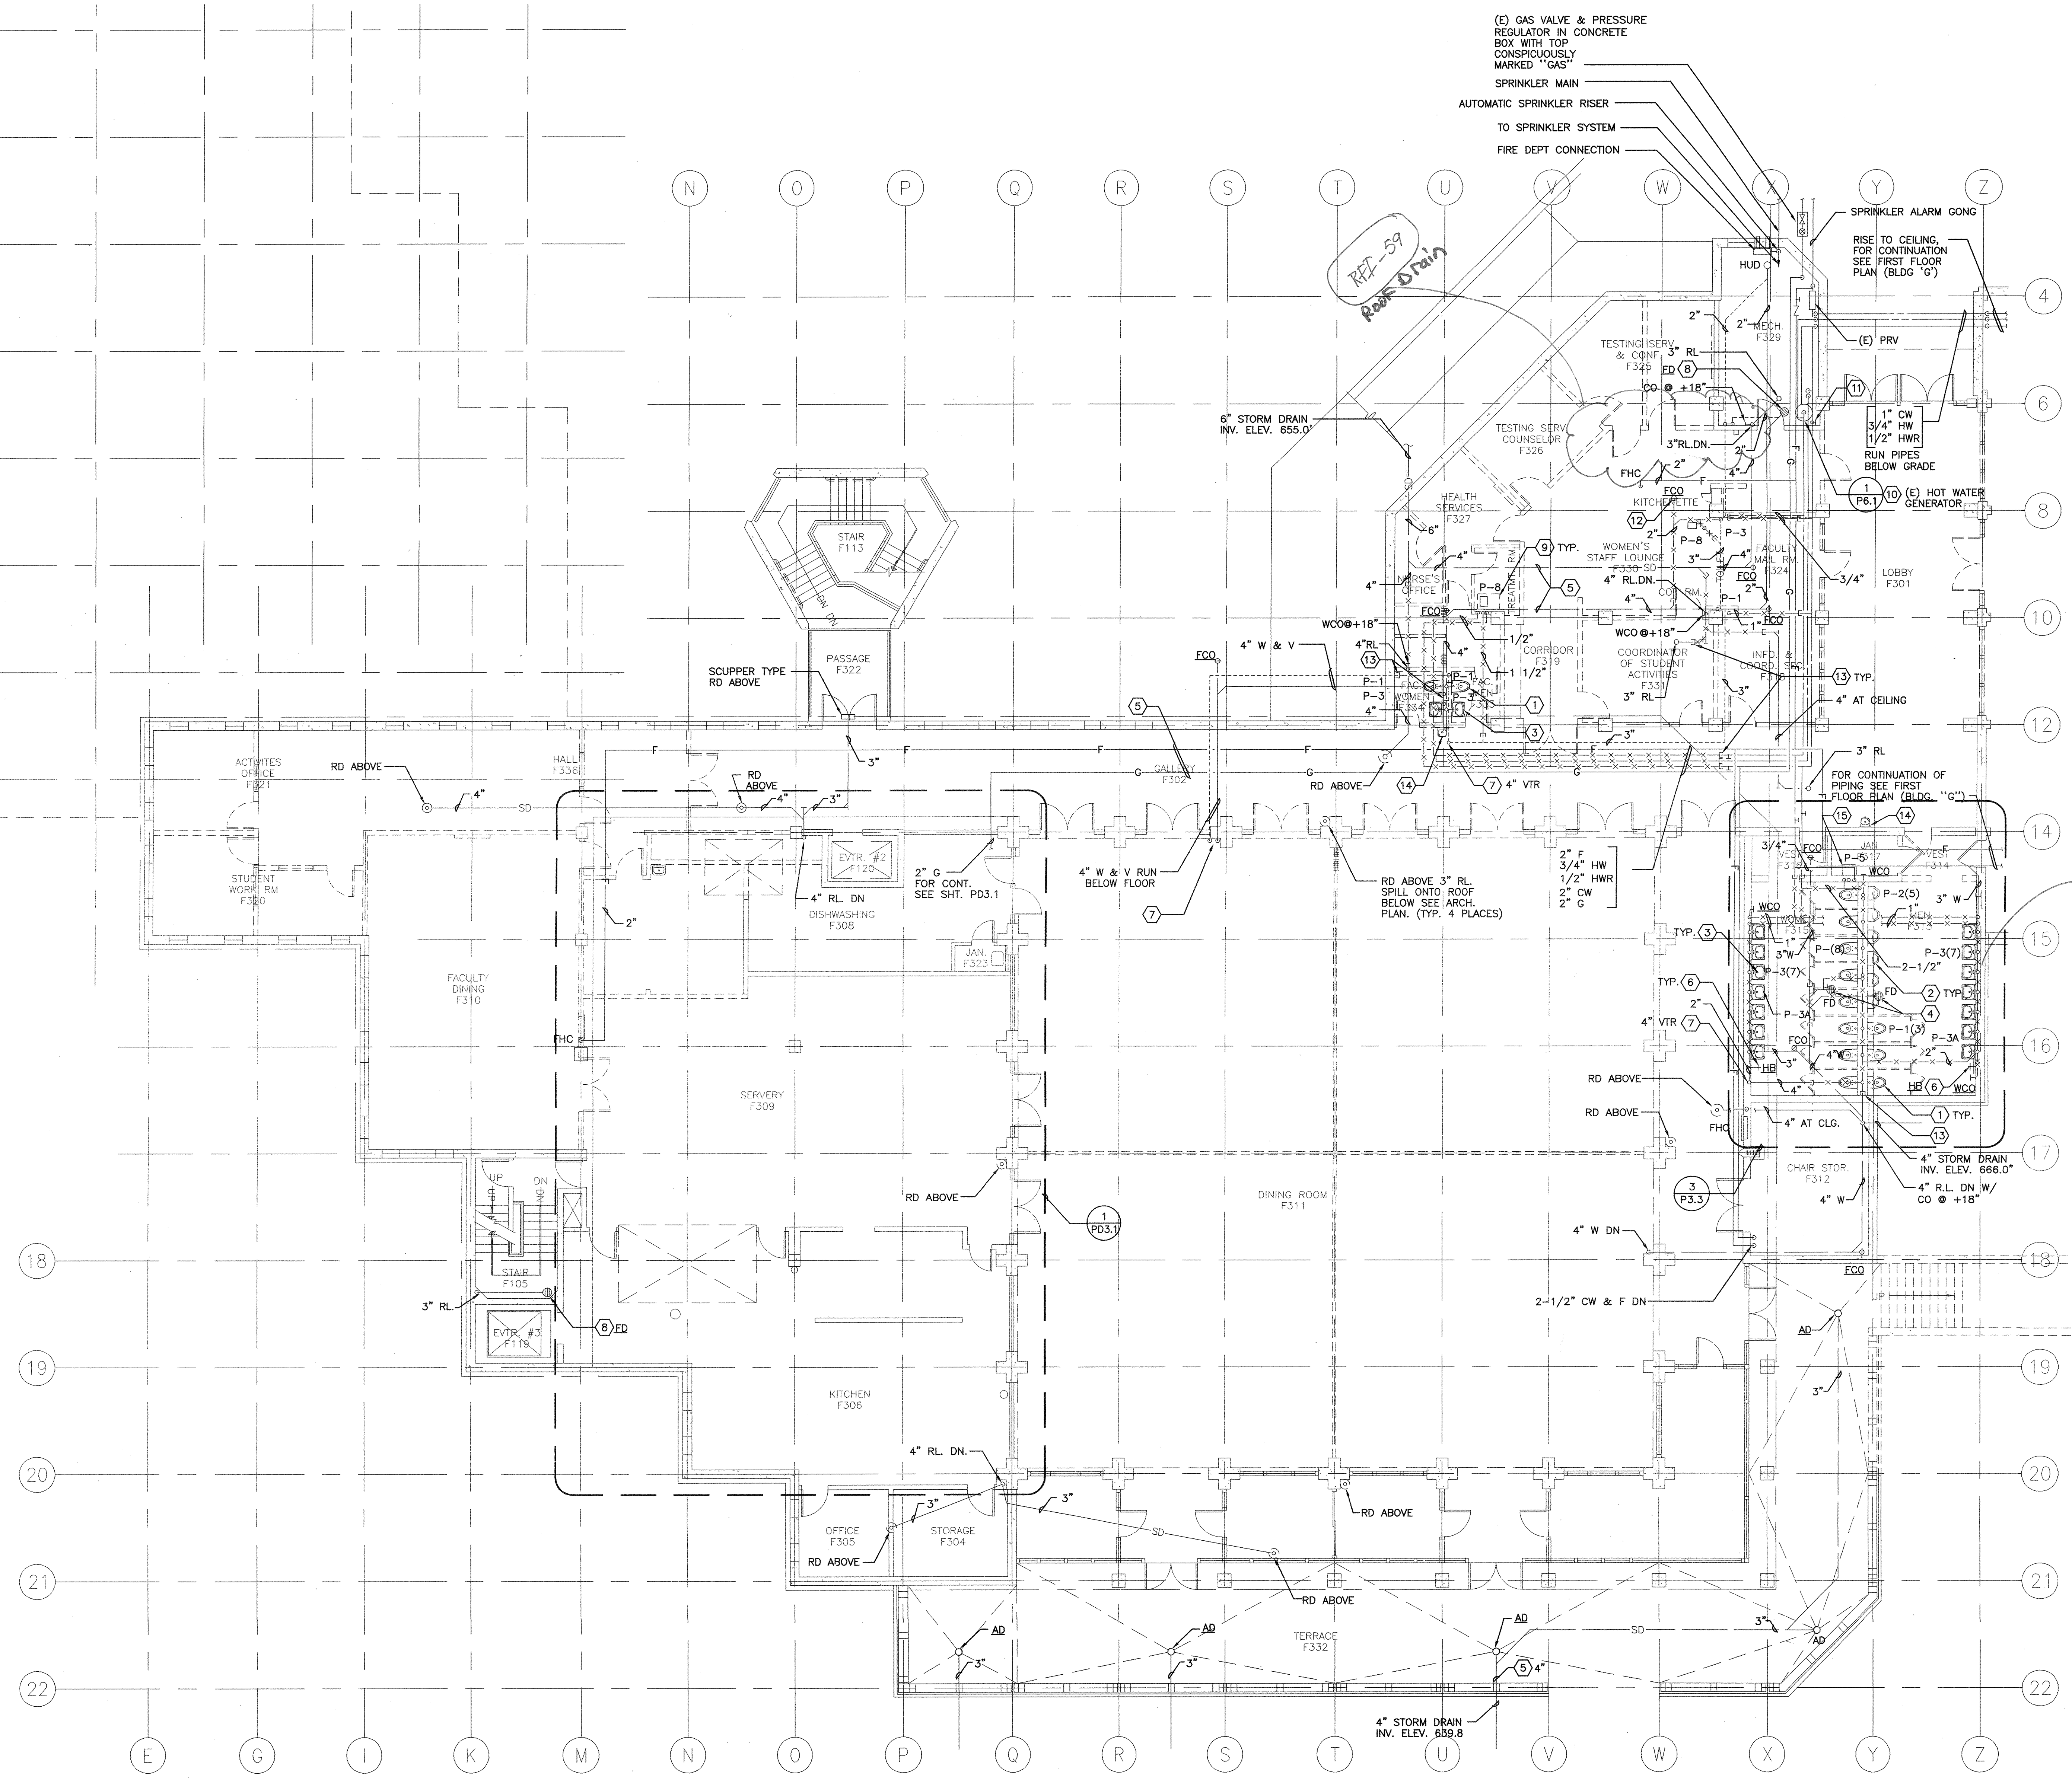

*RFP-62 Existing Building 8 Waste*

**1 THIRD FLOOR DEMOLITION PLAN - PLUMBING**  
SCALE: 1/8"=1'-0"

1. This sheet is part of a set and is not to be used alone.  
2. This sheet is not to be used for construction unless the architect's stamp and signature appear on the drawings and the status box indicates drawings have been released for construction.  
3. These plans and prints thereof, as instruments of service, are owned by the architect and are for use on this project only. Reproduction and/or distribution without the prior written consent of the architect is forbidden.  
4. Copyright Burton Clifford Associates, 2007

REMARKS	DATE

DRAWING STATUS	DATE
<input type="radio"/> DSA PLAN CHECK	
<input type="radio"/> DSA BACK CHECK	
<input type="radio"/> BIDDING (BID #66599)	
<input type="radio"/> CONSTRUCTION	

FILE NO. 41-C1  
IDENTIFICATION STAMP  
DN. OF THE STATE ARCHITECT  
01-110074  
MAR 19 2008

**BUILDINGS 5 & 6 RENOVATIONS**  
San Mateo County Community College District

DSA BACK-CHECK

**CAÑADA COLLEGE**  
4200 Farm Hill Boulevard  
Redwood City, CA 94061

THIRD FLOOR  
DEMOLITION PLAN  
PLUMBING

Date: 01/22/09  
Scale: AS NOTED  
Project Number: 07013  
Drawing Number: PD1.3