

ALL IDEAS, DESIGNS, ARRANGEMENTS, AND PLANS INDICATED OR REPRESENTED BY THIS DRAWING ARE OWNED BY AND THE PROPERTY OF VERDE DESIGN, INC. AND WERE CREATED, EVOLVED, AND DEVELOPED FOR USE ON AND IN CONNECTION WITH THE SPECIFIED PROJECT. NONE OF SUCH IDEAS, DESIGNS, ARRANGEMENTS OR PLANS SHALL BE USED, REPRODUCED, OR PUBLISHED BY ANY METHOD, IN WHOLE OR IN PART, OR DISCLOSED TO ANY PERSON, FIRM, OR CORPORATION FOR ANY PURPOSE WHATSOEVER WITHOUT WRITTEN PERMISSION OF VERDE DESIGN, INC.

VERDE DESIGN
 LANDSCAPE ARCHITECTURE
 CIVIL ENGINEERING
 SPORT PLANNING & DESIGN
 2455 The Alameda
 Santa Clara, CA 95050
 tel: 408.985.7200
 fax: 408.985.7260
 www.VerdeDesignInc.com



American Consulting Engineers, Inc.
 1500 The Alameda, Suite 200
 San Jose, CA 95128
 Tel: 408/298-2312
 Fax: 408/298-2316
 JOB #E12249.00



SHEET TITLE
PHOTOMETRICS

PROJECT NAME
CANADA COLLEGE TENNIS FACILITY IMPROVEMENTS


PROJECT ADDRESS
**4200 FARM HILL BLVD
 REDWOOD CITY, CA 94061**

SUBMITTAL	DATE
90%	07/30/12
BID SUBMITTAL	08/21/12
ADDENDUM ONE	08/31/12
CONFORM SET	09/24/12

NO.	REVISIONS	DATE
▲		
▲		
▲		
▲		
▲		
▲		

DRAWN BY MM	CHECKED BY SF
DATE ISSUED 08/21/12	SCALE AS NOTED
PROJ. NO. 1207300-1281	
SHEET NO. E1.2	

29 OF 39 SHEETS

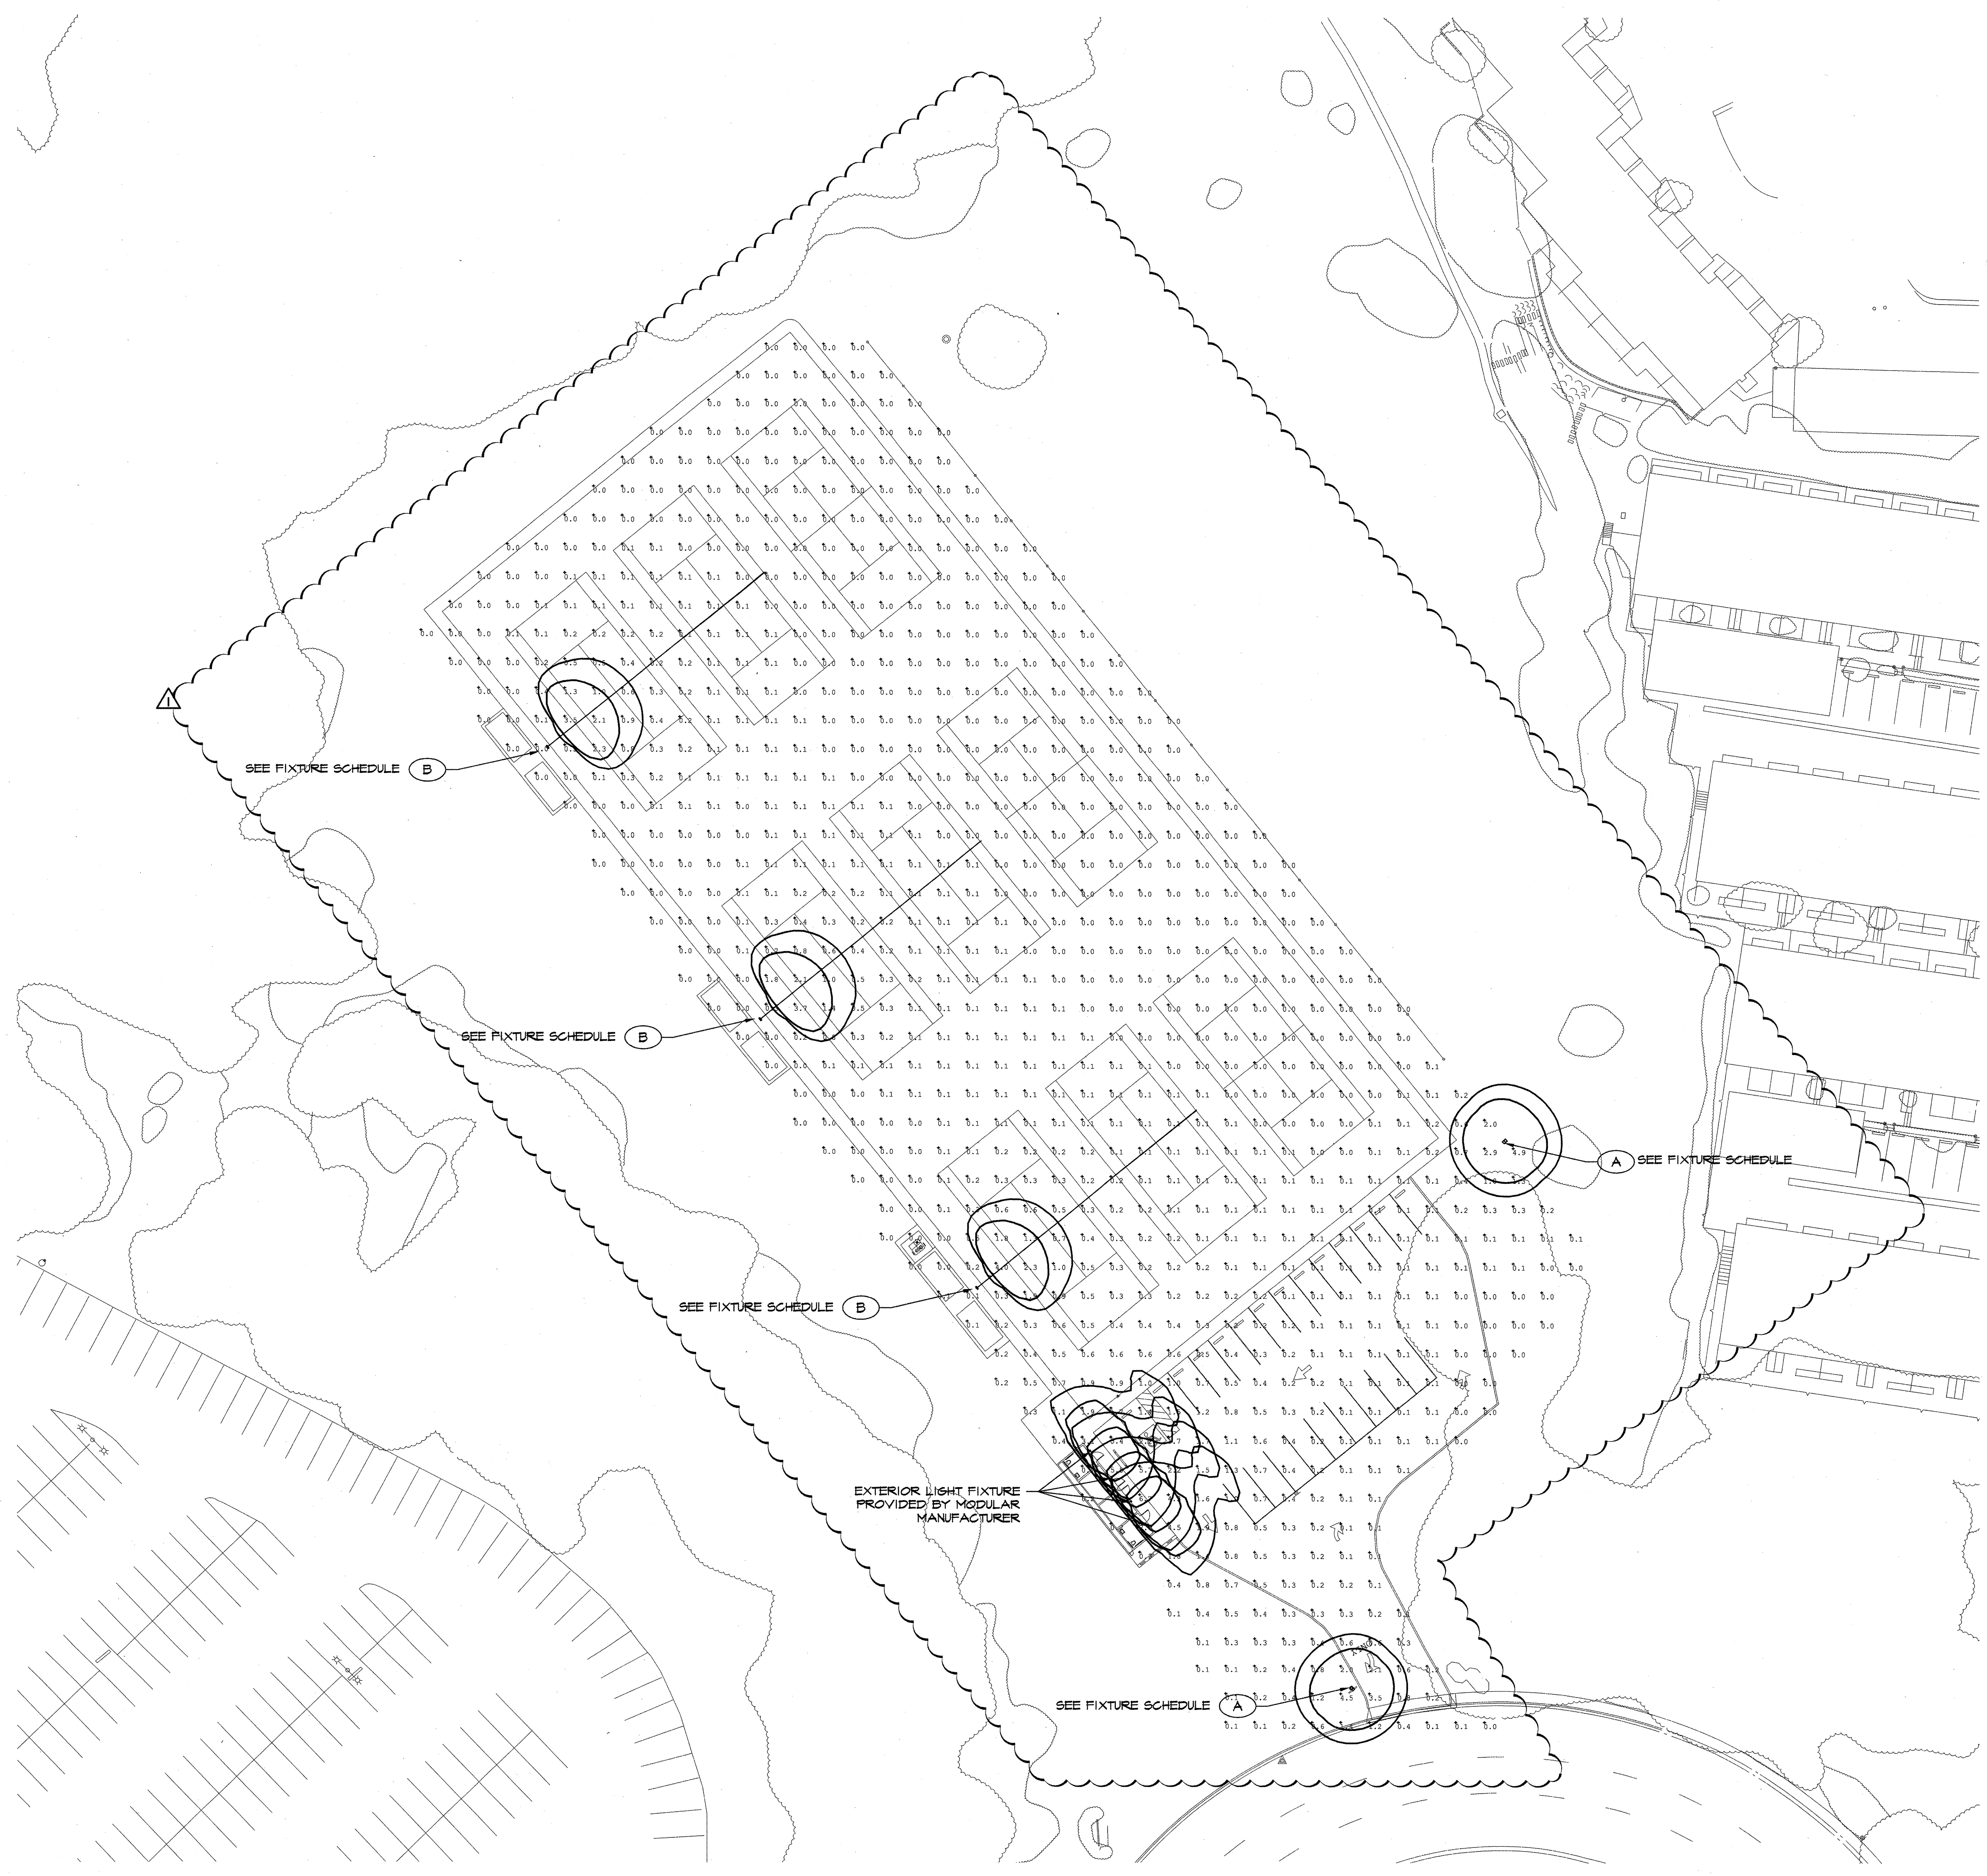

1 PHOTOMETRICS
 E1.2 SCALE: 1" = 30'-0"

