R:\drawings\PROJECTS\OPEN PROJECTS\San Mateo Community College\Drawing Set\ASBUILTS\FO# 1-5.dwg, 2/28/2008 3:20:53 PM, \\Col-fps-01\Xerox 6050 Wide Format

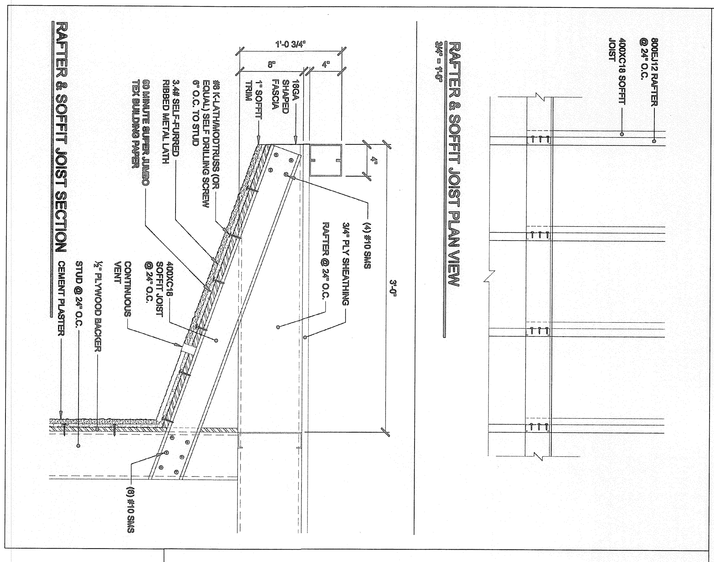

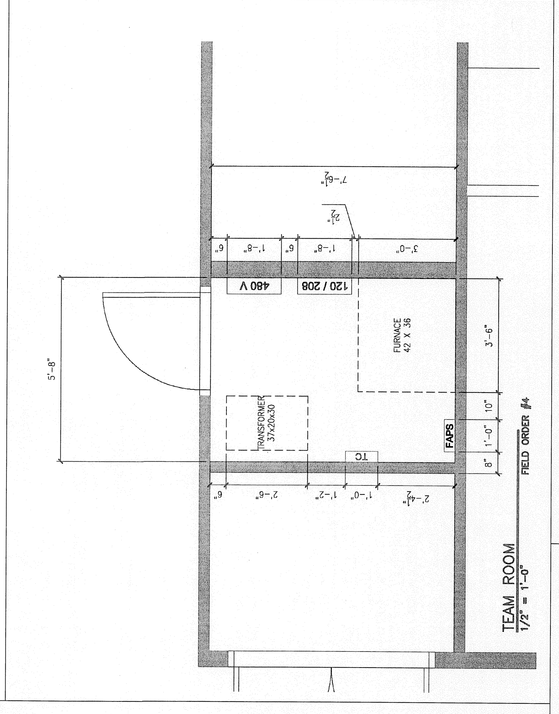

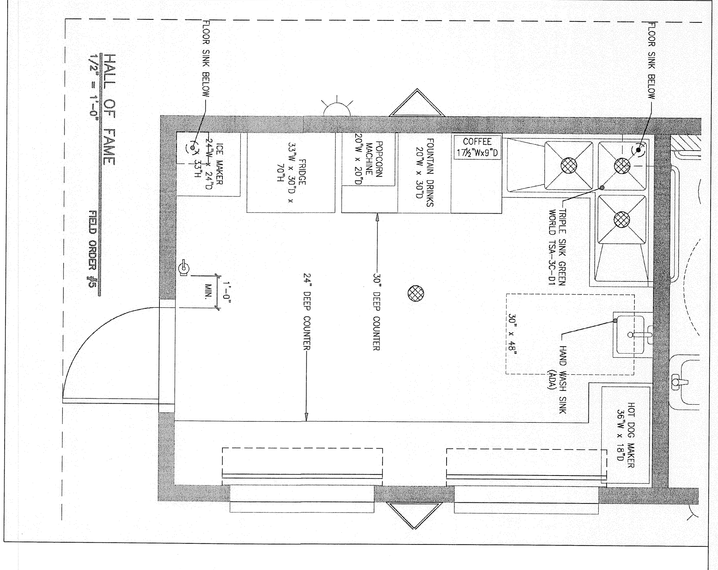

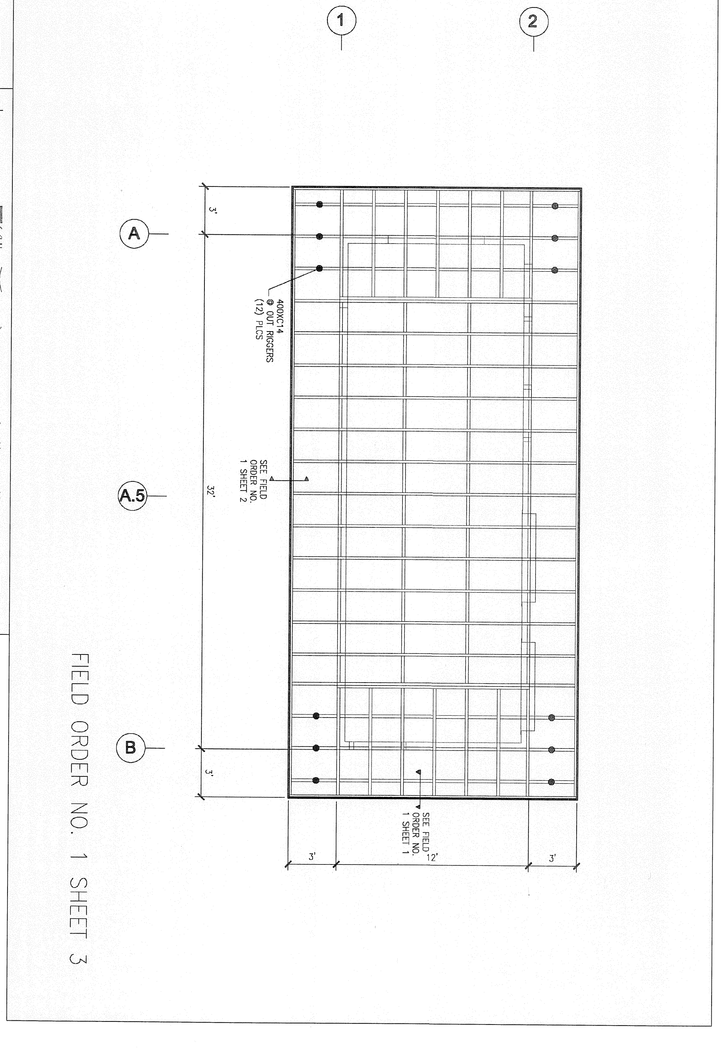

FO#(1-5) AS-BUILT