

COLLEGE OF SAN MATEO
DIVISION OF THE STATE ARCHITECT APPLICATION NUMBERS

BLDG #	BUILDING NAME	DSA #	DATE
1	ADMINISTRATION	19726	
2	MUSIC	19726	
2	CHORAL ROOM REMODEL	101566	6/4/99
3	THEATER	19726	
4	ART	19726	
4A	CERAMICS/SCULPTURE	19726	
5	STUDENT CENTER	25836	
6	MUSEUM	25836	
5/6	ASBESTOS REMOVAL	64532	3/15/96
6	ADD ACCESSIBLE RAMP	102949	7/26/00
7	MAINTENANCE	19726	
8	GYMNASIUM	19726	
8	GYM BLEACHERS	24074	10/2/63
9	LIBRARY	19726	
9	KCSM / FM REMODEL	25836	
10	SEISMIC UPGRADE	61027	5/29/94
11	LIFE SCIENCE	19726	
12	SCIENCE LECTURE	19726	
13	PHYSICAL SCIENCE	19726	
14	PHYSICAL SCIENCE	19726	
15	SOUTH HALL	19726	
16	FACULTY OFFICES	19726	
16	CENTRAL HALL	19726	
16	REMODEL - DISABLED STUDEN SRVS	102949	7/26/00
17	FACULTY OFFICES	19726	
18	NORTH HALL	19726	
18	ASBESTOS REMOVAL	100439	5/27/98
19	READING CENTER REMODEL	102949	7/26/00
19	ENGINEERING / ELECTRONICS	19726	
20	EOPS / MULTICULTURAL CENTER	19726	
20A	HORTICULTURE	19726	
21	COSMETOLOGY	19726	
22	HEALTH OCCUPATION	19726	
23	CONSUMER ARTS & SCIENCE - NURSING	57077	
24	LOCKER ROOMS	19726	
25	AERONAUTICS	19726	
26	TECHNICAL LECTURE	19726	
27	TRADES & INDUSTRY	19726	
28	TEST CELL	19726	
29	CANTEEN	29088	6/20/67
30	TEAM CELL	19726	
30A	TRACK TOILET ROOM	19726	12/1/60
31	TICKETS	19726	
33	CHILD CARE CENTER	47780	4/21/80
34	BUTLER BUILDING	61027	
A	DISTRICT ADMIN. OFFICE	40115	
	COLONNADES SEISMIC UPGRADE	61238	3/11/94
	ELEVATOR ADDITION	54663	
	HANDRAIL / GUARDRAIL UPGRADE	100440	5/27/98
	SPRINT CELL SITE	67891	6/3/97
	STADIUM BLEACHERS	24929	6/23/64

SYMBOLS/LEGENDS

- PEDESTRIAN ACCESSIBLE PATH OF TRAVEL
- ⇒⇒⇒⇒ VEHICULAR ACCESS


LOCAL FIRE AUTHORITY REVIEW

① ACCESS ROADS AND GATE ENTRANCES ARE IN ACCORDANCE WITH TITLE 19, CALIFORNIA CODE OF REGULATIONS SUBCHAPTER 1, ARTICLE 3.05 (ACCESS ROADS) AND ARTICLE 3.16 (GATE ENTRANCES) TO SCHOOL SITES.

② FIRE FLOW, FIRE HYDRANT LOCATION AND DISTRIBUTION ARE IN ACCORDANCE WITH CALIFORNIA FIRE CODE, APPENDIX III-BB (HYDRANT LOCATION)

LOCAL FIRE AUTHORITY SAN MATEO FIRE DEPT
 ADDRESS: 1900 O'FARRELL BLVD CITY/STATE/ZIP: SAN MATEO, CA 94403
 PHONE NUMBER: (415) 577-7940 DATE: Aug 9 2007
 APPROVAL ISSUE BY: [Signature] SIGNATURE: MARISE PONG
 RANK/TITLE: DEPUTY FIRE MARSHAL
 COMMENT: OK

(A SIGNATURE ABOVE SIGNIFIES THAT THE LOCAL FIRE AUTHORITY WAS CONSULTED REGARDING THE ACCESS ROADS, GATES IN THE PERIMETER FENCES, (WHERE APPLICABLE) LOCATIONS OF MAIN FIRE ALARM CONTROL PANELS (FACP) AND ANNUNCIATOR PANELS, FIRE HYDRANTS AND FIRE FLOW, POST INDICATOR VALVES (PIV'S), FIRE DEPARTMENT CONNECTIONS (FDC'S), PORTABLE FIRE EXTINGUISHERS, AND FIRE PROTECTION DURING CONSTRUCTION. METHODS INDICATED ON THE PLANS AND IN SPECIFICATION ARE CONSIDERED ADEQUATE.)

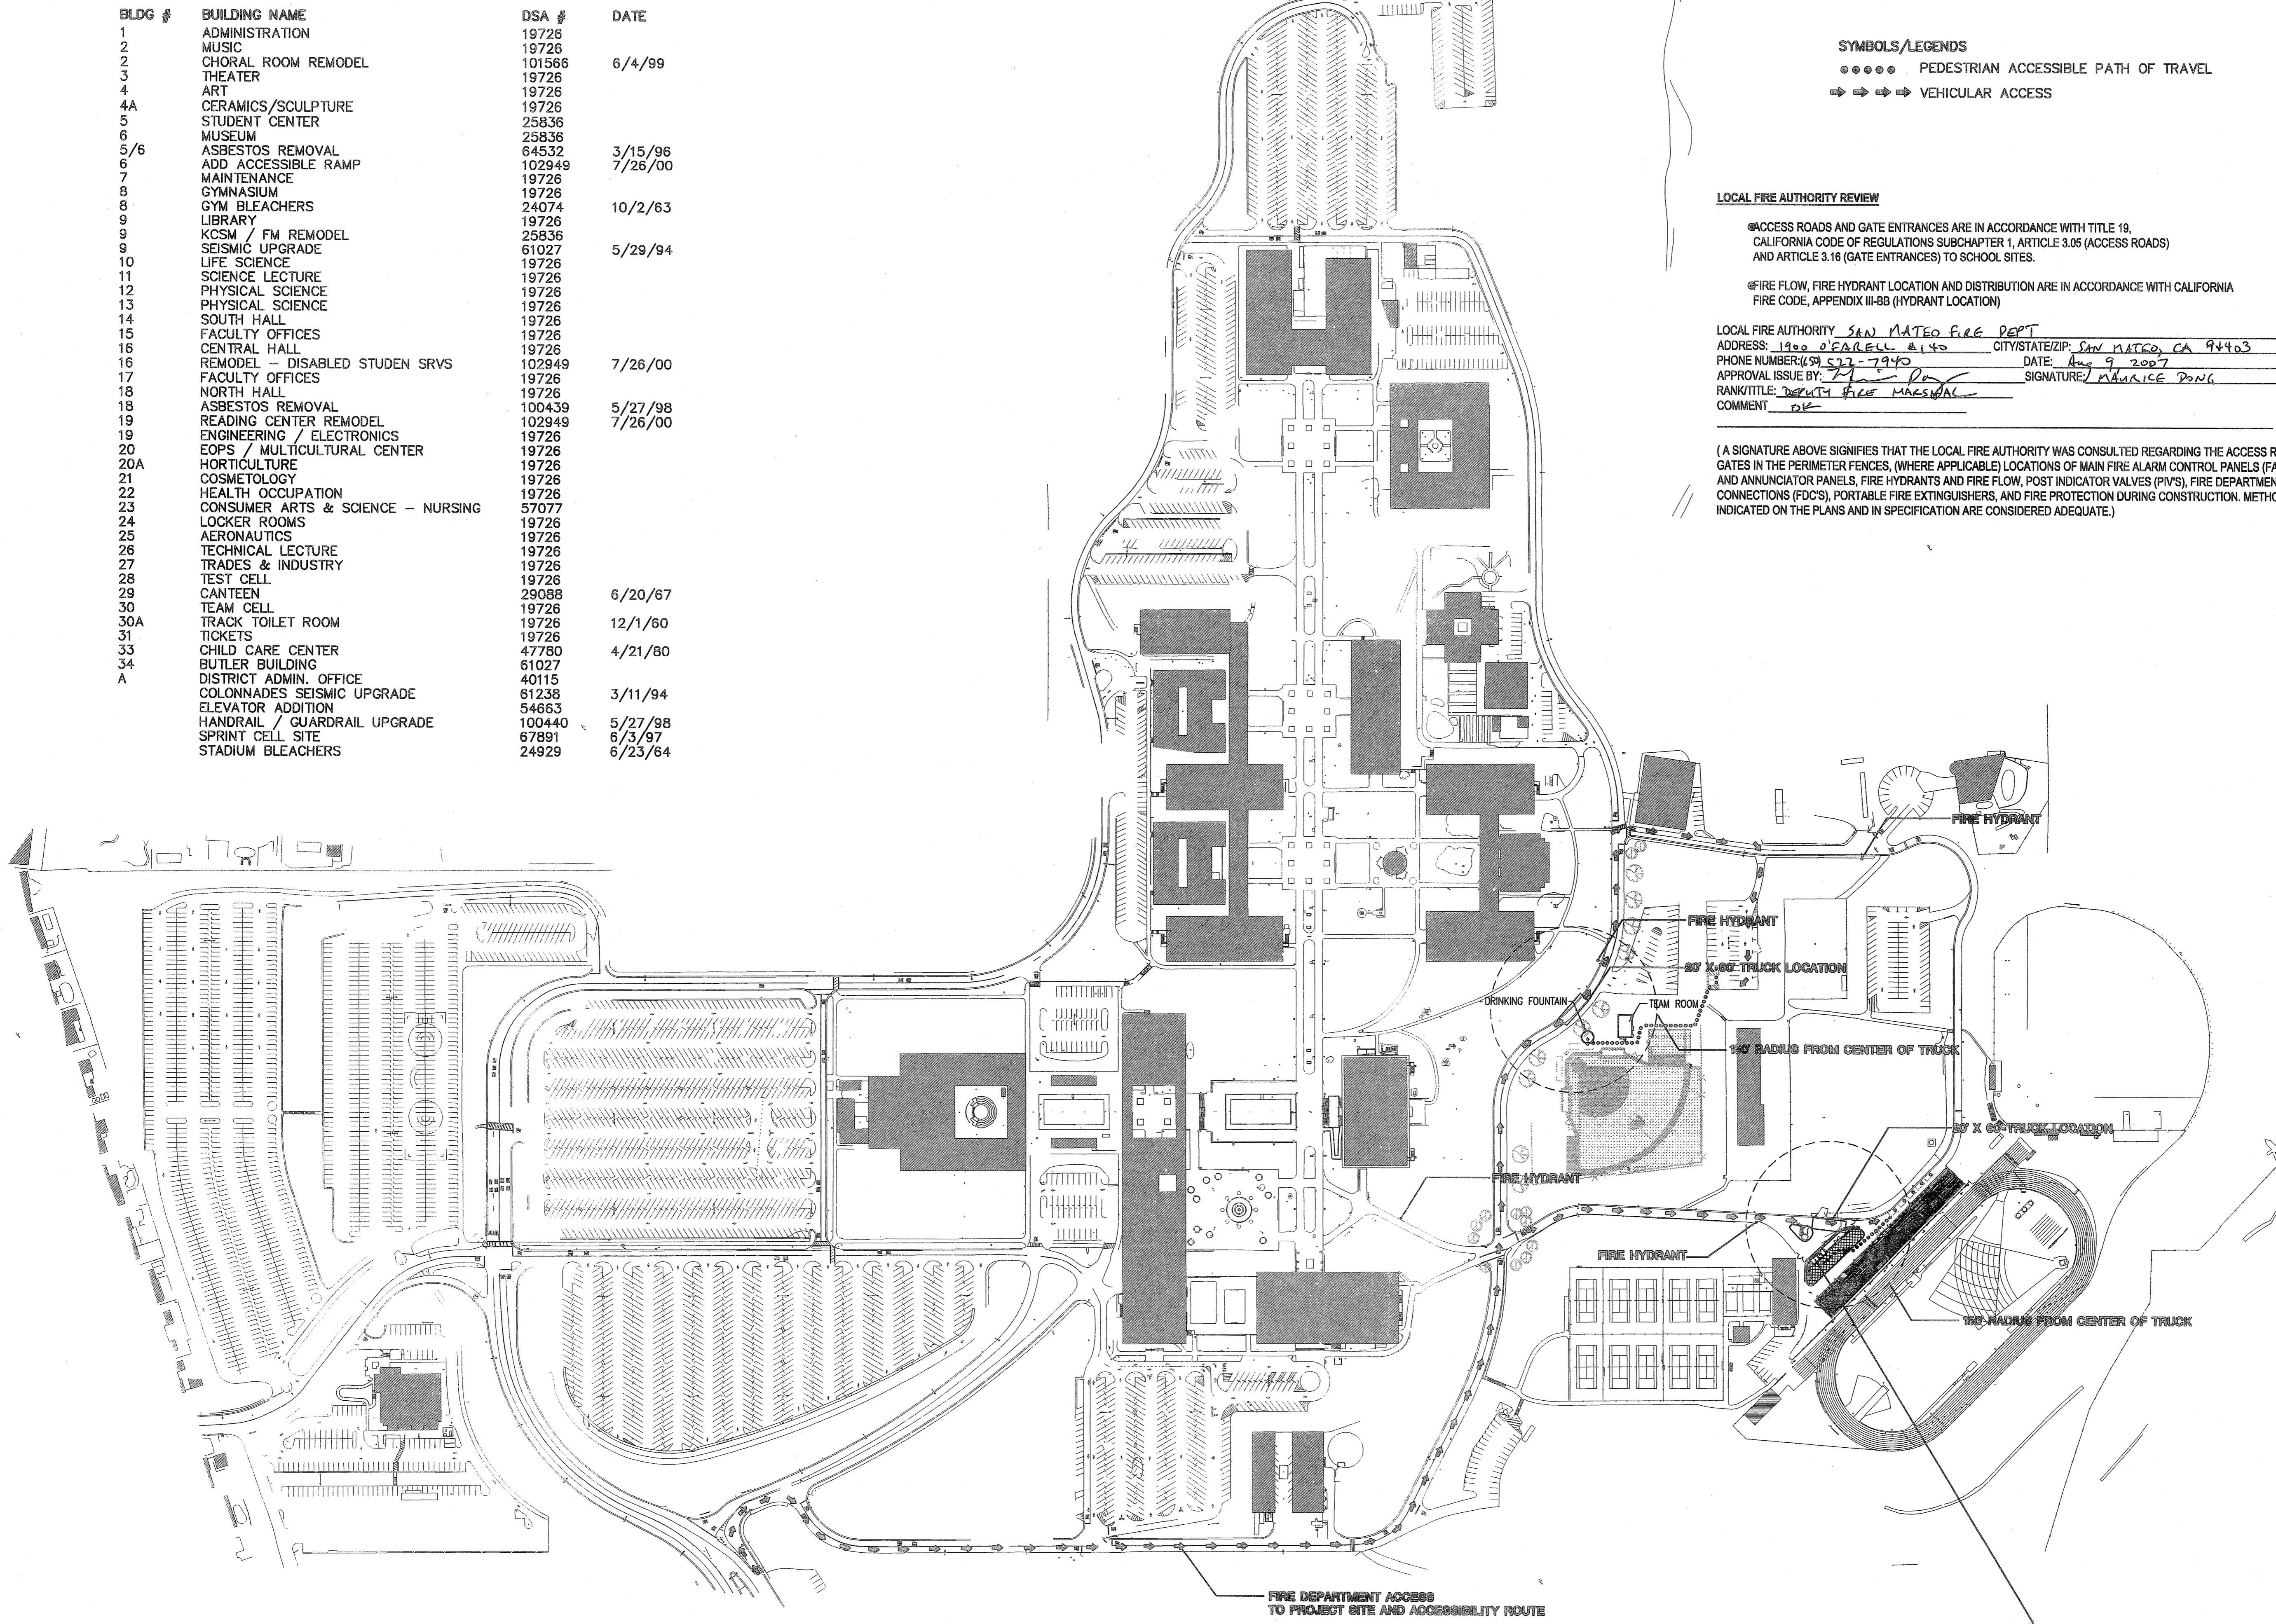

1 ACCESSIBILITY SITE PLAN
NTS

DES
ARCHITECTS
ENGINEERS

399 Bradford Street Redwood City, Ca. 94063
 Tel: (650) 364-6453
 Fax: (650) 364-2618
 www.des-ae.com

SARAMARK
INCORPORATED
SAN JOSE, CALIFORNIA 95154
 Ph: (408) 971-3881
 Fax: (408) 971-3534

ROBERT A. BOTHMAN, INC.
 General Engineering and Building Contractors
 650 QUINN AVENUE
 SAN JOSE, CA. 95112
 Ph: (408) 279-2277
 Fax: (408) 279-2281

SAN MATEO COUNTY
COMMUNITY COLLEGE
DISTRICT
ATHLETIC FIELDS
PHASE 2
 COLLEGE OF SAN MATEO
 SOFTBALL FIELD TEAM ROOM
 & FOOTBALL HALL OF FAME
 San Mateo, Ca. 94402
 1700 W. Hillsdale Blvd.
CAMPUS WIDE SITE PLAN

ISSUE:	DATE:	DESCRIPTION:
DSA	04/26/07	DSA SUBMISSION

DRAWN BY: A.BAKSH
 REVIEWED BY: V.AMRHEIN
 APPROVED BY: V.AMRHEIN
 DES PROJECT NO.: 9126.12

IDENTIFICATION STAMP
 DIVISION OF THE STATE ARCHITECT
 APPL #: 01-108848
 FILE #: 41-C1
 DATE: OCT 10 2007



Aug 08, 2007 - 9:03am P:\SMCCDD\AHP2\9126.12\DWG\1ncr.1, 2 and 6 CSM Softball\1ncr.2_L_DSA SUBMISSION\24x36 00.03.dwg