
(N) 30x26 OPENING
(E) OA OPENING
INSTALL ACOUSTIC DUCT LINING IN SUPPLY AND RETURN DUCT
RELOCATE (E) EXISTING FAN IN THIS LOCATION TO AVOID CONFLICT WITH (N)
(N) 2"Ø CHWS & R
(E) 2"Ø CHWS & R
(N) SHUT OFF VALVES
(E) 3"Ø CHWS
(N) 2"Ø CHWS
ABANDONED HWS & R
(N) VAV-23
(N) VAV-27
(N) VAV-28
(E) RAMP
(E) ENGINEER STORAGE
(E) CORRIDOR
(E) MEN - PSA 6A102
(E) WOMEN - PSA 6A102
(E) JAN
PSA 6A102
F.S.D.
UP
DN
LAND'G
BOOK DROP

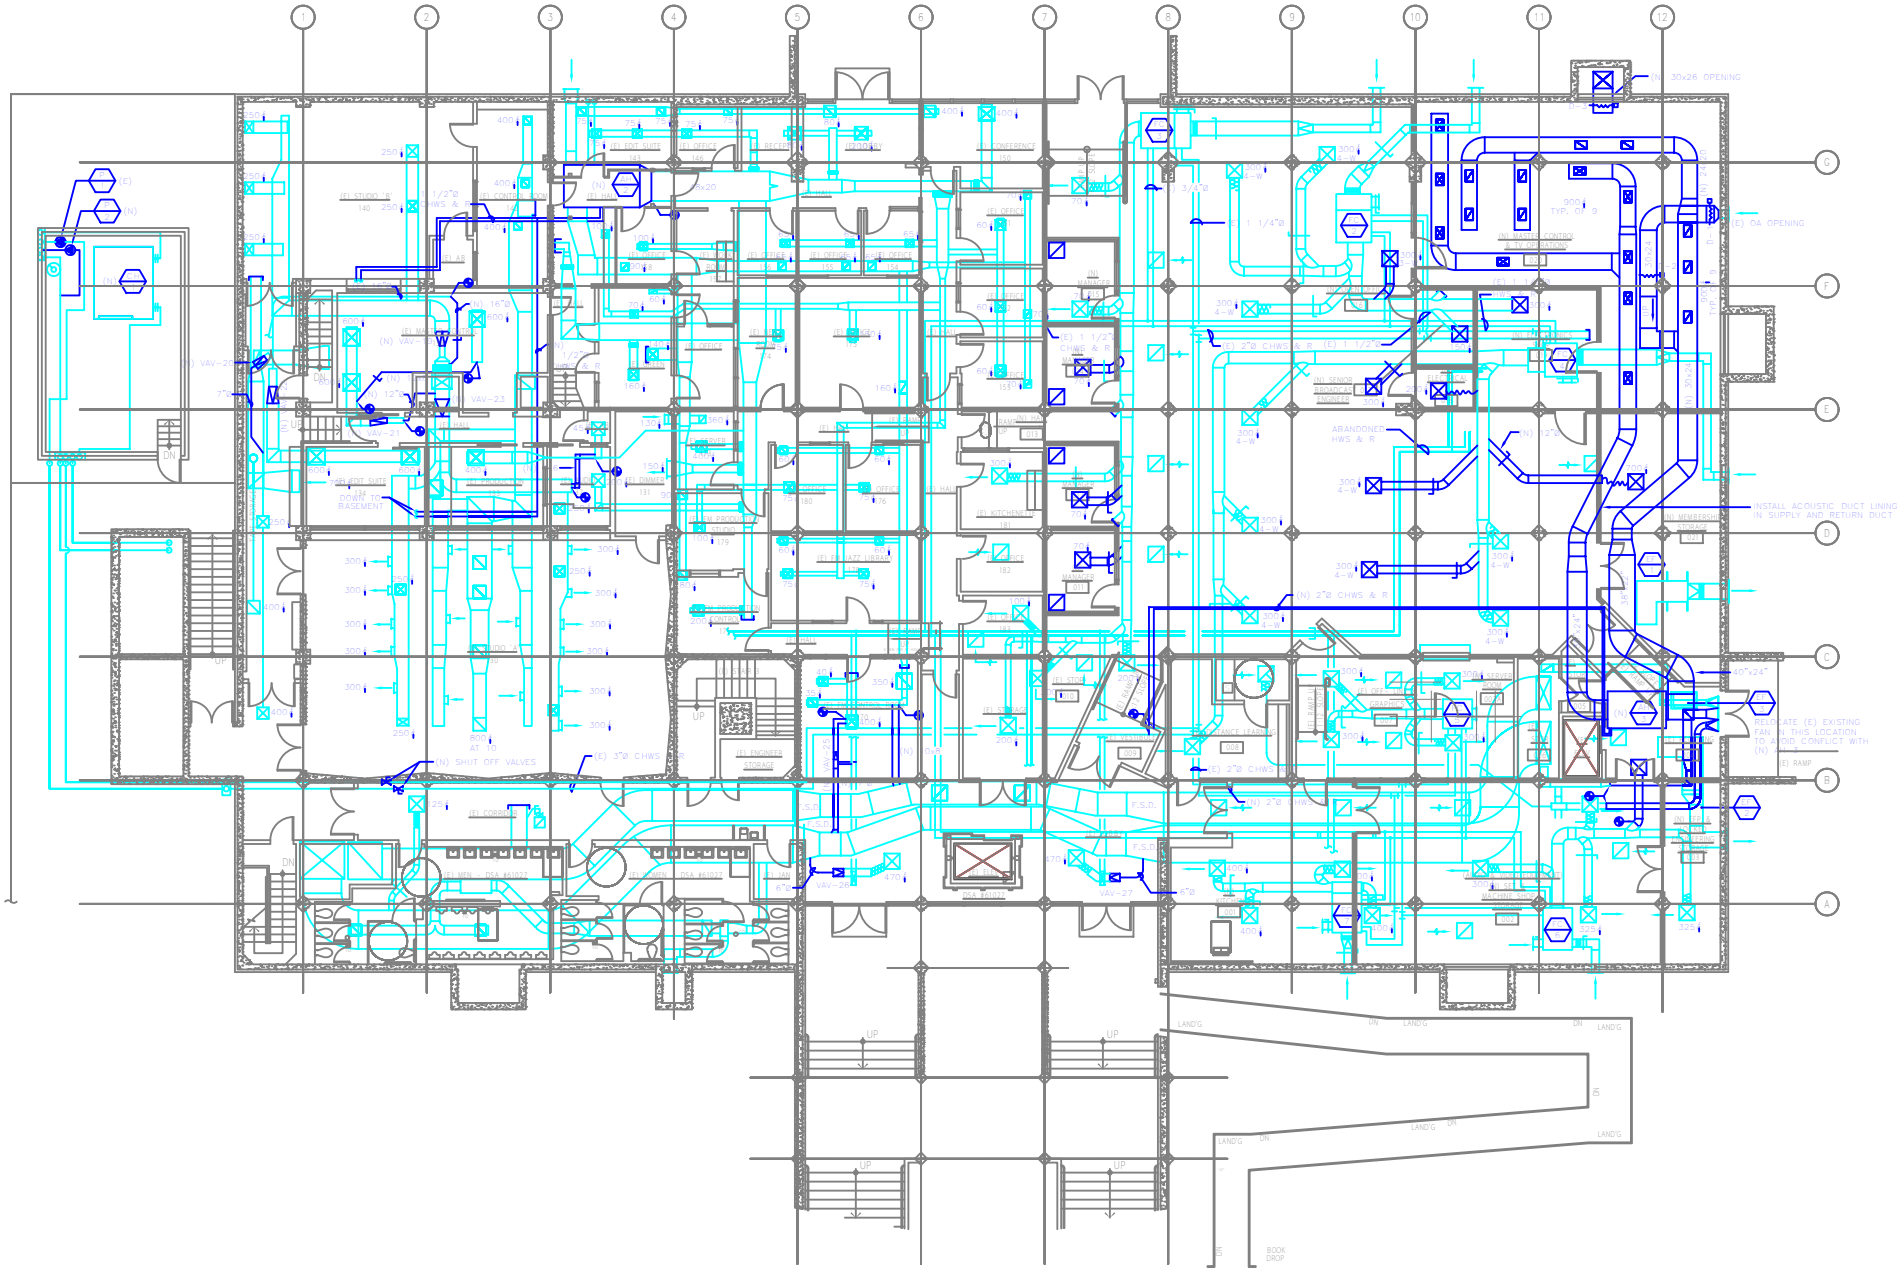


## SHEET NOTES

1. AIR BALANCE THE EXISTING AND NEW DIFFUSERS TO NEW BALANCE FLOW.
2. FAN COIL FC-4 TO BE RELOCATED IN ELECTRONIC SHOP 019 TO AVOID NEW ARCHITECTURAL PARTITIONS.

## NEW CONSTRUCTION NOTES

- FAN COIL FC-4 TO BE RELOCATED INTO ELECTRONIC SHOP 019 CEILING AREA TO AVOID INTERFERENCE WITH NEW ARCHITECTURAL WALL PARTITIONS.
- RELOCATE EXISTING DUCT TO NEW LOCATION AS SHOWN ON DRAWING.
- INSTALL NEW ROOM EXHAUST DUCT THRU EXISTING GLASS ENCLOUSER MAINTAIN HIGHEST ELEVATION FROM FFL. REFER TO SHEET M-08 DETAIL 6.

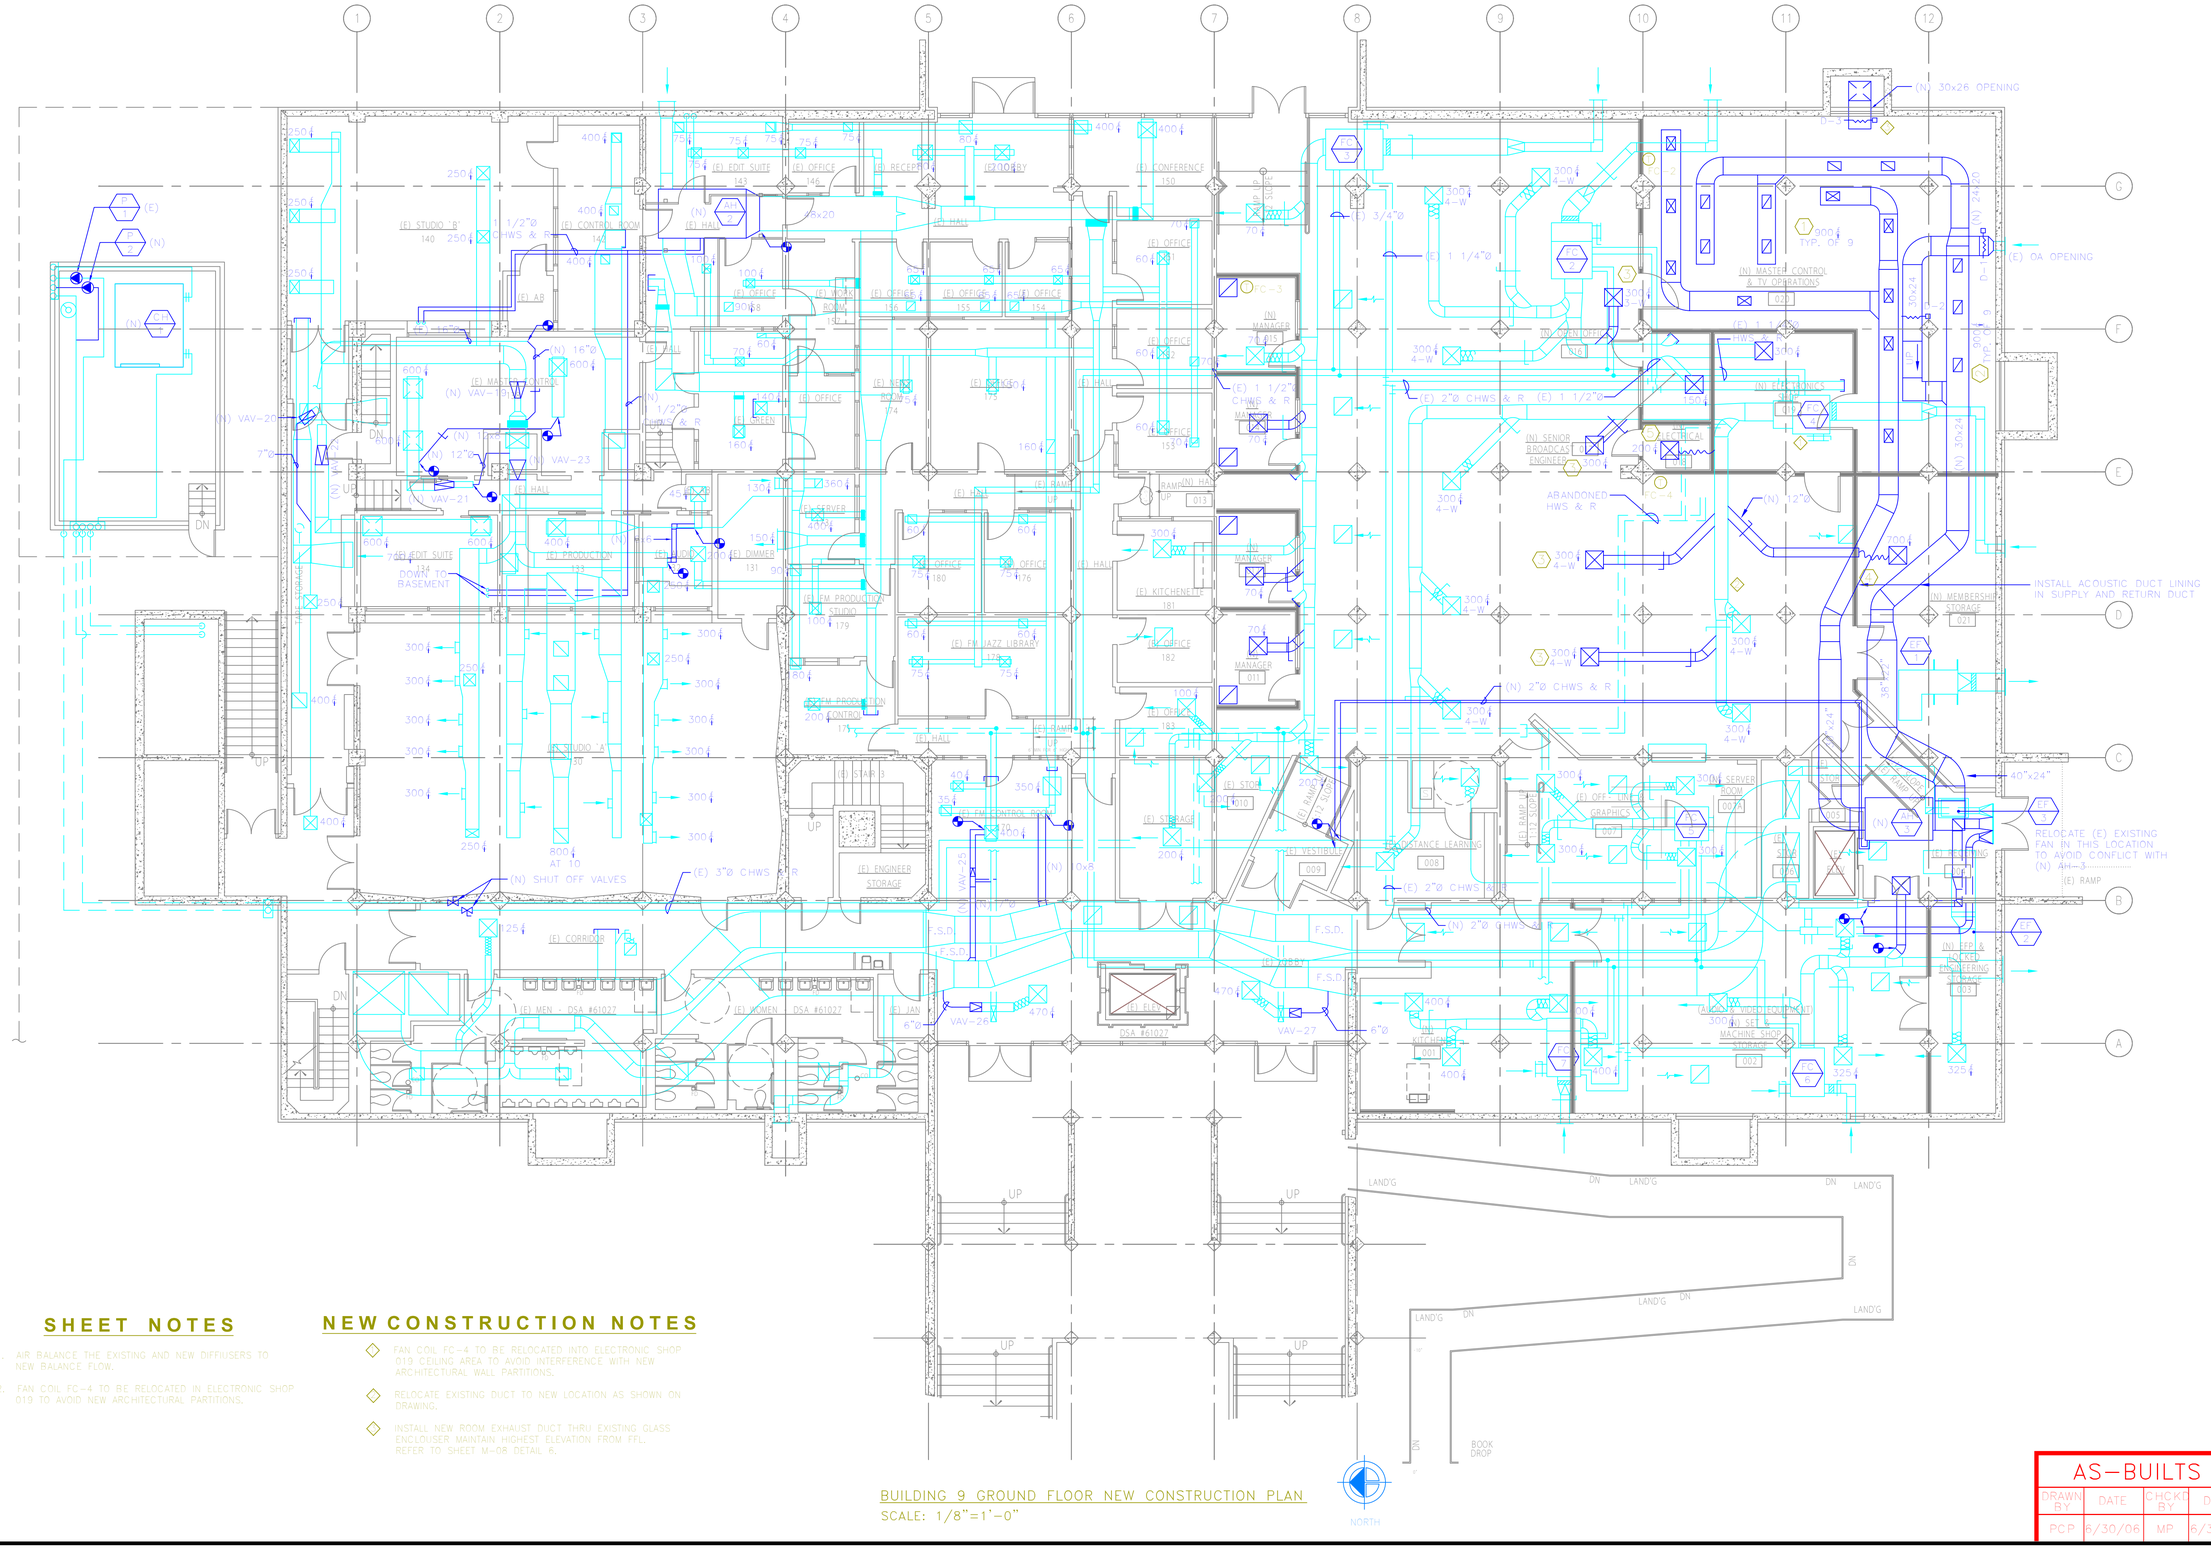BUILDING 9 GROUND FLOOR NEW CONSTRUCTION PLAN
SCALE: 1/8"=1'-0"

| AS-BUILTS | | | |
|---|---|---|---|
| DRAWN BY | DATE | CHCKD BY | DATE |
| PCP | 6/30/06 | MP | 6/30/06 |


Prepared by:
CHEVRON ENERGY SOLUTIONS COMPANY
A Division of Chevron U.S.A. Inc.
SAN FRANCISCO OFFICE
345 CALIFORNIA STREET, 32nd FLOOR
Tel 415 733 4000
Fax 415 733 4000


| REV | DATE | BY | DESCRIPTION |
|---|---|---|---|
| | | | |

# SAN MATEO COUNTY COMMUNITY COLLEGE DIST.

## BUILDING 9 GROUND FLOOR NEW CONSTRUCTION PLAN

| | |
|---|---|
| JOB | 128-41-1 |
| SHEET No. | 1324 |
| DRAWN BY | M. FARSHIDI |
| CHKD BY | PCP |
| CHECKED BY | M. BUGGIA |
| DATE | 02/01/06 |
| SHEET NO | 24x36-NSTD |
| REF1 | XREF |
| REF1 (CONT) | XREF |
| REF2 (CONT) | XREF |
| FILENAME | 1323-MECH-GRND |

**M-06**