


SEE 1/A-10 FOR TYPICAL NOTES


SECTION - CONC. RETAINING WALL CAP

REVISED FROM CONT. STEEL GRATE COVER ON DET. 1/A-1 TO CONT GSM COVER.


AUTOMOTIVE CURM. BUILDING SKYLINE COLLEGE S M E S C D	KELLER and DASEKING ARCHITECTS 825 Oak Grove Avenue MENLO PARK, CA. 94025	8906 3/20/91 AR-1
---	--	-------------------------

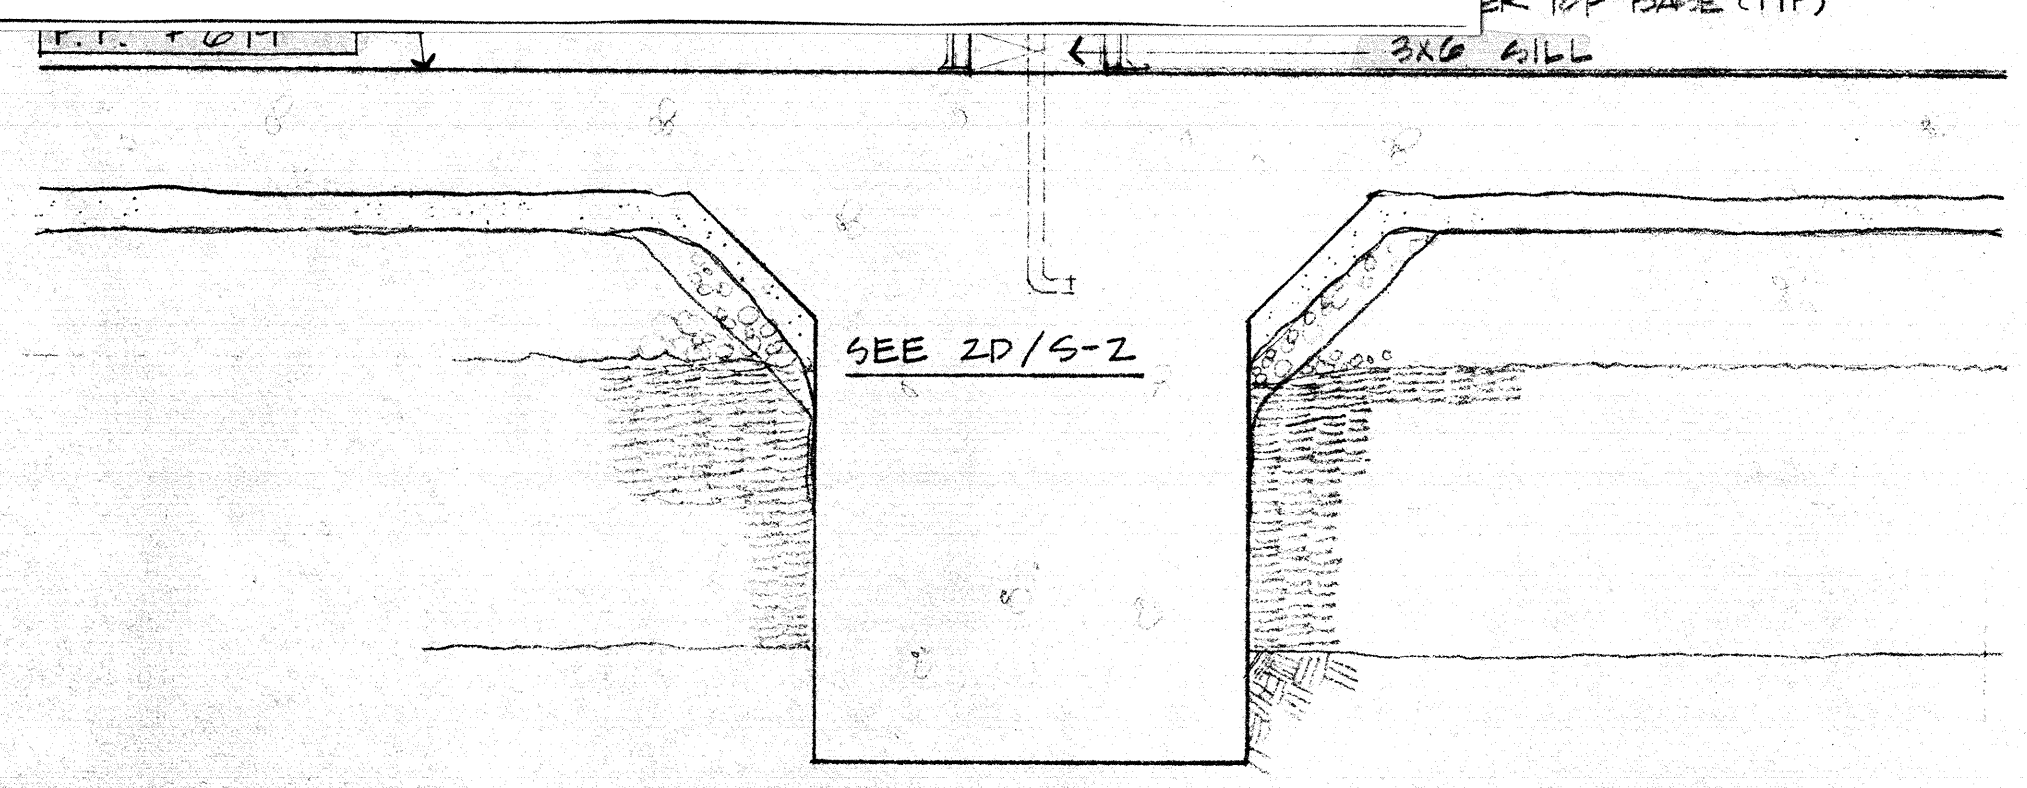

SECTION - INTERIOR WALL @ COLUMN LINE "B" 1/2" = 1'-0" 3

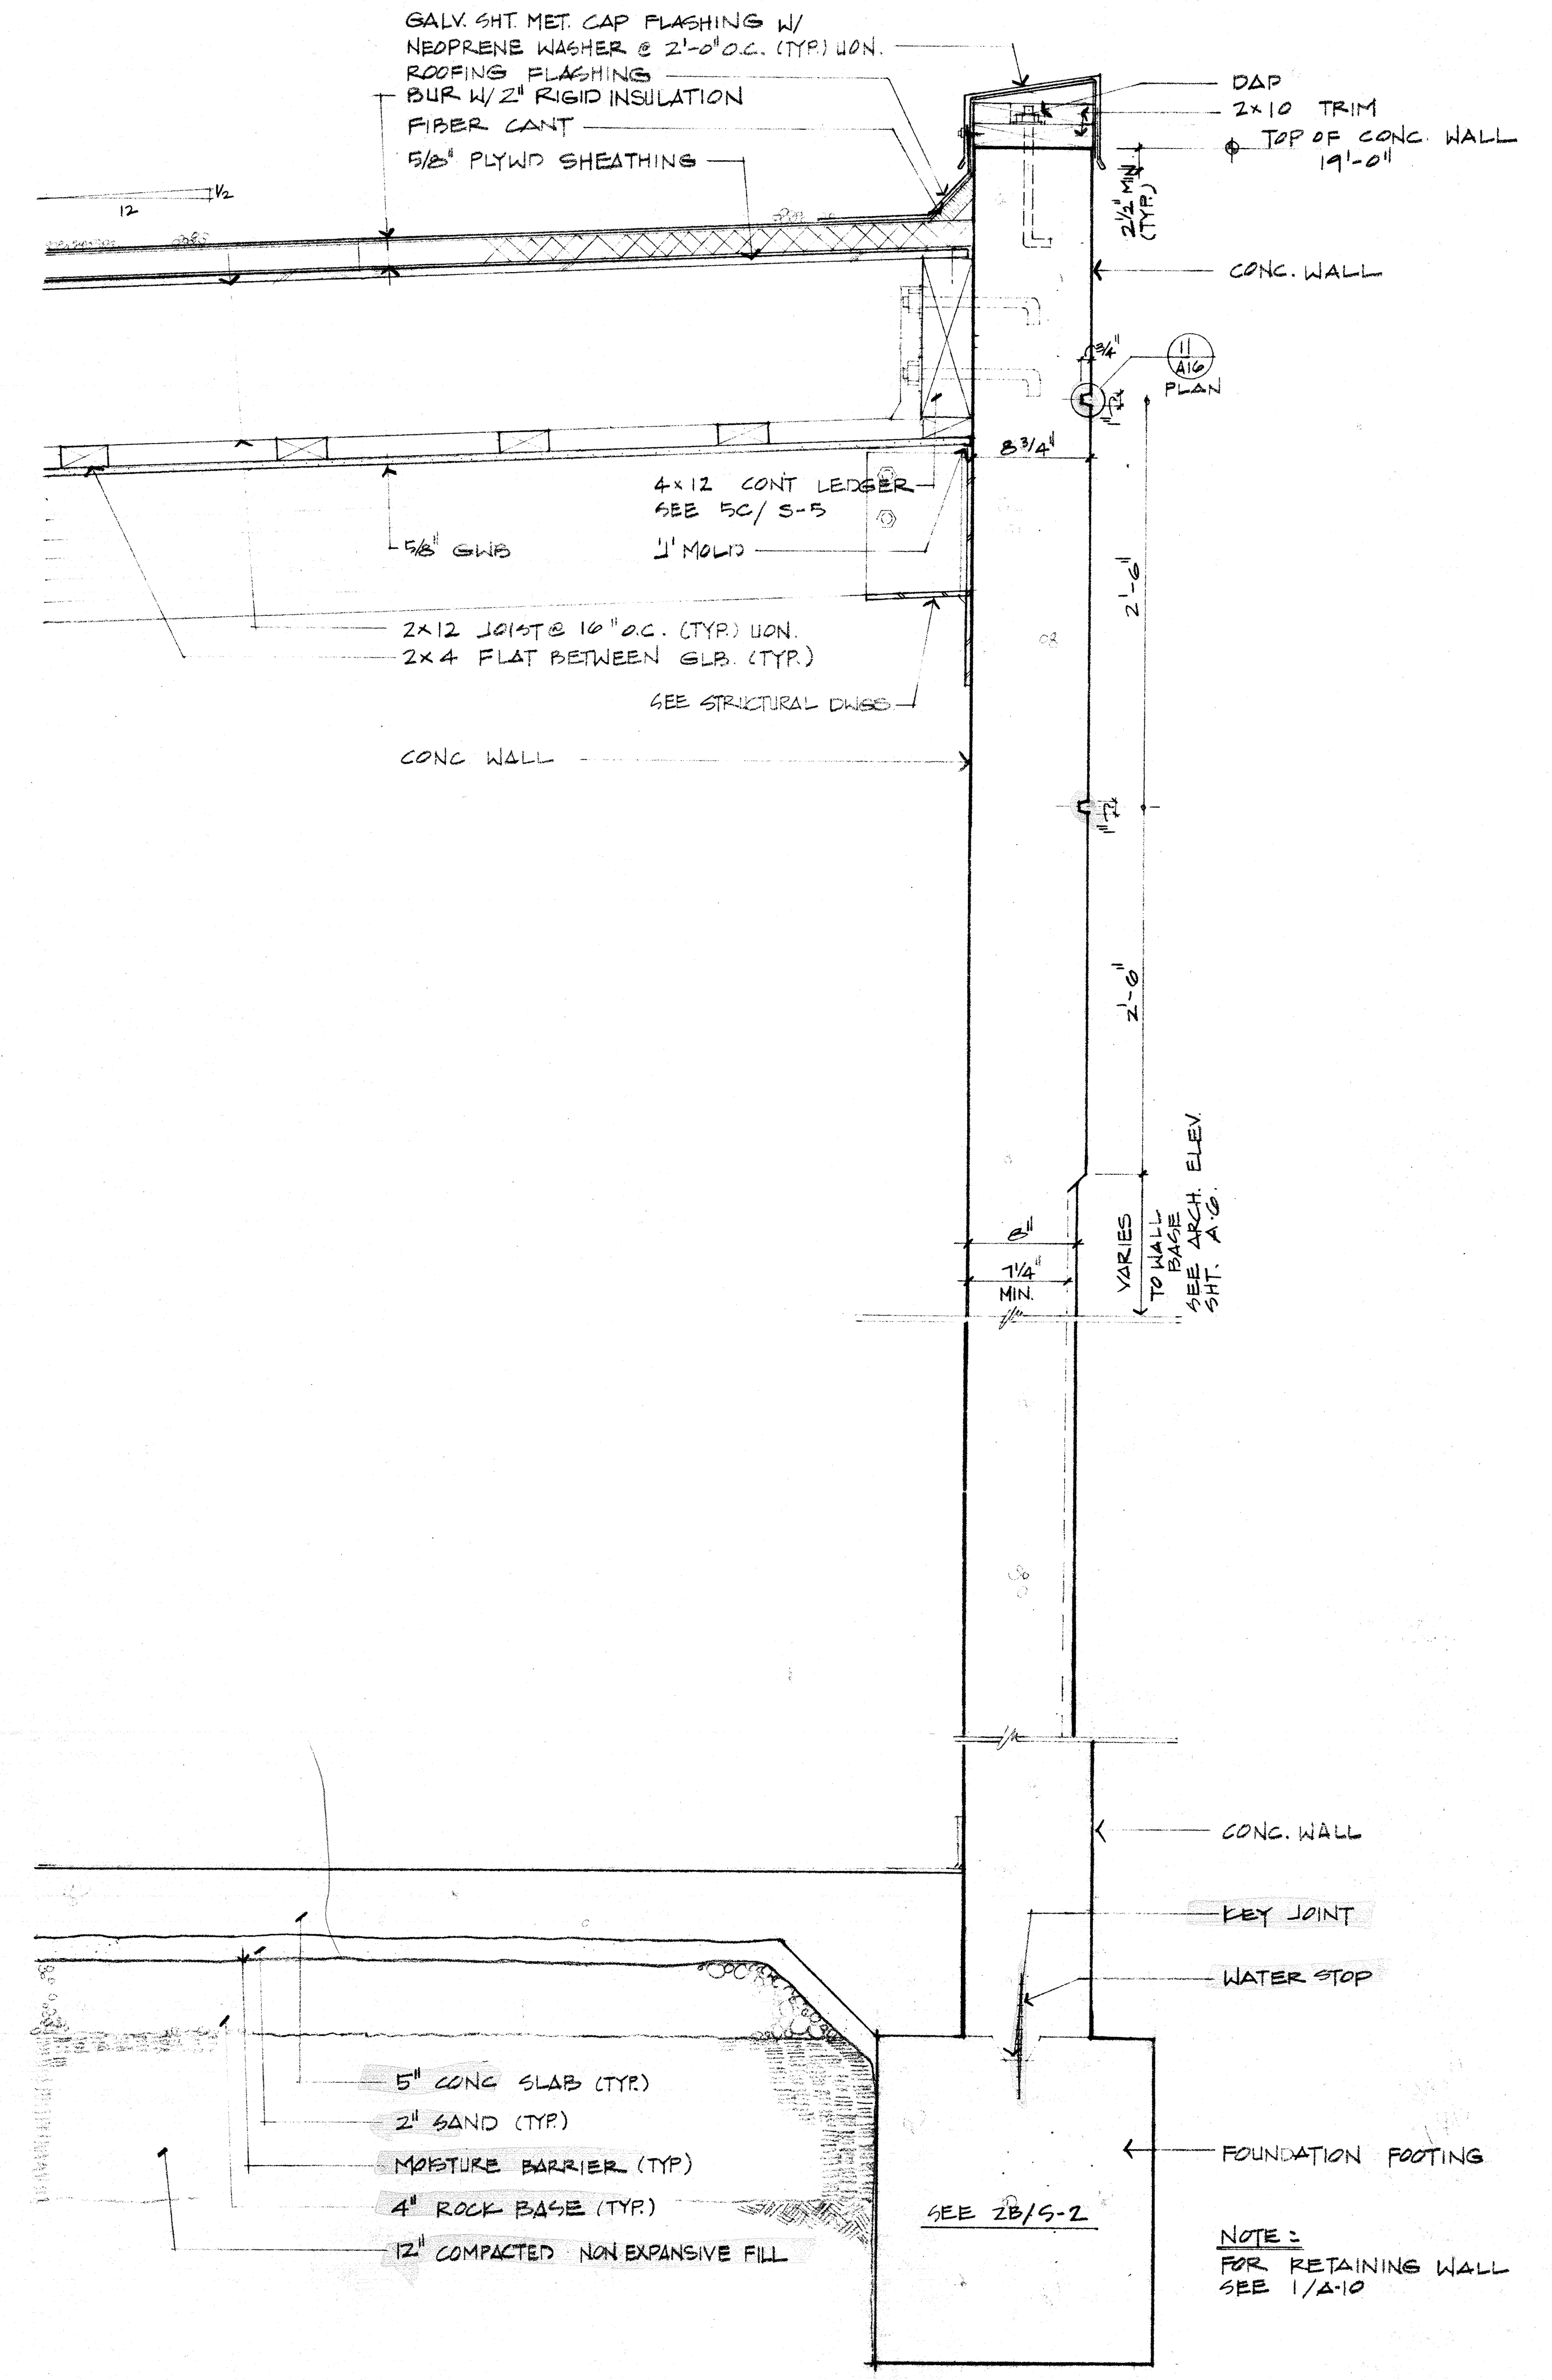

SECTION - CONC REAR WALL @ COLUMN LINE "C" 1/2" = 1'-0" 2

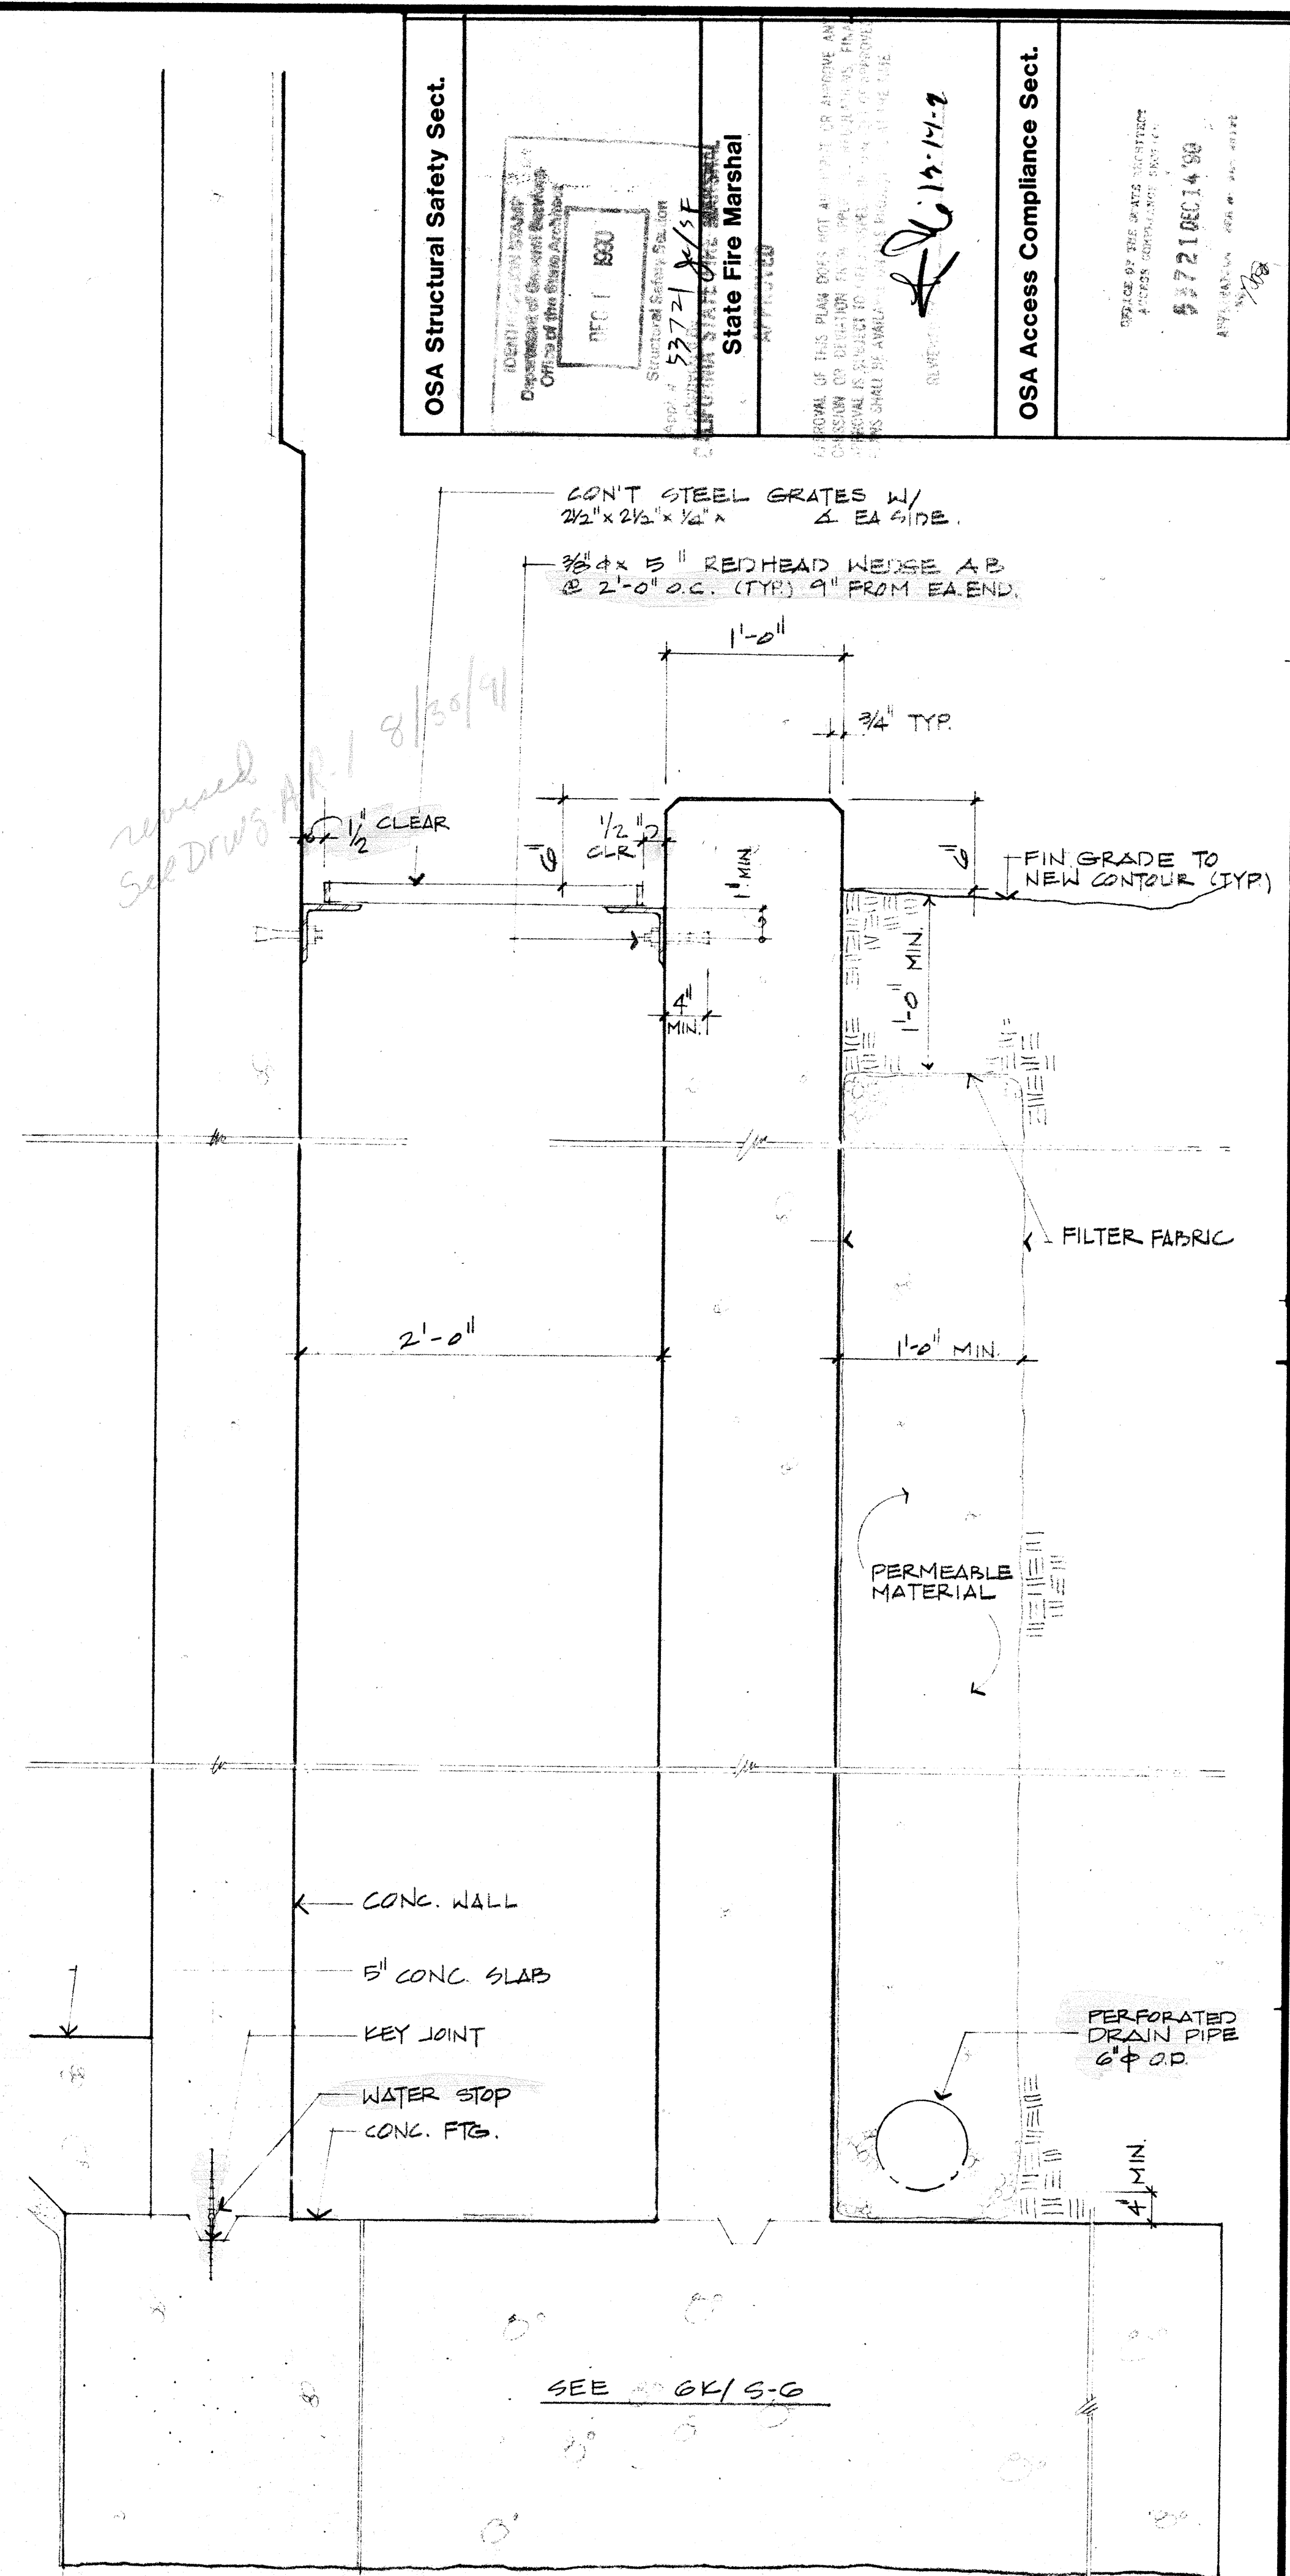

SECTION - CONC. RETAINING WALL 1/2" = 1'-0" 1

---	--

REV 8-22-90

KELLER AND DASEKING ARCHITECTS
WALTER L. KELLER A.I.A.
WILLIAM H. DASEKING A.I.A.
825 OAK GROVE AVENUE
MENLO PARK, CA 94025 415/322-5366

AUTOMOTIVE CLASSROOM BUILDING
TOILET ROOM RENOVATIONS
SKYLINE COLLEGE
SAN MATEO COUNTY COMMUNITY COLLEGE DISTRICT

8906
3.12.90
A10
11 of 41