


FENCE SOUTH ELEVATION

SCALE: 1/4" = 1'-0" 6

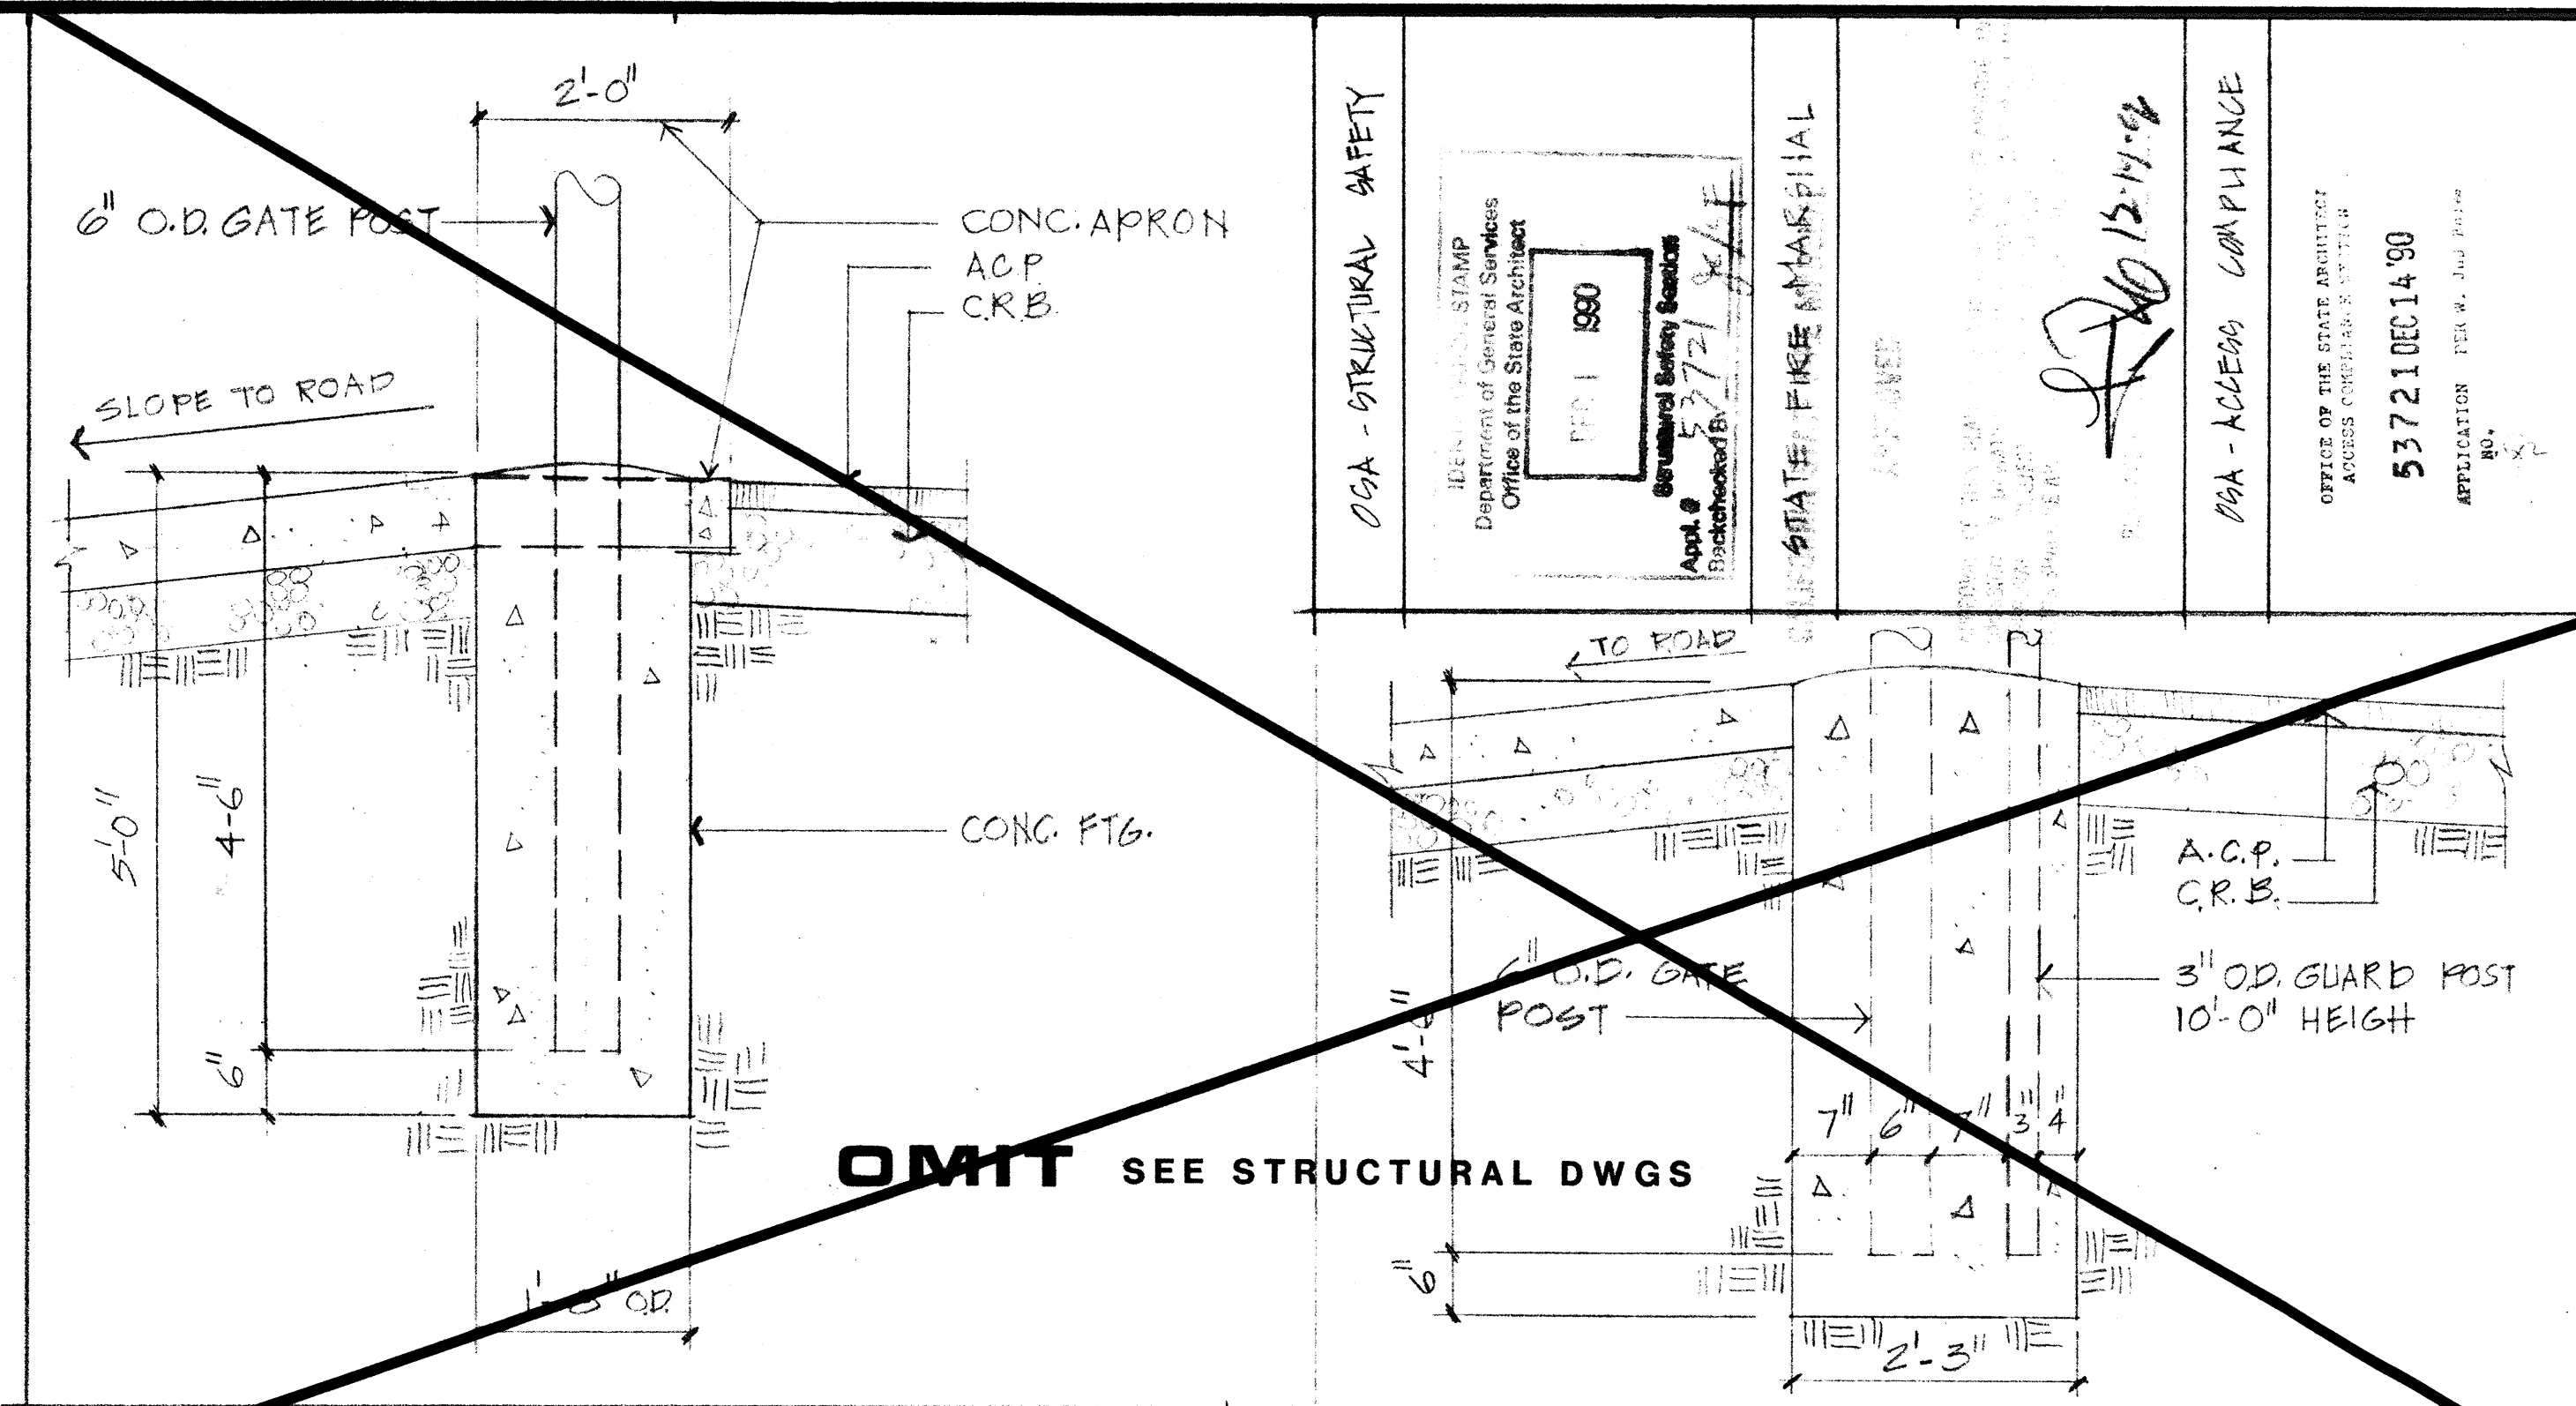


GATE POST FOOTING

SCALE: 3/4" = 1'-0" 5

GATE POST W/GUARD POST


SCALE: 3/4" = 1'-0" 4

STA - STRUCTURAL SAFETY  
 DEPARTMENT OF GENERAL SERVICES  
 OFFICE OF THE STATE ARCHITECT  
 STAMP  
 FEB 1 1990  
 State Architect  
 State of California  
 STATE FIRE MARSHAL  
 12/11/90  
 53721 DEC 14 90  
 APPLICATOR TSM W. J. J. J.

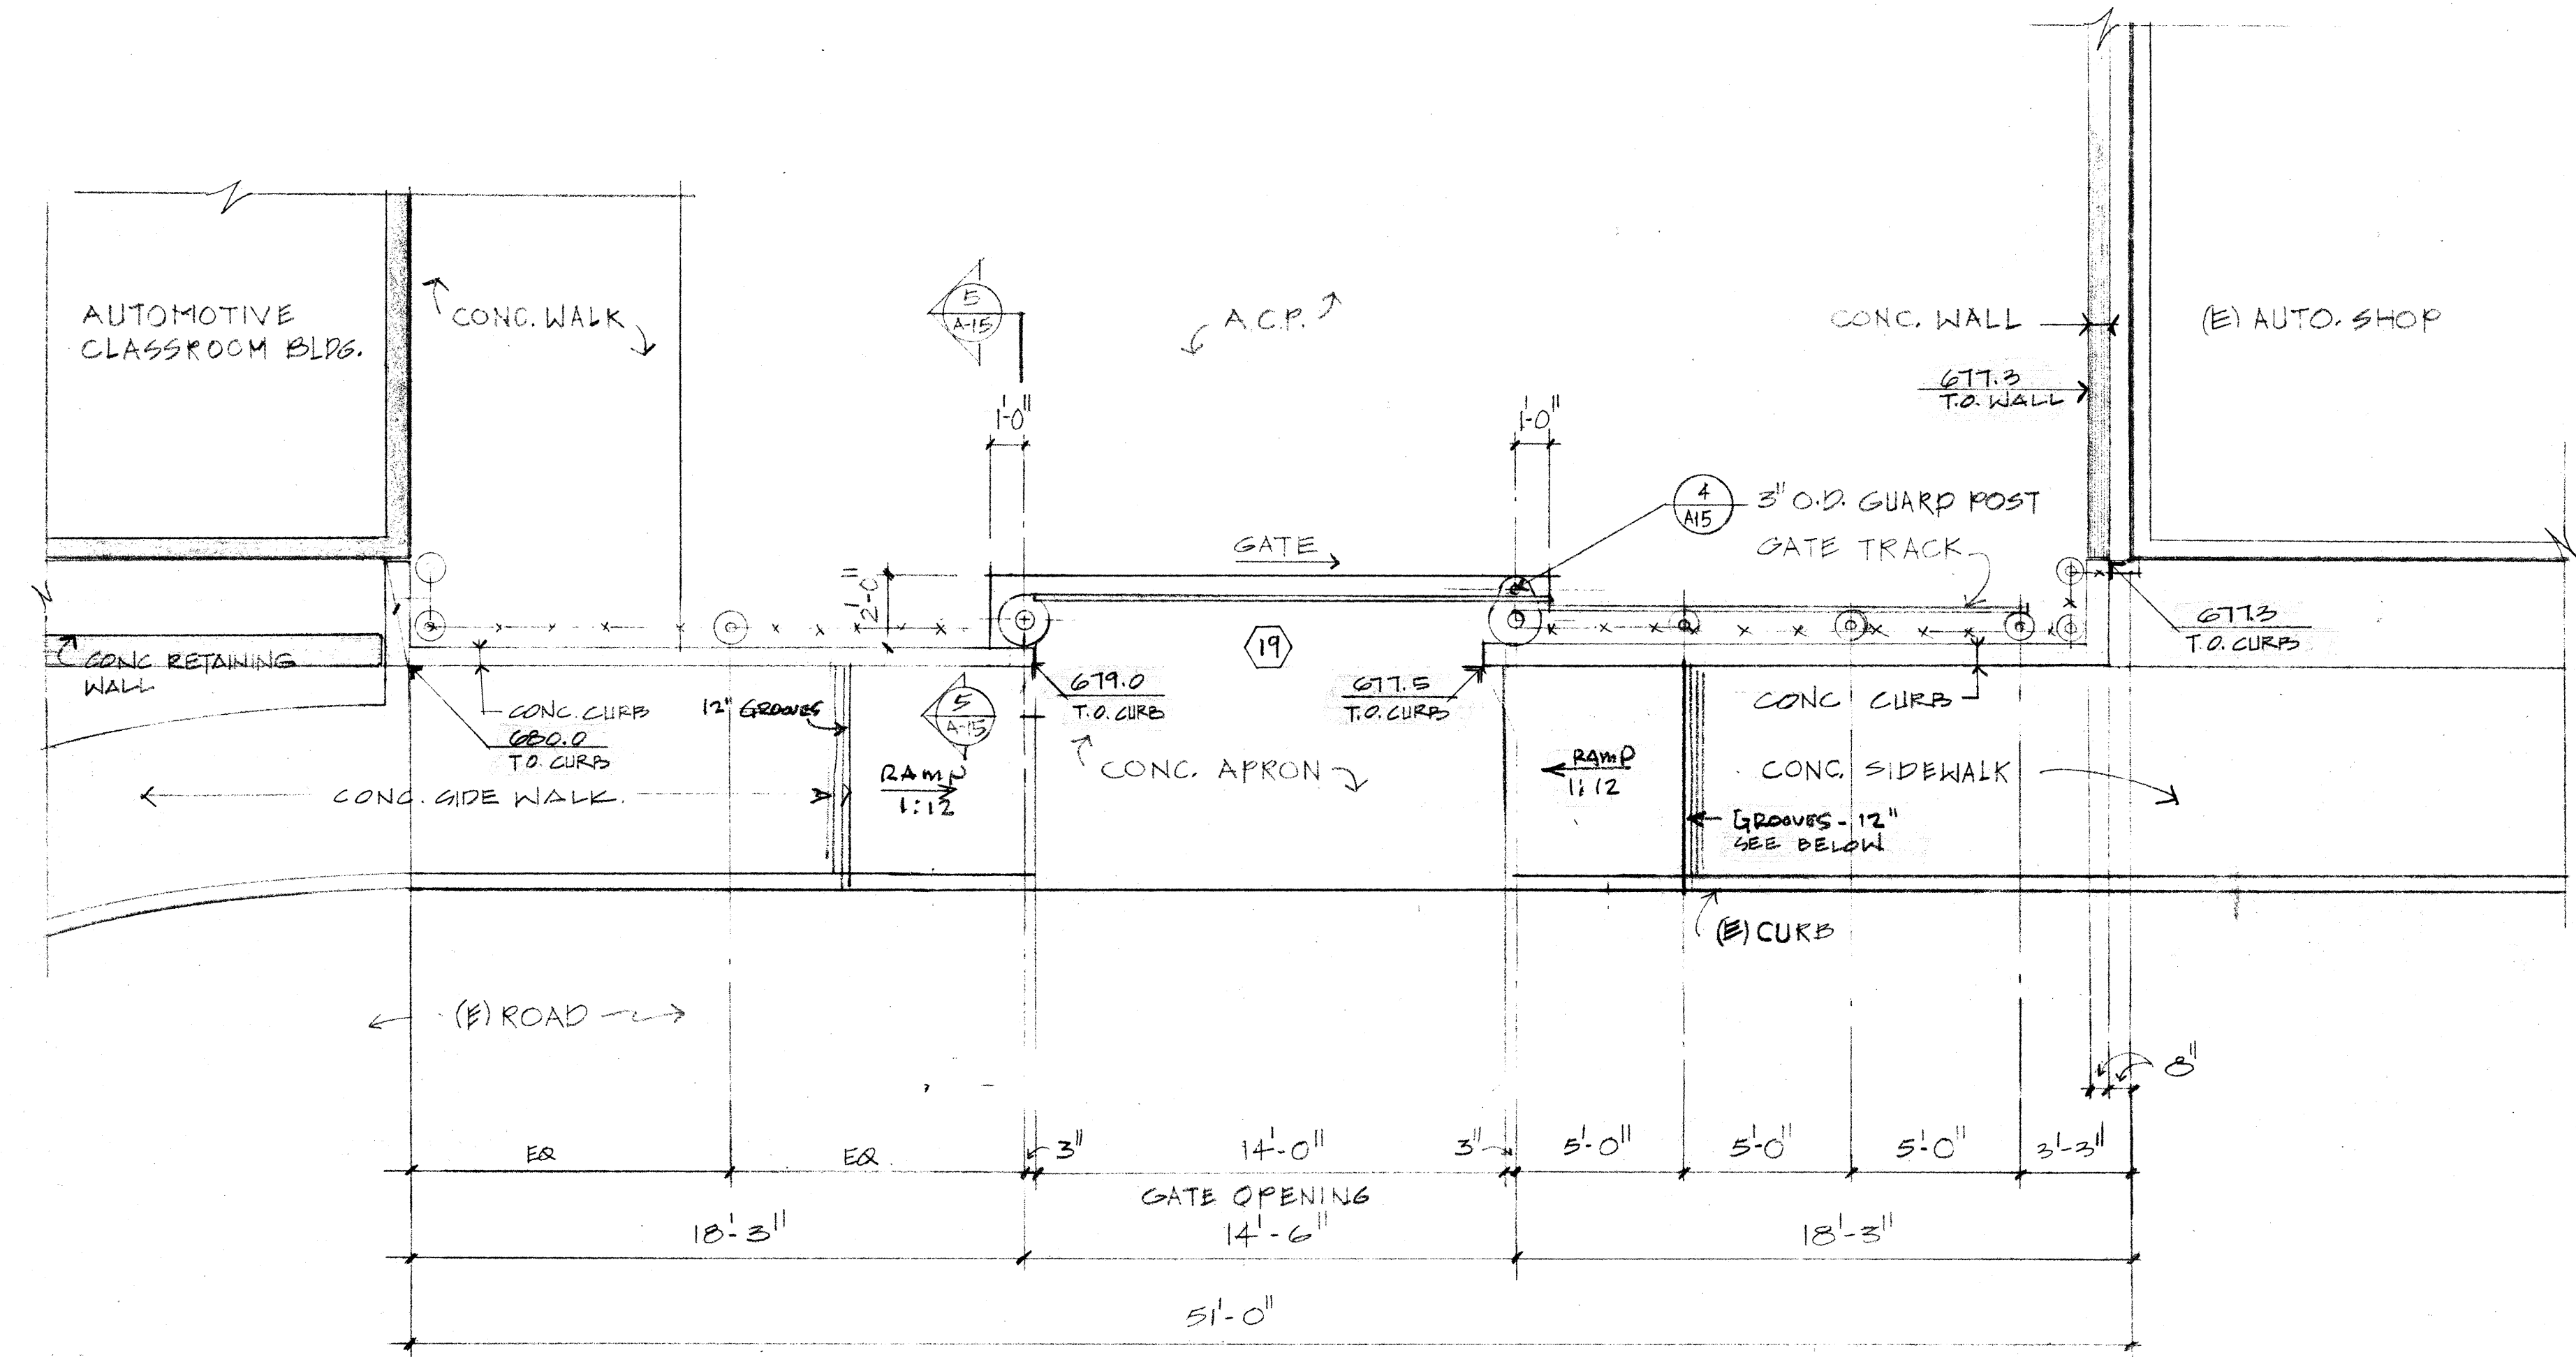


VV A L K AND PART FENCE PLAN

SCALE: 1/4" = 1'-0" 3

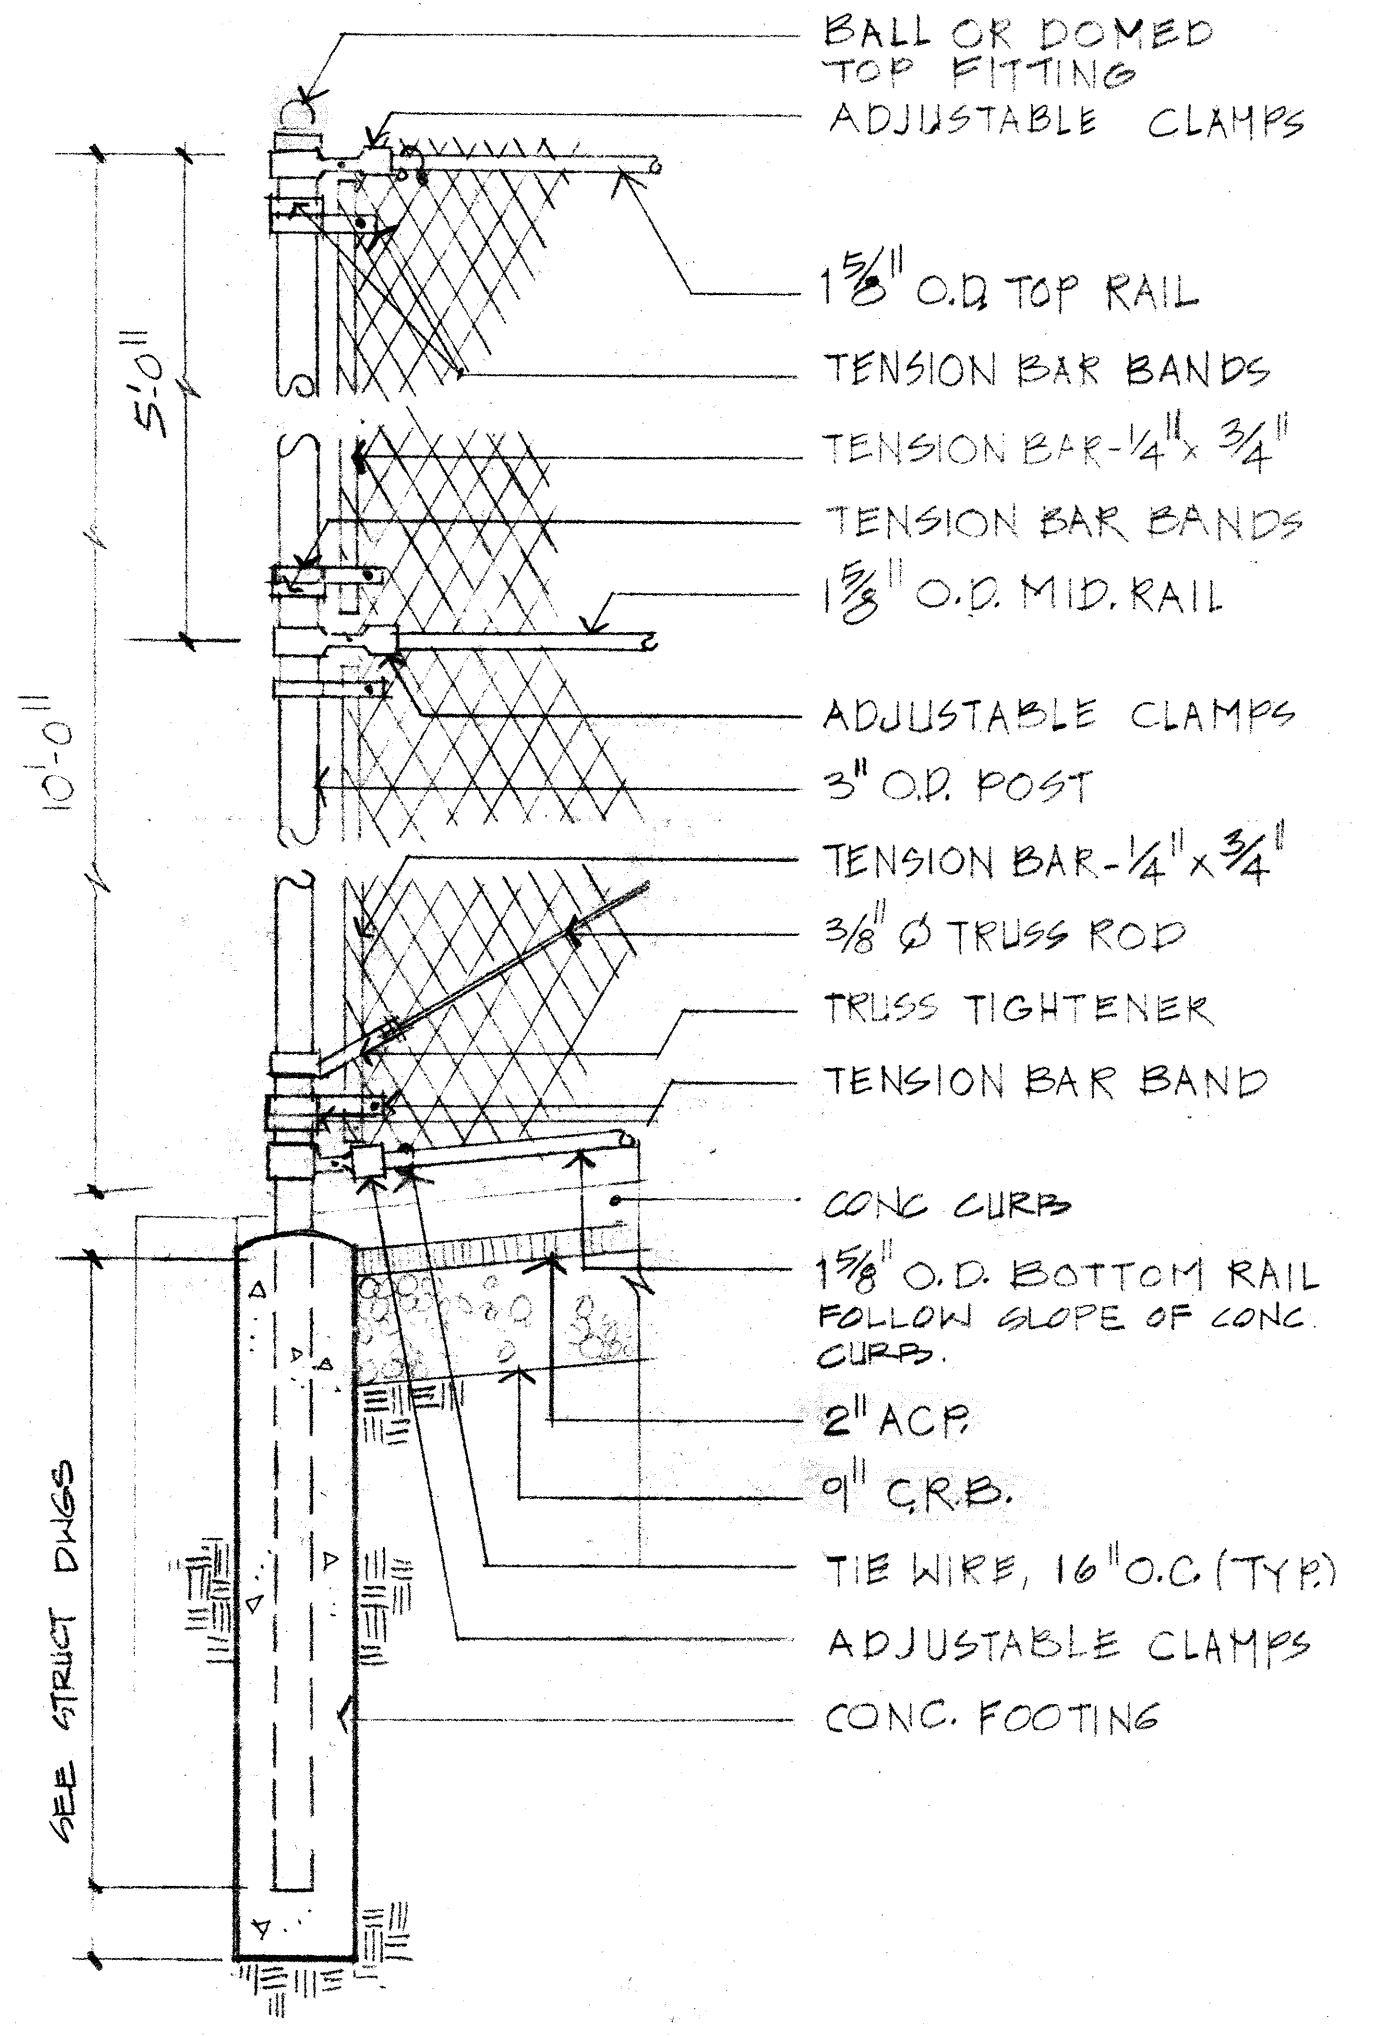

VIEW FROM INSIDE FENCE (SLOPED CONDITION SHOWN-LEVEL SIMILAR)

SCALE: 3/4" = 1'-0" 2

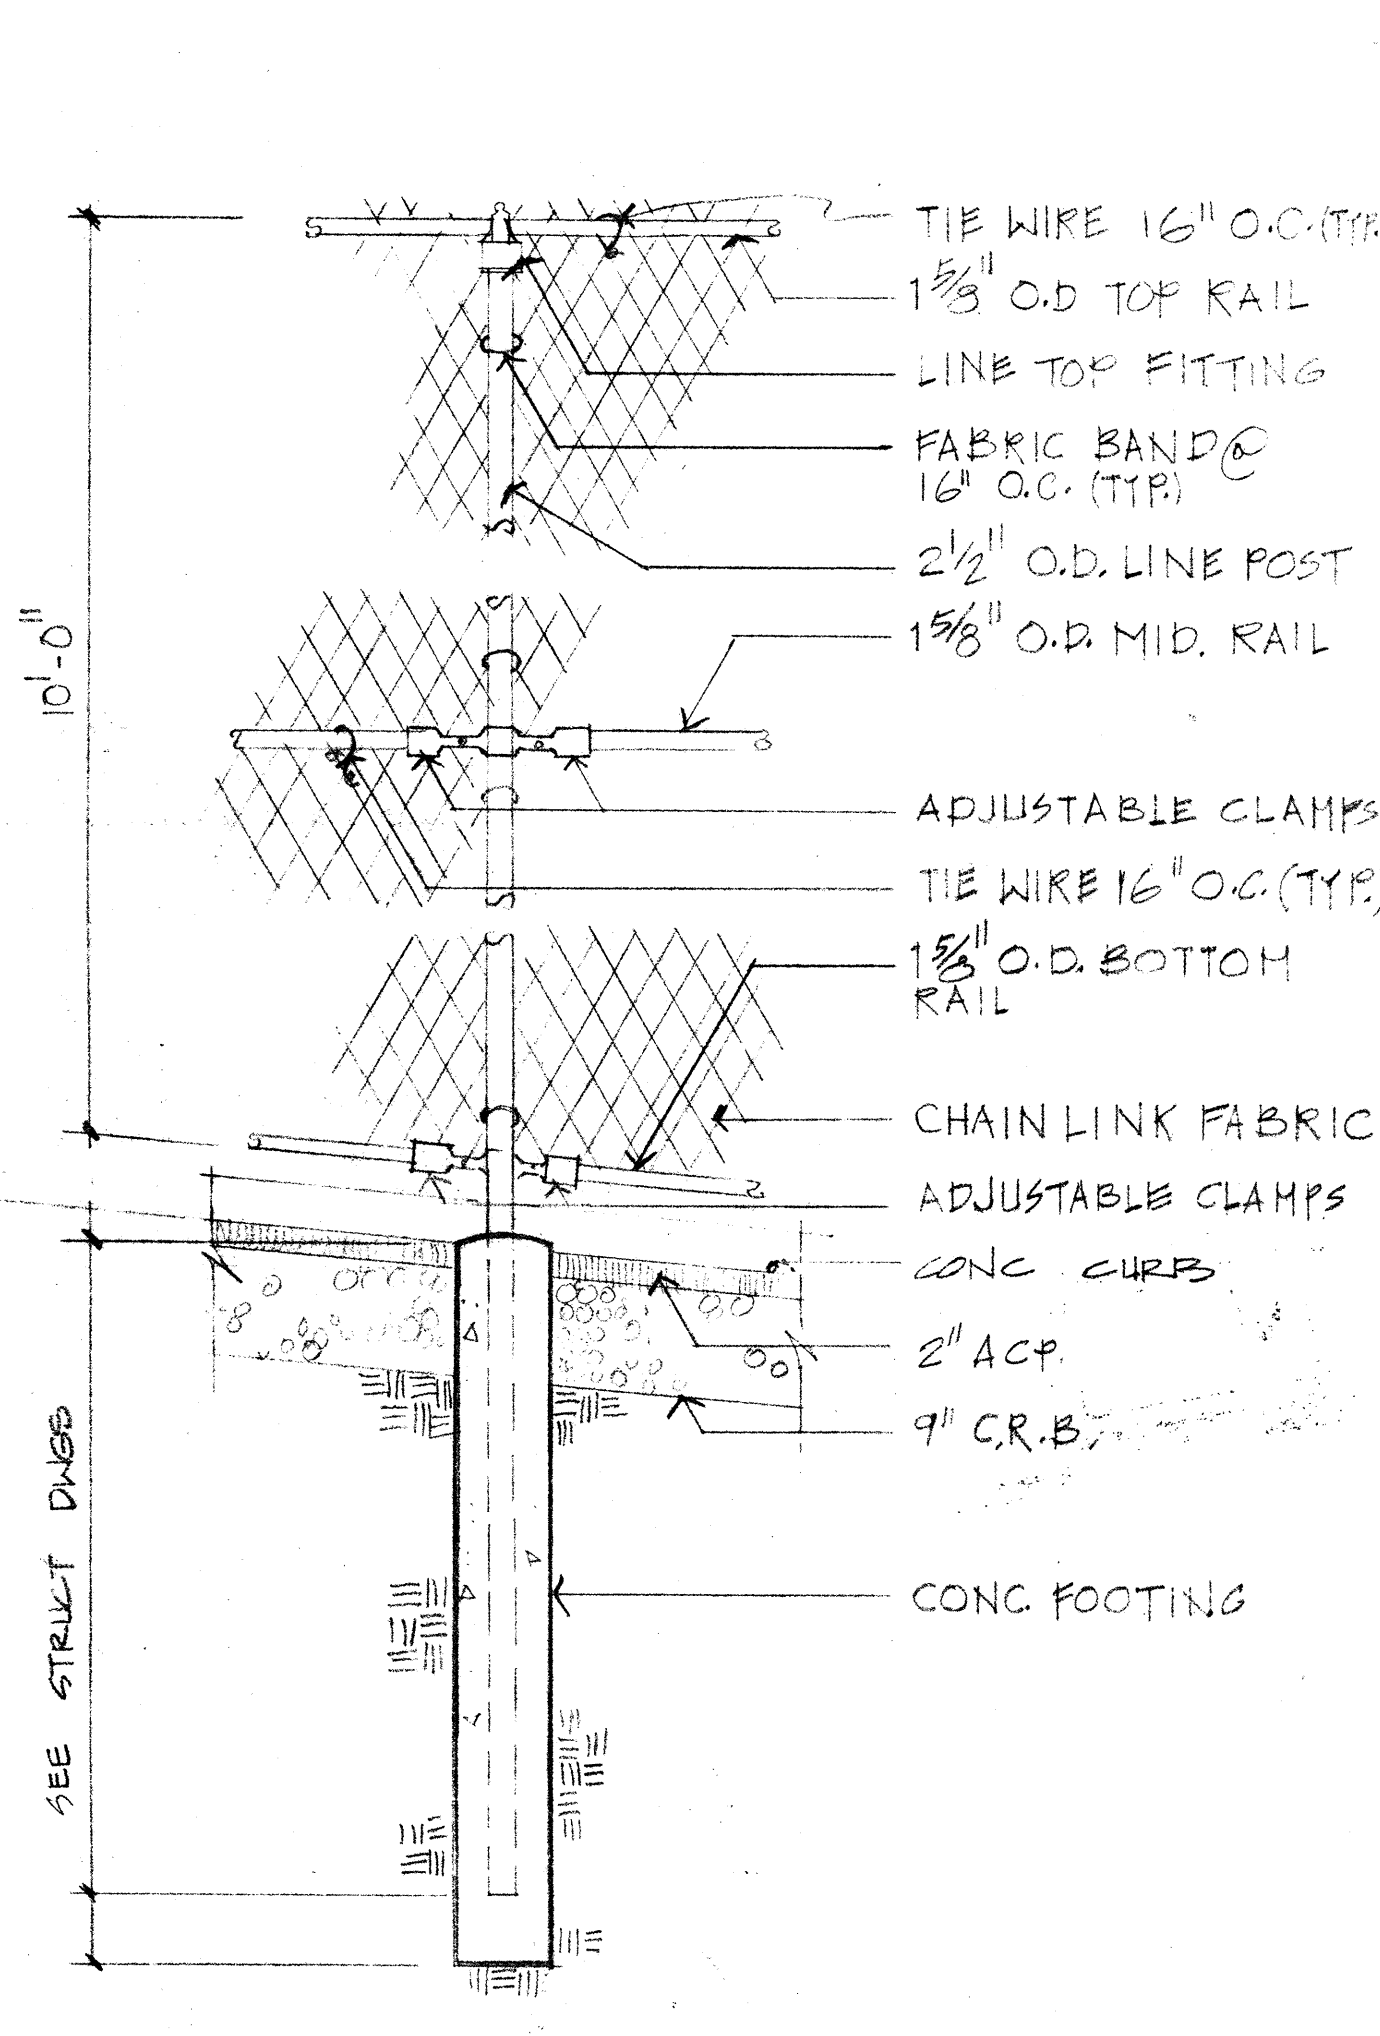

VIEW FROM INSIDE FENCE (SLOPED CONDITION SHOWN-LEVEL SIMILAR)

SCALE: 3/4" = 1'-0" 1

KELLER AND DASEKING ARCHITECTS  
 WALTER L. KELLER A.I.A.  
 WILLIAM H. DASEKING A.I.A.  
 825 OAK GROVE AVENUE  
 MENLO PARK, CA 94025-4193/22-5586  
 W. L. Keller  
 W. H. Daseking  
 2-1534

AUTOMOTIVE CLASSROOM BUILDING  
 TOILET ROOM RENOVATIONS  
 SKYLINE COLLEGE  
 SAN MATEO COUNTY COMMUNITY COLLEGE DISTRICT

8906

2.12.90

A 15

16 of 41