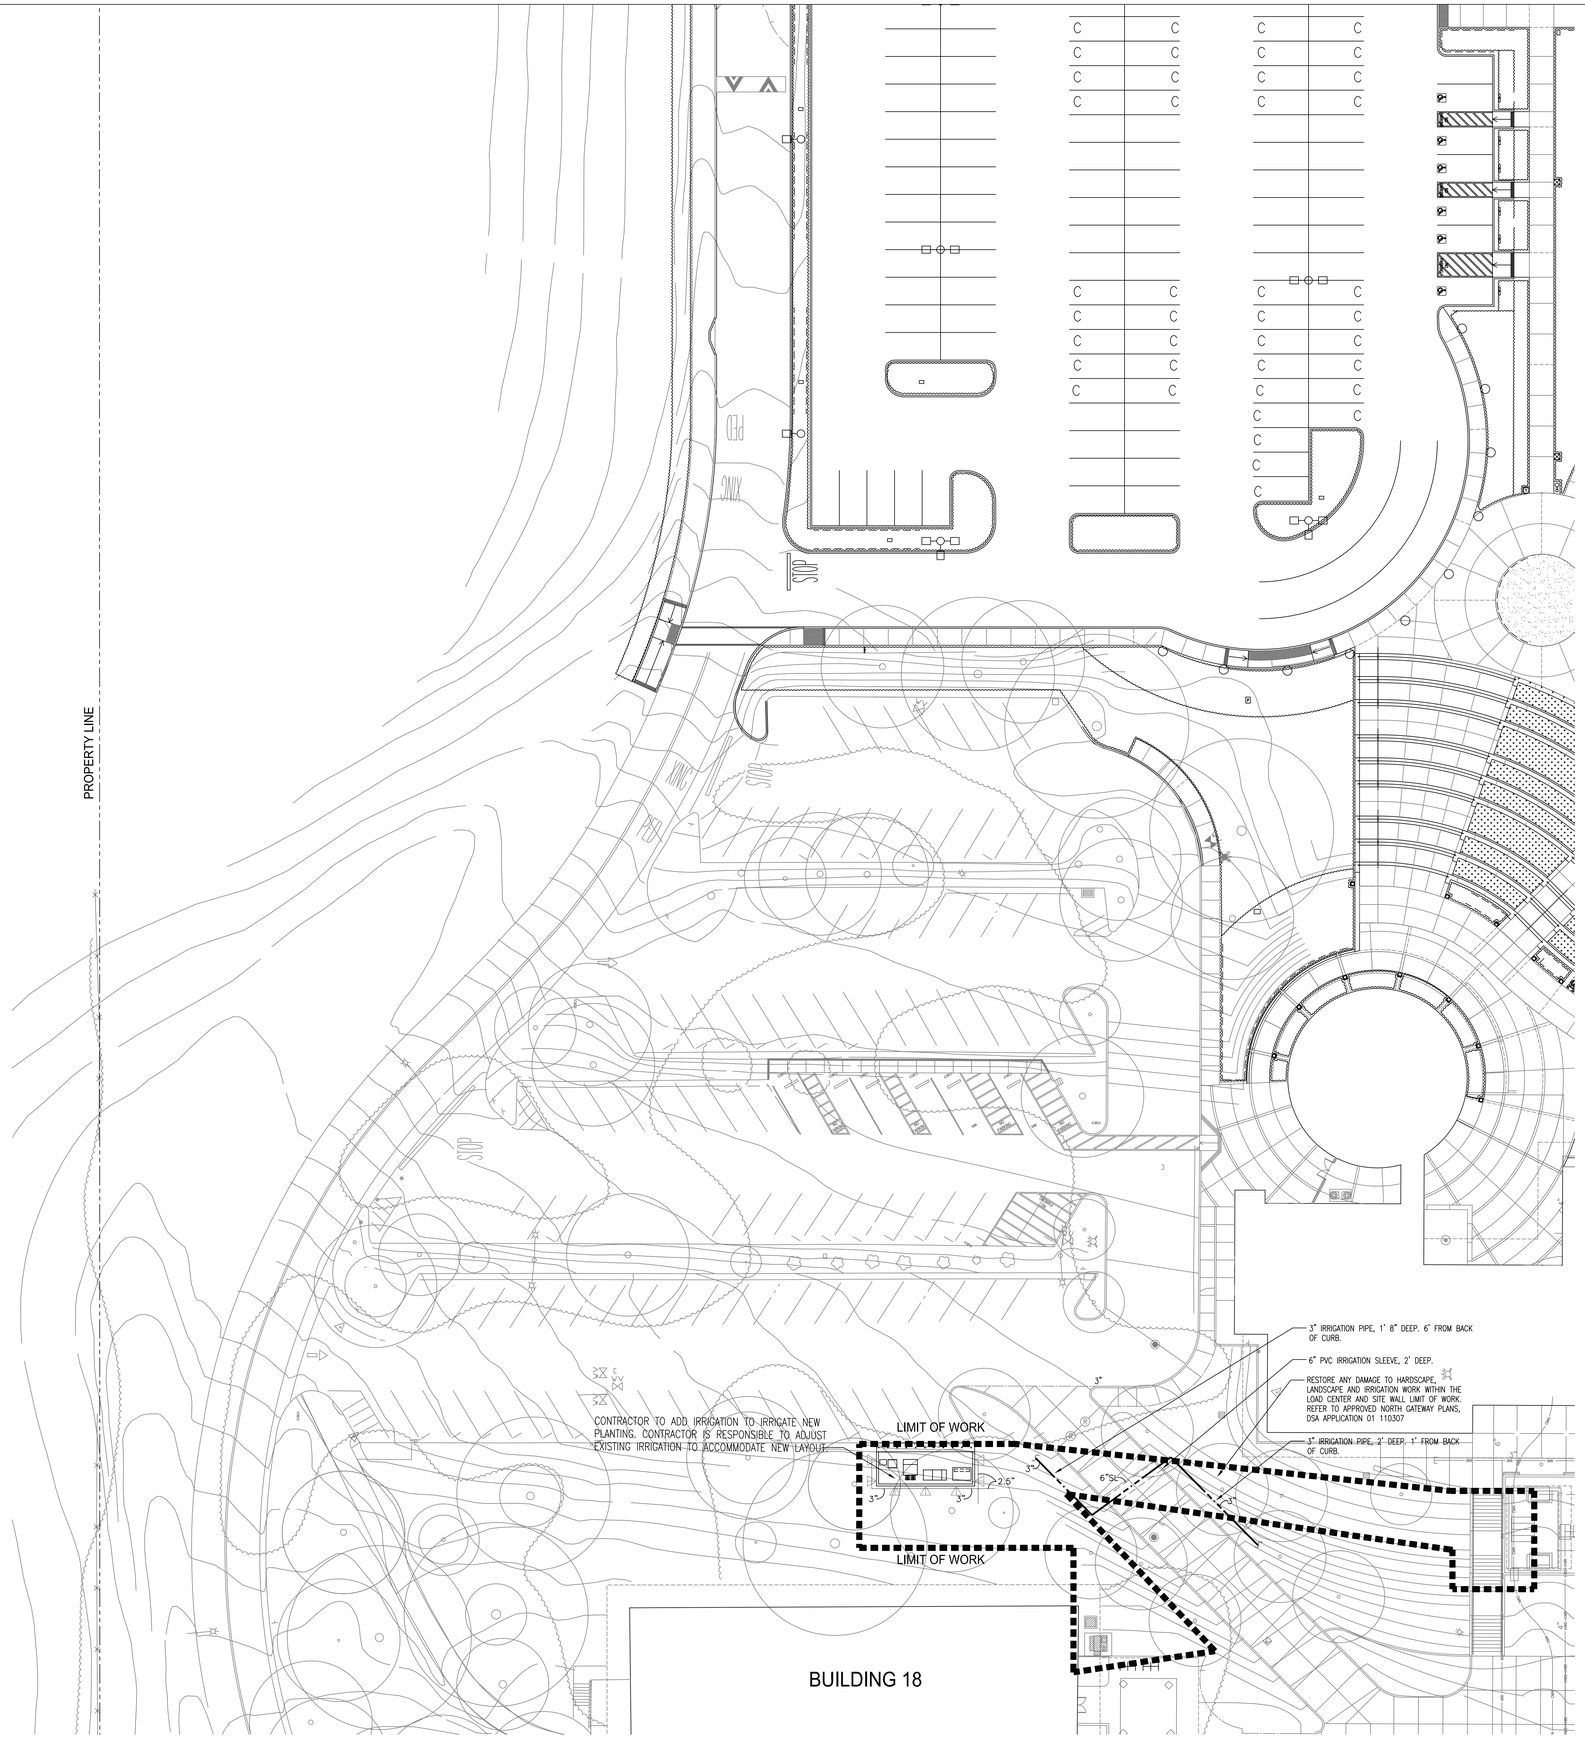

IRRIGATION PLAN | 1" = 20'-0" | 01

Irrigation Consultant:
Russell D. Mitchell Associates, Inc.
2760 Camino Diablo
Walnut Creek, CA 94597
Phone (925) 939-3985 Email:
Fax (925) 932-5671 RMA@RMAIRRIGATION.COM
—RMA—

FEBRUARY 2012 RECORD DRAWING NOTE:

THESE AS-BUILT RECORD DRAWINGS HAVE BEEN PREPARED BASED ON INFORMATION PROVIDED BY THE GENERAL CONTRACTOR / OTHERS. LPA AND ITS CONSULTANTS HAVE NOT VERIFIED THE ACCURACY AND/OR COMPLETENESS OF THIS INFORMATION AND ARE NOT RESPONSIBLE FOR ANY ERRORS OR OMISSIONS THAT MAY BE INCORPORATED AS A RESULT. LPA DOES NOT ASSUME ANY RESPONSIBILTIY FOR THE FIELD MODIFICATIONS TO THE PLANS.

noll & tam
architects and planners
729 Heinz Avenue
Berkeley, CA 94710
510.649.8295
fax 510.649.3008

LPA
Architecture
Planning
Interior Design
Landscape Architecture
Graphics

1548 Eureka Road
Suite 101
Roseville, California 95661

P 916 | 772-4300
F 916 | 772-4330
E lpa@lpainc.com
W www.lpainc.com

This and all other project documents and all ideas, aesthetics and designs incorporated therein are instruments of service. All project documents are the property of Architecture + Life Planning (LPA) and cannot be used in whole or in part for any project or purpose except as described in the contractual agreement between Noll & Tam and the District. LPA hereby gives formal notice that any such project document use, reproduction or modification (misuse) is not only unlawful but automatically binds all parties involved with misuse to fully indemnify and defend LPA and LPA's Consultants to the maximum legal extent against all losses, demands, claims or liabilities that result from misuse. Project documents describe design intent of work and are not a representation of as-built or existing conditions. LPA and LPA's Consultants make no representations concerning the accuracy of documents and are not responsible for any discrepancies between project documents and the existing conditions.
© Copyright 2008

CALIFORNIA STATE FIRE MARSHAL
APPROVED

APPROVAL OF THIS PLAN DOES NOT AUTHORIZE OR APPROVE ANY OMISSION OR DEVIATION FROM APPLICABLE REGULATIONS. FINAL APPROVAL IS SUBJECT TO FIELD INSPECTION. ONE SET OF APPROVED PLANS SHALL BE AVAILABLE ON THE PROJECT SITE AT ALL TIMES.

REVIEWED BY: _____ DATE:

CSM NORTH GATEWAY

LOAD CENTER & SITE WALL

1700
West Hillsdale Blvd
San Mateo, CA
94402

REGISTERED LANDSCAPE ARCHITECT
KEVIN MICHAEL SULLIVAN
Signature
NO. 2188
RENEWAL 5-31-12
Date
STATE OF CALIFORNIA

PROJECT RECORD DOCUMENT

SHEET TITLE
IRRIGATION PLAN

REVISIONS

NO.	DATE	DESCRIPTION

DATE FEBRUARY 24, 2012
DRAWN KFRF
CHECKED KS
SCALE 1" = 20'
JOB NO. 28066.10

SHEET NUMBER
L5.02