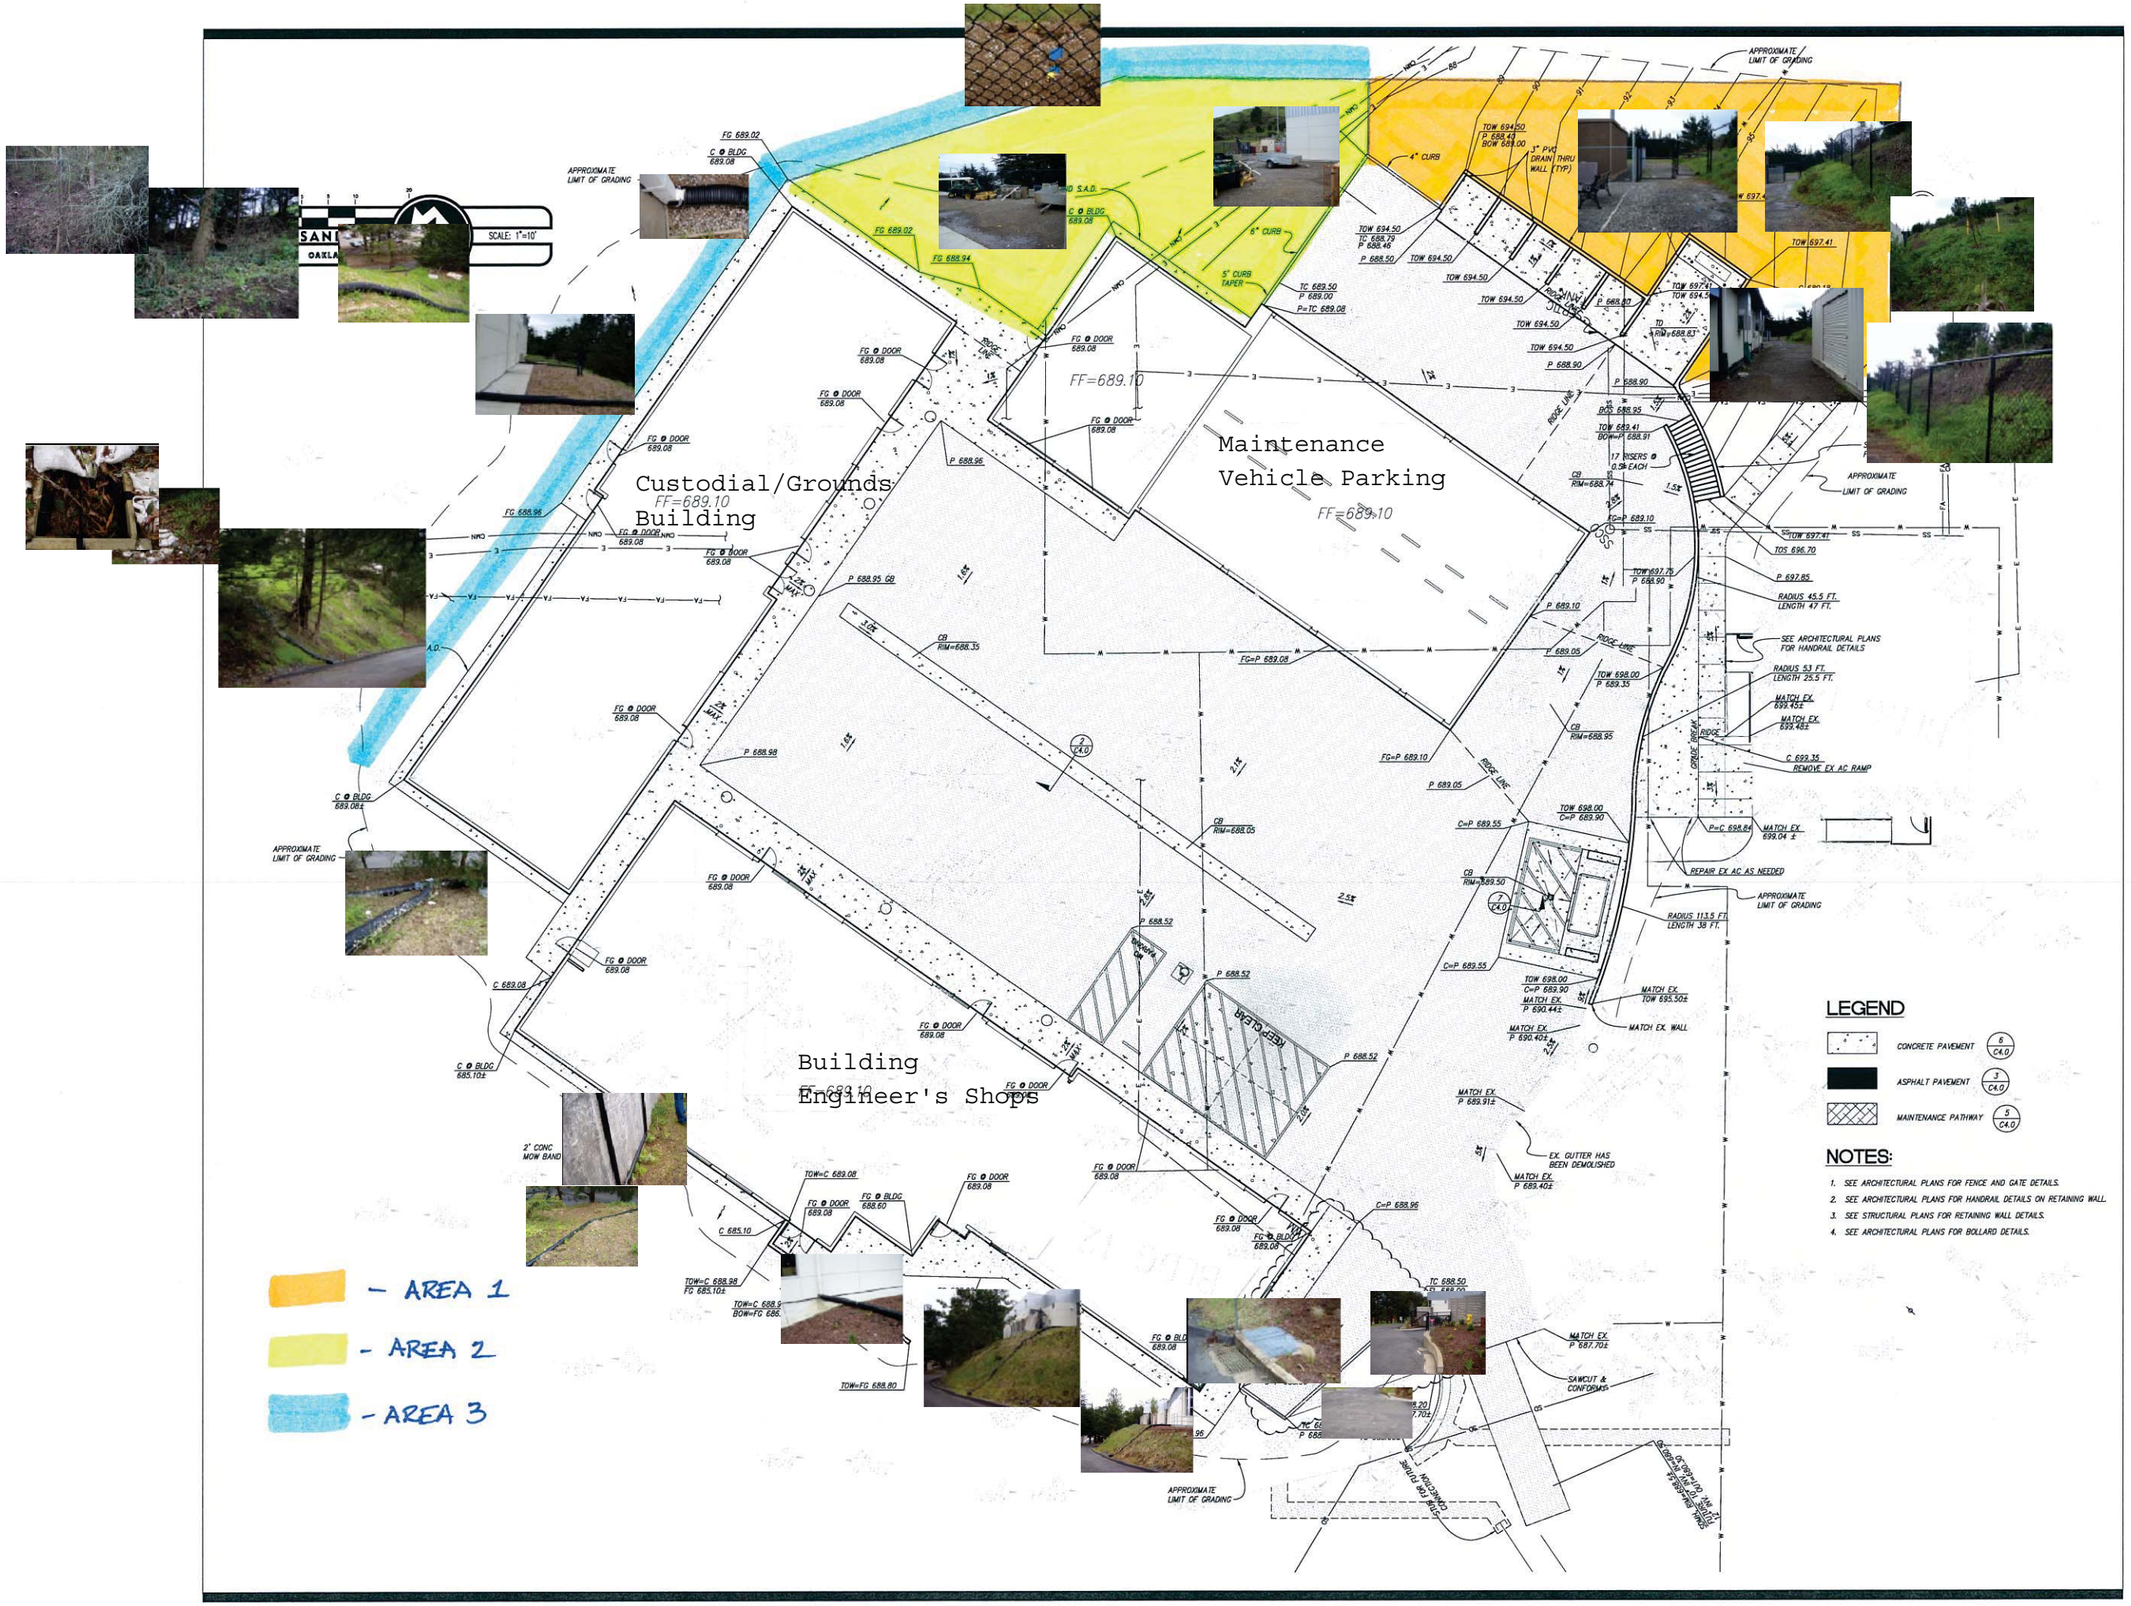

BC|A

architecture
planning
interiors

Bunton Clifford Associates, Inc.
210 Hammond Ave.
Fremont, California 94539
[T] 510.445.1000
[F] 510.445.1005
www.BCAincOnline.com

SANDIS | CIVIL ENGINEERS SURVEYORS PLANNERS
www.sandis.net
1721 Broadway, Suite 201 | Oakland, CA 94612 | P. 510.873.8666 | F. 510.873.8668
MOUNTAIN VIEW · ROSEVILLE · OAKLAND

ARCHITECT	ENGINEER
LICENSED ARCHITECT PAUL CURTIS BUNTON No. C018659 Ren.: 9/30/07 STATE OF CALIFORNIA	

GENERAL NOTES
1. This sheet is part of a set and is not to be used alone.
2. This sheet is not to be used for construction unless the architect's stamp and signature appear on the drawings and the status box indicates drawings have been released for construction.
3. These plans and prints thereof, as instruments of service, are owned by the architect and are for use on this project only. Reproduction and/or distribution without the prior written consent of the architect is forbidden.
4. Copyright Bunton Clifford Associates, 2007

REVISION HISTORY

REMARKS	DATE
1	
2	
3	
4	
5	
6	
7	
8	

DRAWING STATUS — DATE
- DSA PLAN CHECK
- DSA BACK CHECK
- BIDDING
- CONSTRUCTION

FILE NO.
IDENTIFICATION STAMP D.V. OF THE STATE ARCHITECT
AC_____ FLS_____ SS_____
DATE_____

KEY PLAN

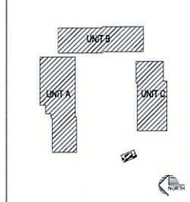

SKYLINE COLLEGE

Facilities maintenance center
3300 college drive
SAN BRUNO,
CALIFORNIA 94066

GRADING AND DRAINAGE PLAN

Date	Drawing Number
07/14/2008	C2.0
Scale: AS NOTED	
Project Number: 06016	