



**HOBACH-LEWIN, INC.**  
STRUCTURAL ENGINEERS  

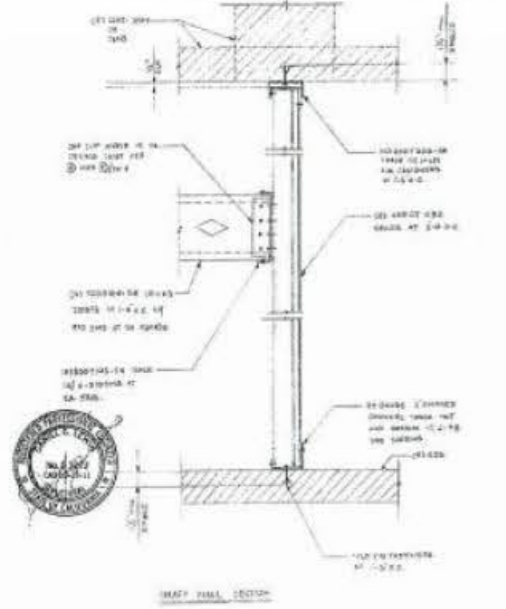


SK-3

**HOBACH-LEWIN, INC.**  
STRUCTURAL ENGINEERS  

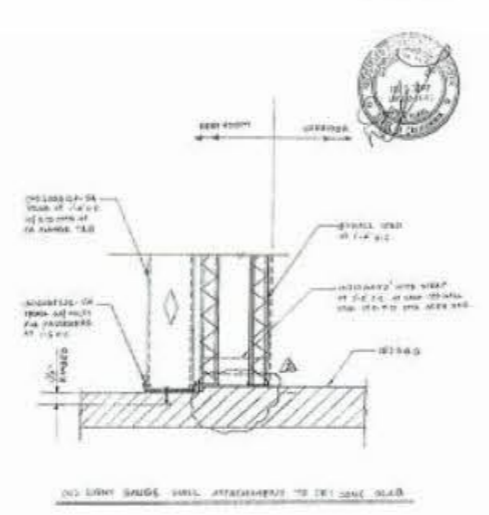


SK-6

**HOBACH-LEWIN, INC.**  
STRUCTURAL ENGINEERS  

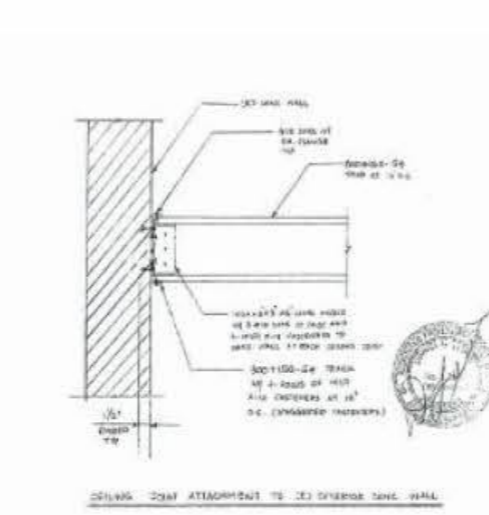


SK-4

**HOBACH-LEWIN, INC.**  
STRUCTURAL ENGINEERS  

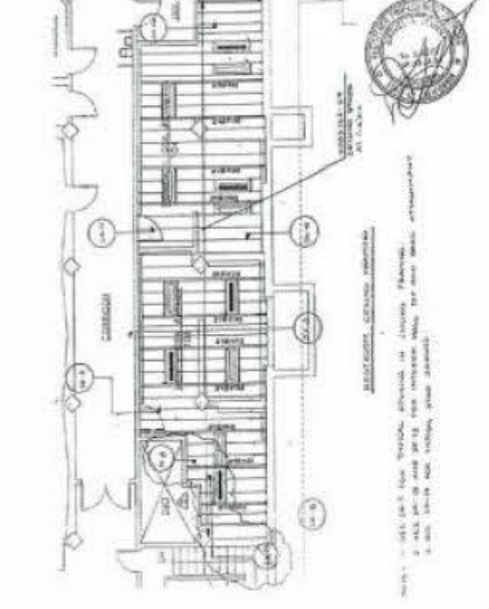


SK-2

**HOBACH-LEWIN, INC.**  
STRUCTURAL ENGINEERS  

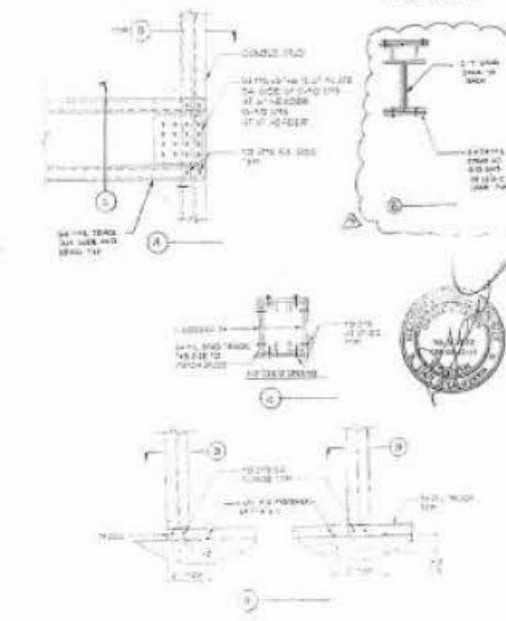


SK-9

**HOBACH-LEWIN, INC.**  
STRUCTURAL ENGINEERS  

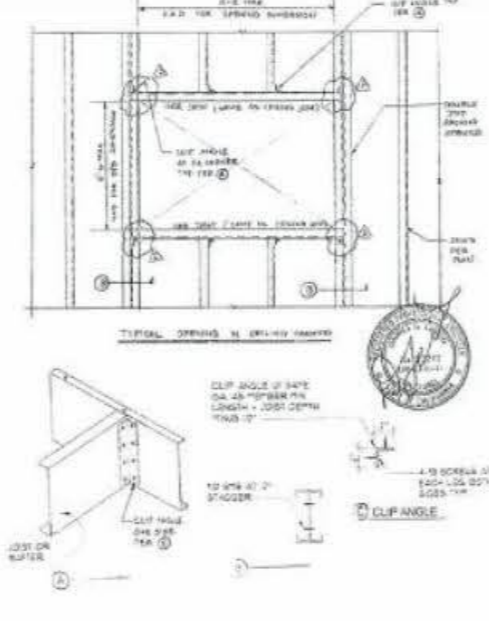


SK-7

**HOBACH-LEWIN, INC.**  
STRUCTURAL ENGINEERS  

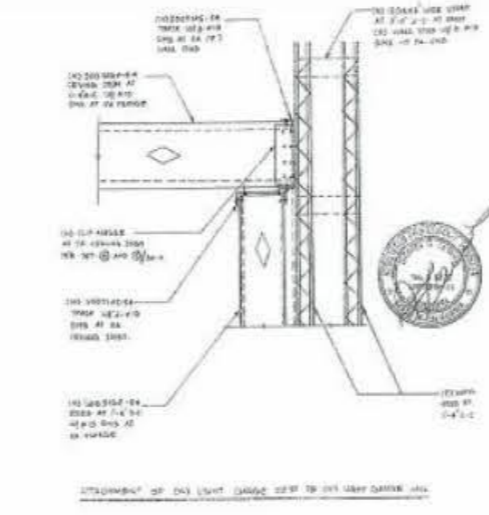

SK-5

**HOBACH-LEWIN, INC.**  
STRUCTURAL ENGINEERS  

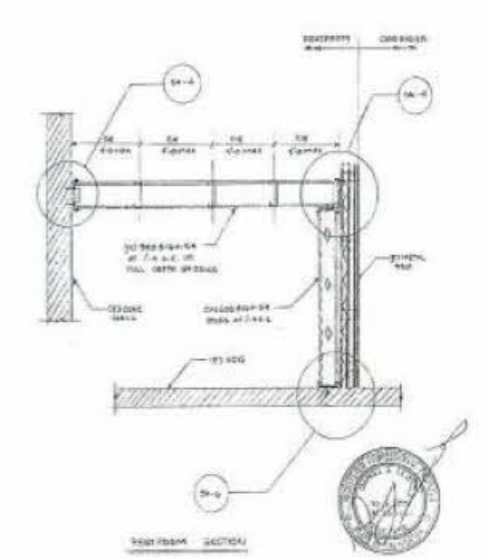

SK-8