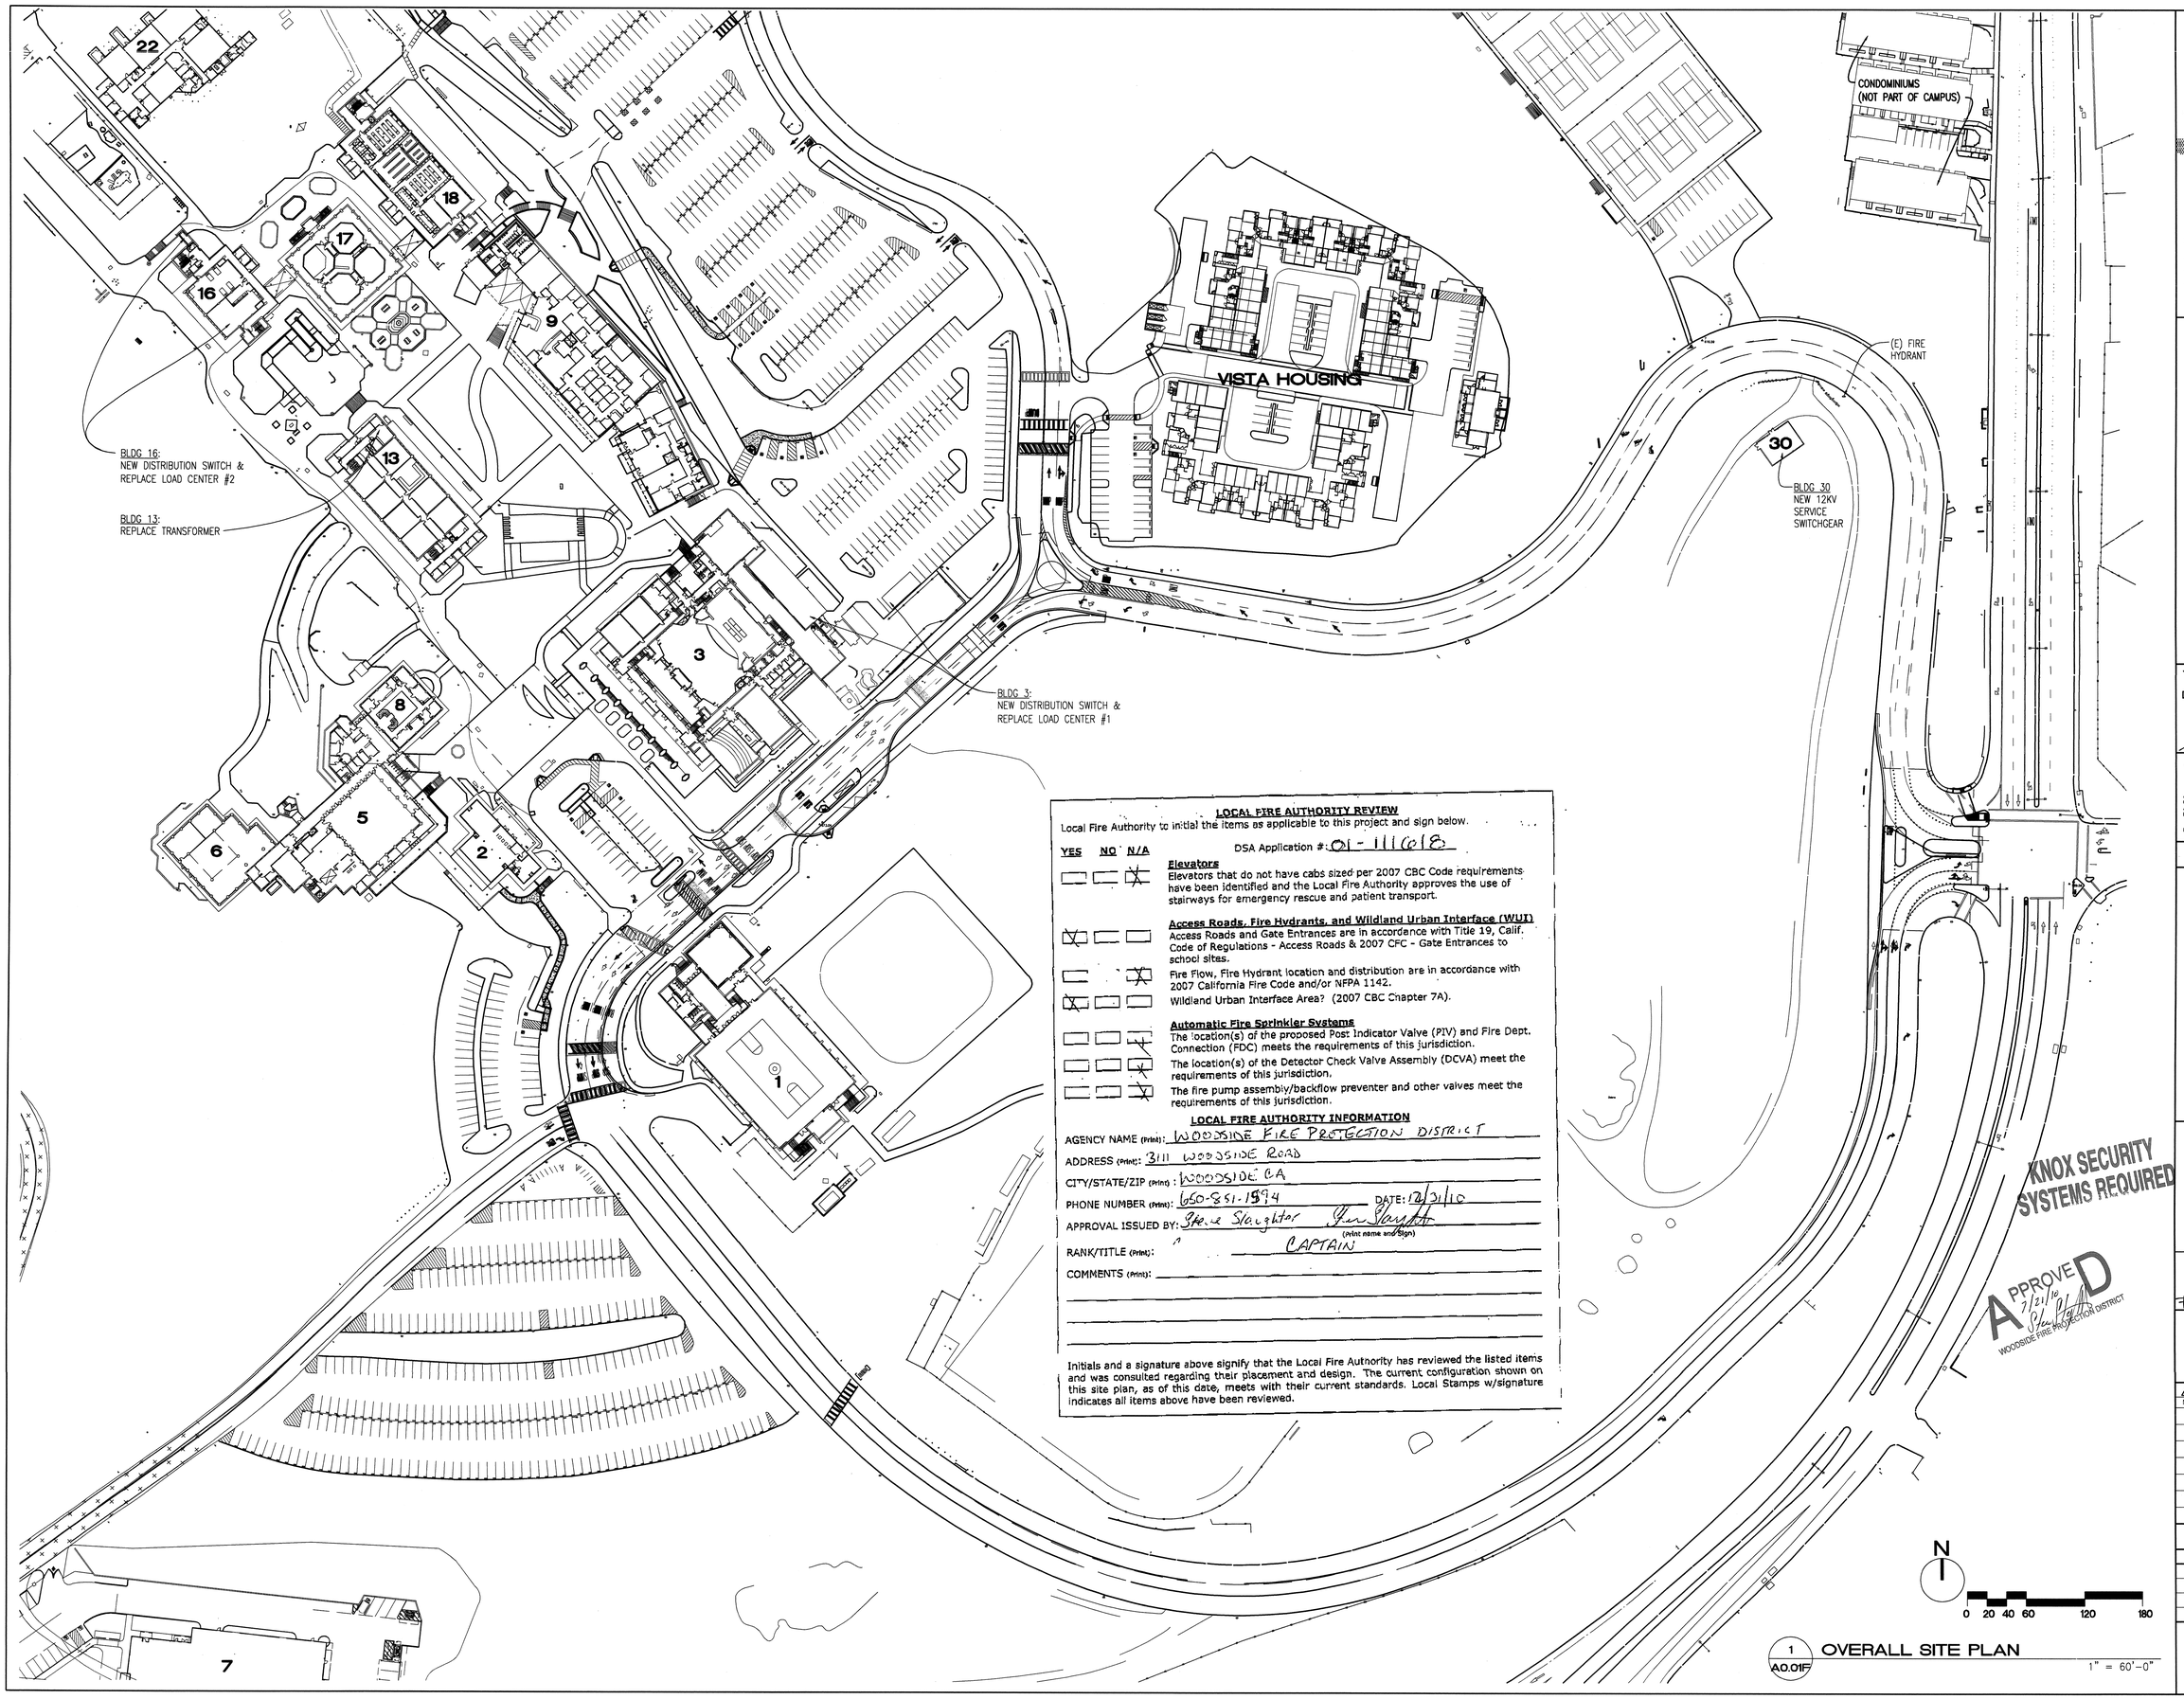

LOCAL FIRE AUTHORITY REVIEW

Local Fire Authority to initial the items as applicable to this project and sign below.

DSA Application #: 01-111618

YES	NO	N/A	
		X	**Elevators** Elevators that do not have cabs sized per 2007 CBC Code requirements have been identified and the Local Fire Authority approves the use of stairways for emergency rescue and patient transport.
X			**Access Roads, Fire Hydrants, and Wildland Urban Interface (WUI)** Access Roads and Gate Entrances are in accordance with Title 19, Calif. Code of Regulations - Access Roads & 2007 CFC - Gate Entrances to school sites.
		X	Fire Flow, Fire Hydrant location and distribution are in accordance with 2007 California Fire Code and/or NFPA 1142.
X			Wildland Urban Interface Area? (2007 CBC Chapter 7A).
		X	**Automatic Fire Sprinkler Systems** The location(s) of the proposed Post Indicator Valve (PIV) and Fire Dept. Connection (FDC) meets the requirements of this jurisdiction.
		X	The location(s) of the Detector Check Valve Assembly (DCVA) meet the requirements of this jurisdiction.
		X	The fire pump assembly/backflow preventer and other valves meet the requirements of this jurisdiction.

LOCAL FIRE AUTHORITY INFORMATION

AGENCY NAME (Print): WOODSIDE FIRE PROTECTION DISTRICT

ADDRESS (Print): 3111 WOODSIDE ROAD

CITY/STATE/ZIP (Print): WOODSIDE CA

PHONE NUMBER (Print): 650-851-1594 DATE: 12/21/10

APPROVAL ISSUED BY: Steve Slaughter (print name and sign)

RANK/TITLE (Print): CAPTAIN

COMMENTS (Print):

Initials and a signature above signify that the Local Fire Authority has reviewed the listed items and was consulted regarding their placement and design. The current configuration shown on this site plan, as of this date, meets with their current standards. Local Stamps w/signature indicates all items above have been reviewed.

1 A0.01F OVERALL SITE PLAN 1" = 60'-0"

noll & tam
architects and planners
723 Heinz Avenue
Berkeley, CA 94710
510.649.9295
fax 510.649.3008

IDENTIFICATION STAMP
DIVISION OF THE STATE ARCHITECT
APPLICATION NUMBER: 01
AC FLS SS
DATE

CALIFORNIA STATE FIRE MARSHAL
APPROVED

APPROVAL OF THIS PLAN DOES NOT AUTHORIZE OR APPROVE ANY OMISSION OR DEVIATION FROM APPLICABLE REGULATIONS. FINAL APPROVAL IS SUBJECT TO FIELD INSPECTION. ONE SET OF APPROVED PLANS SHALL BE AVAILABLE ON THE PROJECT SITE AT ALL TIMES.

REVIEWED BY: _____ DATE:

CAÑADA COLLEGE

Electrical Infrastructure Replacement Project

4200 Farm Hill Blvd
Redwood City, CA 94061

LICENSED ARCHITECT
CHRISTOPHER NOLL
REN. 12/31/11
C15916
STATE OF CALIFORNIA

FOR REFERENCE ONLY

SHEET TITLE

Overall Site Plan

REVISIONS

NO.	DATE	DESCRIPTION

DATE
DRAWN
CHECKED
SCALE 1" = 60'-0"
JOB NO. 2921.01

SHEET NUMBER

A0.01F