

BCA
architecture
planning
interiors


1100 Woodland Ave.
Redwood City, CA 94061
(415) 948-1000
(415) 948-1002

Title: REMOVE DOOR 5-322A

Project Name: CANADA COLLEGE - BUILDINGS 5 & 6 RENOVATIONS
SAN MATEO COUNTY COMMUNITY COLLEGE DISTRICT
4200 FARM HILL BOULEVARD
REDWOOD CITY, CA 94061
FILE NO. 43-C1 APPL. 01-110074

Date: 08/20/11
Scale: AS NOTED
Project Number: 0912

Revision: 64
Drawing Number: ASK-31A

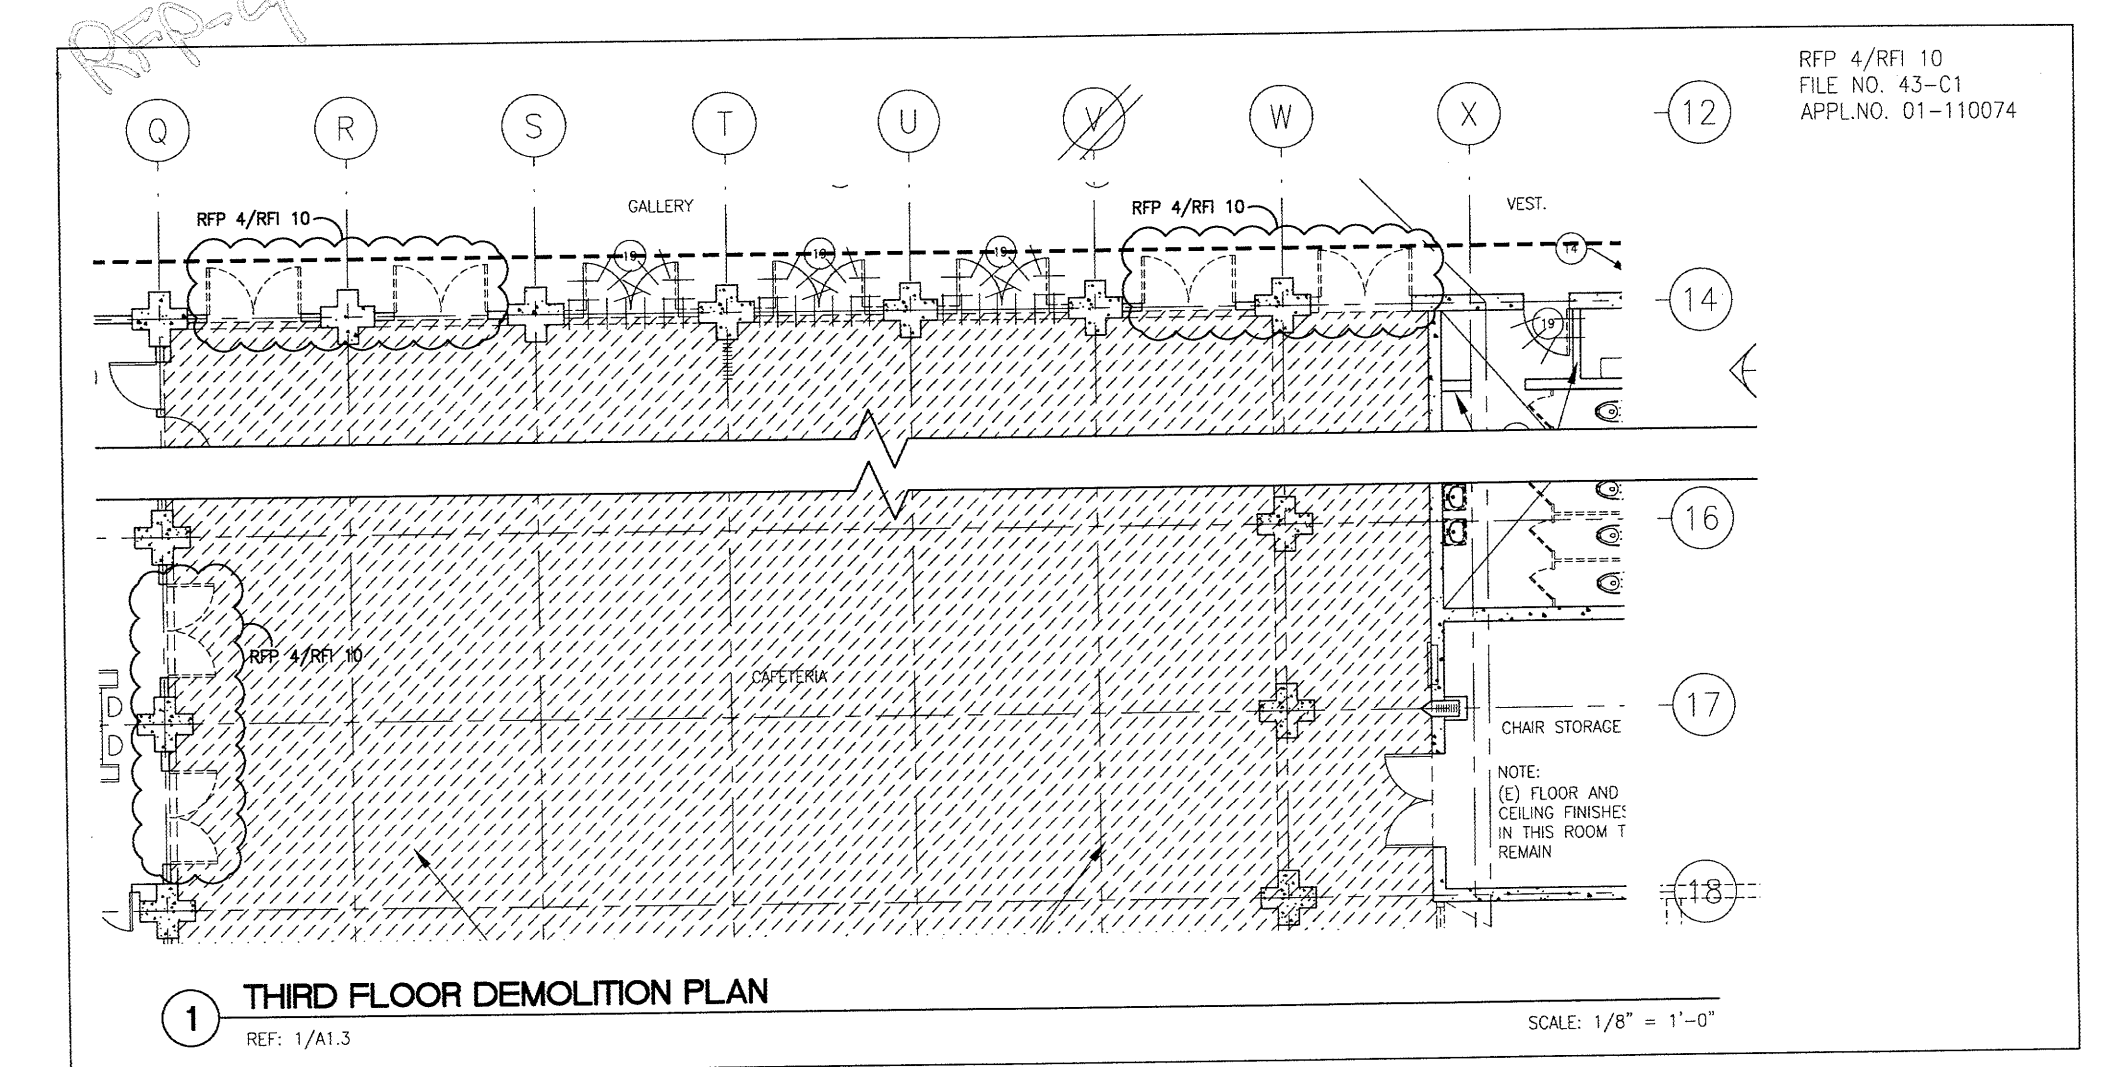

BCA
architecture
planning
interiors


1100 Woodland Ave.
Redwood City, CA 94061
(415) 948-1000
(415) 948-1002

Title: THIRD FLOOR DOORS

Project Name: CANADA COLLEGE - BUILDINGS 5 & 6 RENOVATIONS
SAN MATEO COUNTY COMMUNITY COLLEGE DISTRICT
4200 FARM HILL BOULEVARD
REDWOOD CITY, CA 94061
FILE NO. 43-C1 APPL. 01-110074

Date: 08/20/11
Scale: AS NOTED
Project Number: 0912

Revision: ASK-1A

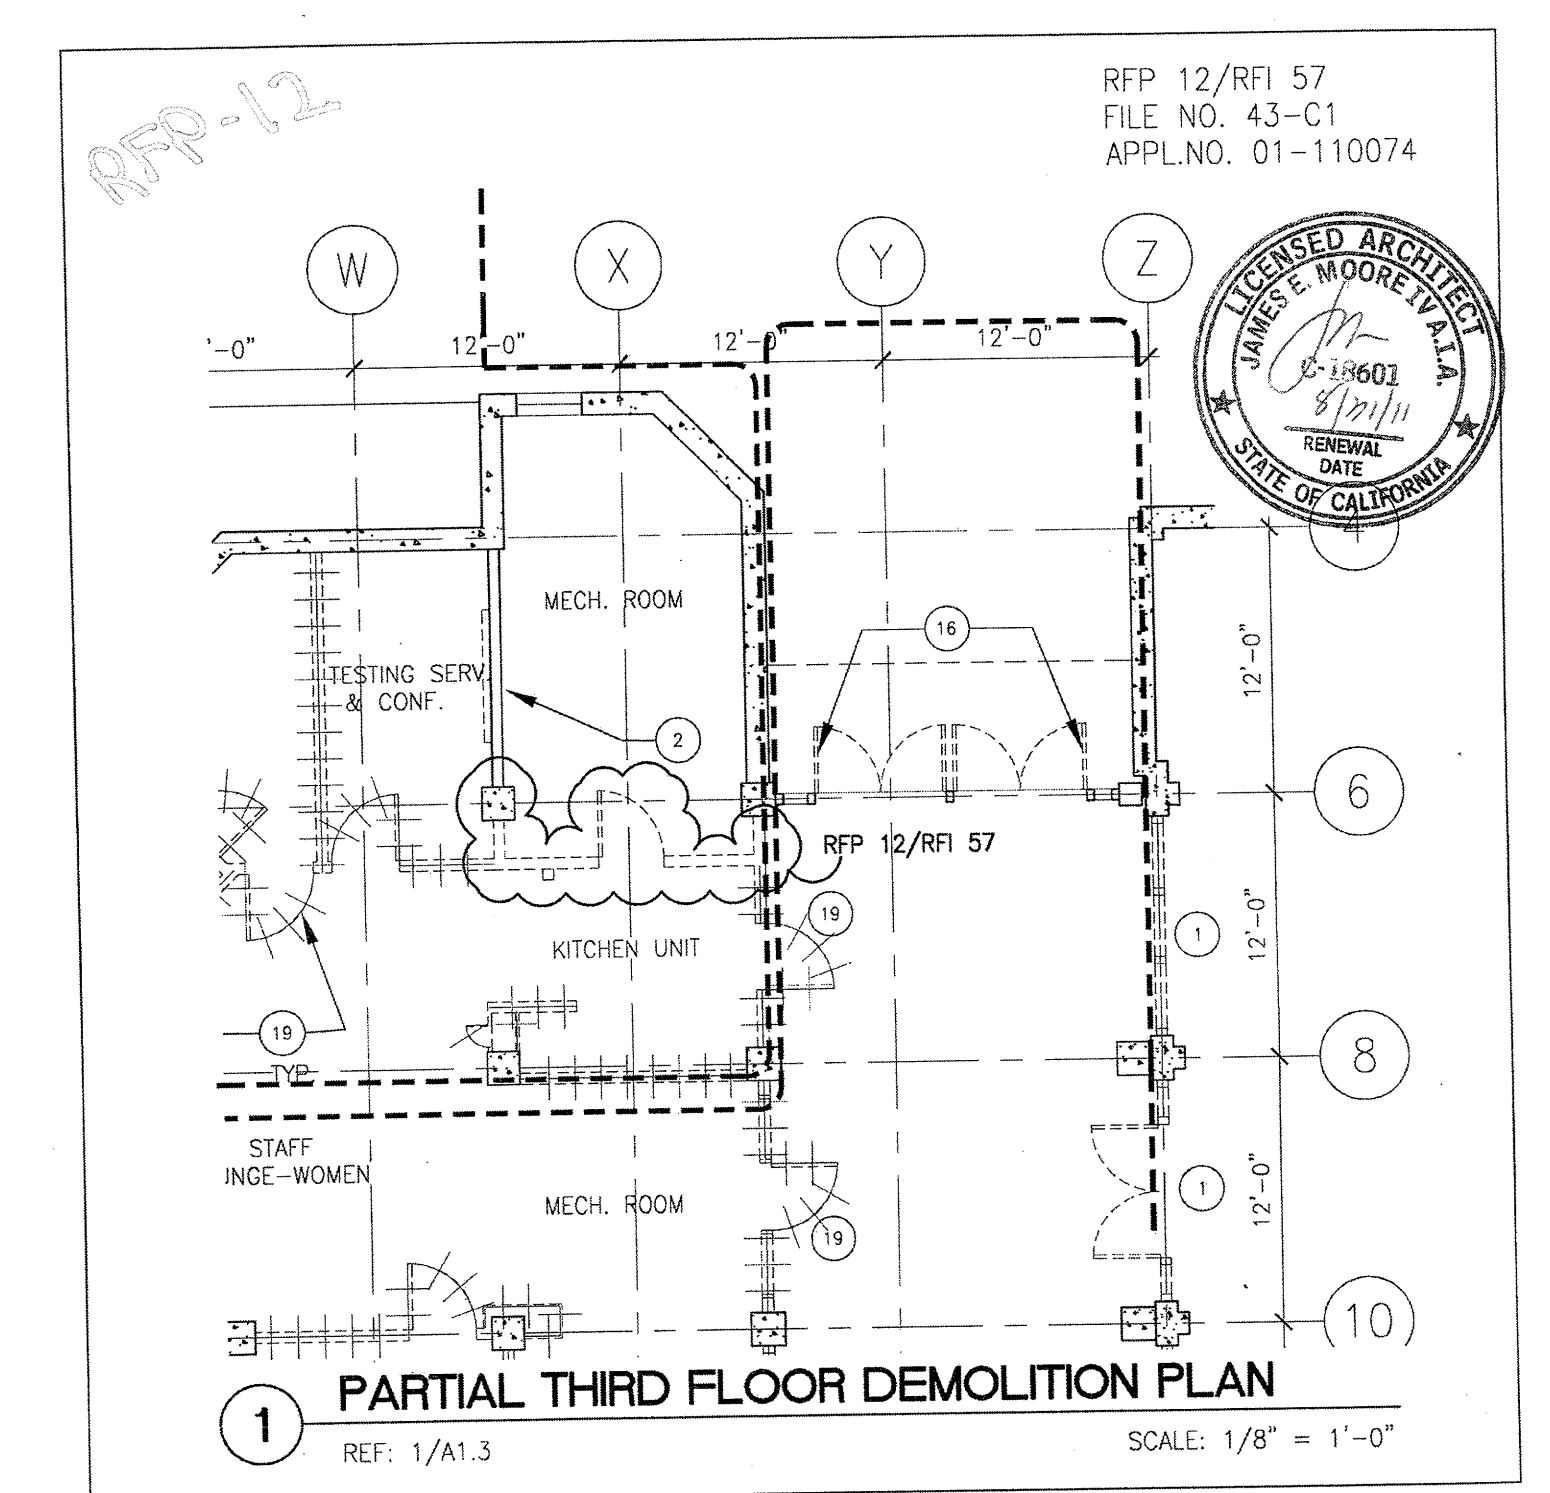

BCA
architecture
planning
interiors

1100 Woodland Ave.
Redwood City, CA 94061
(415) 948-1000
(415) 948-1002

Title: 3RD FLOOR ELEC. AND MECH. ROOMS

Project Name: CANADA COLLEGE - BUILDINGS 5 & 6 RENOVATIONS
SAN MATEO COUNTY COMMUNITY COLLEGE DISTRICT
4200 FARM HILL BOULEVARD
REDWOOD CITY, CA 94061
FILE NO. 43-C1 APPL. 01-110074

Date: 08/20/11
Scale: AS NOTED
Project Number: 0912

Revision: ASK-4A