



BCA architecture planning interiors
REMOVE DOOR 5-322A
 Project Name: CANADA COLLEGE - BUILDINGS 5 & 6 RENOVATIONS
 SAN MATEO COUNTRY COMMUNITY COLLEGE DISTRICT
 4200 FARM HILL BOULEVARD
 REDWOOD CITY, CA 94061
 FILE NO. 43-C1 APPL. 01-110074

Revision: RFP 64
 Date: 05/20/11
 Scale: AS NOTED
 Project Number: ASK-31A
 Drawing Number: 64

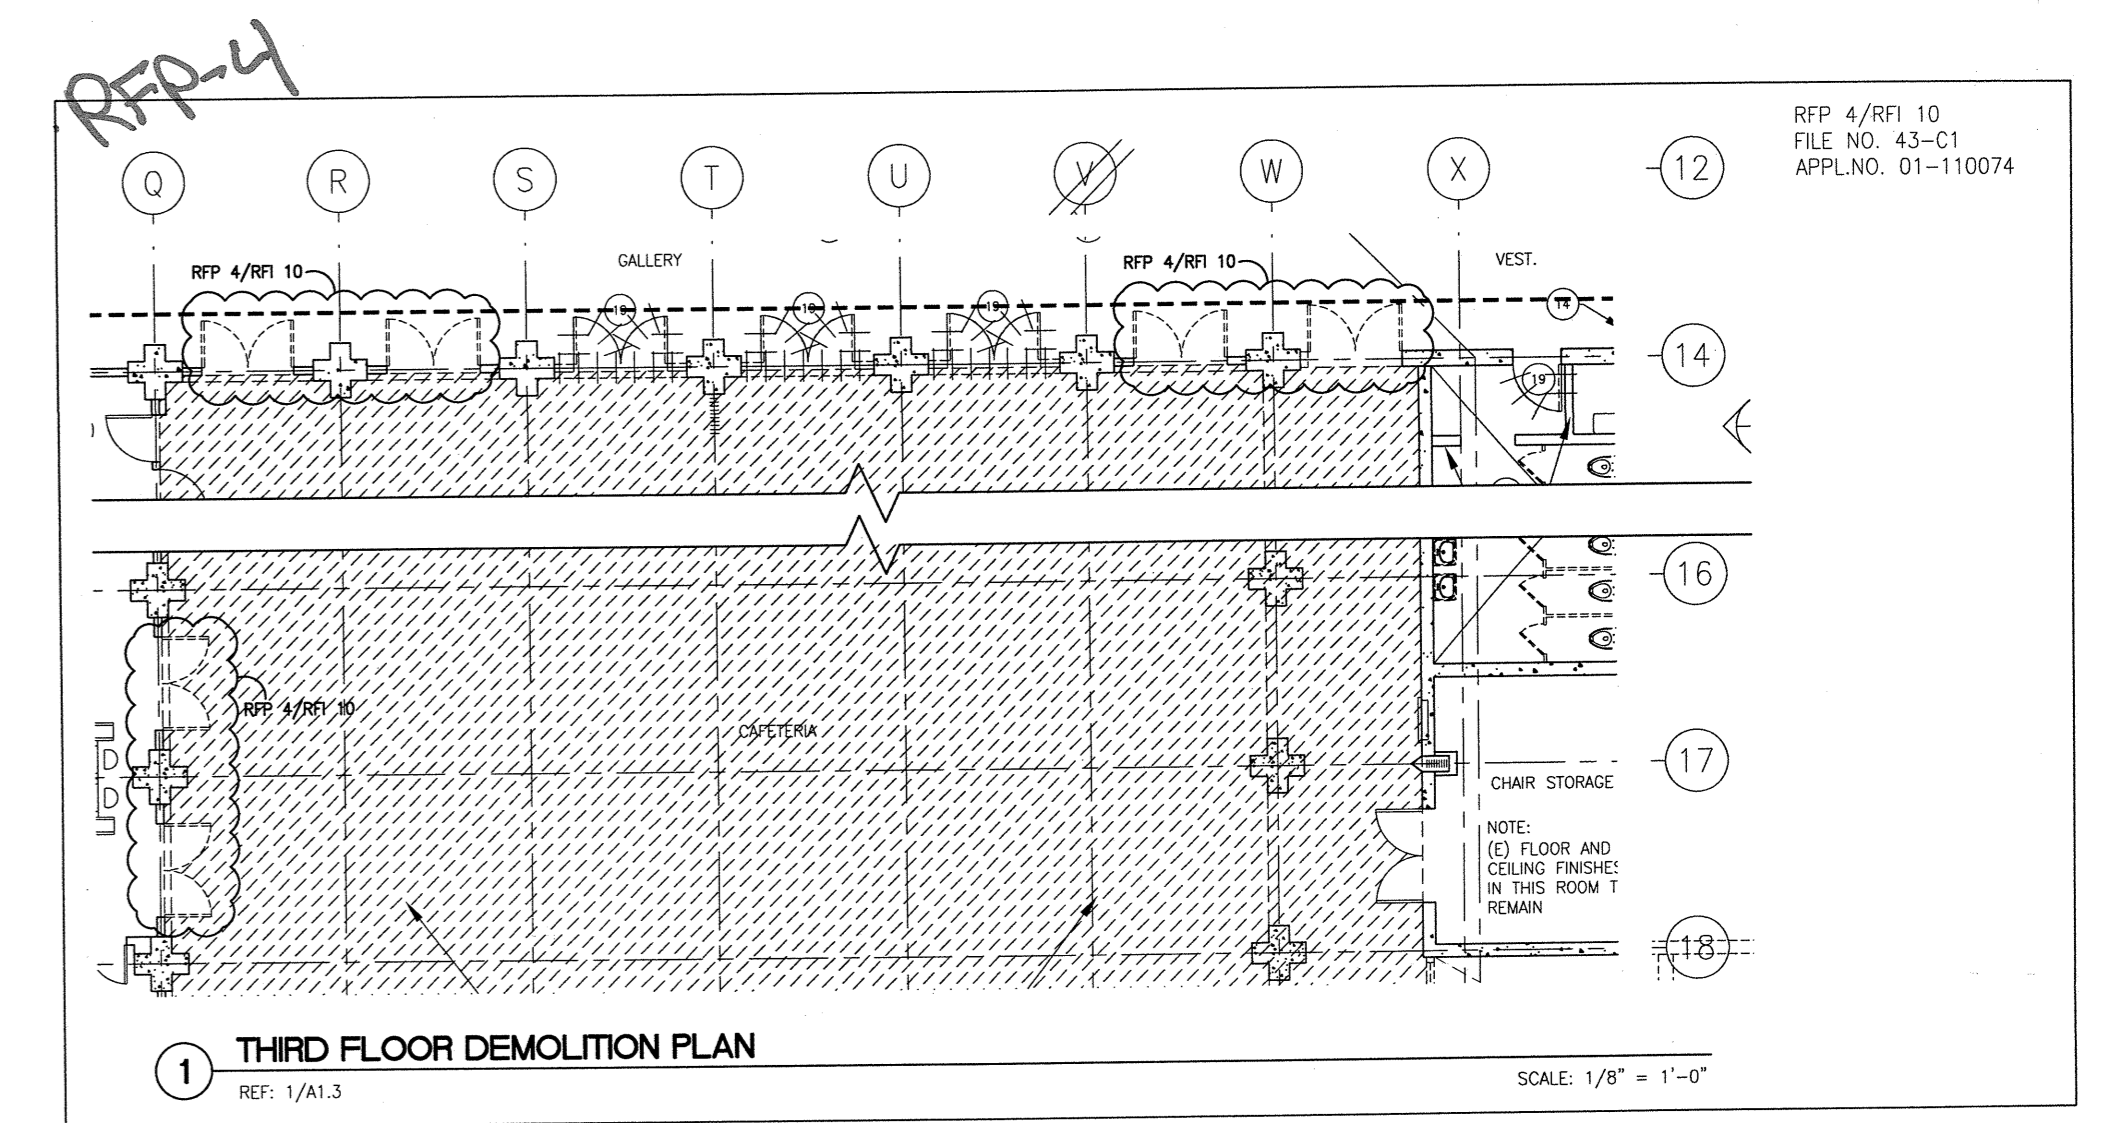


BCA architecture planning interiors
THIRD FLOOR DOORS
 Project Name: CANADA COLLEGE - BUILDINGS 5 & 6 RENOVATIONS
 SAN MATEO COUNTRY COMMUNITY COLLEGE DISTRICT
 4200 FARM HILL BOULEVARD
 REDWOOD CITY, CA 94061
 FILE NO. 43-C1 APPL. 01-110074

Revision: RFP 4
 Date: 05/20/11
 Scale: AS NOTED
 Project Number: ASK-1A
 Drawing Number: 4

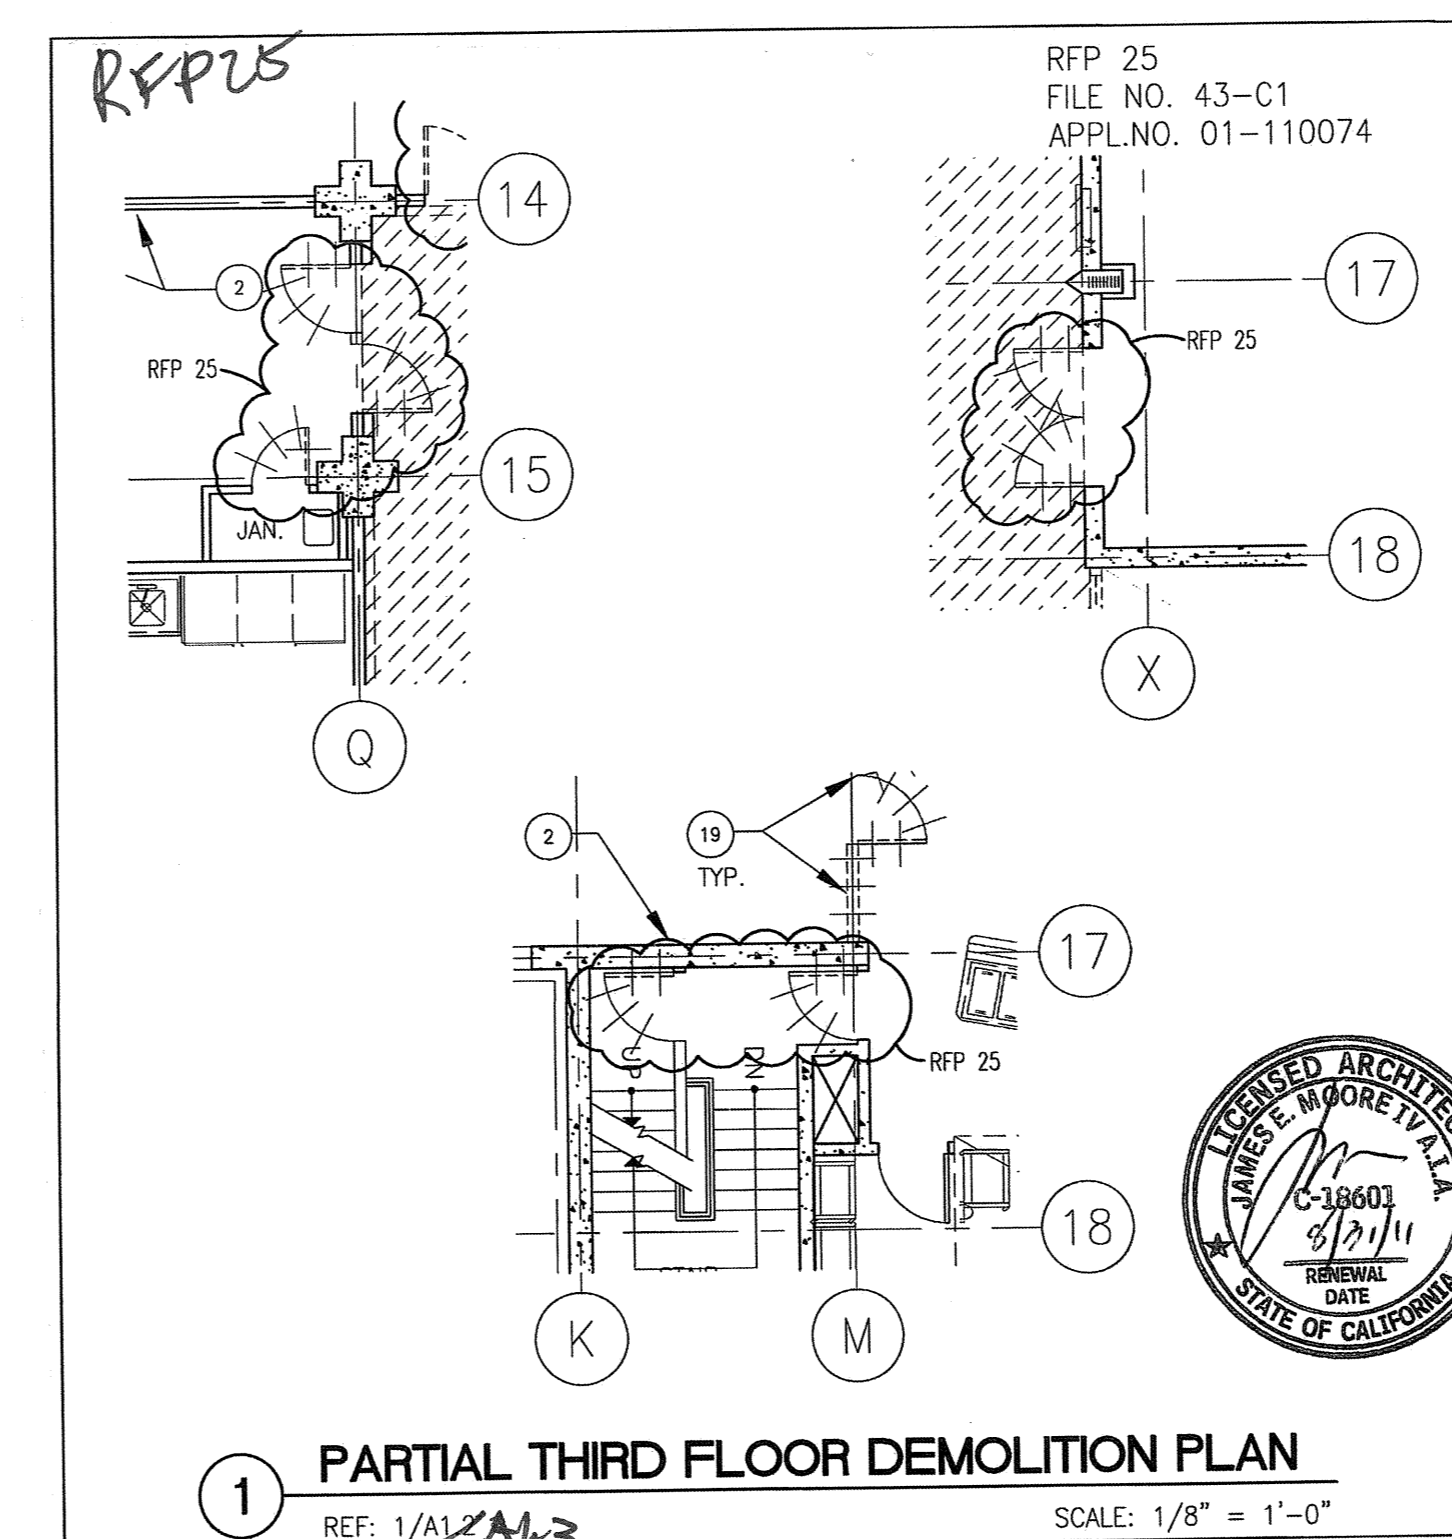

BCA architecture planning interiors
NEW DOORS
 Project Name: CANADA COLLEGE - BUILDINGS 5 & 6 RENOVATIONS
 SAN MATEO COUNTRY COMMUNITY COLLEGE DISTRICT
 4200 FARM HILL BOULEVARD
 REDWOOD CITY, CA 94061
 FILE NO. 43-C1 APPL. 01-110074

Revision: RFP 25
 Date: 05/20/11
 Scale: AS NOTED
 Project Number: ASK-14C
 Drawing Number: 25

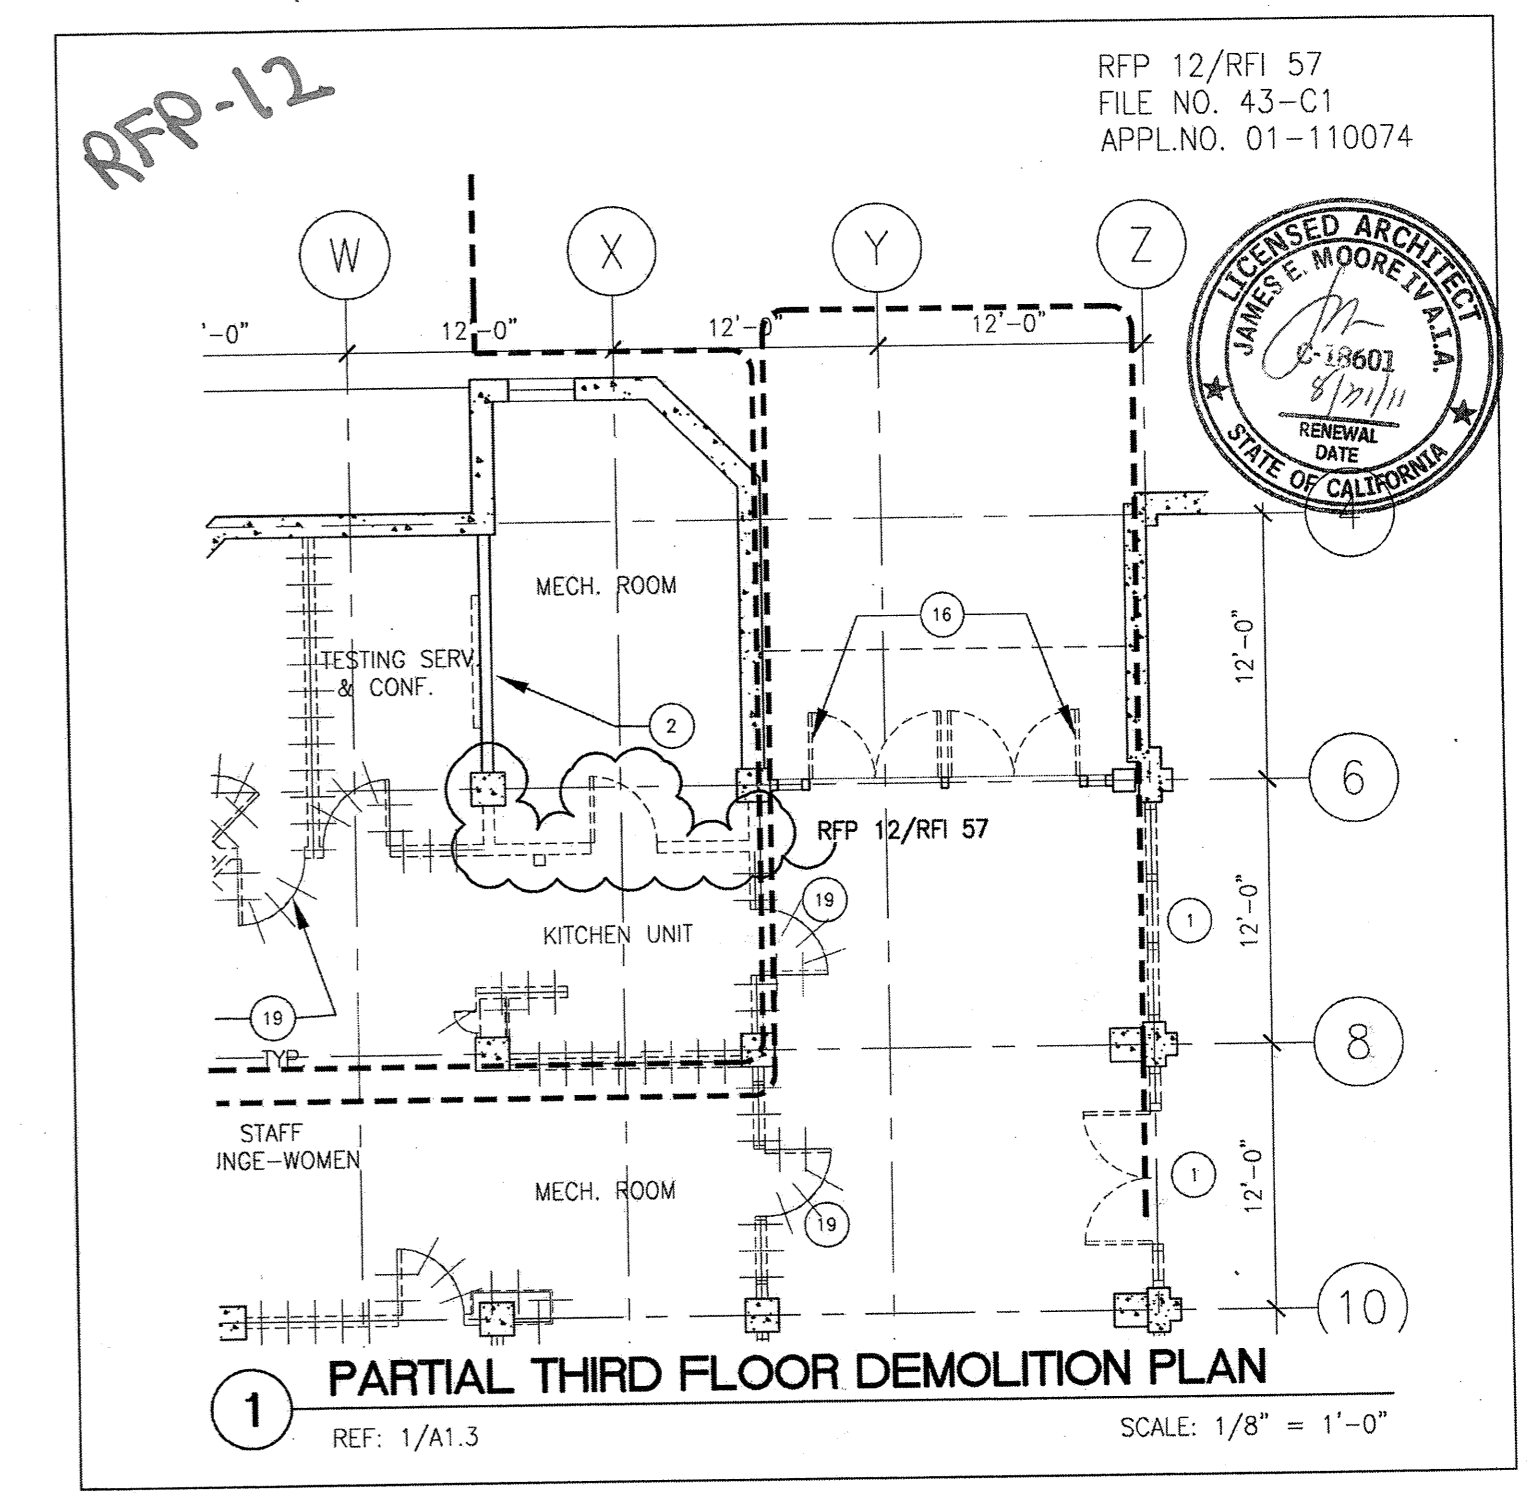

BCA architecture planning interiors
3RD FLOOR ELEC. AND MECH. ROOMS
 Project Name: CANADA COLLEGE - BUILDINGS 5 & 6 RENOVATIONS
 SAN MATEO COUNTRY COMMUNITY COLLEGE DISTRICT
 4200 FARM HILL BOULEVARD
 REDWOOD CITY, CA 94061
 FILE NO. 43-C1 APPL. 01-110074

Revision: RFP 12
 Date: 05/20/11
 Scale: AS NOTED
 Project Number: ASK-4A
 Drawing Number: 12