


BCA architecture planning interiors	THE	Revision:	RFP No.:
	WALL BASE DETAIL	RFI 113	18
PROJECT NAME:	CARADA COLLEGE - BUILDINGS 5 & 6 RENOVATIONS SAN MATEO COUNTY COMMUNITY COLLEGE DISTRICT	DATE:	Drawing Number:
FILE NO. 43-C1 APPL. 01-110074	4200 FARM HILL BOULEVARD REDWOOD CITY, CA 94061	02/22/2010	ASK-10F
DATE PLOTTED:	02/22/2010	PROJECT NUMBER:	0913
SCALE:	AS NOTED		

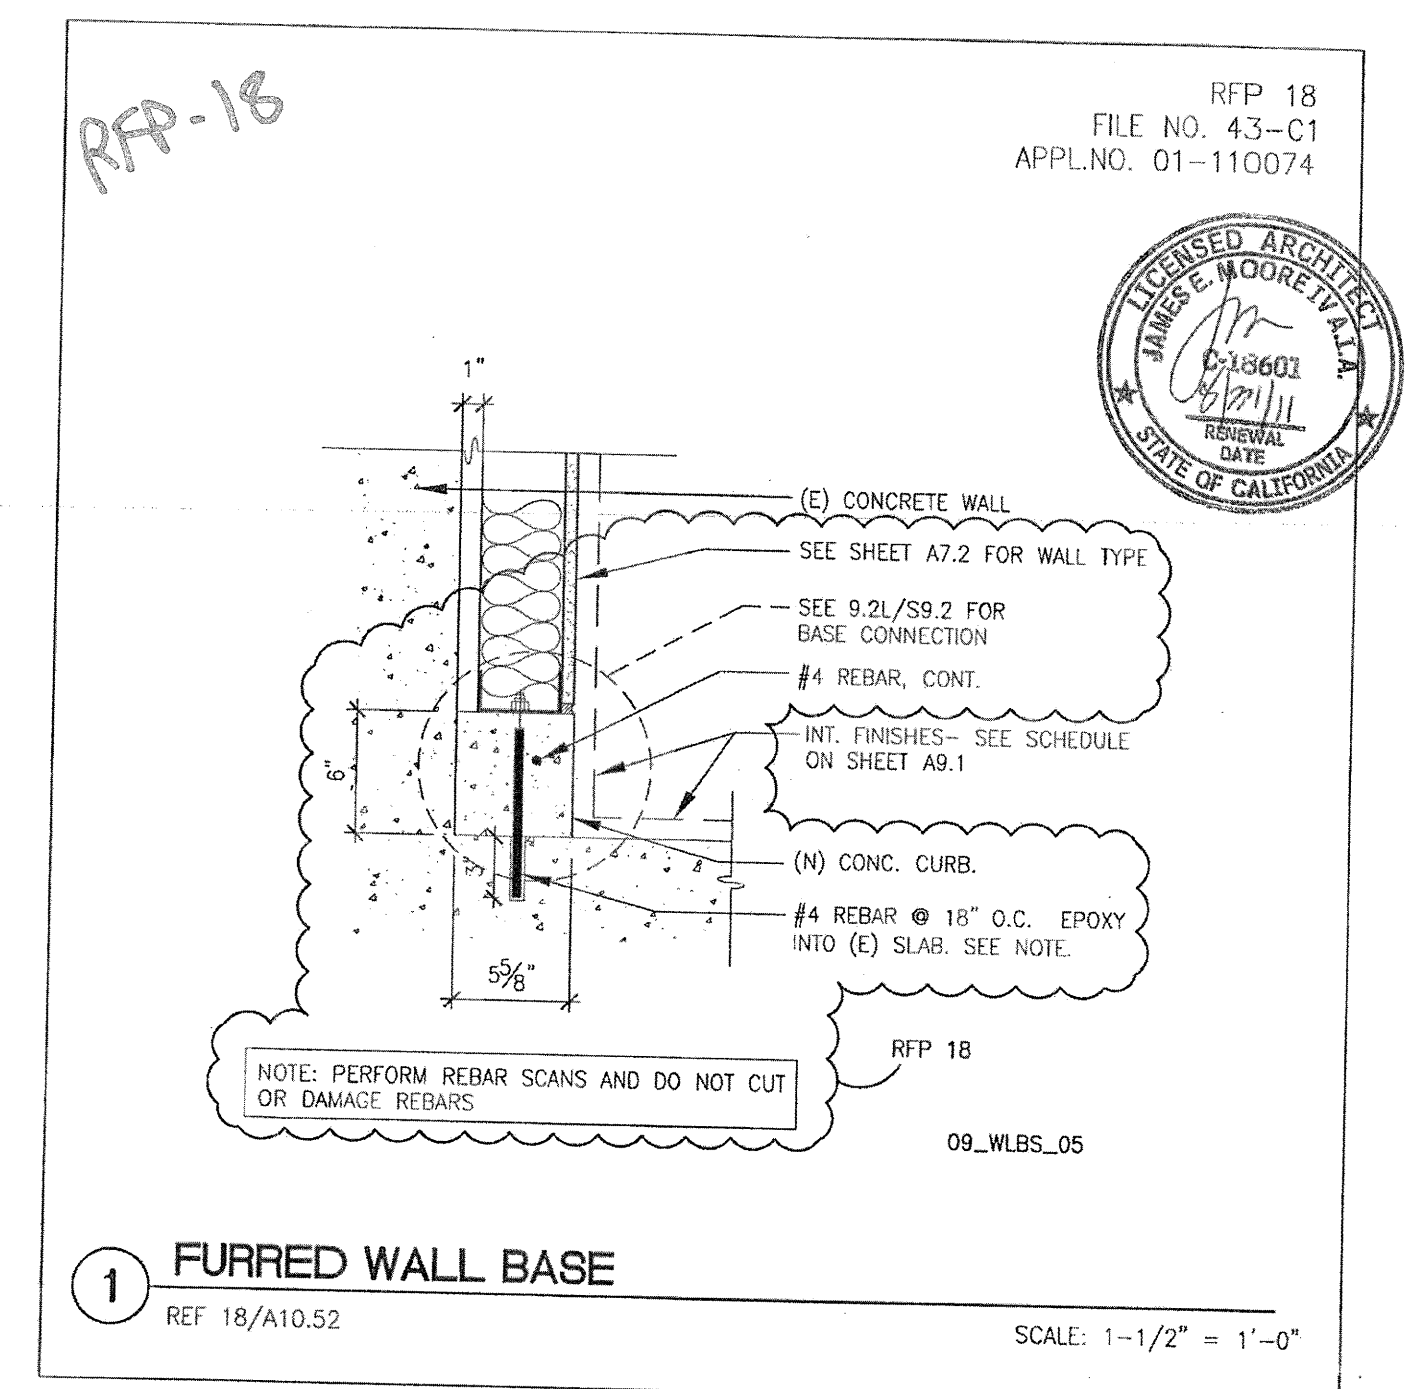

BCA architecture planning interiors	THE	Revision:	RFP No.:
	FURRED WALL BASE DETAIL	RFI 113	18
PROJECT NAME:	CARADA COLLEGE - BUILDINGS 5 & 6 RENOVATIONS SAN MATEO COUNTY COMMUNITY COLLEGE DISTRICT	DATE:	Drawing Number:
FILE NO. 43-C1 APPL. 01-110074	4200 FARM HILL BOULEVARD REDWOOD CITY, CA 94061	02/22/2010	ASK-10E
DATE PLOTTED:	02/22/2010	PROJECT NUMBER:	0913
SCALE:	AS NOTED		