




A102 NORTH ELEVATION

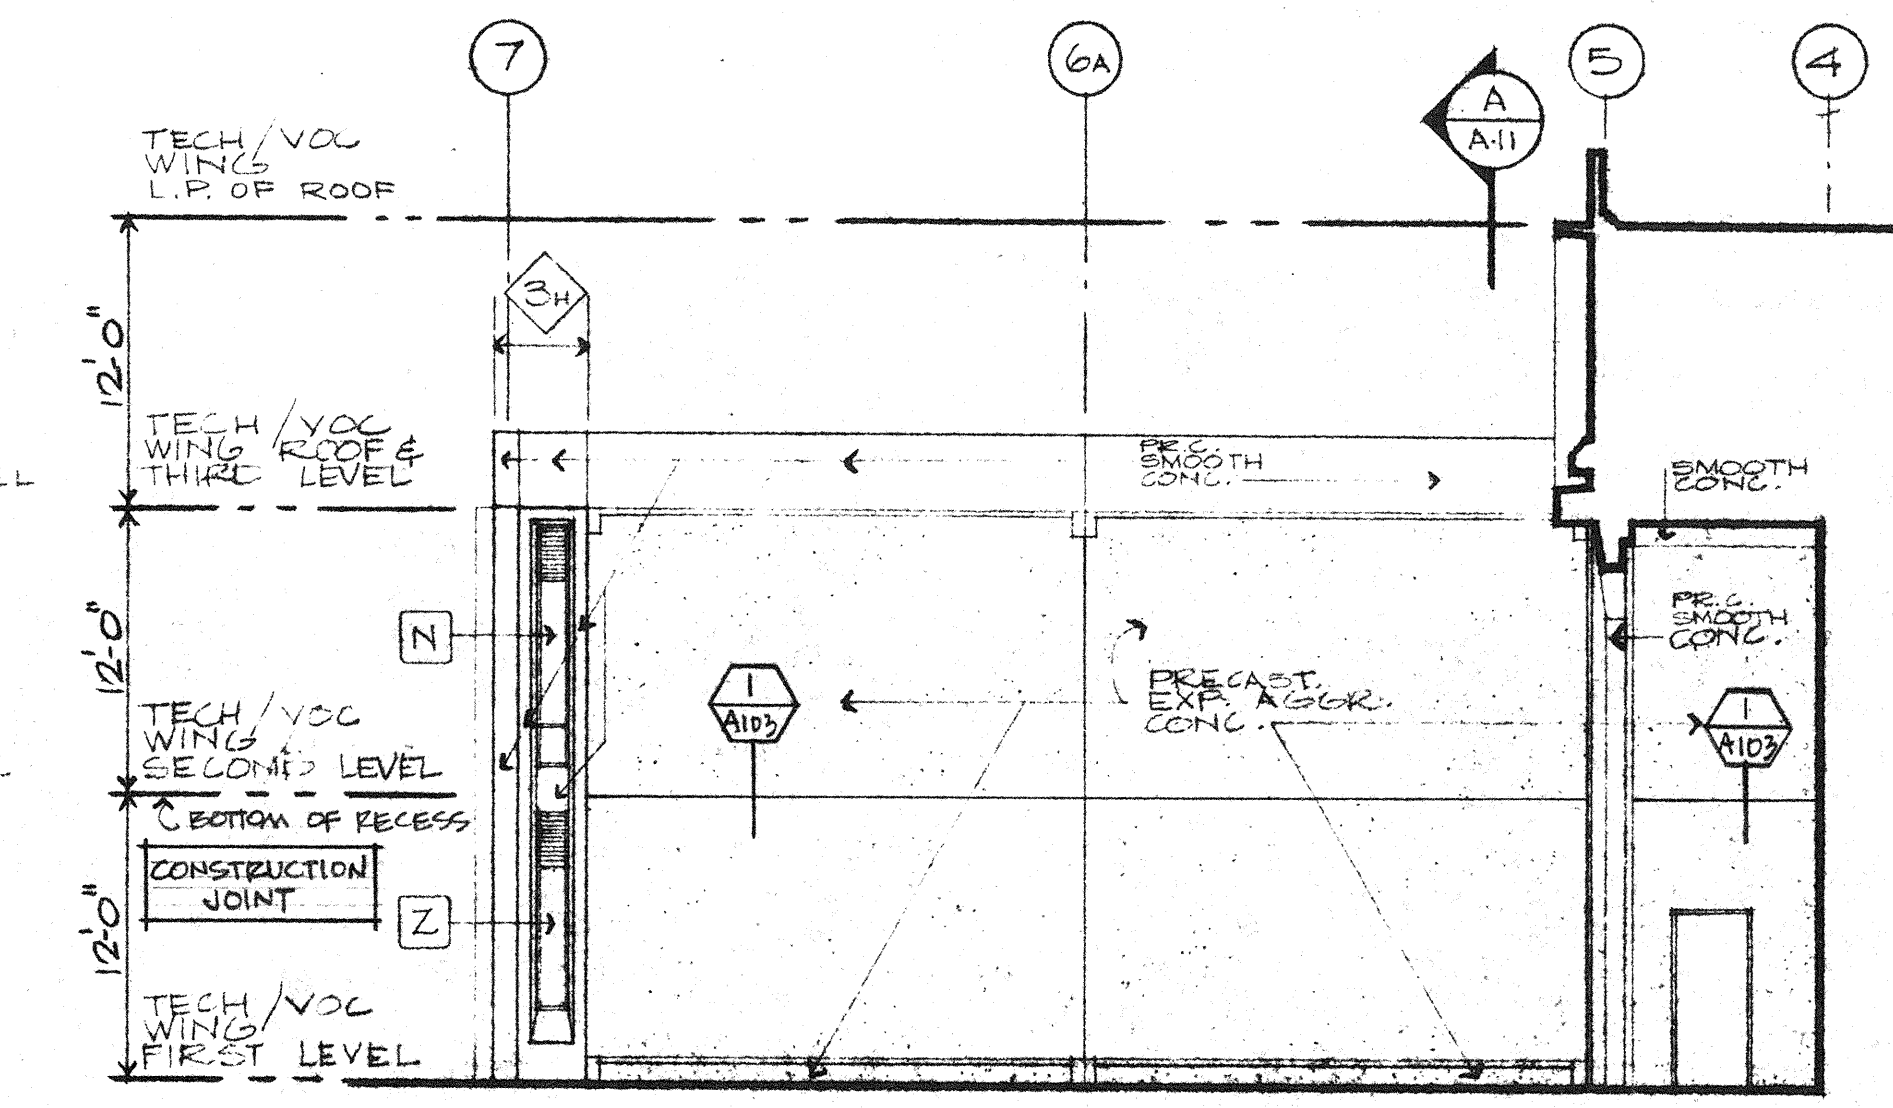


B NORTH ELEVATION

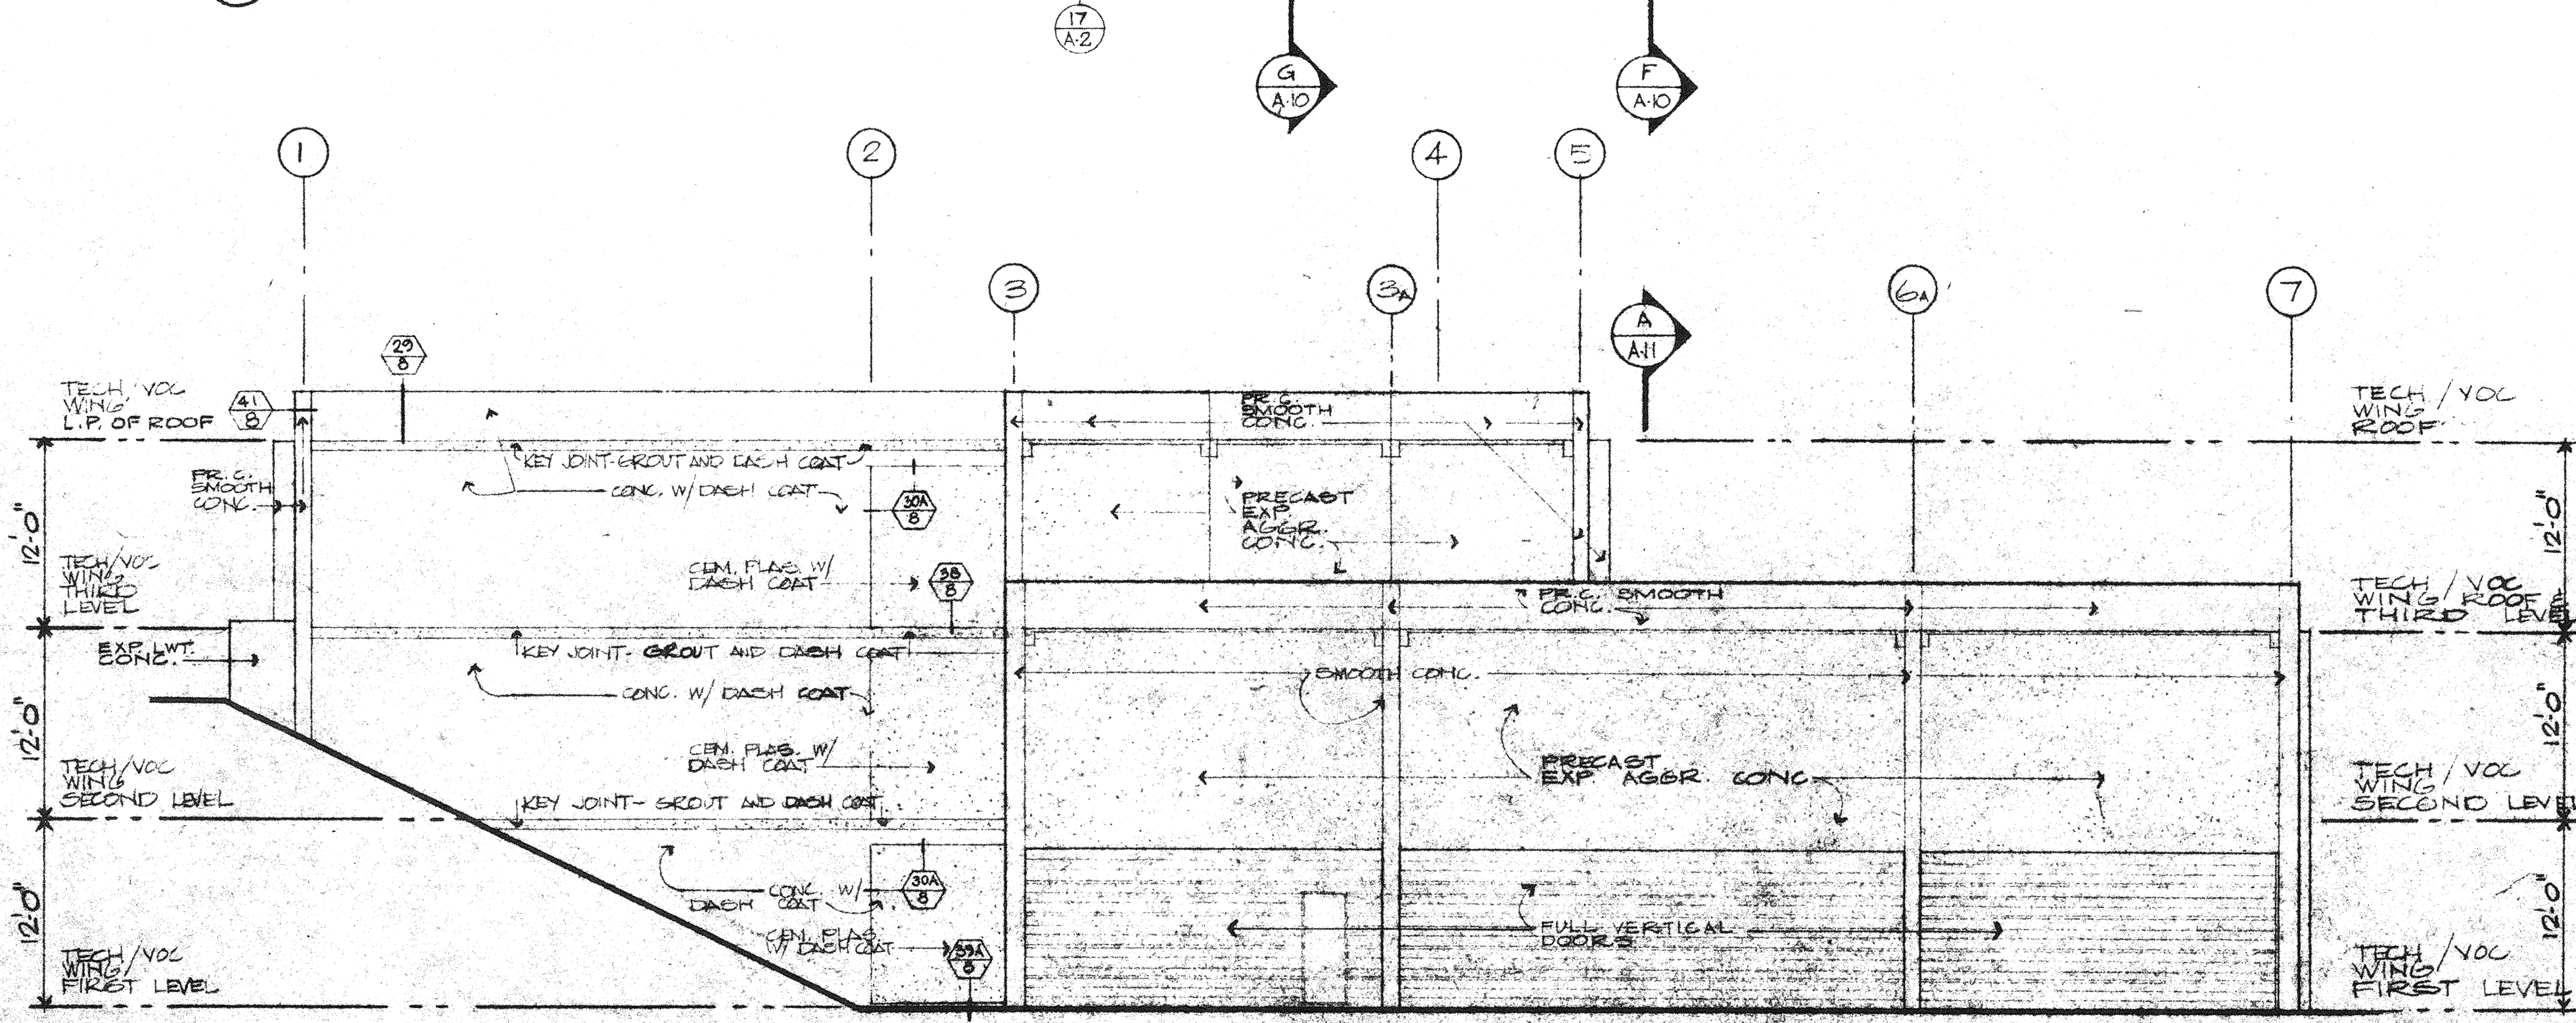

C PARTIAL SOUTH ELEVATION

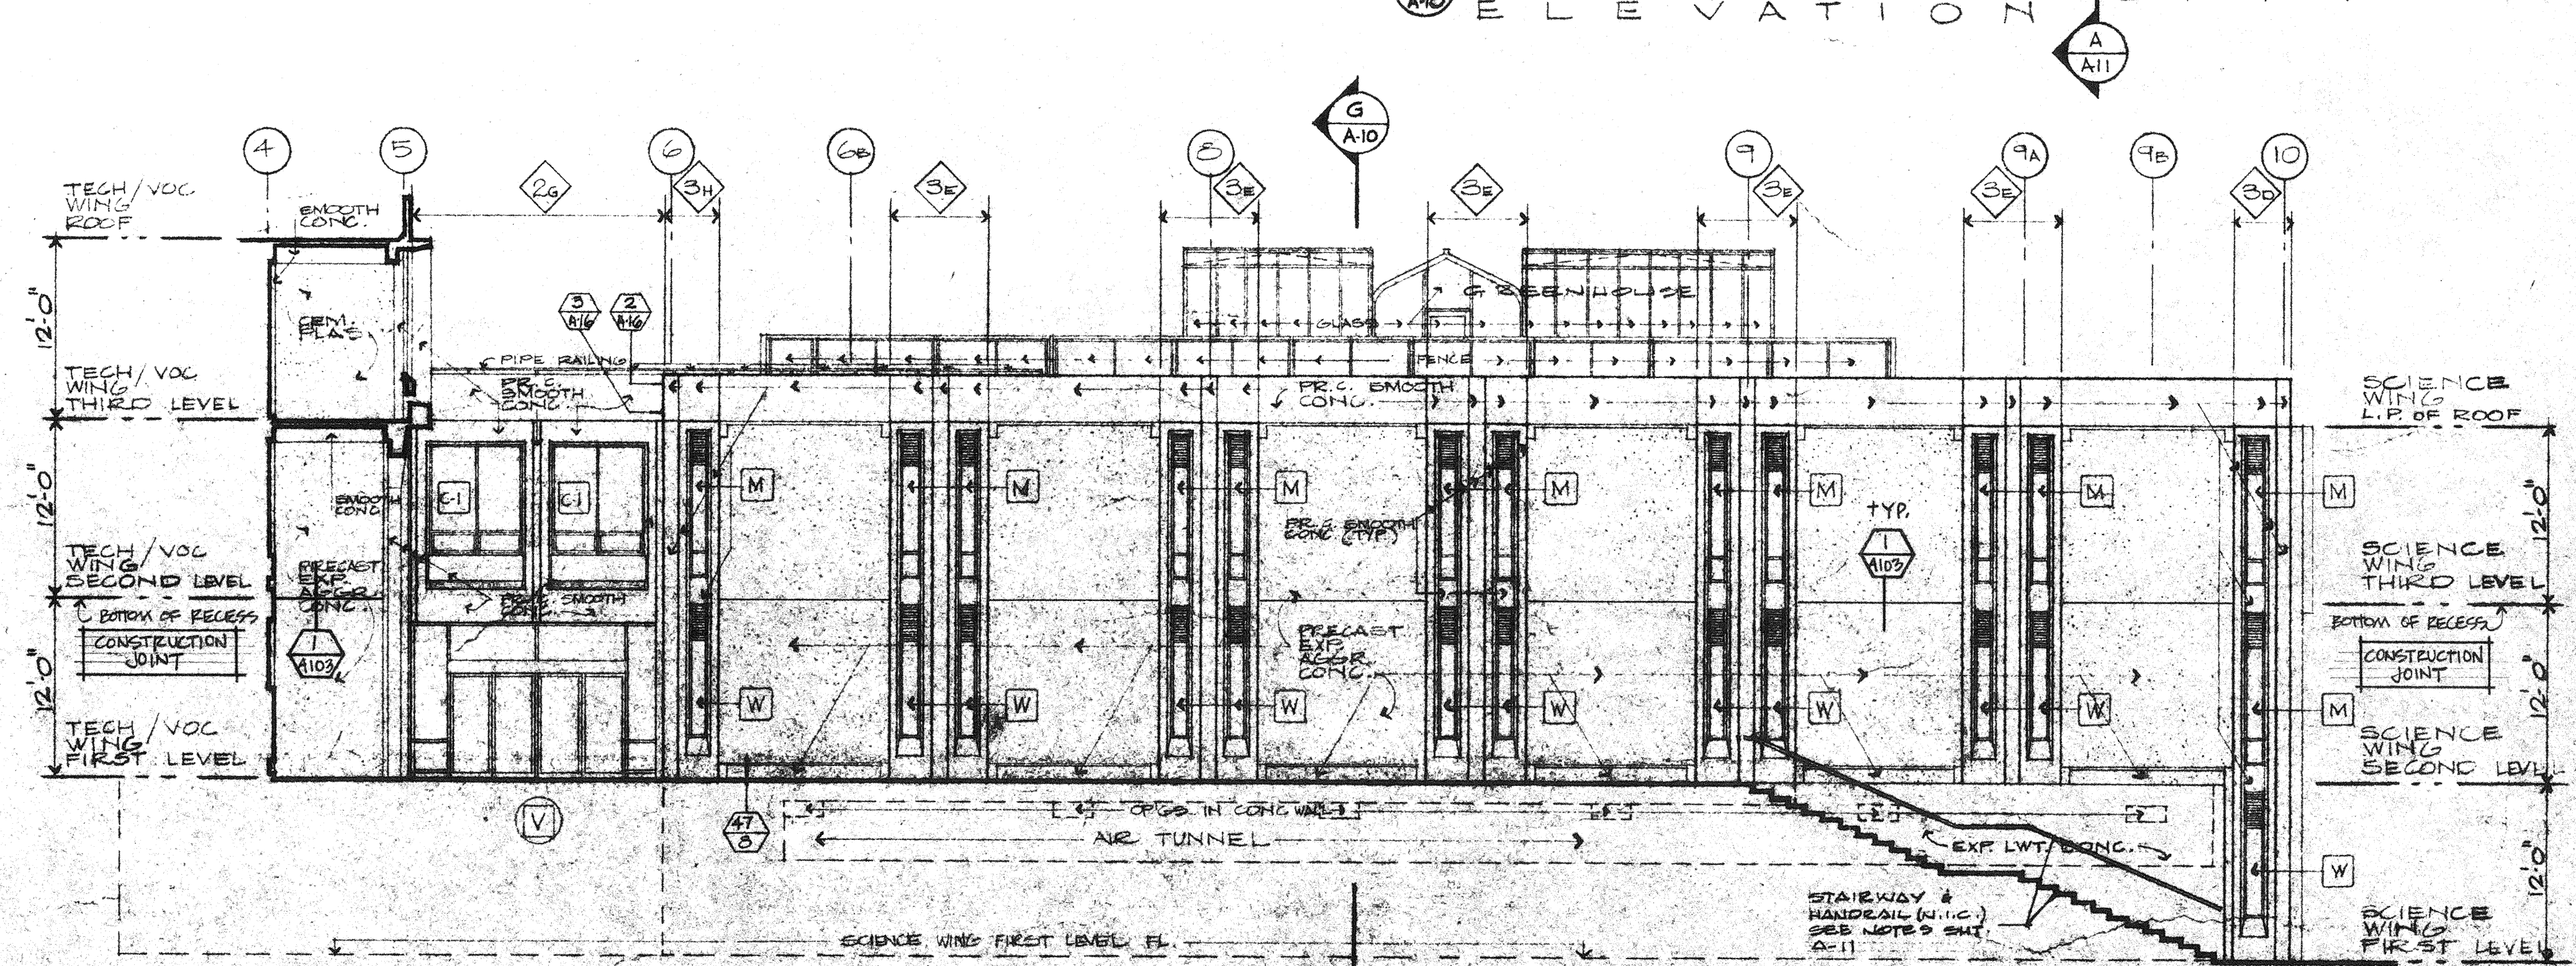


D PARTIAL SOUTH ELEVATION

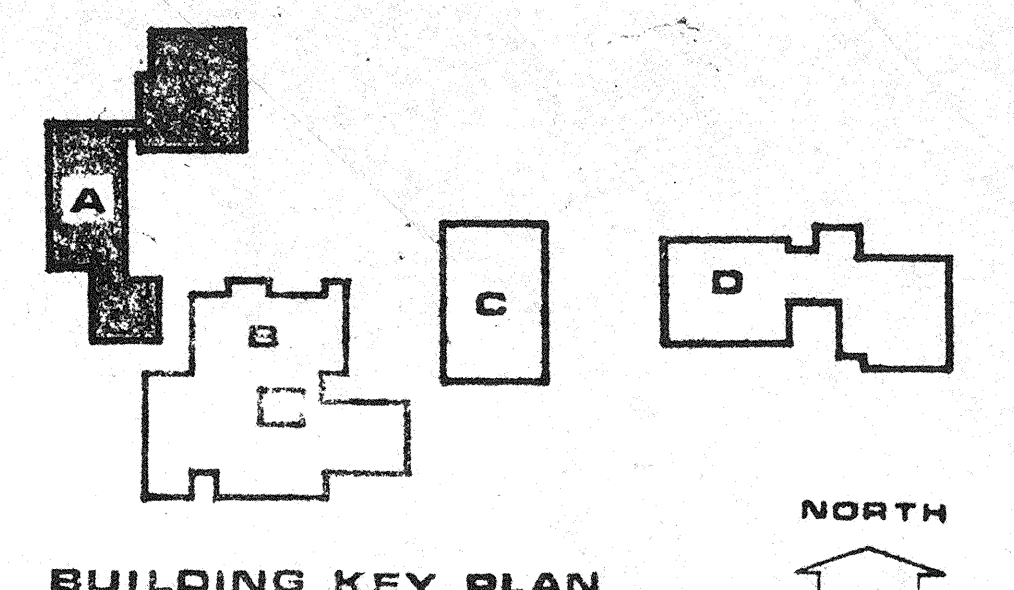

JOHN CARL WARNECKE P.A.L.

JOHN CARL WARNECKE AND ASSOCIATES
ARCHITECTS AND PLANNING CONSULTANTS
 51 NEW MONTGOMERY STREET SAN FRANCISCO

DAVIDE THOMPSON
 STRUCTURAL ENGINEER
 CARL E. KIRKER
 MECH. & ELEC. ENGINEERS
 CIVIL ENGINEERS

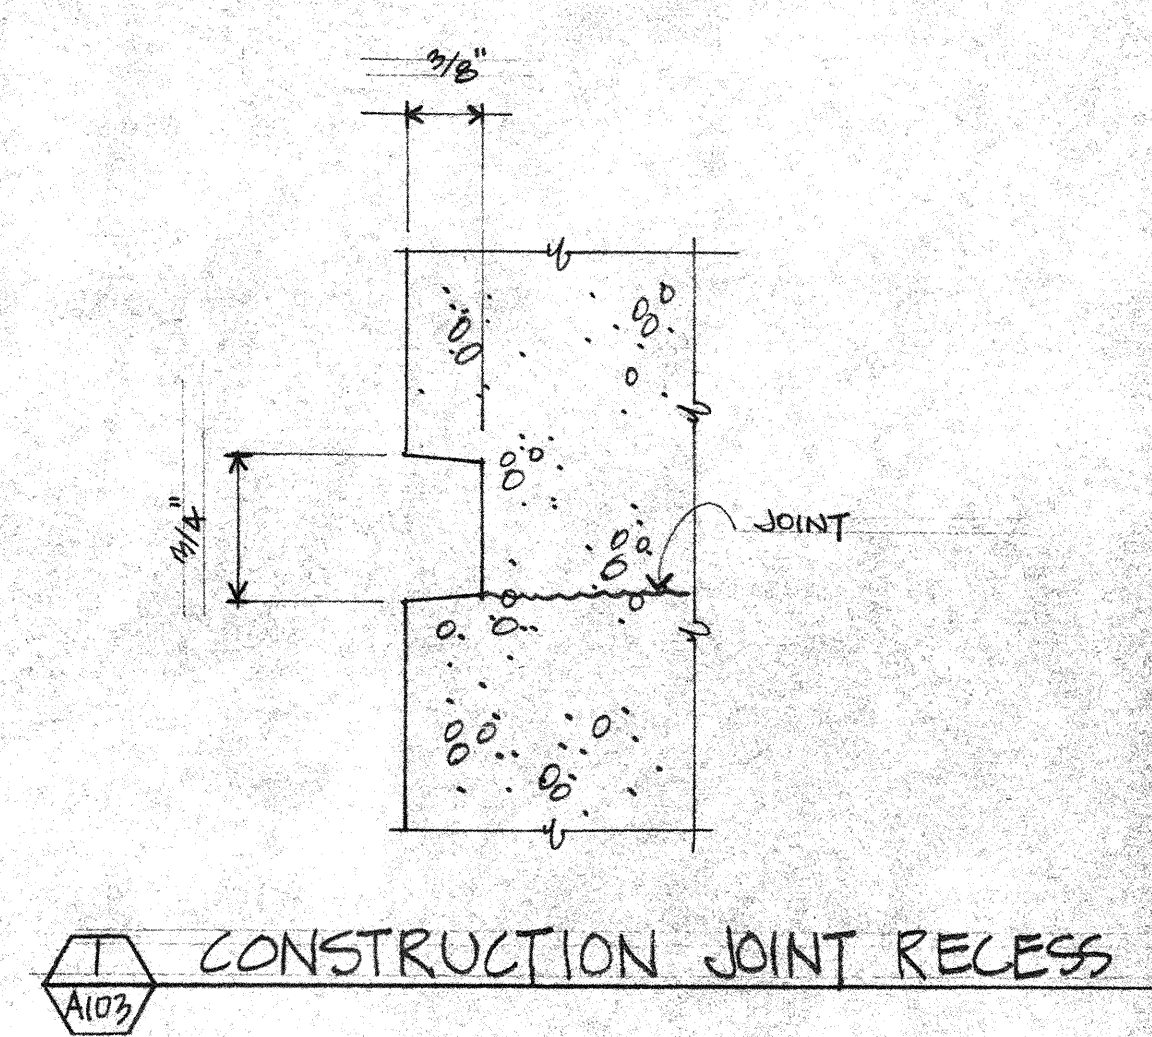

CONSTRUCTION JOINT CLARIFICATION

BUILDING A SCIENCE, TECH/VOL.
 EXTERIOR ELEVATIONS & BLDG. SECTIONS
COLLEGE OF SAN MATEO
 SAN BRUNO CALIFORNIA

SCALE AS NOTED	REVISION DESCRIPTION	DATE	APPROVED
JOB NO. 44-15			
D.S. E.F.			
CHECK BY			
DATE 9/26/67			
SHEET NUMBER			
A102			
OF SHEETS			
REVISION NO.			