




BCA Title: DOOR & HARDWARE MODIFICATION Revision: RFP-52
 architecture planning interiors
 CANADA COLLEGE - BUILDINGS 5 & 6 RENOVATIONS
 SAN MATEO COUNTRY COMMUNITY COLLEGE DISTRICT
 4200 FARM HILL BOULEVARD
 REDWOOD CITY, CA 94061
 FILE NO. 43-C1 APPL. 01-110074
 Date: 12/01/06
 Scale: AS NOTED
 Project Number: ASK-24
 Drawing Number: 0203

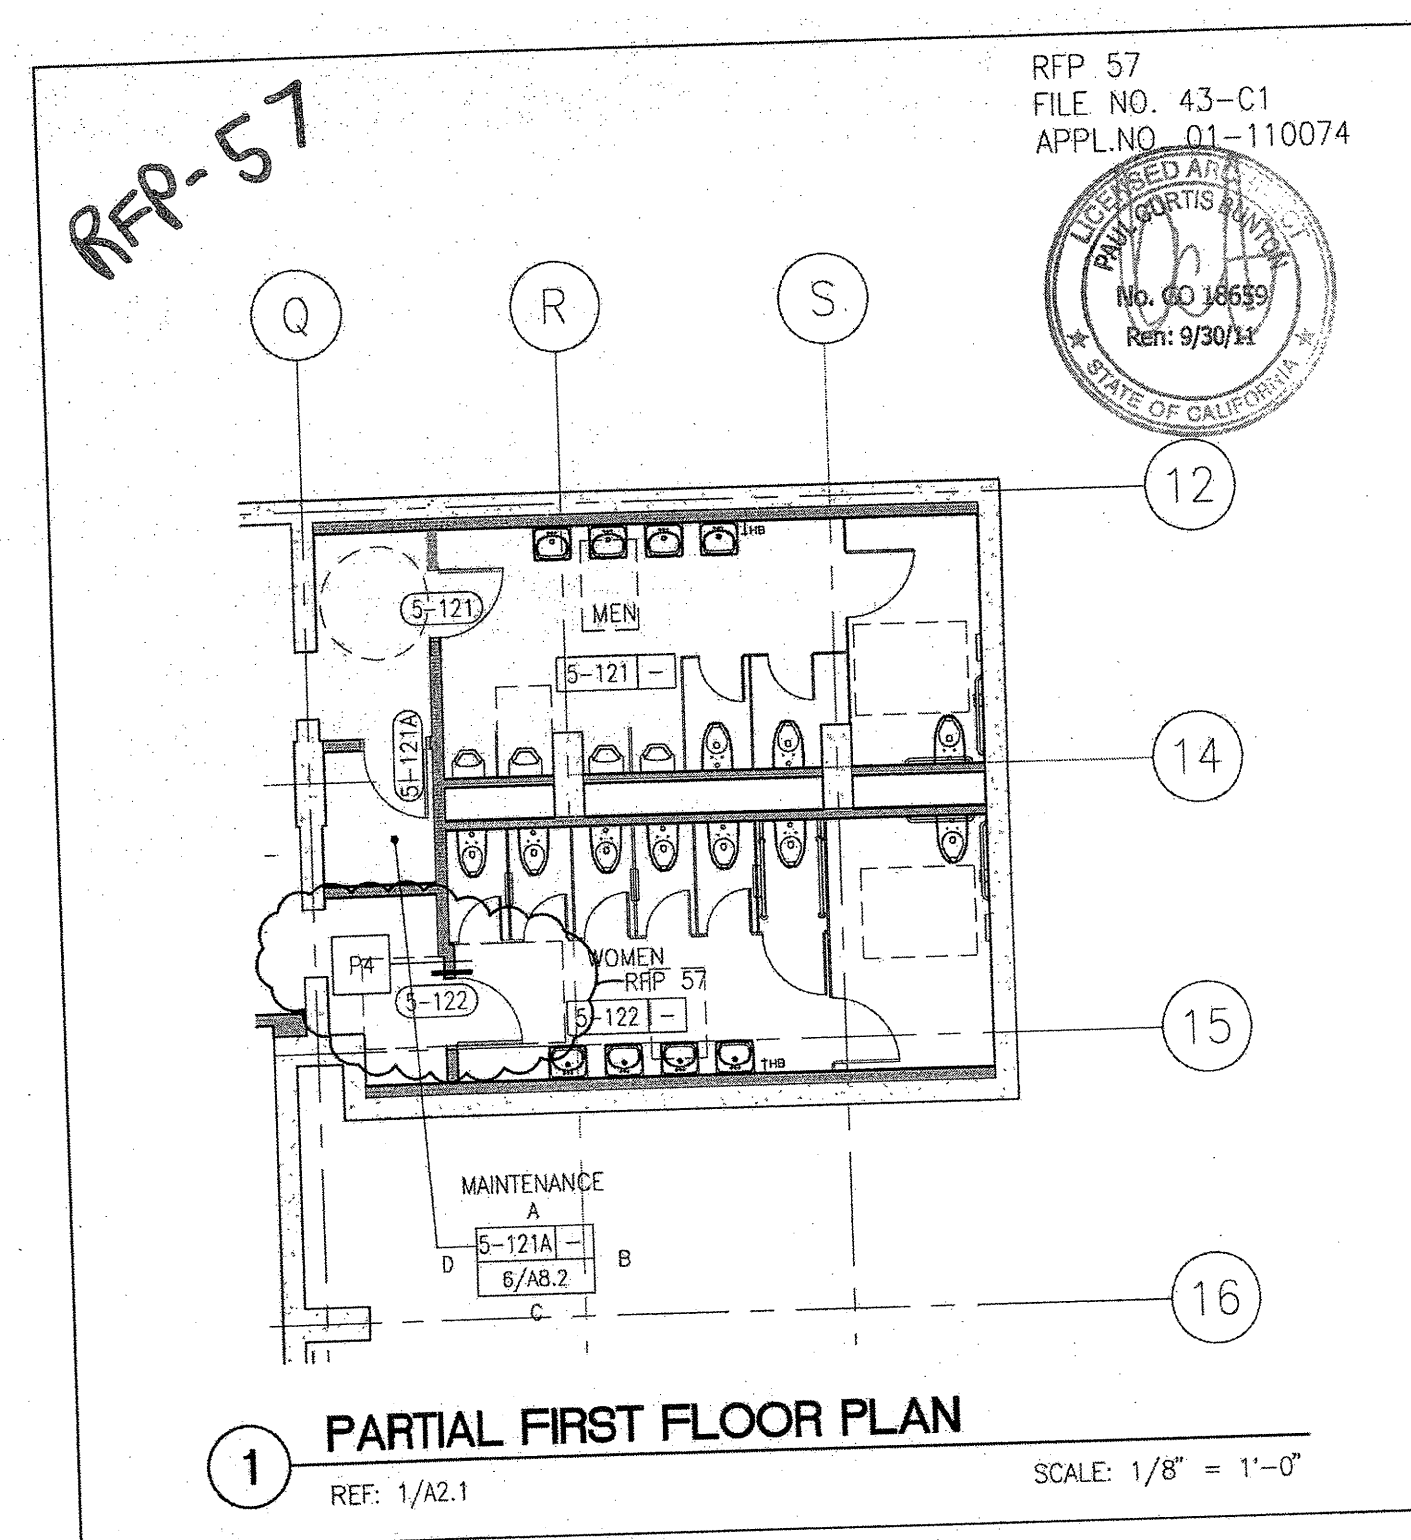

BCA Title: DOOR MODIFICATION Revision: RFP-57
 architecture planning interiors
 CANADA COLLEGE - BUILDINGS 5 & 6 RENOVATIONS
 SAN MATEO COUNTRY COMMUNITY COLLEGE DISTRICT
 4200 FARM HILL BOULEVARD
 REDWOOD CITY, CA 94061
 FILE NO. 43-C1 APPL. 01-110074
 Date: 12/01/06
 Scale: AS NOTED
 Project Number: ASK-27C
 Drawing Number: 0203

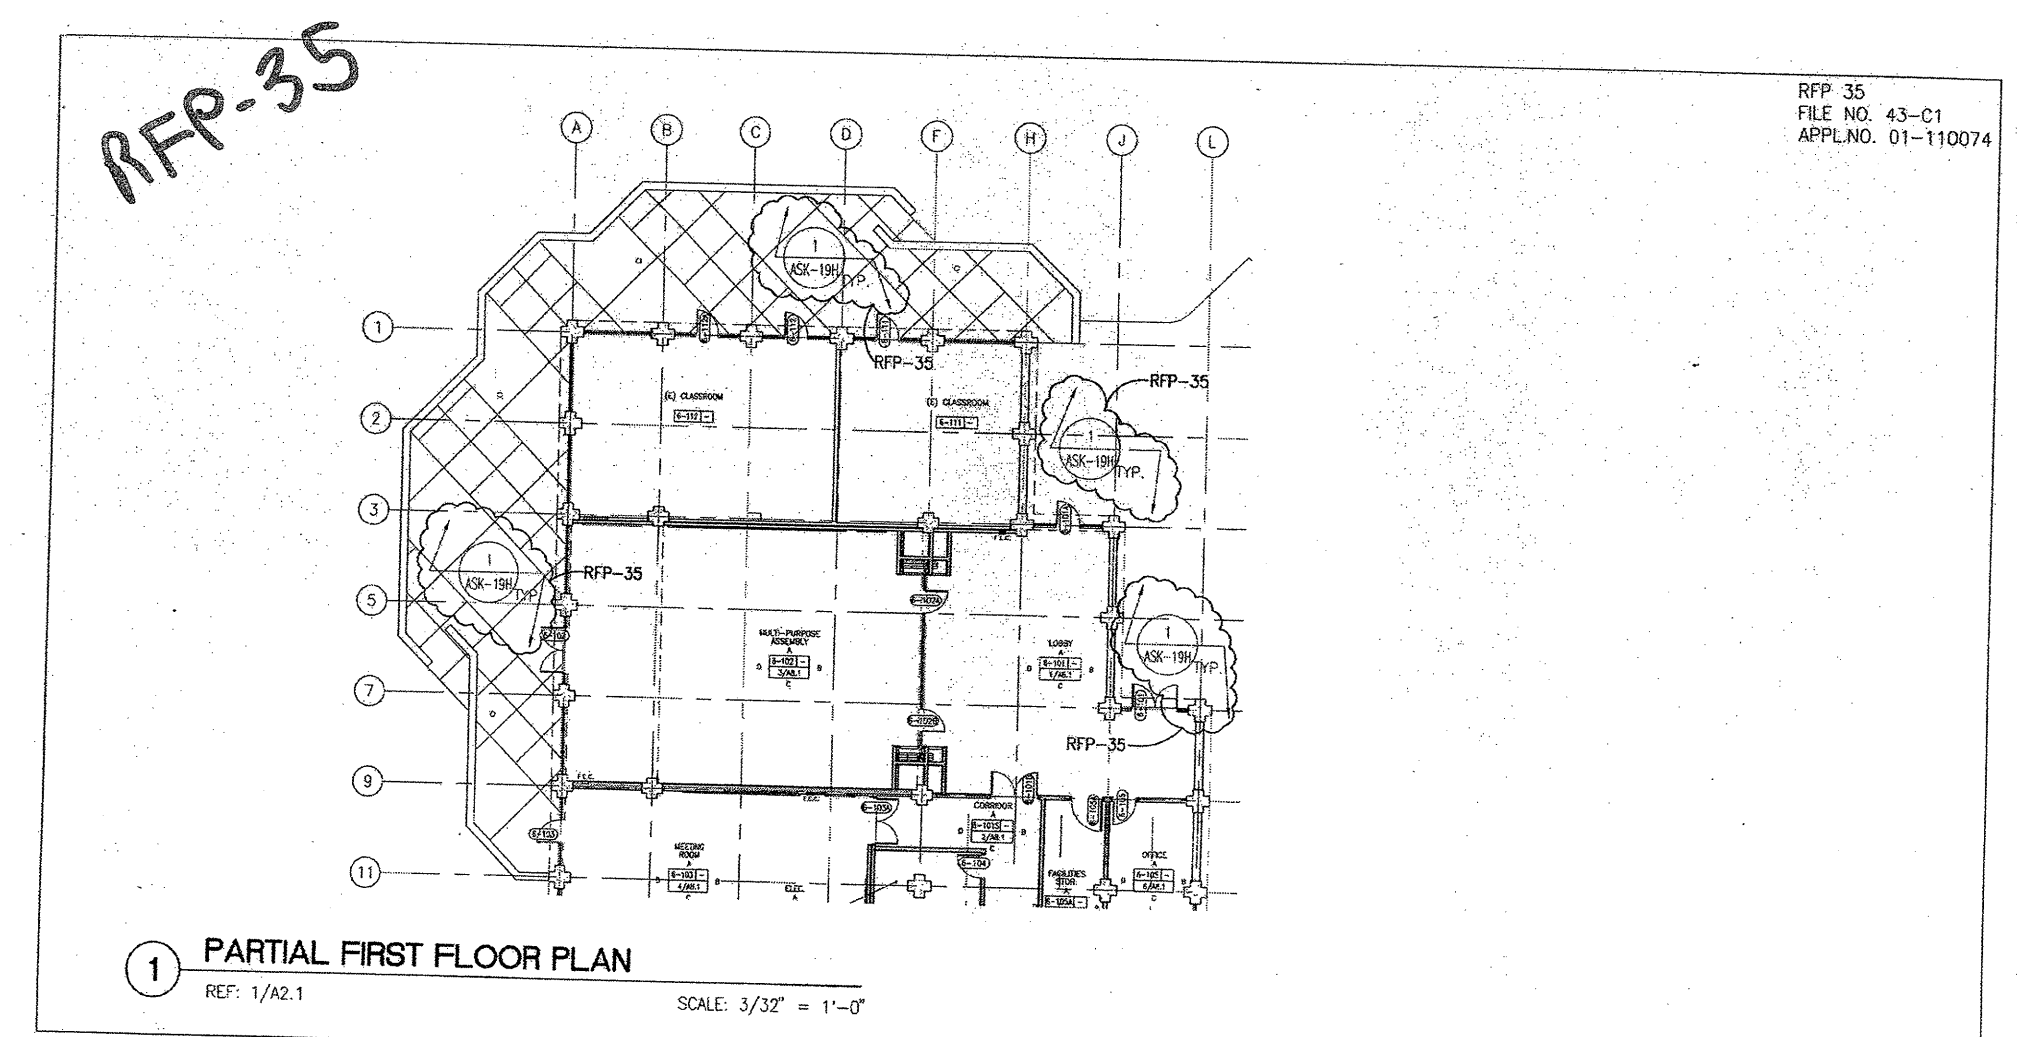

BCA Title: EXTERIOR TERRACE WATERPROOFING Revision: RFP-35
 architecture planning interiors
 CANADA COLLEGE - BUILDINGS 5 & 6 RENOVATIONS
 SAN MATEO COUNTRY COMMUNITY COLLEGE DISTRICT
 4200 FARM HILL BOULEVARD
 REDWOOD CITY, CA 94061
 FILE NO. 43-C1 APPL. 01-110074
 Date: 12/01/06
 Scale: AS NOTED
 Project Number: ASK-19G
 Drawing Number: 0203

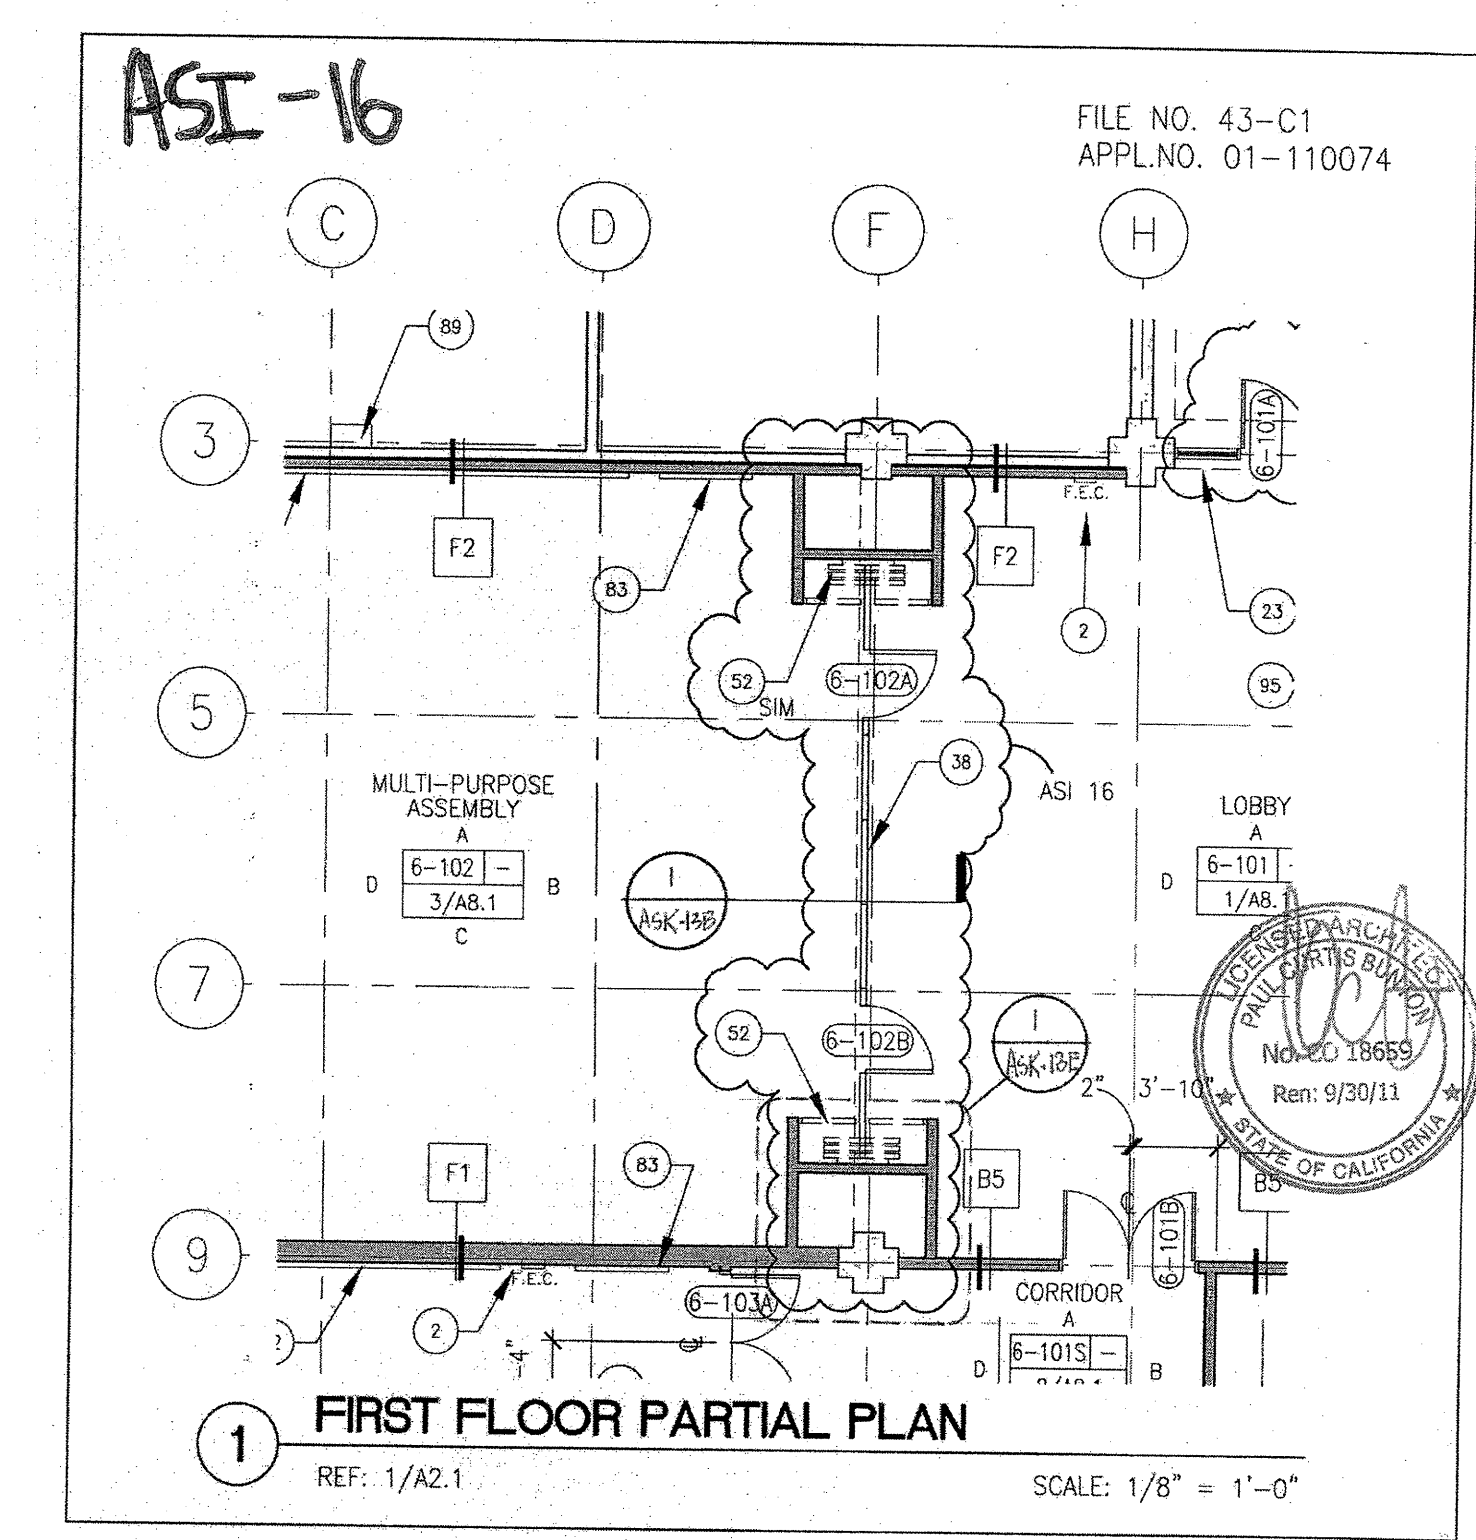

BCA Title: FOLDING PARTITION LAYOUT Revision: ASI-16
 architecture planning interiors
 CANADA COLLEGE - BUILDINGS 5 & 6 RENOVATIONS
 SAN MATEO COUNTRY COMMUNITY COLLEGE DISTRICT
 4200 FARM HILL BOULEVARD
 REDWOOD CITY, CA 94061
 FILE NO. 43-C1 APPL. 01-110074
 Date: 09/20/06
 Scale: AS NOTED
 Project Number: ASK-13A
 Drawing Number: 0203