




Canada B5/6
Central Duplication
Proposed Layout
From Meeting 08-19-10
Kent DDCI 08-29-10

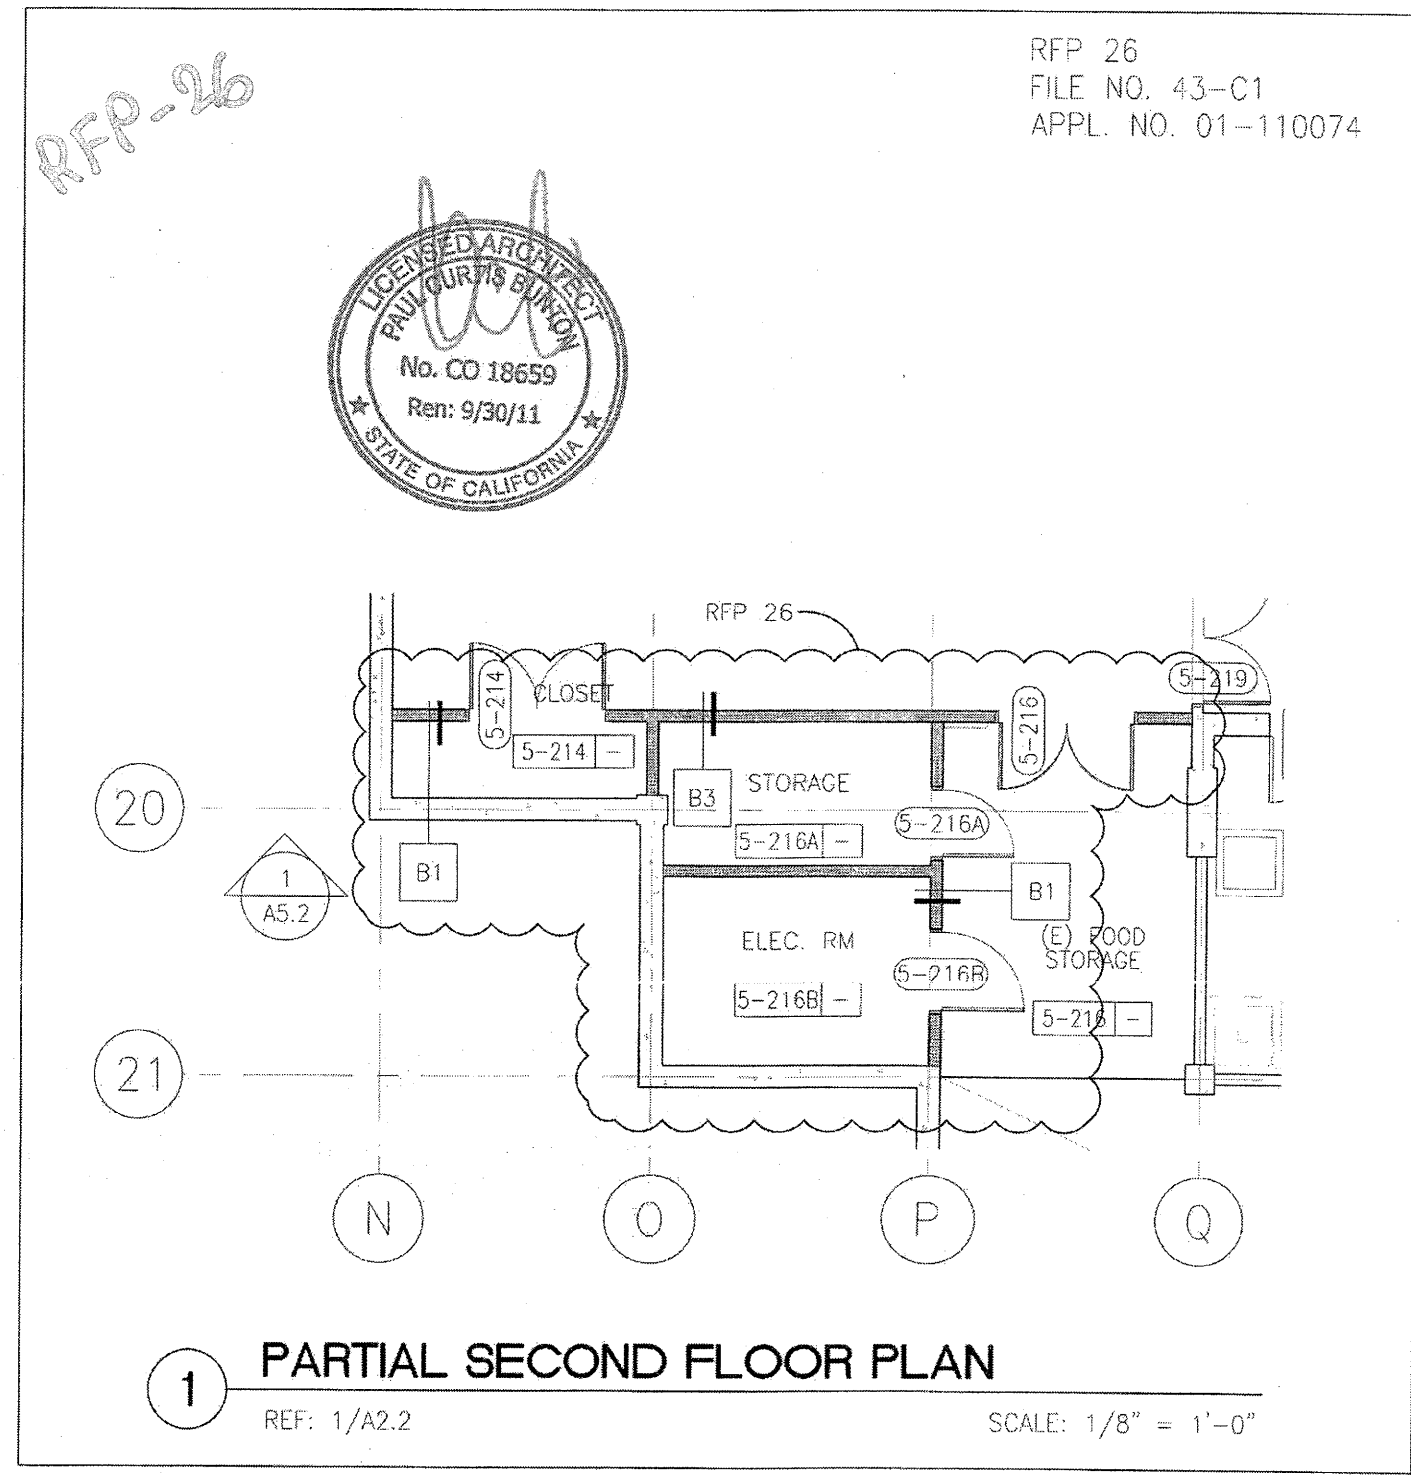

BCA architecture planning interiors
 Project Name: CANADA COLLEGE - BUILDINGS 5 & 6 RENOVATIONS
 SAN MATEO COUNTRY COMMUNITY COLLEGE DISTRICT
 4200 FARM HILL BOULEVARD
 REDWOOD CITY, CA 94061
 FILE NO. 43-C1 APPL. 01-110074
 Date: 08/28/11
 Scale: AS NOTED
 Project Number: 08/13
 Drawing Number: ASK-15B

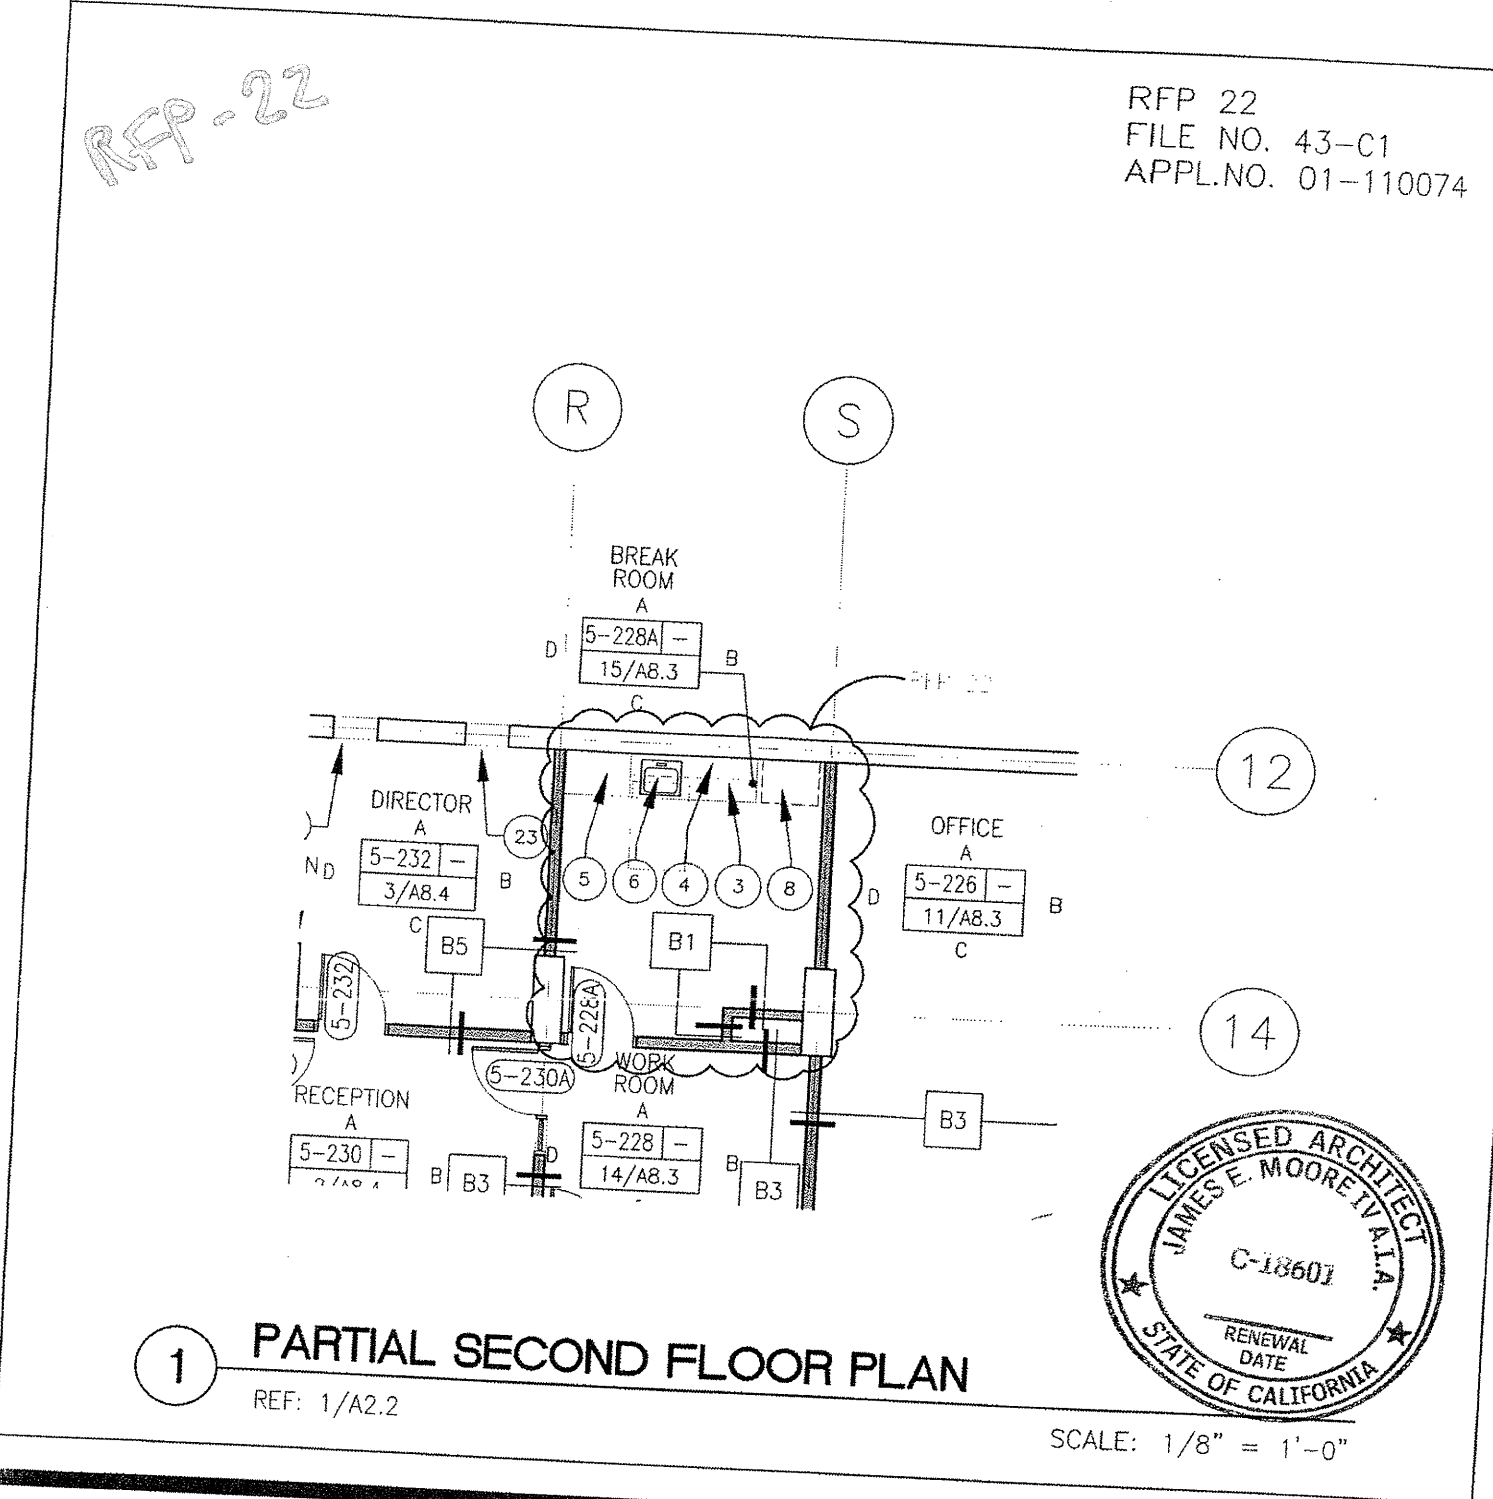


BCA architecture planning interiors
 Project Name: CANADA COLLEGE - BUILDINGS 5 & 6 RENOVATIONS
 SAN MATEO COUNTRY COMMUNITY COLLEGE DISTRICT
 4200 FARM HILL BOULEVARD
 REDWOOD CITY, CA 94061
 FILE NO. 43-C1 APPL. 01-110074
 Date: 07/28/11
 Scale: AS NOTED
 Project Number: 07/13
 Drawing Number: ASK-12A

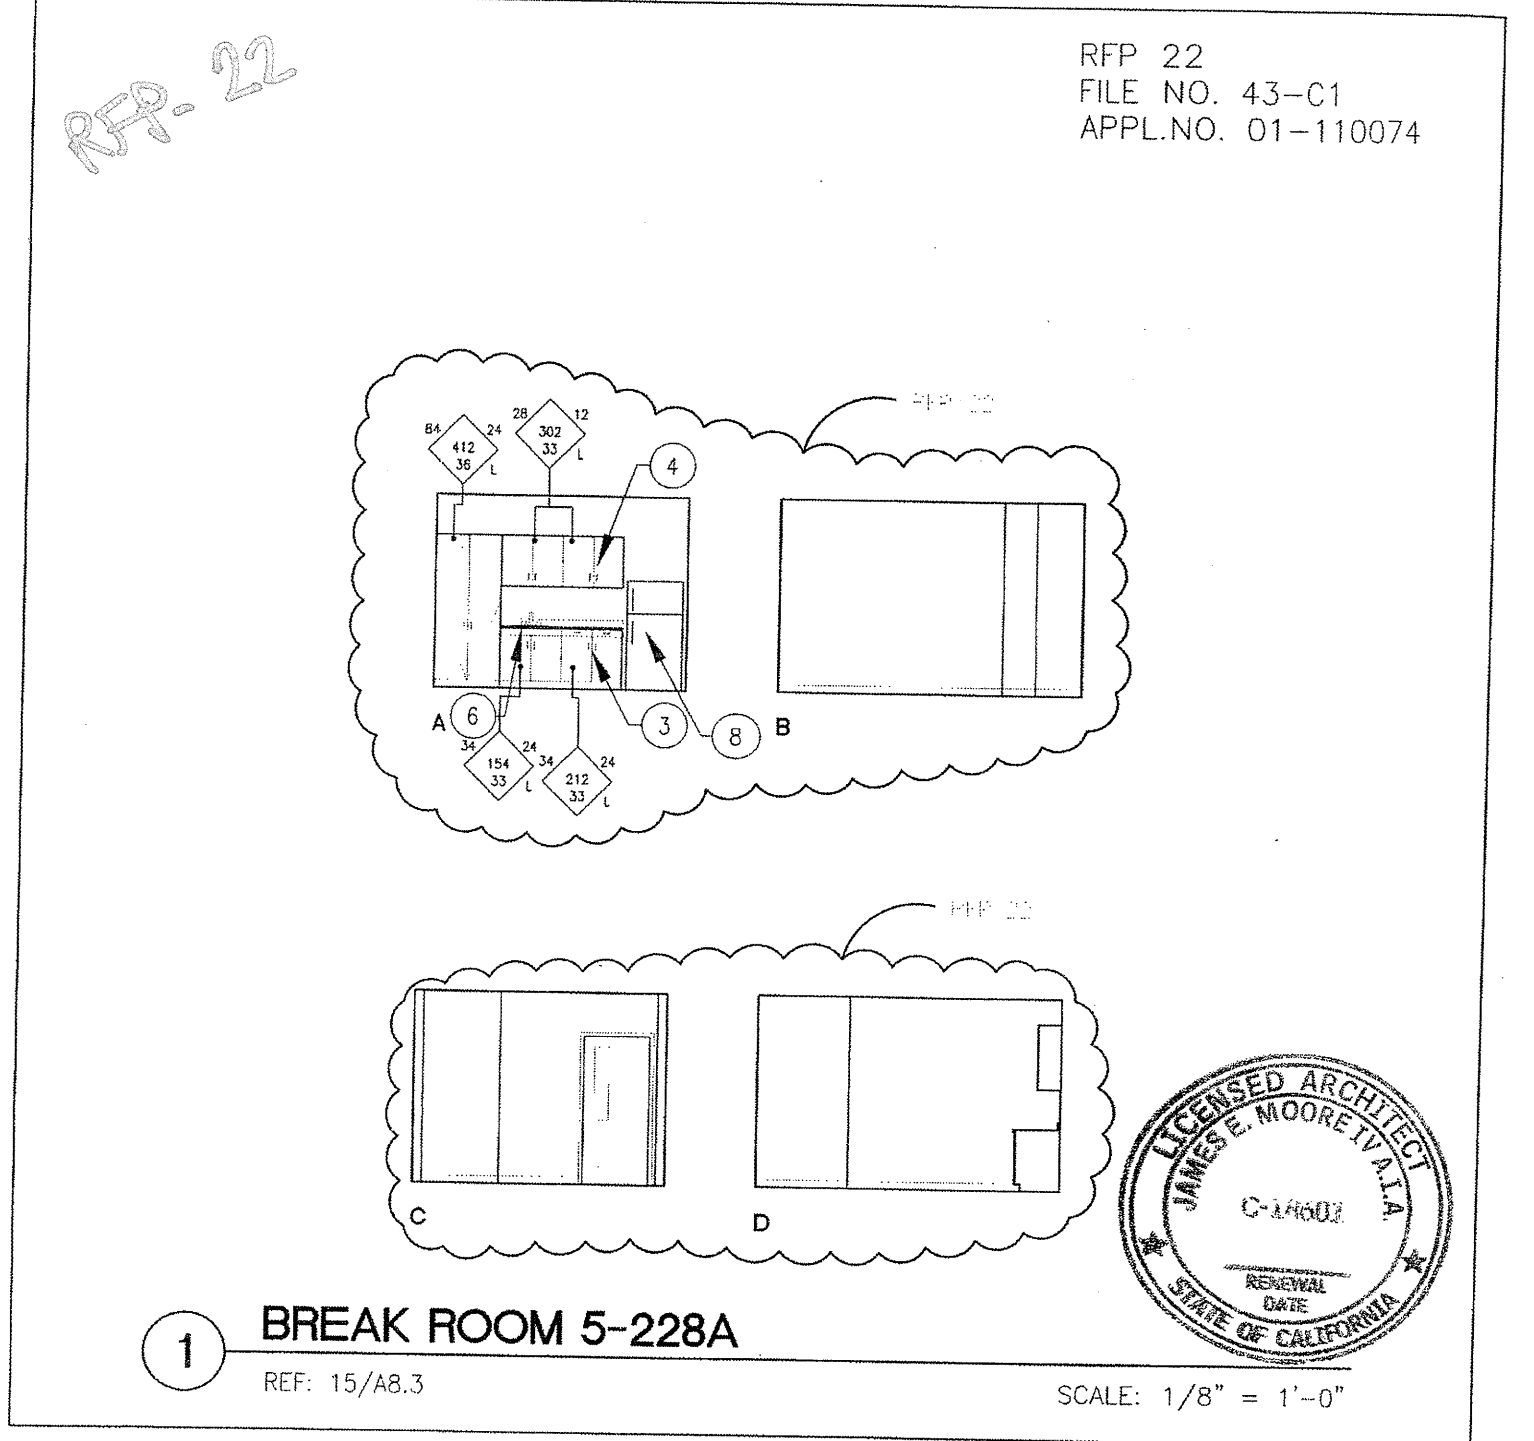

BCA architecture planning interiors
 Project Name: CANADA COLLEGE - BUILDINGS 5 & 6 RENOVATIONS
 SAN MATEO COUNTRY COMMUNITY COLLEGE DISTRICT
 4200 FARM HILL BOULEVARD
 REDWOOD CITY, CA 94061
 FILE NO. 43-C1 APPL. 01-110074
 Date: 07/28/11
 Scale: AS NOTED
 Project Number: 07/13
 Drawing Number: ASK-12B

RFP-116

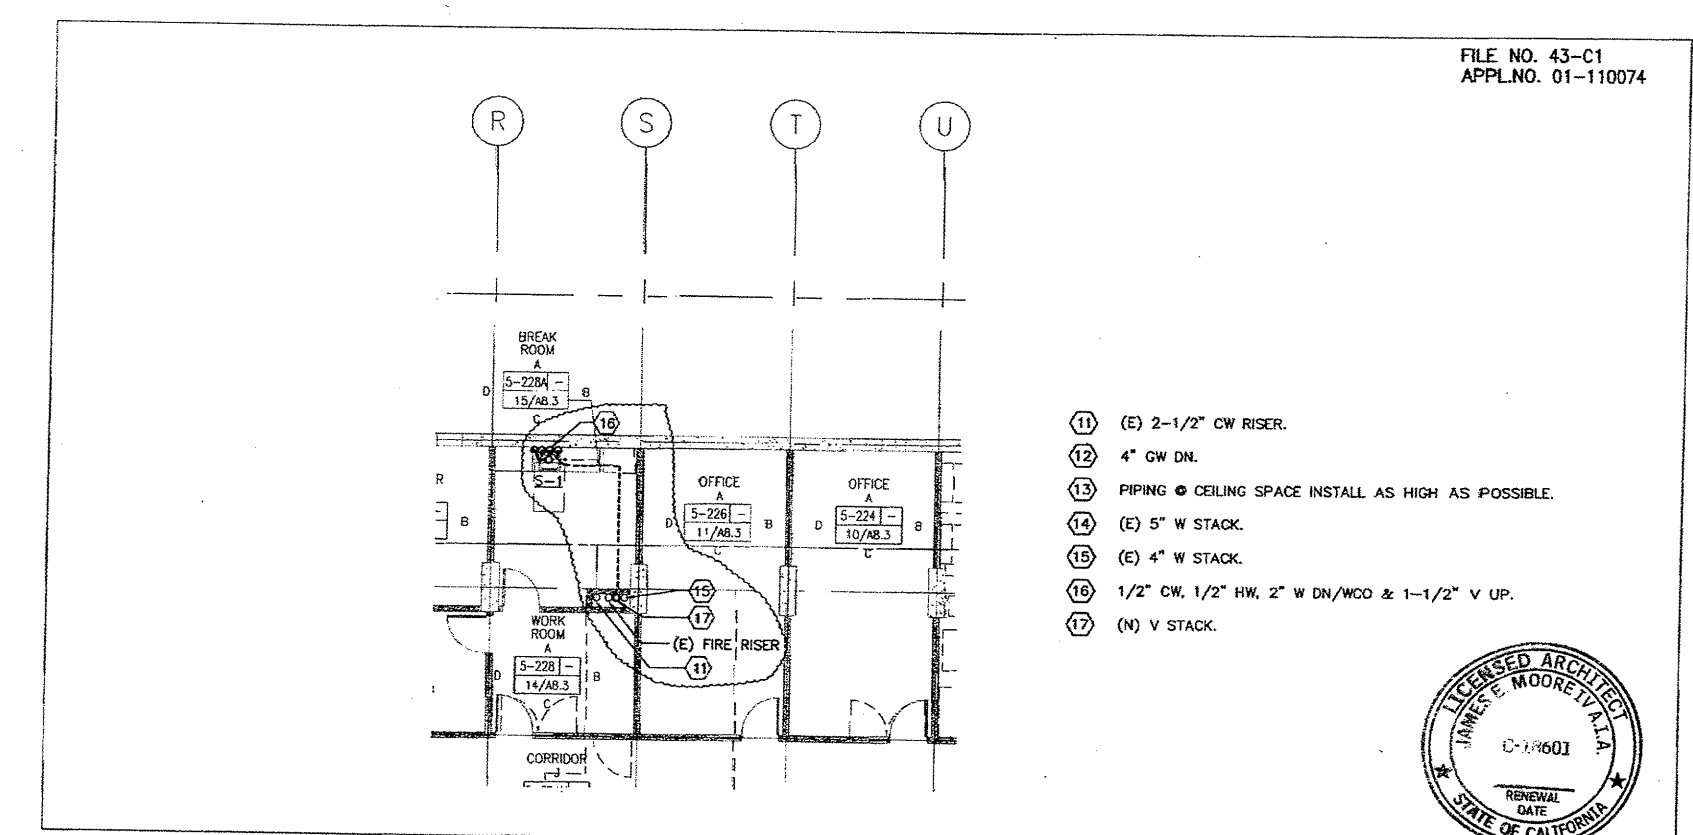

BCA architecture planning interiors
 Project Name: CANADA COLLEGE - BUILDINGS 5 & 6 RENOVATIONS
 SAN MATEO COUNTRY COMMUNITY COLLEGE DISTRICT
 4200 FARM HILL BOULEVARD
 REDWOOD CITY, CA 94061
 FILE NO. 43-C1 APPL. 01-110074
 Date: 08/28/11
 Scale: AS NOTED
 Project Number: 08/13
 Drawing Number: PSK-02