




BCA Title: DOOR MODIFICATION Revision: RFP 57
 Project Name: CANADA COLLEGE - BUILDINGS 5 & 6 RENOVATIONS
 SAN MATEO COUNTRY COMMUNITY COLLEGE DISTRICT
 4200 FARM HILL BOULEVARD
 REDWOOD CITY, CA 94061
 File No. 43-C1 APPL. 01-110074
 Date: 05/20/10
 Scale: AS NOTED
 Project Number: ASK-27D
 Drawing Number: 0703

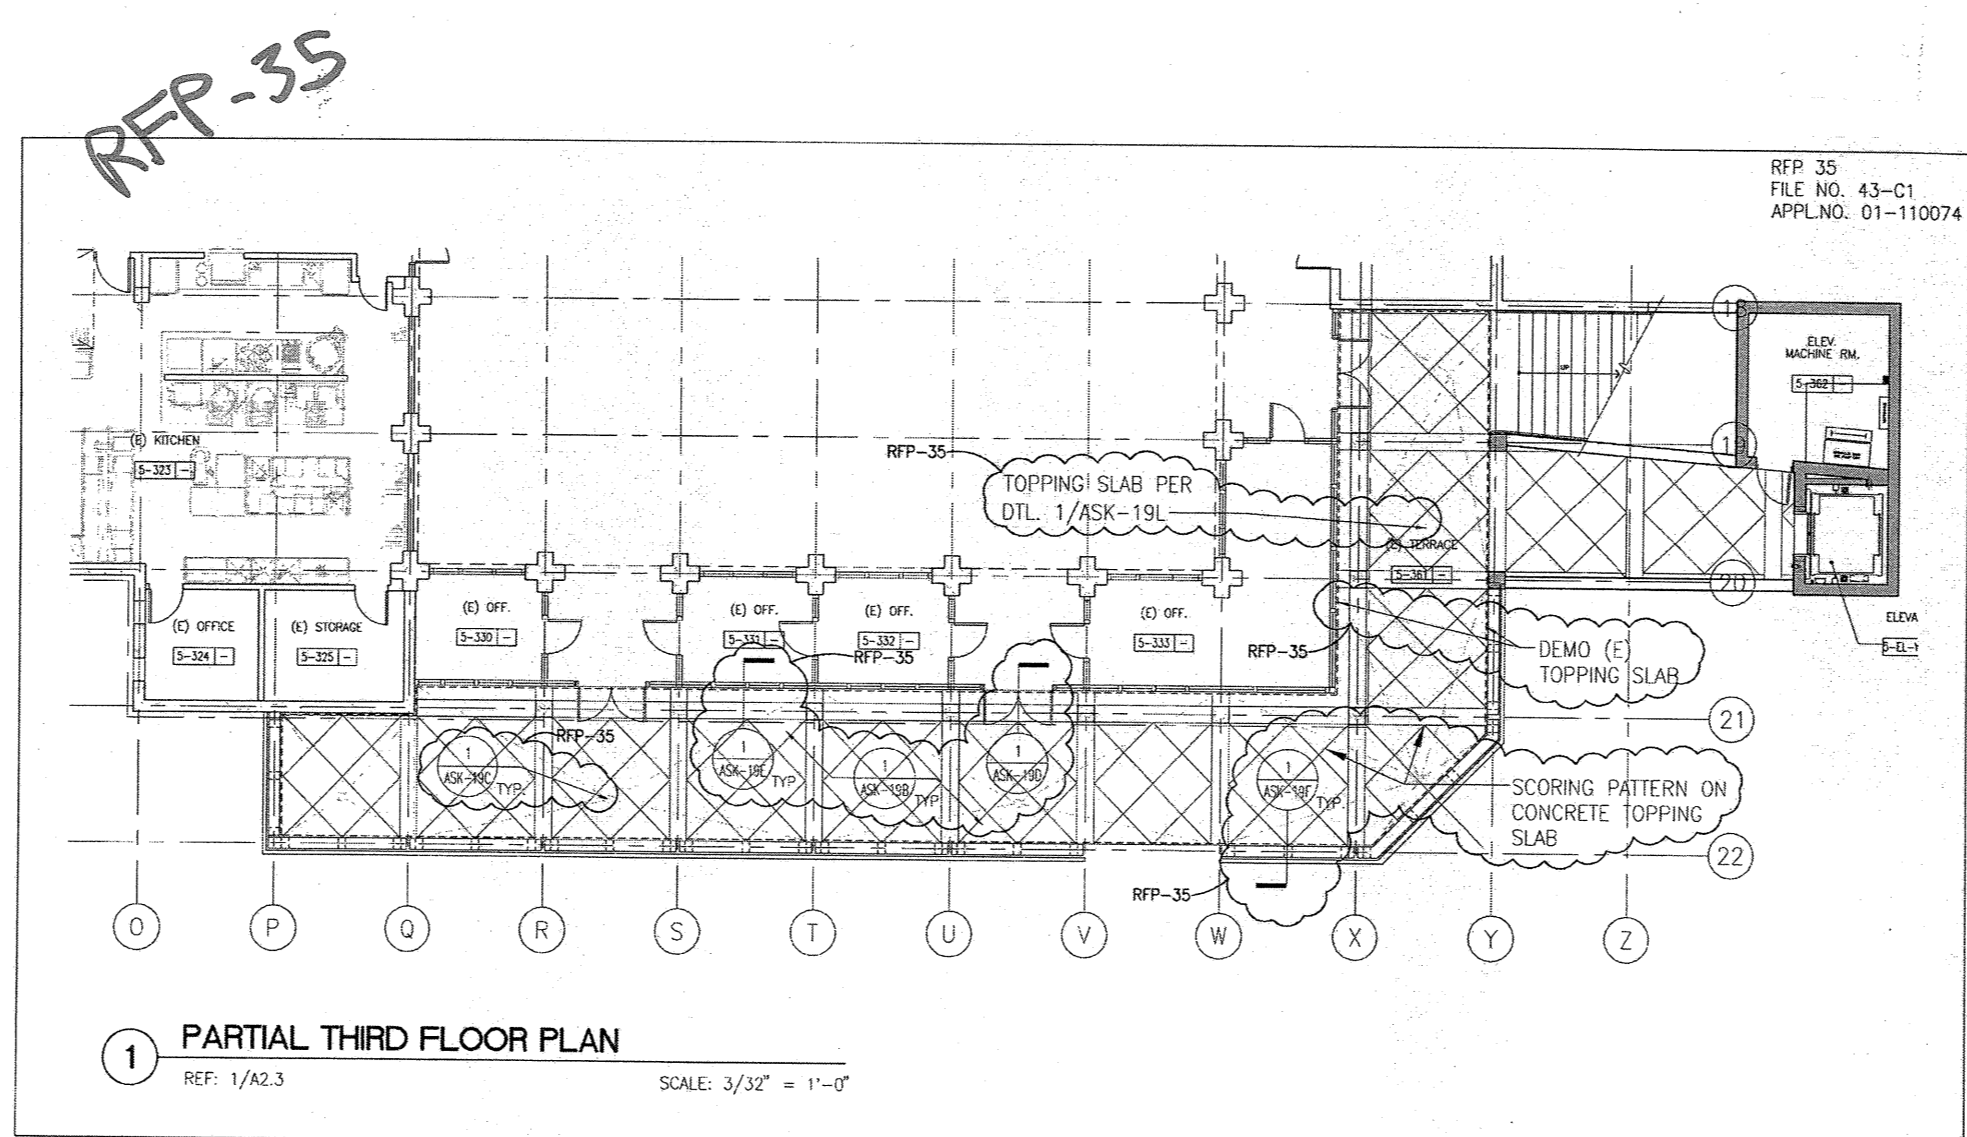


BCA Title: EXTERIOR TERRACE WATERPROOFING Revision: RFP 35
 Project Name: CANADA COLLEGE - BUILDINGS 5 & 6 RENOVATIONS
 SAN MATEO COUNTRY COMMUNITY COLLEGE DISTRICT
 4200 FARM HILL BOULEVARD
 REDWOOD CITY, CA 94061
 File No. 43-C1 APPL. 01-110074
 Date: 05/20/10
 Scale: AS NOTED
 Project Number: ASK-19A
 Drawing Number: 0703

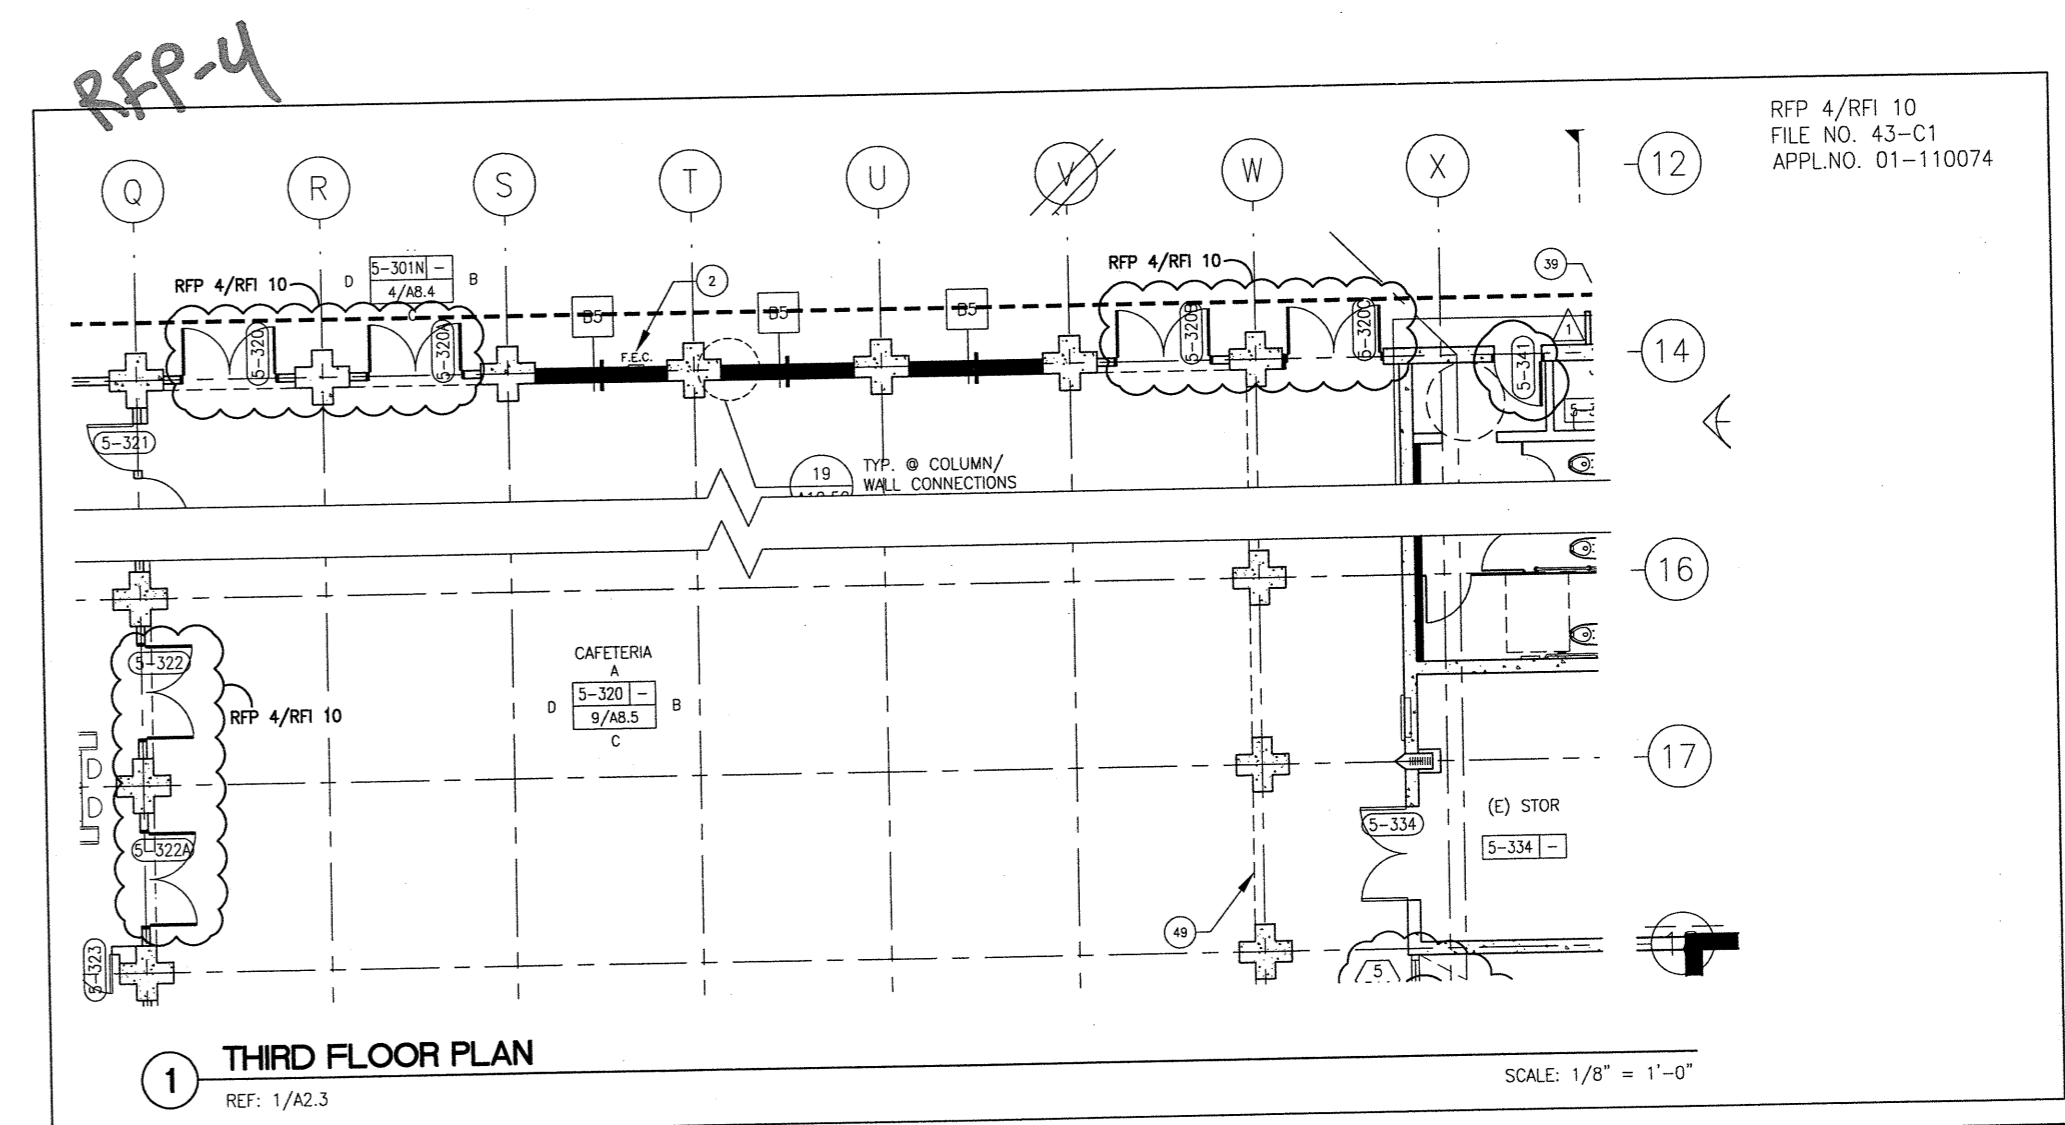


BCA Title: THIRD FLOOR DOORS Revision: RFP 4
 Project Name: CANADA COLLEGE - BUILDINGS 5 & 6 RENOVATIONS
 SAN MATEO COUNTRY COMMUNITY COLLEGE DISTRICT
 4200 FARM HILL BOULEVARD
 REDWOOD CITY, CA 94061
 File No. 43-C1 APPL. 01-110074
 Date: 05/20/10
 Scale: AS NOTED
 Project Number: ASK-18
 Drawing Number: 0703

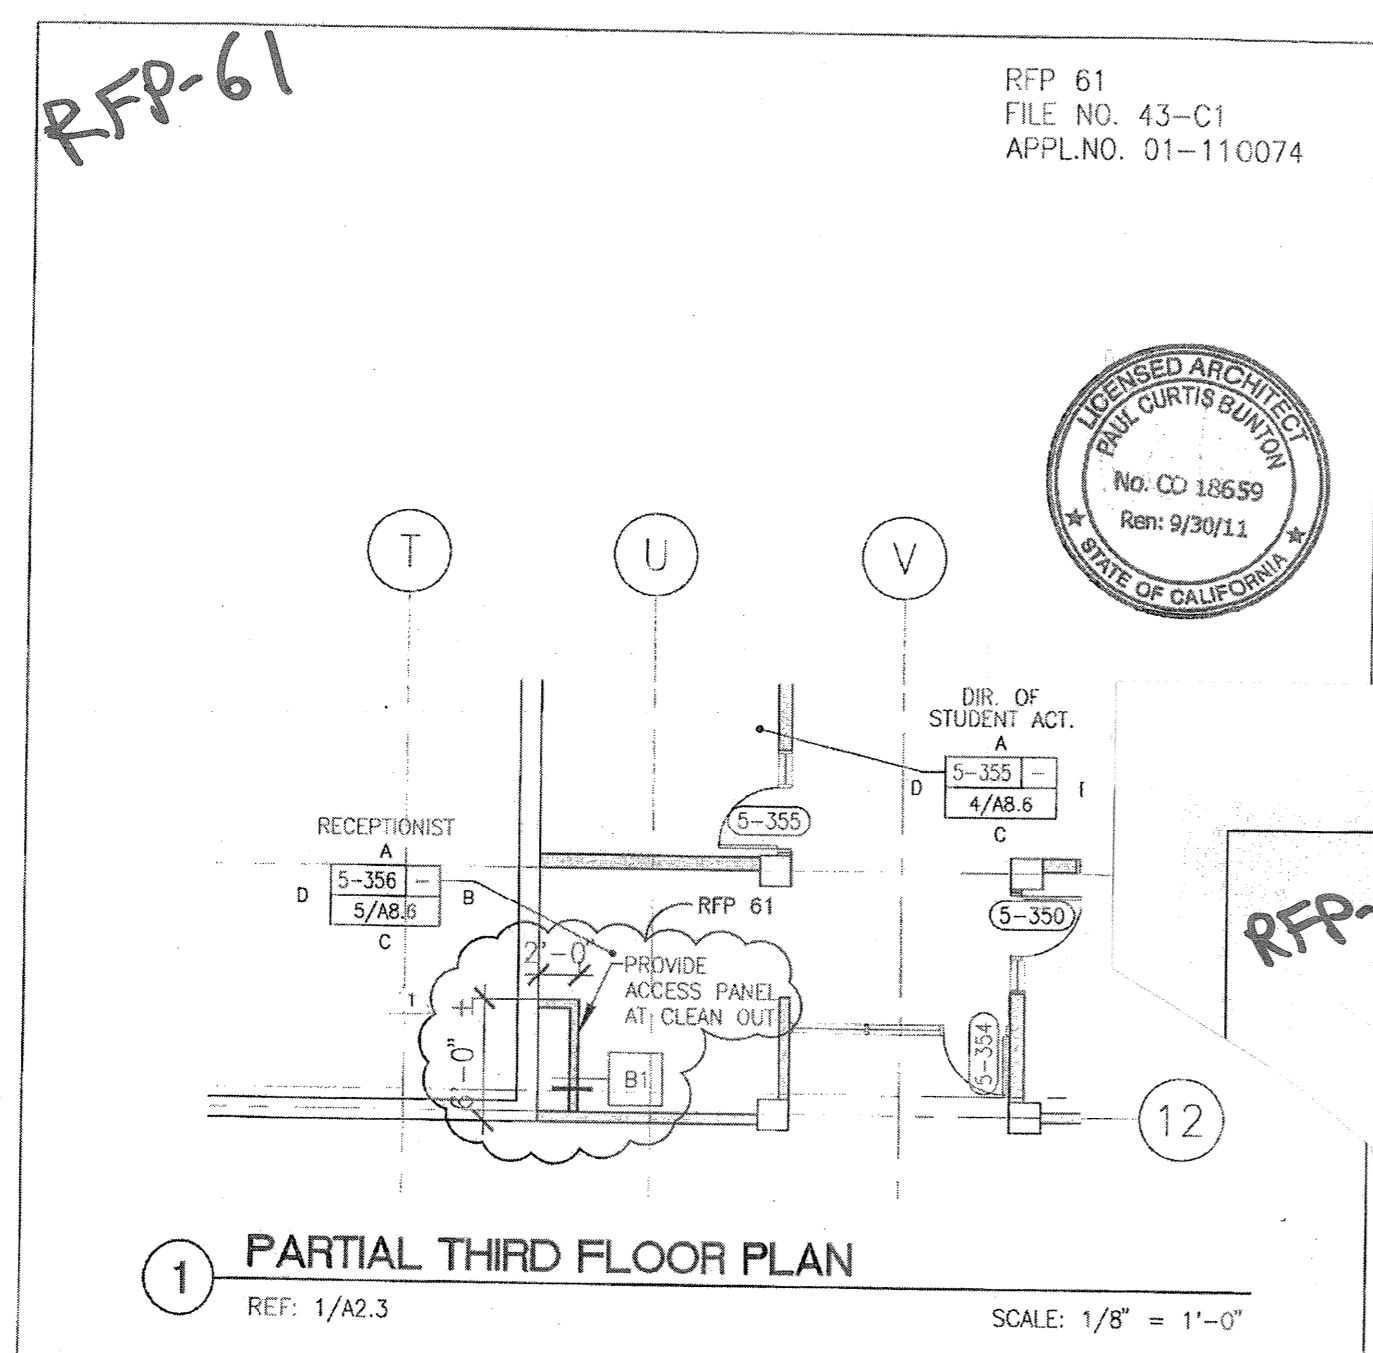


BCA Title: MECHANICAL CHASE Revision: RFP 61
 Project Name: CANADA COLLEGE - BUILDINGS 5 & 6 RENOVATIONS
 SAN MATEO COUNTRY COMMUNITY COLLEGE DISTRICT
 4200 FARM HILL BOULEVARD
 REDWOOD CITY, CA 94061
 File No. 43-C1 APPL. 01-110074
 Date: 05/20/10
 Scale: AS NOTED
 Project Number: ASK-30
 Drawing Number: 0703

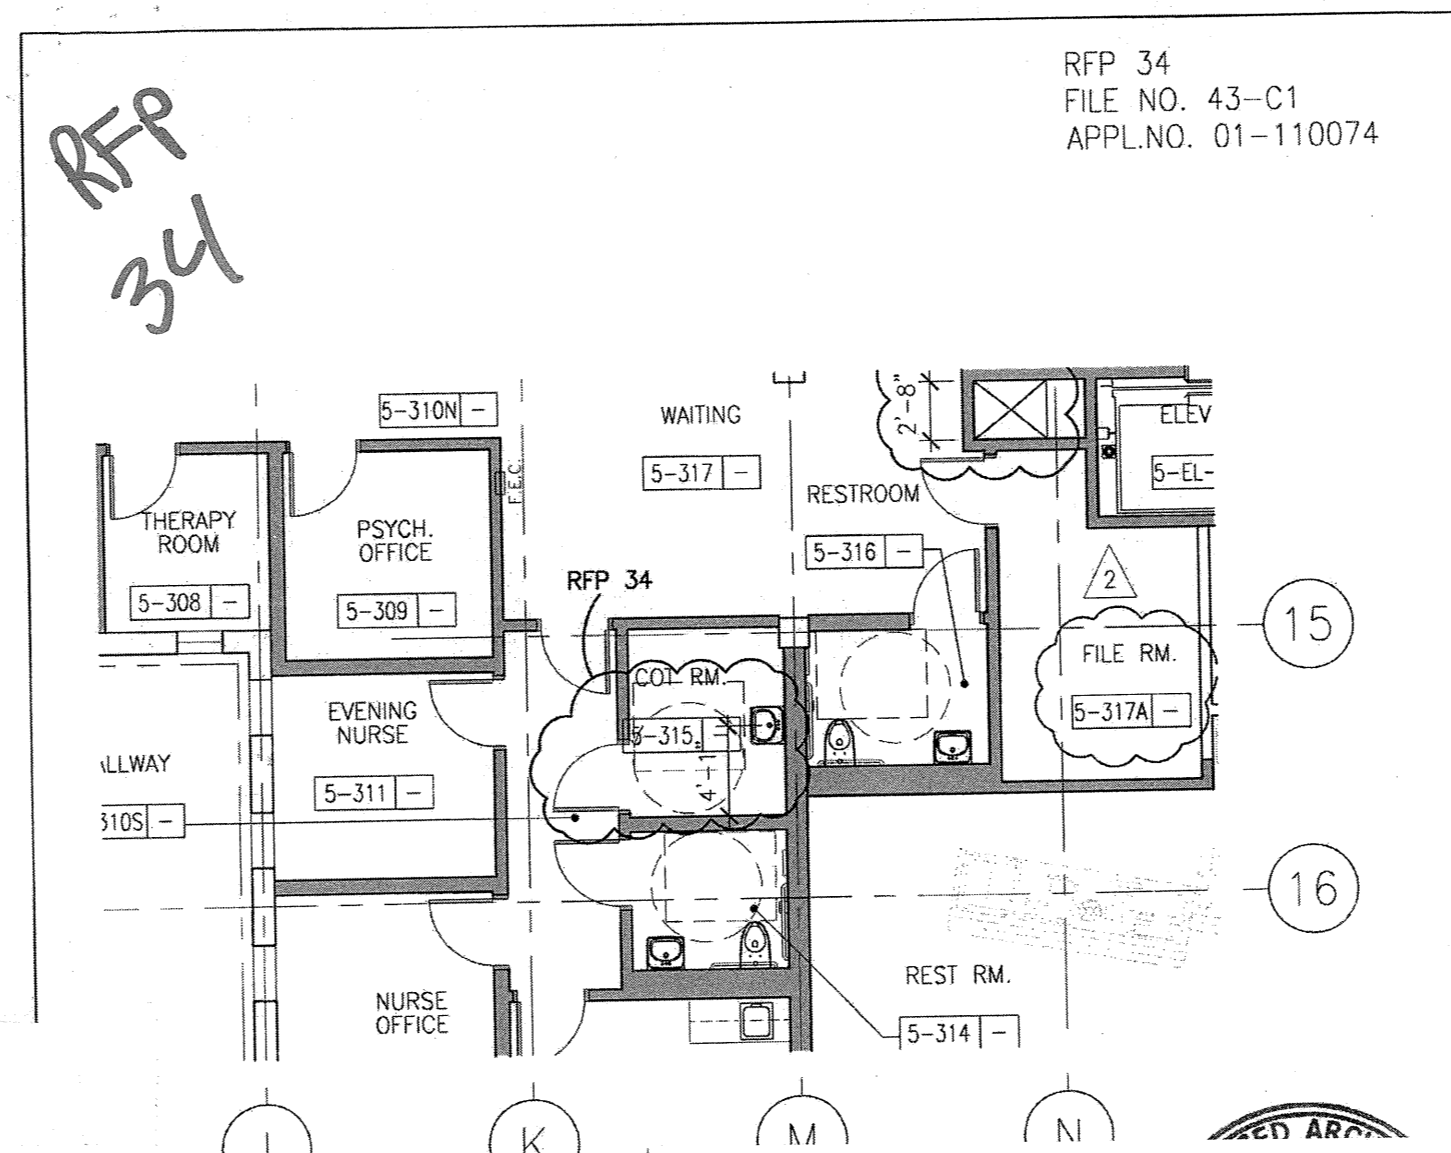


BCA Title: COT ROOM - SINK Revision: RFP 34
 Project Name: CANADA COLLEGE - BUILDINGS 5 & 6 RENOVATIONS
 SAN MATEO COUNTRY COMMUNITY COLLEGE DISTRICT
 4200 FARM HILL BOULEVARD
 REDWOOD CITY, CA 94061
 File No. 43-C1 APPL. 01-110074
 Scale: AS NOTED
 Project Number: ASK-19A
 Drawing Number: 0703

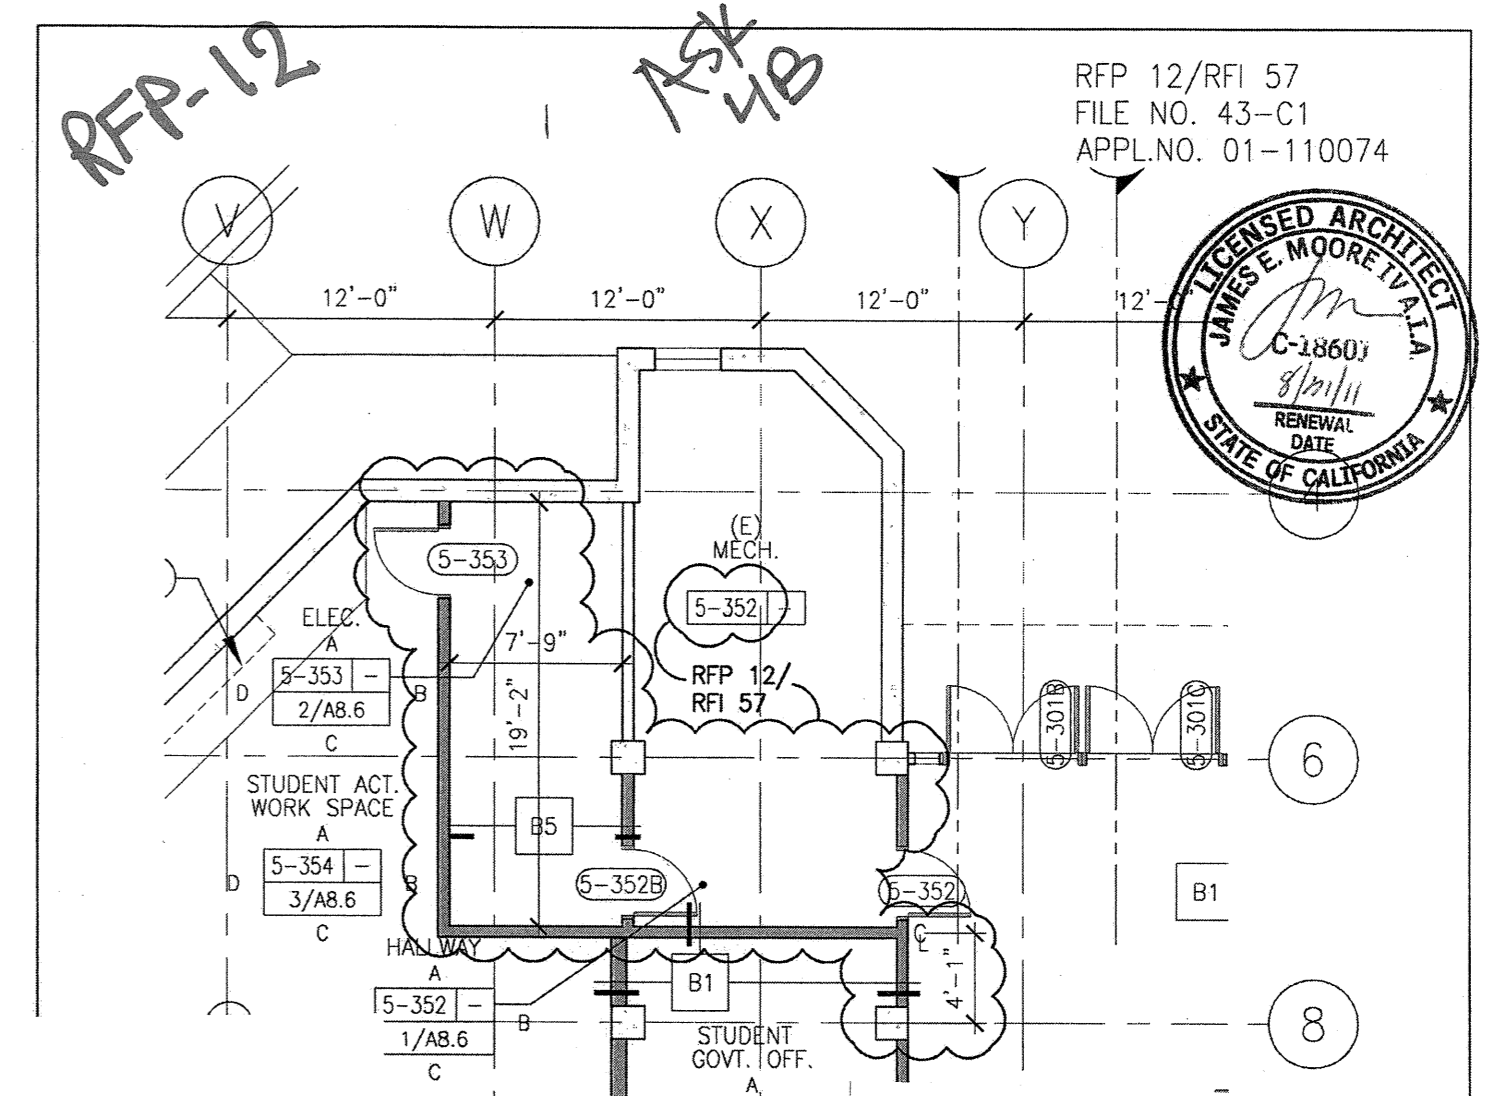


BCA Title: PARTIAL THIRD FLOOR PLAN Revision: RFP 12
 Project Name: CANADA COLLEGE - BUILDINGS 5 & 6 RENOVATIONS
 SAN MATEO COUNTRY COMMUNITY COLLEGE DISTRICT
 4200 FARM HILL BOULEVARD
 REDWOOD CITY, CA 94061
 File No. 43-C1 APPL. 01-110074
 Date: 05/20/10
 Scale: AS NOTED
 Project Number: ASK-18
 Drawing Number: 0703

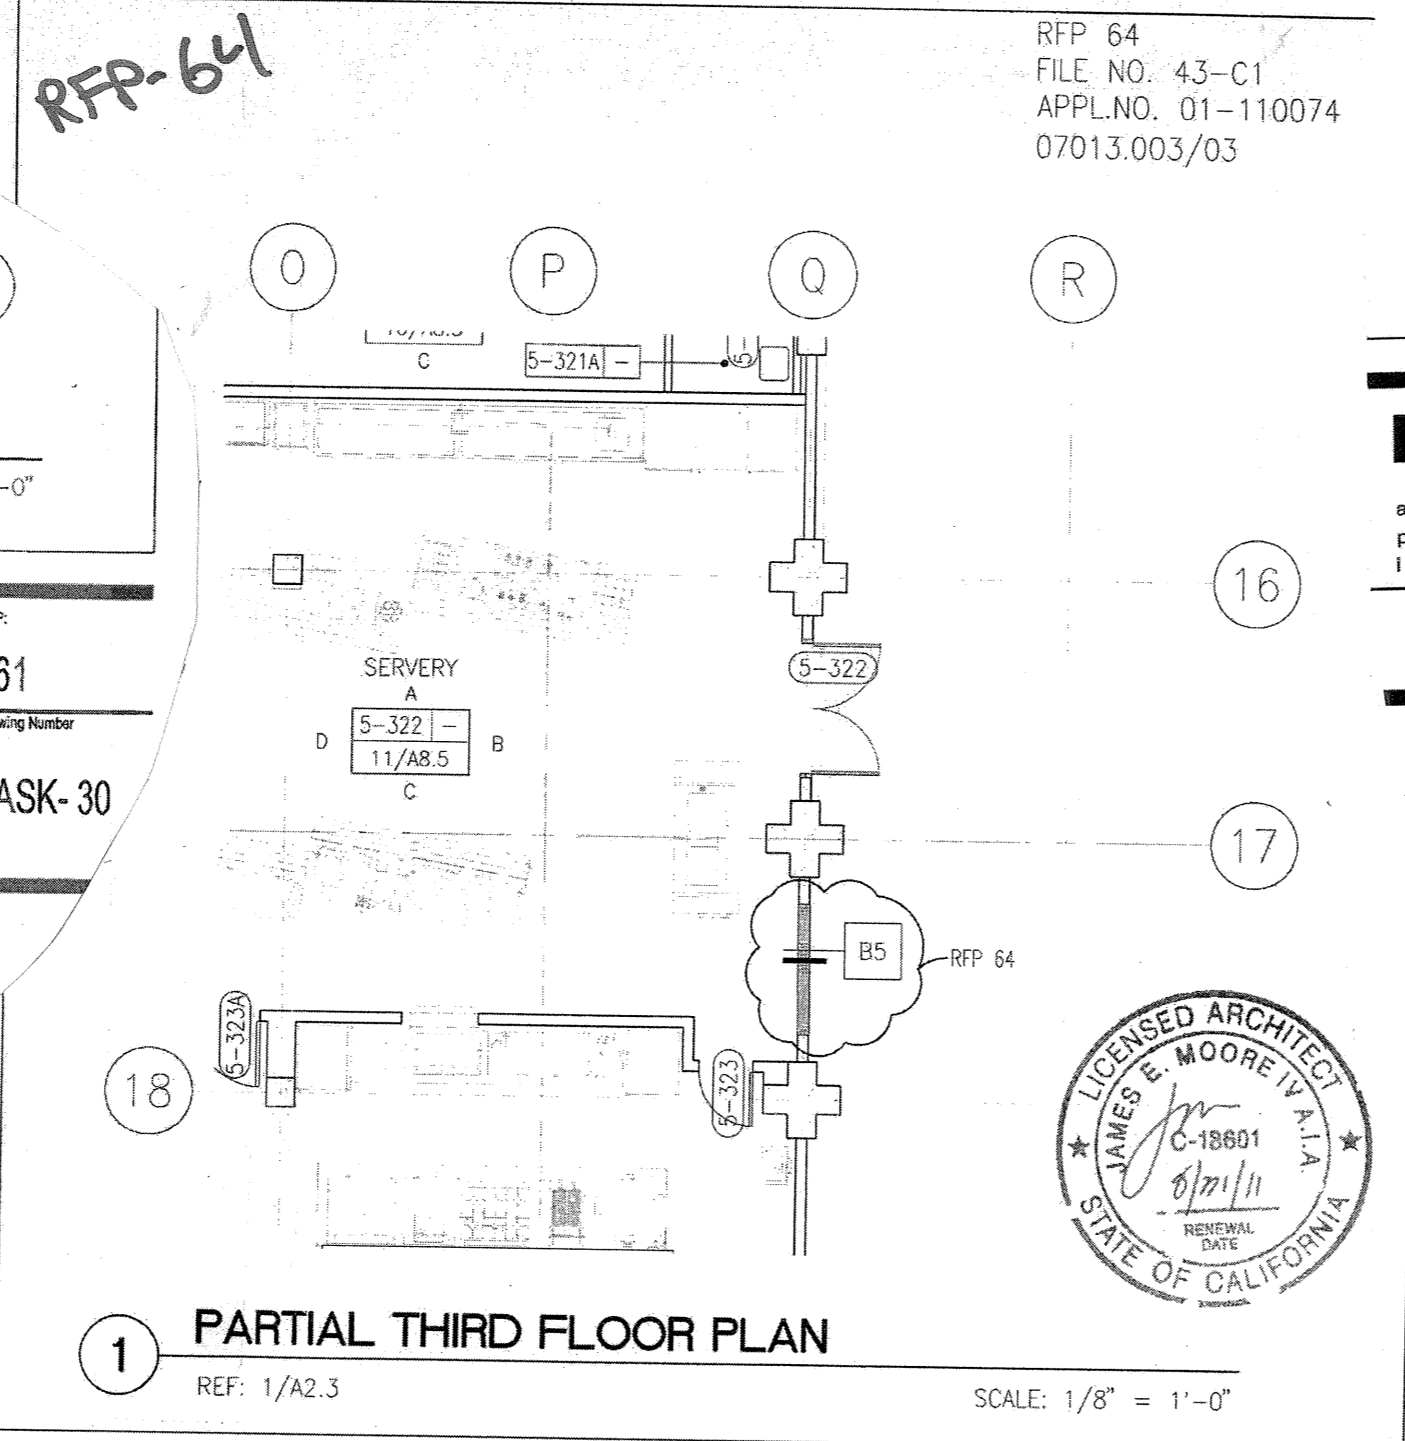

BCA Title: CAFETERIA RE-DESIGN Revision: RFP 64
 Project Name: CANADA COLLEGE - BUILDINGS 5 & 6 RENOVATIONS
 SAN MATEO COUNTRY COMMUNITY COLLEGE DISTRICT
 4200 FARM HILL BOULEVARD
 REDWOOD CITY, CA 94061
 File No. 43-C1 APPL. 01-110074
 Date: 05/20/10
 Scale: AS NOTED
 Project Number: ASK-31B
 Drawing Number: 0703

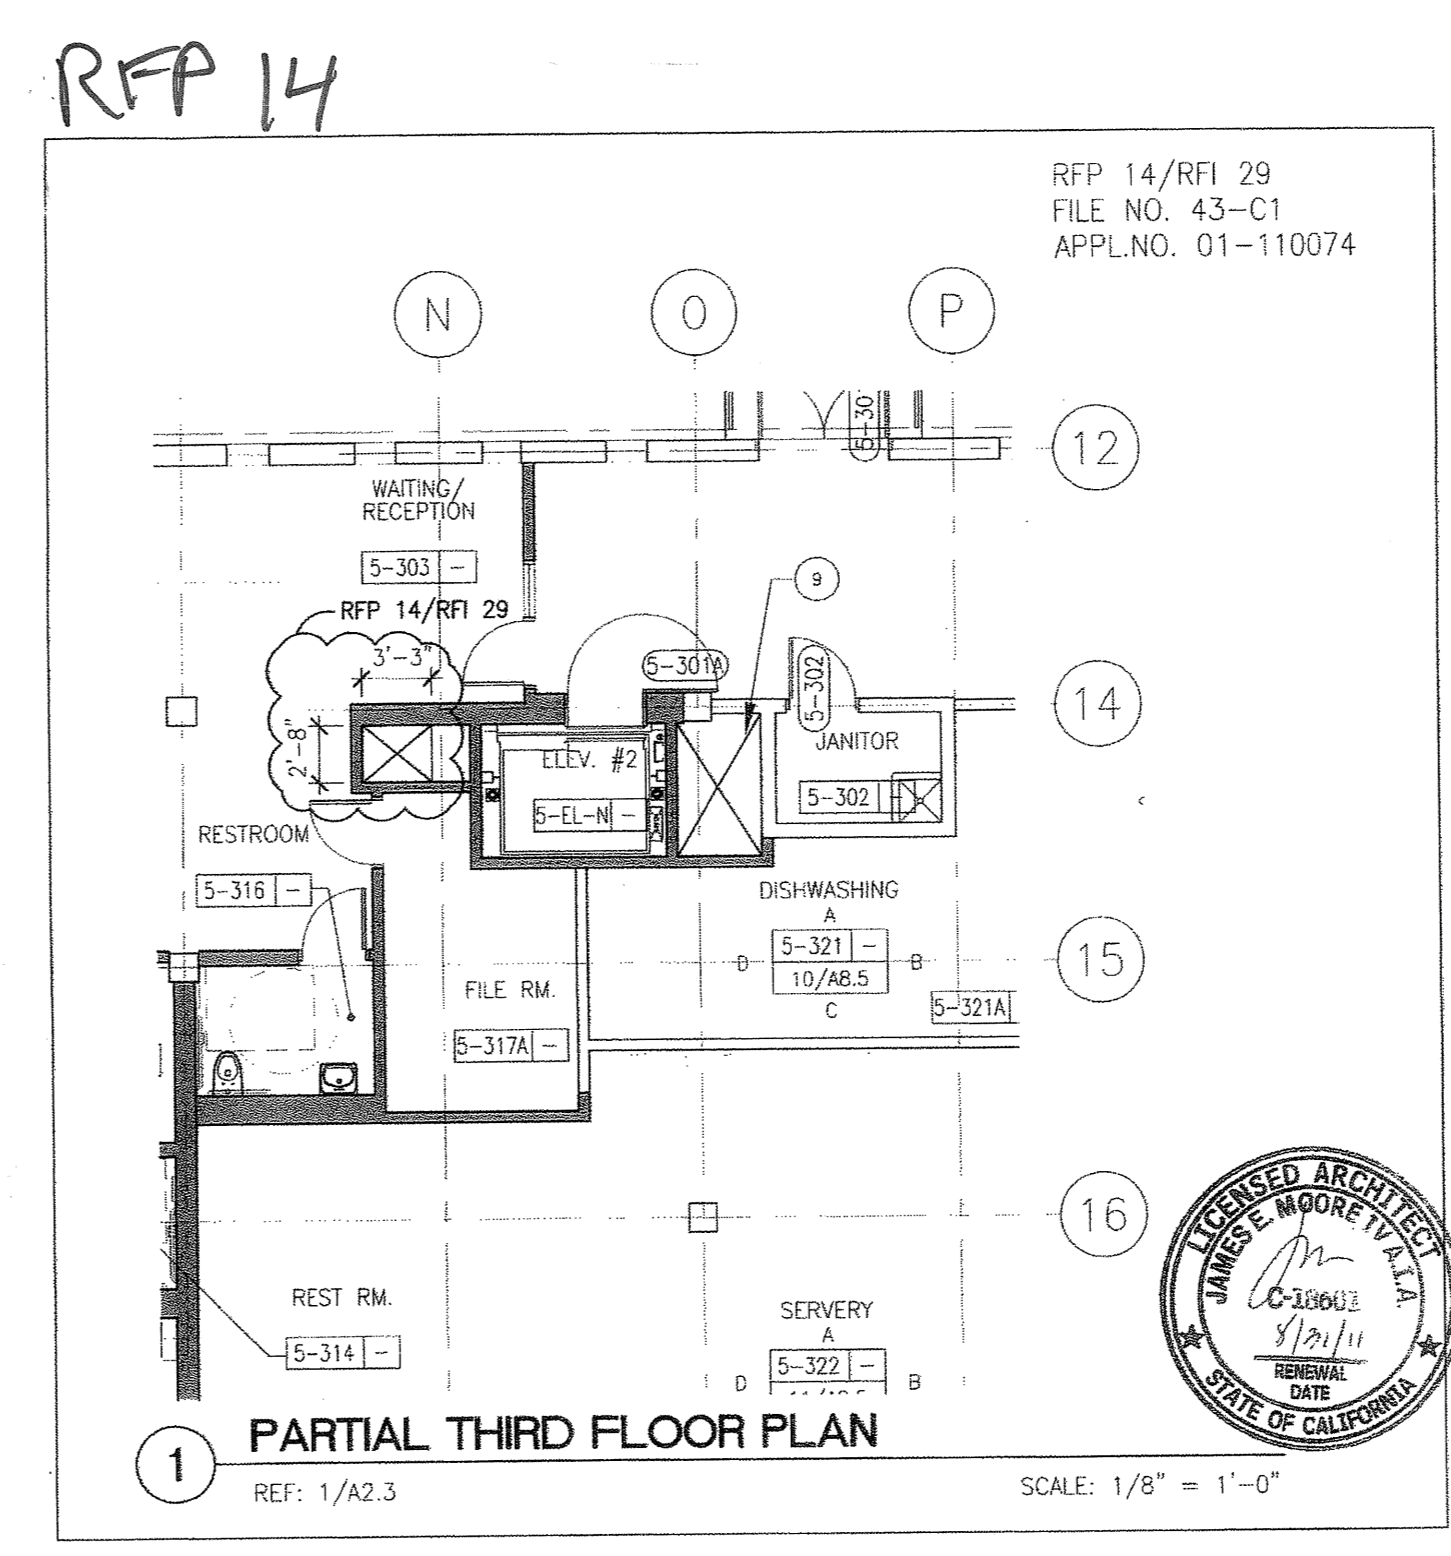

BCA Title: 3RD FLOOR MECHANICAL SHAFT Revision: RFP 14
 Project Name: CANADA COLLEGE - BUILDINGS 5 & 6 RENOVATIONS
 SAN MATEO COUNTRY COMMUNITY COLLEGE DISTRICT
 4200 FARM HILL BOULEVARD
 REDWOOD CITY, CA 94061
 File No. 43-C1 APPL. 01-110074
 Date: 05/20/10
 Scale: AS NOTED
 Project Number: ASK-6
 Drawing Number: 0703

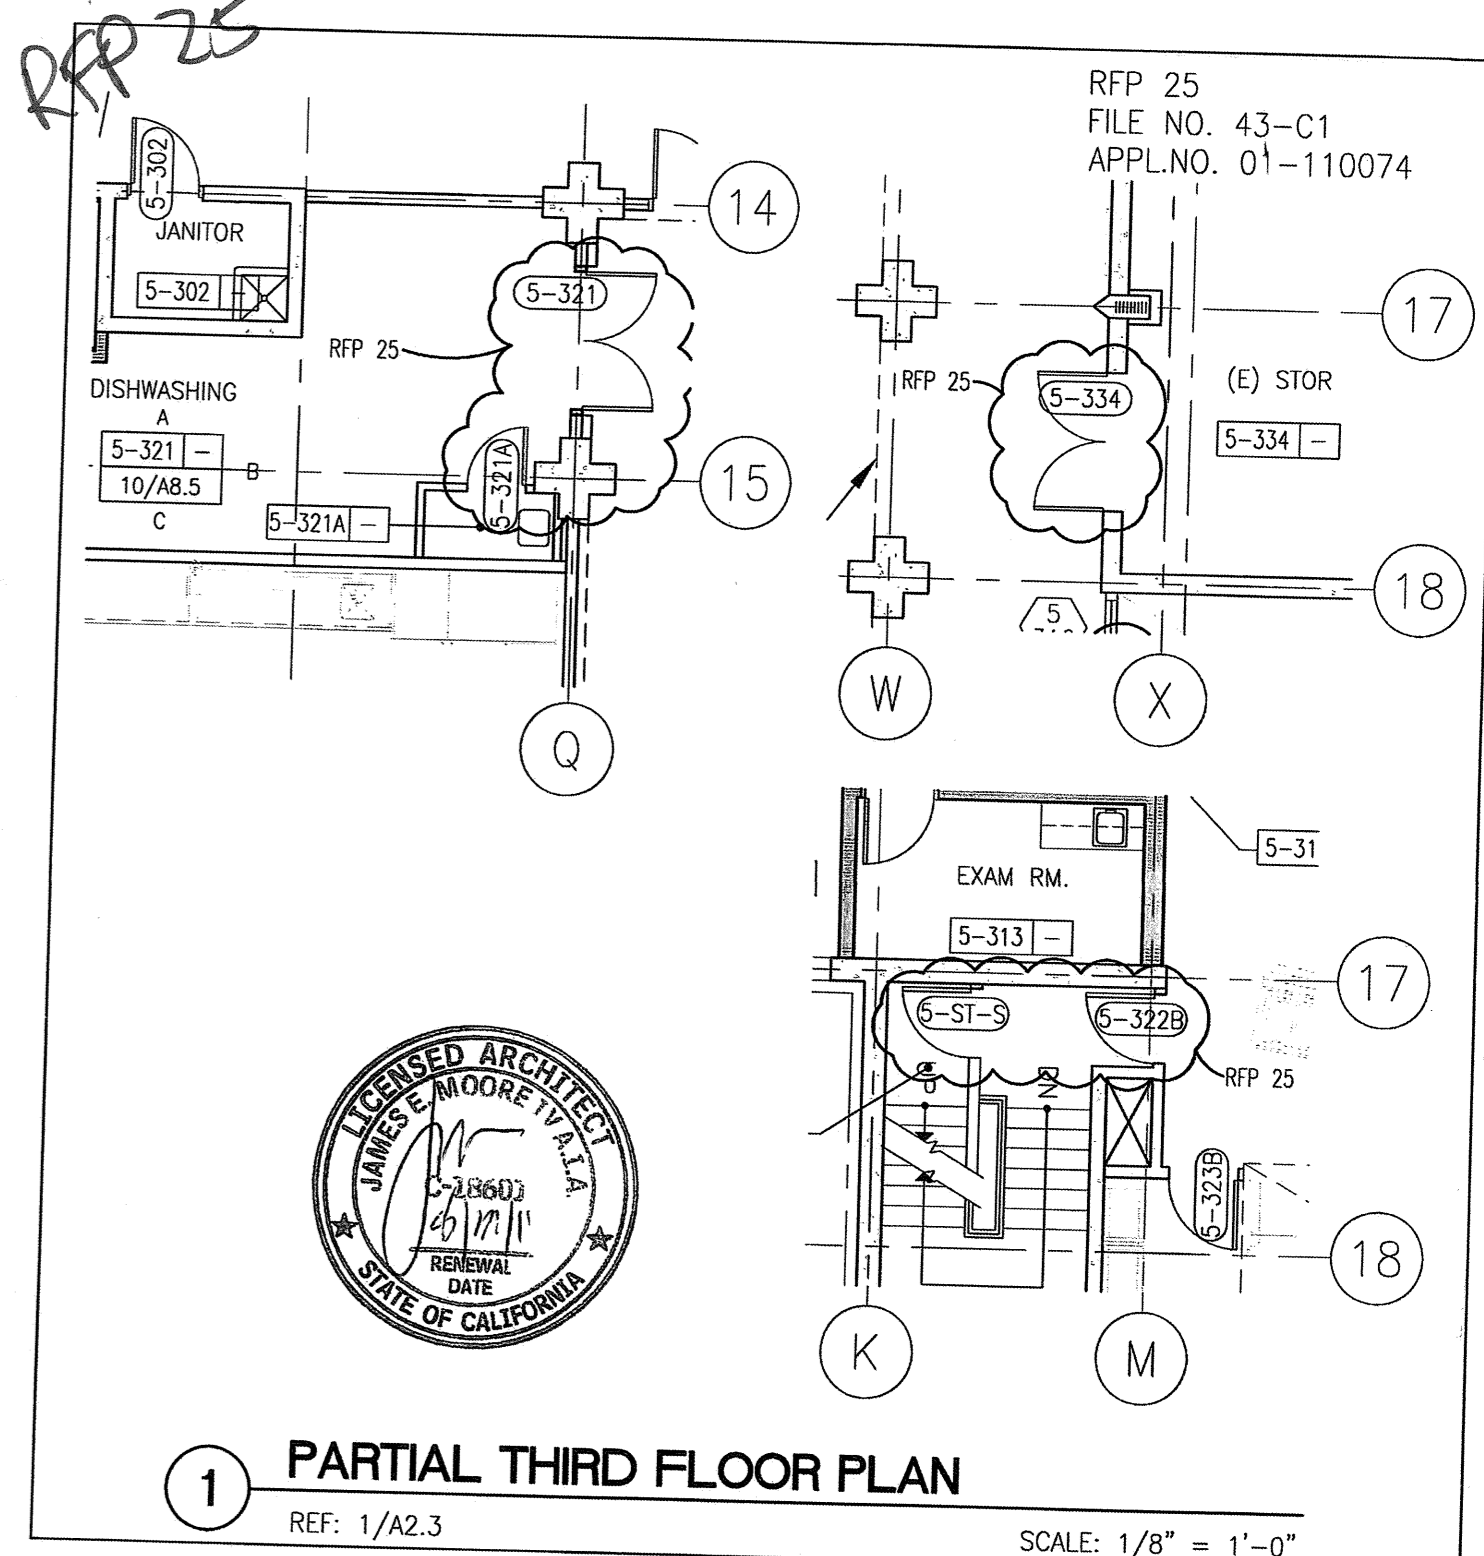

BCA Title: NEW DOORS Revision: RFP 25
 Project Name: CANADA COLLEGE - BUILDINGS 5 & 6 RENOVATIONS
 SAN MATEO COUNTRY COMMUNITY COLLEGE DISTRICT
 4200 FARM HILL BOULEVARD
 REDWOOD CITY, CA 94061
 File No. 43-C1 APPL. 01-110074
 Date: 05/20/10
 Scale: AS NOTED
 Project Number: ASK-14F
 Drawing Number: 0703