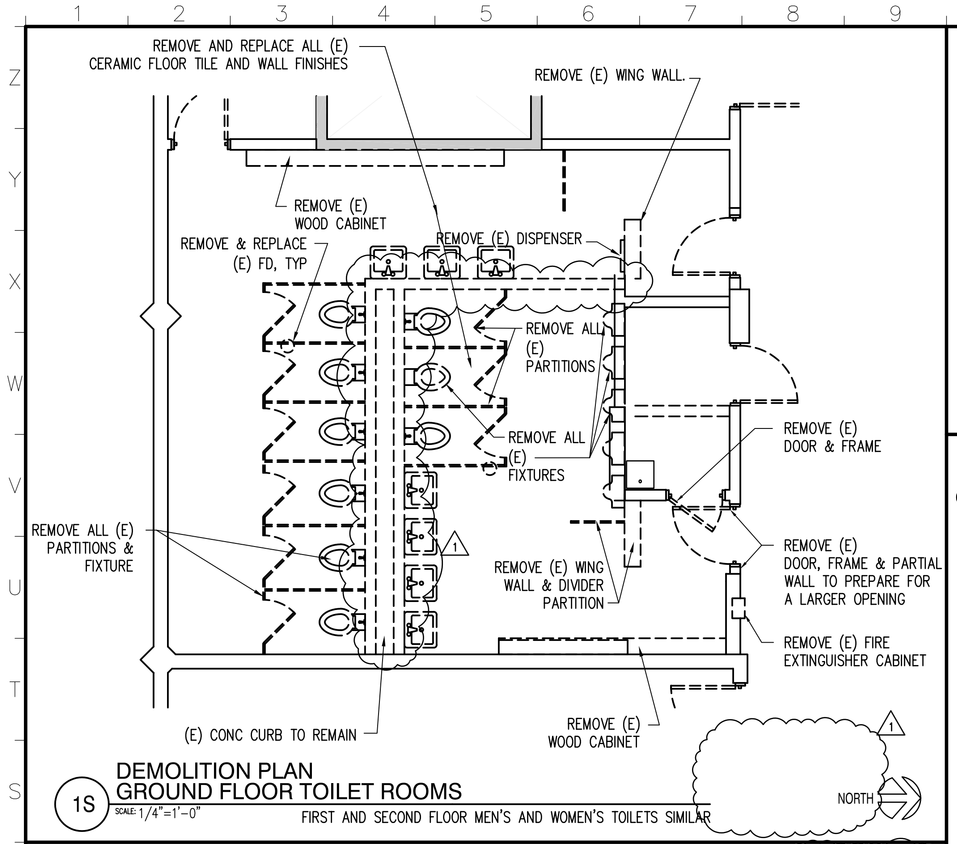

1S DEMOLITION PLAN
GROUND FLOOR TOILET ROOMS
SCALE: 1/4"=1'-0" FIRST AND SECOND FLOOR MEN'S AND WOMEN'S TOILETS SIMILAR

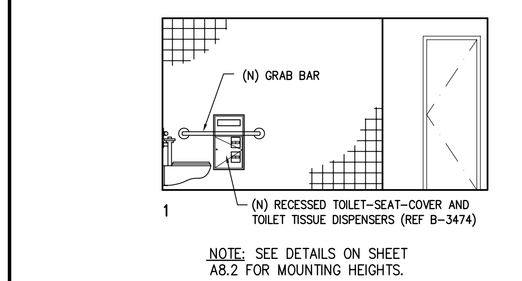

NOTE: SEE DETAILS ON SHEET A8.2 FOR MOUNTING HEIGHTS.

10W MEN'S TOILET RM-77
SCALE: 1/4"=1'-0" FIRST AND SECOND FLOOR SIMILAR

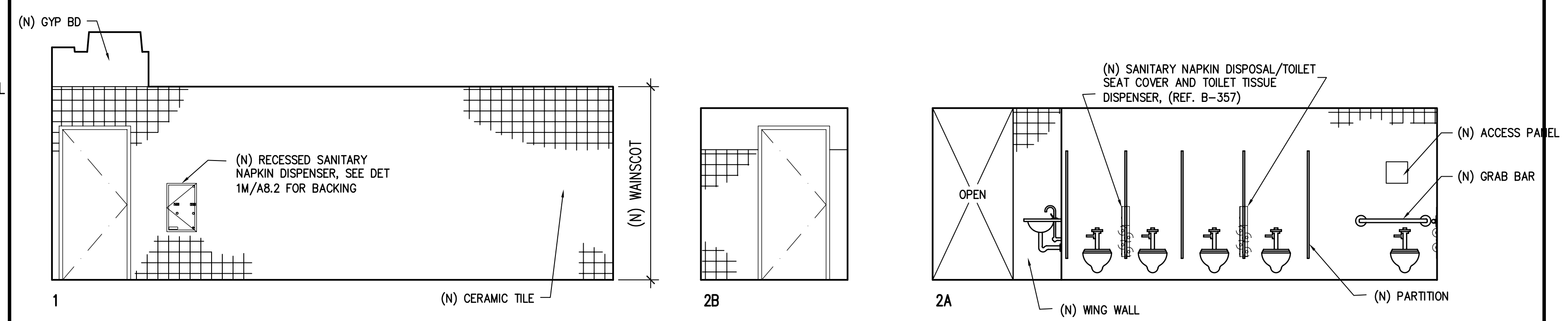

NOTE: SEE DETAILS ON SHEET A8.2 FOR MOUNTING HEIGHTS.

10N WOMEN'S TOILET RM-83
SCALE: 1/4"=1'-0" FIRST AND SECOND FLOOR SIMILAR

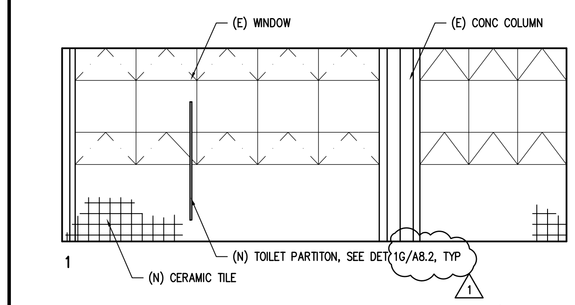

NOTE: FOR BALANCE OF DATA AND OTHER SIM ELEVATIONS, SEE 10N/-

25N WOMEN'S TOILET RM-183
SCALE: 1/4"=1'-0"

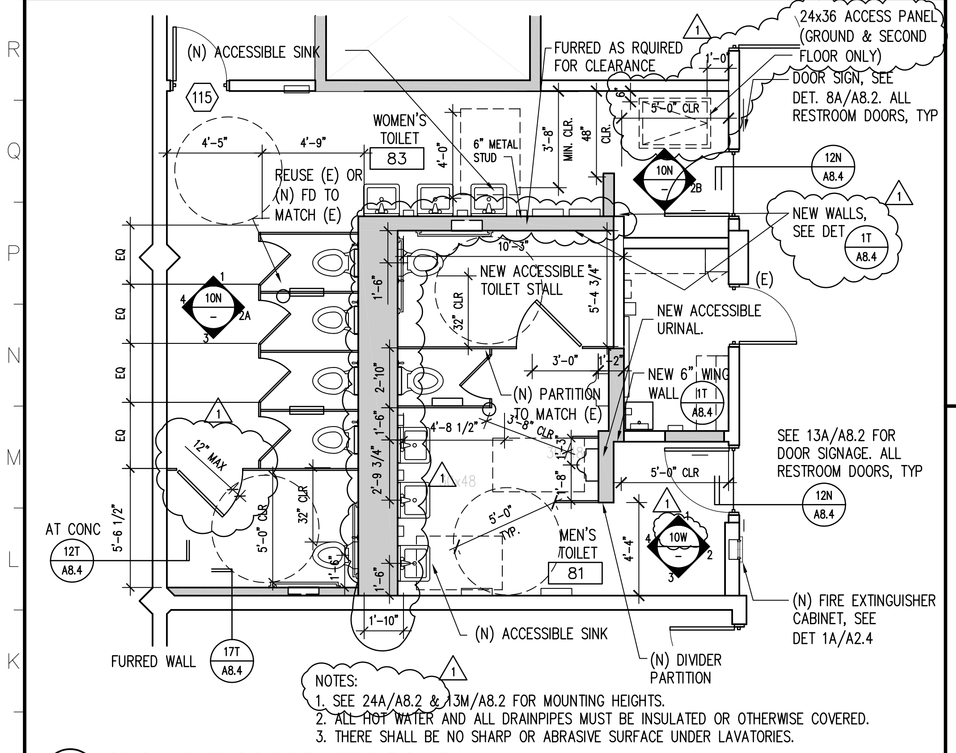

NOTES:
1. SEE 24A/A8.2 & 13M/A8.2 FOR MOUNTING HEIGHTS.
2. ALL HOT WATER AND ALL DRAINPIPES MUST BE INSULATED OR OTHERWISE COVERED.
3. THERE SHALL BE NO SHARP OR ABRASIVE SURFACE UNDER LAVATORIES.

1J GROUND FLOOR TOILET ROOMS
SCALE: 1/4"=1'-0" FIRST AND SECOND FLOOR MEN'S AND WOMEN'S TOILETS SIMILAR

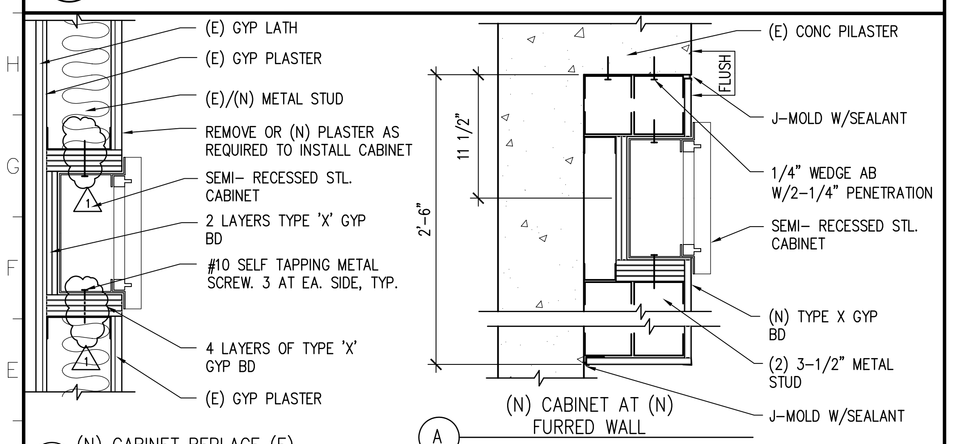

NOTES:
1. PROVIDE 2A 10 BC FIRE EXINGUSHER W./ VALID CERTIFICATION TAG.
2. SEE GA FILE NO WP 1311 AND 1330

1A FIRE EXTINGUISHER CABINET
SCALE: 1-1/2"=1'-0"

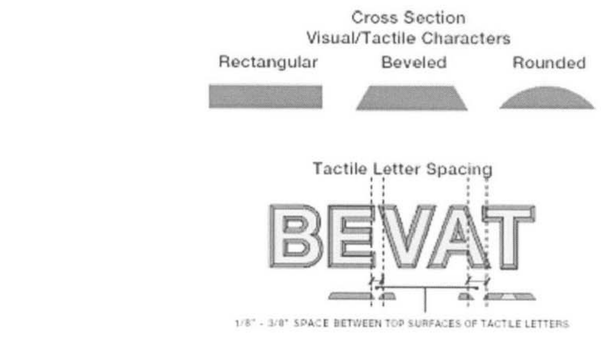

Fig 17-A. Character Spacing

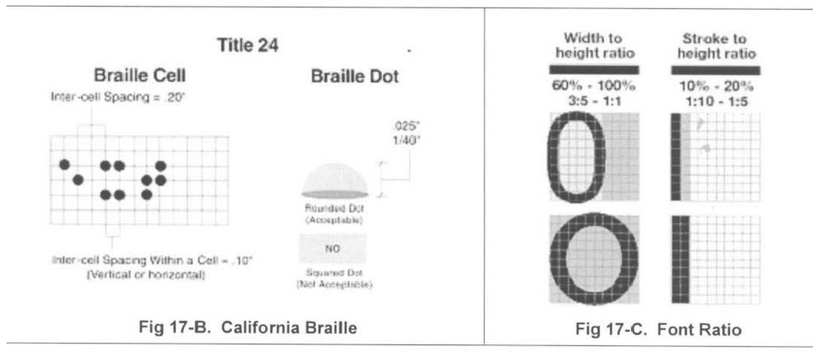

Fig 17-B. California Braille

Fig 17-C. Font Ratio

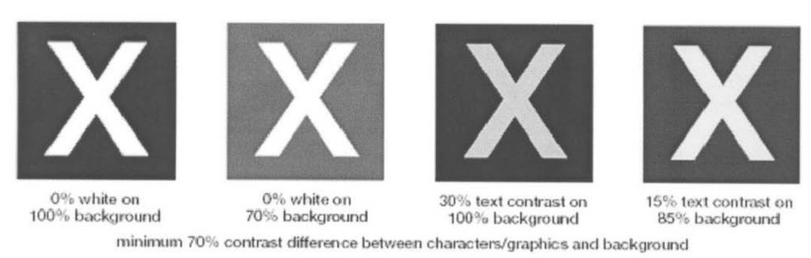

Fig 17-D. Contrast

10A SIGNAGE
SCALE: NTS

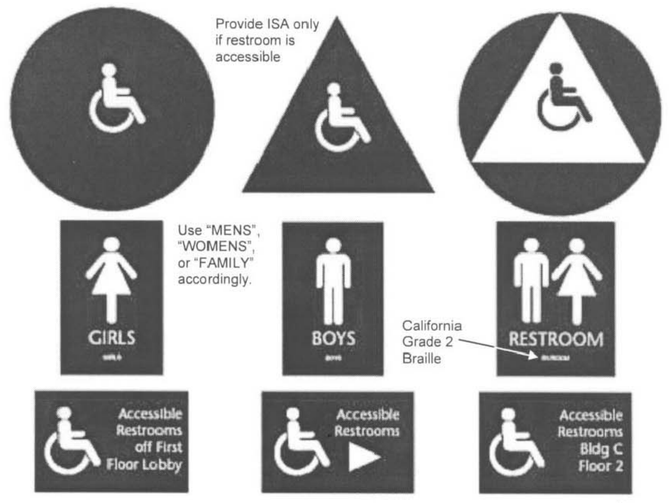

Fig 17-E. Recommended Restroom Signage

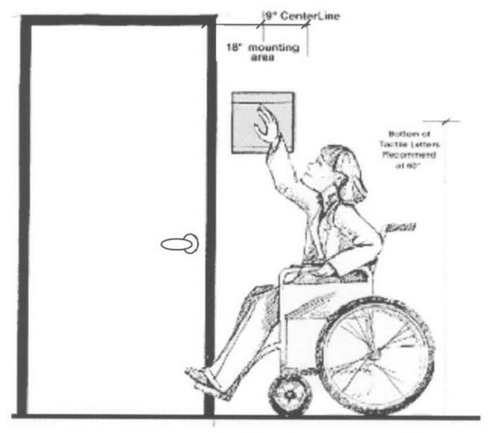

Fig 17-F. Mounting Height

REVISION	DESCRIPTION	INITIAL	DATE
1	ADDENDUM	TKB	4/1/04
	PRE-APPLICATION REVIEW		02/06/04
	ISSUED FOR PLAN CHECK		03/03/04
	ISSUED FOR PERMIT		03/03/04
	ISSUED FOR BID		
	ISSUED FOR CONSTRUCTION		

SEAL:

LICENSED ARCHITECT
THOMAS K. BUTT
No. C 7,389
REN. 3-31-07
STATE OF CALIFORNIA

CONSULTANT:

INTERACTIVE
RESOURCES
ARCHITECTURE • PLANNING • ENGINEERING
117 PARK PLACE
POINT RICHMOND
CALIFORNIA 94801
(510) 236-7435
(FAX) 232-5325
http://www.intres.com

PROJECT:

BUILDING NO. 18 (NORTH HALL) MODERNIZATION

COLLEGE OF SAN MATEO
1700 WEST HILLSDALE BLVD.
SAN MATEO, CA 94402

SAN MATEO CO. COMMUNITY COLLEGE DISTRICT

IDENTIFICATION STAMP
DIV. OF THE STATE ARCHITECT
OFFICE OF REGULATION SERVICES
APPL 106047
AC ____ FLS ____ SS ____
DATE ____

APPROVED
DIV. OF THE STATE ARCHITECT
APPL 106047
AC ____ FLS ____ SS ____
DATE ____

SHEET TITLE:

ENLARGED PLANS, ELEVATIONS AND DETAILS

PROJ. NO.	2002-066.02
PREPARATION AND REVIEW	
DRAWN BY	BA
DESIGNER	TKB
PROJ. MGR.	TKB
PEER REVIEW	

SHEET NUMBER:

MOD
A2.4

NUMBER: OF: