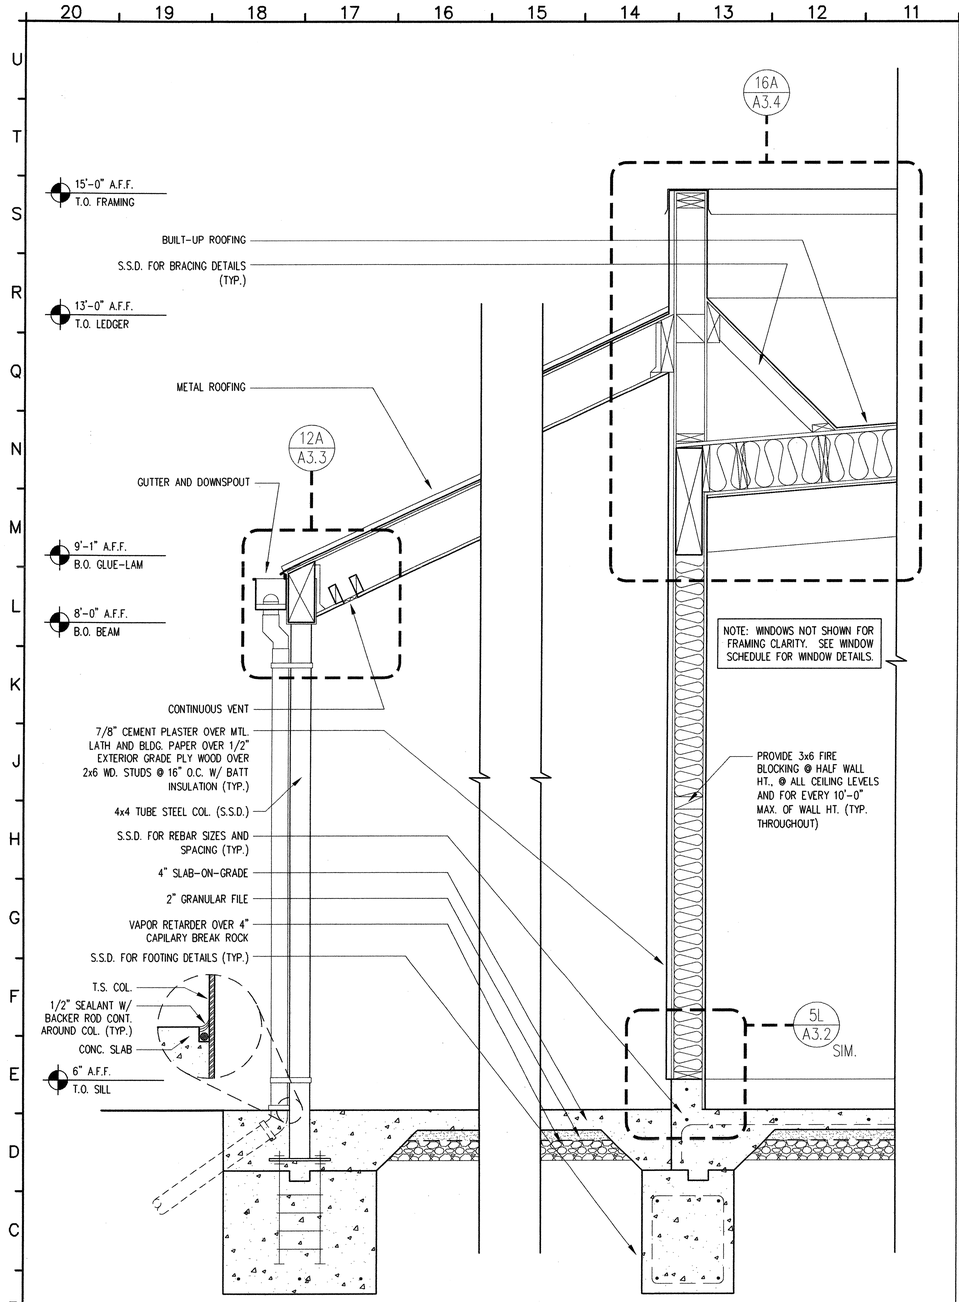

20A WALL SECTION
1/2"=1'-0"

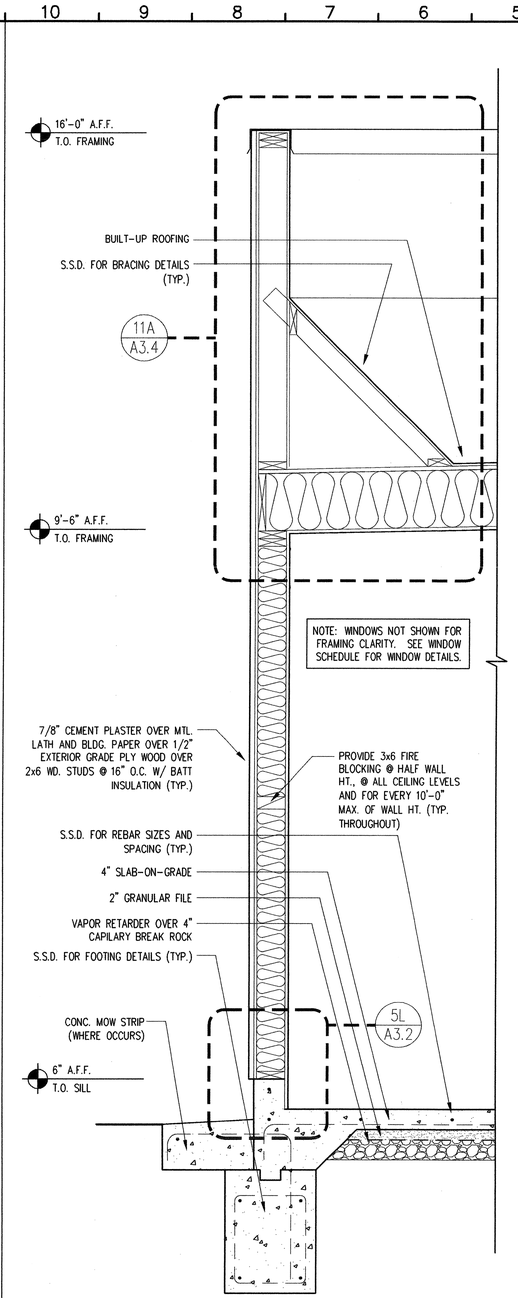

10A WALL SECTION
1/2"=1'-0"

AS-BUILTS

REVISIONS: (△ INDICATES REVISIONS MADE TO THIS SHEET)

NO.:	DATE	REASON	BY