


<b>BCA</b> architecture planning interiors  200 S. Bascom St. San Jose, California 95128 (415) 924-8800 www.bcaarchitect.com	Title:	Revision:	RFI No.:
	Project Name:	Date:	Drawing Number:
	Client:	Scale:	AS NOTED
	Project Location:	Project Number:	ASK-22

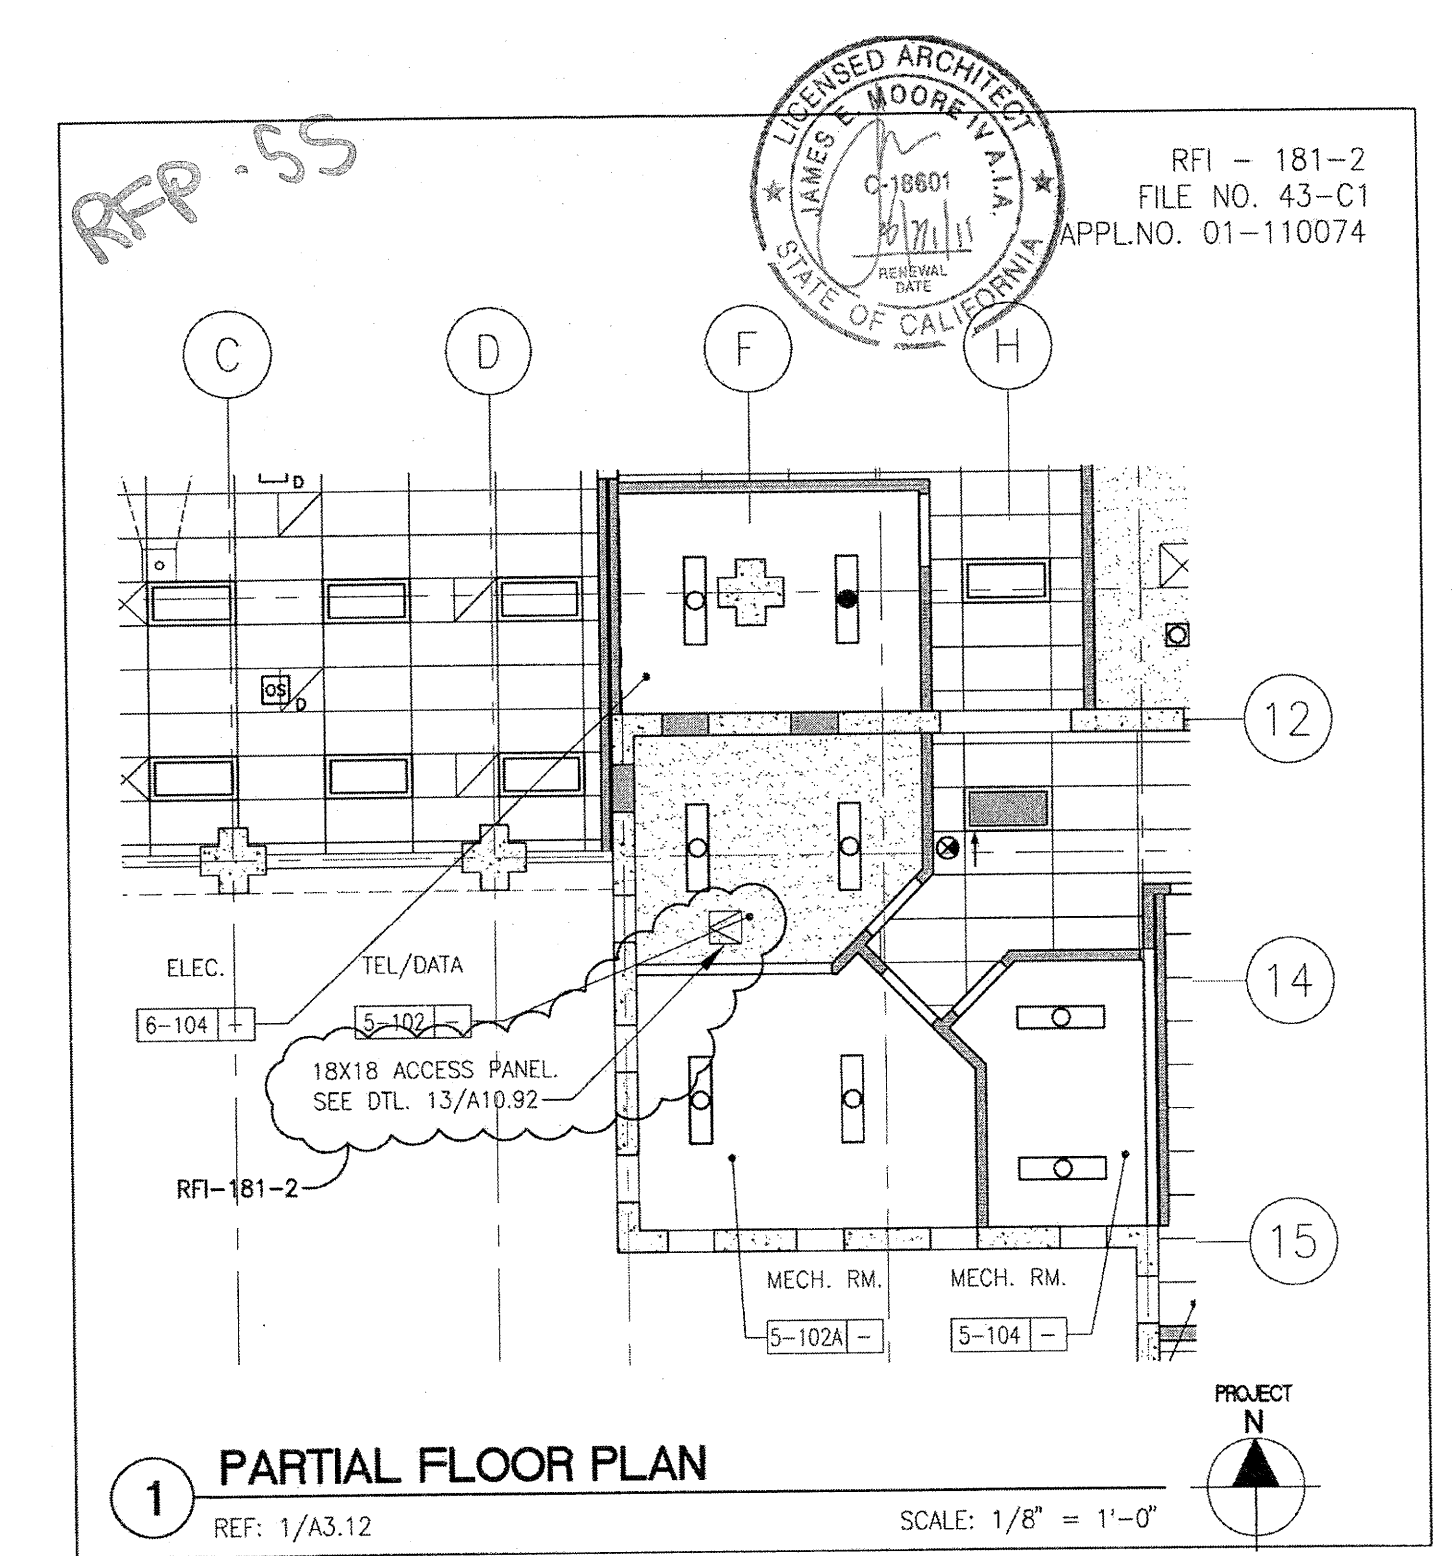

<b>BCA</b> architecture planning interiors  200 S. Bascom St. San Jose, California 95128 (415) 924-8800 www.bcaarchitect.com	Title:	Revision:	RFI No.:
	Project Name:	Date:	Drawing Number:
	Client:	Scale:	AS NOTED
	Project Location:	Project Number:	ASK-26