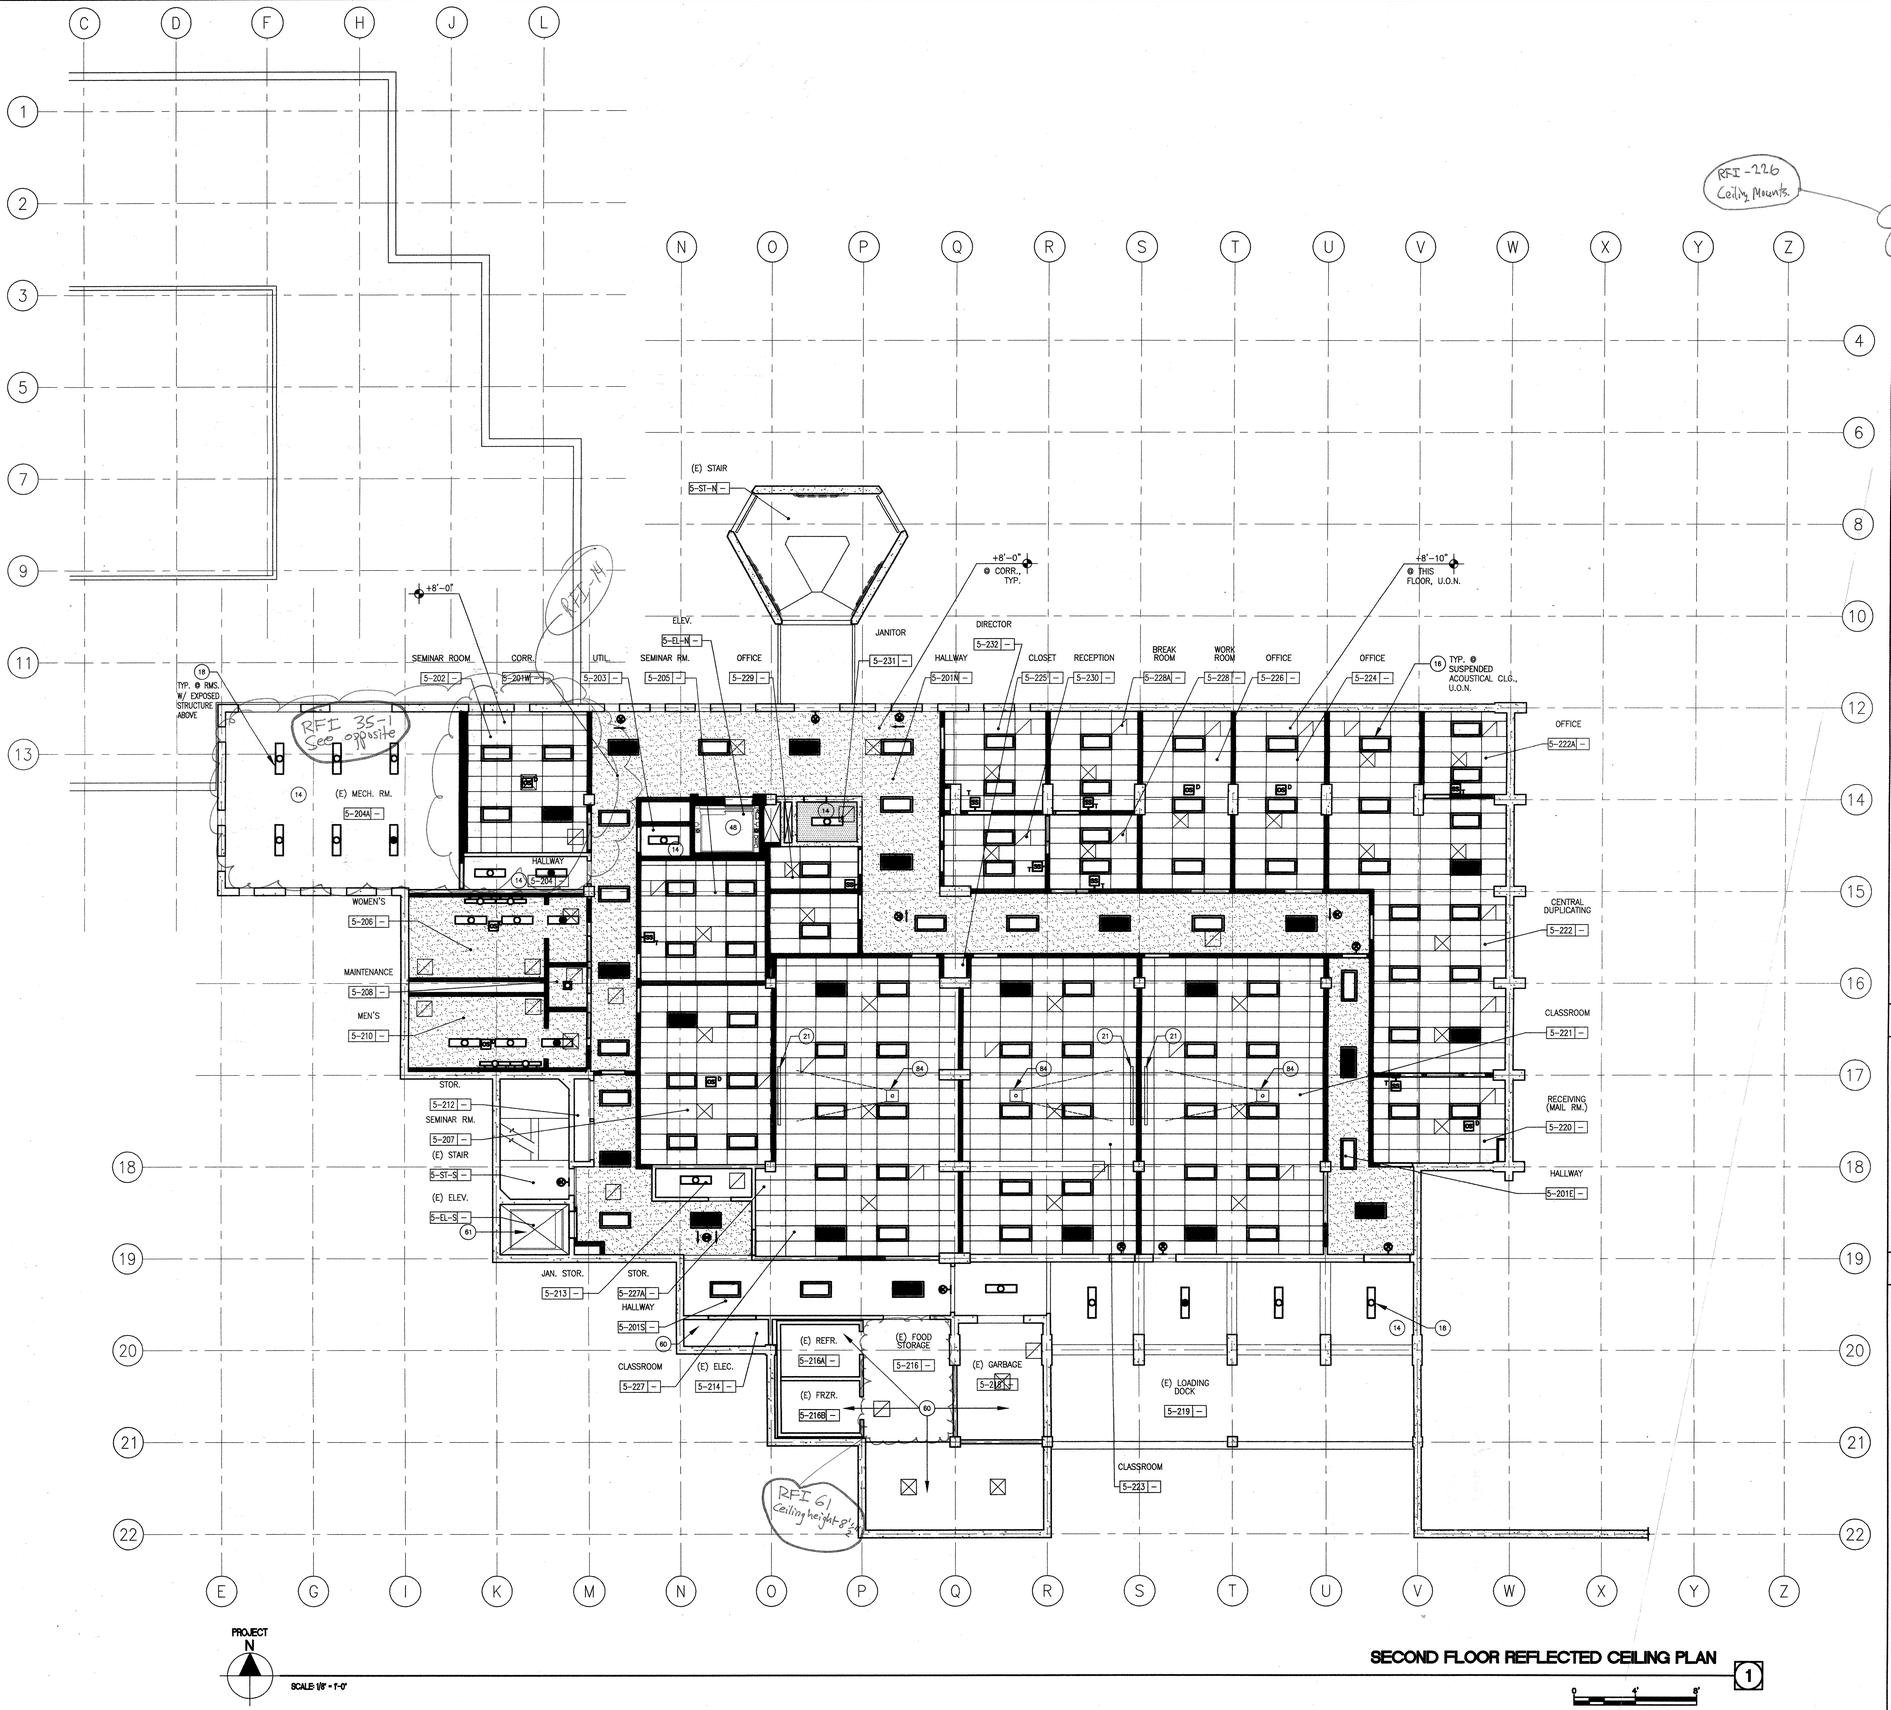


PROJECT N

SCALE: 1/8" = 1'-0"

## SECOND FLOOR REFLECTED CEILING PLAN

1

## SHEET NOTES

10. SUSPENDED ACOUSTICAL PANEL CEILING
11. GYPSUM BOARD CEILING
14. (E)EXPOSED STRUCTURE ABOVE
16. RECESSED LIGHT FIXTURE
18. SUSPENDED LIGHT FIXTURE
21. WALL MTD. PULL-DOWN PROJECTION SCREEN (SEE 21/A10.51)
22. WALL MTD. MOTORIZED PROJECTION SCREEN (SEE 21/A10.51)
60. (E) CEILING AND LIGHT FIXTURES TO REMAIN
61. (E) ELEVATOR TO REMAIN
84. CLG-MTD. PROJECTOR BRACKET (SEE DET. 11/A10.91 FOR CONNECTION), SEE ELECTRICAL DRAWINGS FOR ADDITIONAL INFO.

## GENERAL NOTES

A. SEE SHT. A9.1 FOR FINISH SCHEDULES.

B. SEE ELECTRICAL DRAWINGS FOR LIGHT FIXTURE SUPPORTS & BRACING.

C. SEE MECHANICAL AND PLUMBING DRAWINGS FOR HVAC AND PLUMBING EQUIPMENT AND FIXTURES.

D. SEE SHEETS A10.91 & A10.92 FOR TYPICAL CEILING DETAILS

## LEGEND

- (E) 1'x1' ACOUSTICAL CEILING TILES
- 2'x4' SUSPENDED ACOUSTICAL CEILING PANEL. SEE FINISH SCHED. FOR PANEL TYPE.
- GYPSUM BOARD CEILING. PAINT, U.O.N.
- CONCRETE STRUCTURE ABOVE, PAINT, U.O.N.
- SUPPLY AIR DIFFUSER
- RETURN AIR REGISTER/EXHAUST AIR GRILLE
- ACCESS DOOR
- FLUORESCENT LIGHT FIXTURE. SEE ELECTRICAL PLANS
- FLUORESCENT LIGHT FIXTURE. SEE ELECTRICAL PLANS
- DECORATIVE PENDANT LIGHT FIXTURE. SEE ELECTRICAL PLANS
- RECESSED 'CAN' LIGHT FIXTURE. SEE ELECTRICAL PLANS
- EXTERIOR WALL-MOUNTED LIGHT FIXTURE. SEE ELECTRICAL PLANS
- X'-X" CEILING HEIGHT
- EXIT LIGHT - SEE ELECTRICAL PLANS


BC|A
architecture
planning
interiors

Bunton Clifford Associates, Inc.
210 Hammond Ave.
Fremont, California 94539
[T] 510.445.1000
[F] 510.445.1005
www.BCAincOnline.com


| ARCHITECT | ENGINEER |
|---|---|
| LICENSED ARCHITECT BRIAN CURTIS BUNTON No. C018559 Exp.: 09/30/09 STATE OF CALIFORNIA | |

GENERAL NOTES

1. This sheet is part of a set and is not to be used alone.
2. This sheet is not to be used for construction unless the architect's stamp and signature appear on the drawings and the status box indicates drawings have been released for construction.
3. These plans and prints thereof, as instruments of service, are owned by the architect and are for use on this project only. Reproduction and/or distribution without the prior written consent of the architect is forbidden.
4. Copyright Bunton Clifford Associates, 2007

REVISION HISTORY

| | REMARKS | DATE |
|---|---|---|
| 1 | | |
| 2 | | |
| 3 | | |
| 4 | | |
| 5 | | |
| 6 | | |
| 7 | | |
| 8 | | |
| 9 | | |
| 10 | | |

DRAWING STATUS

| | DATE |
|---|---|
| DSA PLAN CHECK | 08/29/08 |
| DSA BACK CHECK | 01/22/09 |
| BIDDING | |
| CONSTRUCTION | |

FILE NO. 41-C1

IDENTIFICATION STAMP DIV. OF THE STATE ARCHITECT
01- 110074
AC FLS SS
DATE MAR 19 2009

# BUILDINGS 5 & 6 RENOVATIONS

San Mateo County Community College District

DSA SUBMITTAL

# CAÑADA COLLEGE

4200 Farm Hill Boulevard
Redwood City, CA 94061

SECOND FLOOR
REFLECTED CEILING PLAN

Date: 08/29/08
Scale: AS NOTED
Project Number: 07013

Drawing Number: A3.22