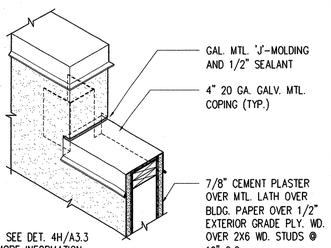

NOTE: SEE DET. 4H/A3.3 FOR MORE INFORMATION

20Q ISOMETRIC COPING

TYP. @ CHANGE IN PARAPET HEIGHT — N.T.S.

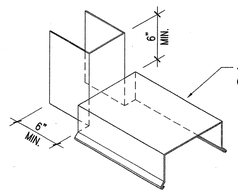

16Q ISOMETRIC COPING

TYP. @ CHANGE IN PARAPET HEIGHT — N.T.S.

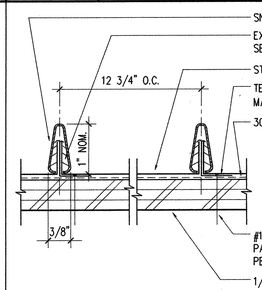

12Q STANDING SEAM MTL ROOFING

FULL SCALE

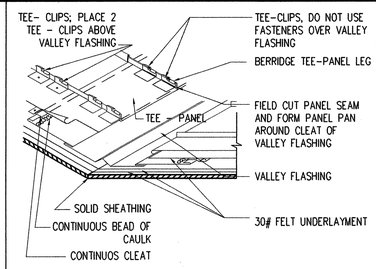

8Q ROOF VALLEY ATTACHMENT

N.T.S.

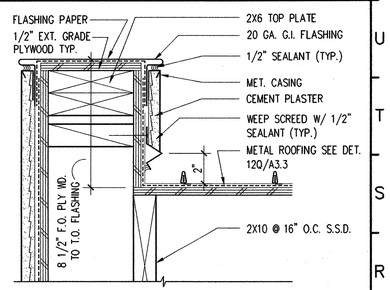

4Q ROOF PARAPET

@ ENTRY FOYER — FULL SCALE

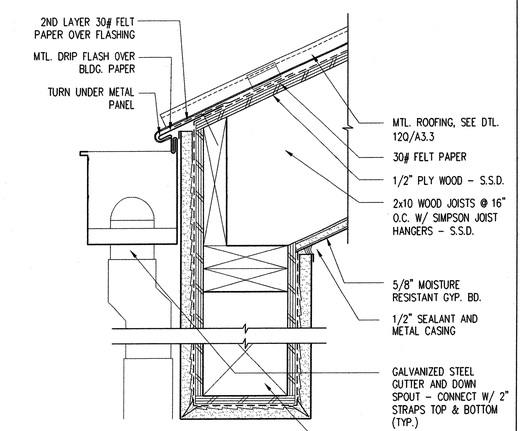

20H ROOF GUTTER

@ ENTRY FOYER ROOF — 3" = 1'-0"

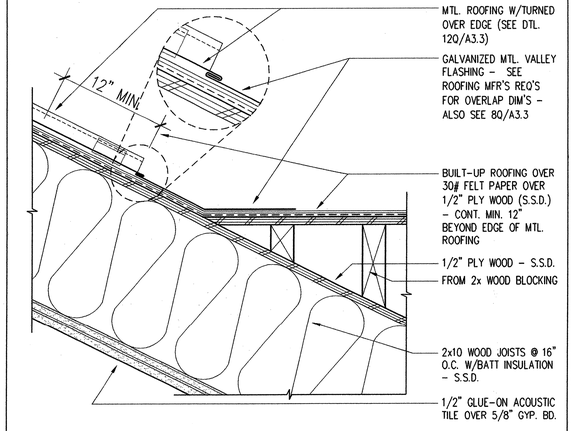

14H ROOF VALLEY

@ ENTRY FOYER ROOF — 3" = 1'-0"

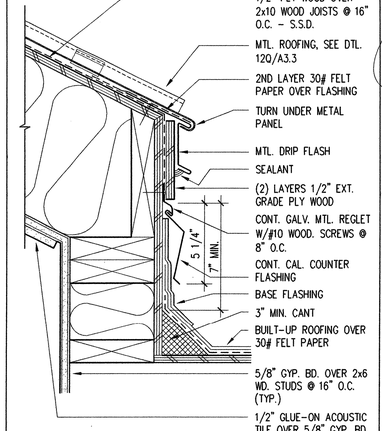

8H ROOF DRIP EDGE

@ ENTRY FOYER ROOF — 3" = 1'-0"

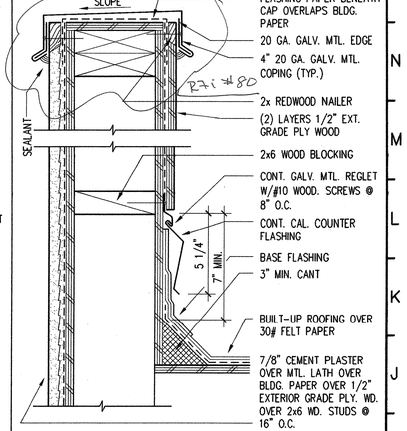

4H ROOF PARAPET

@ HEIGHTS < 2'-0" — 3" = 1'-0"

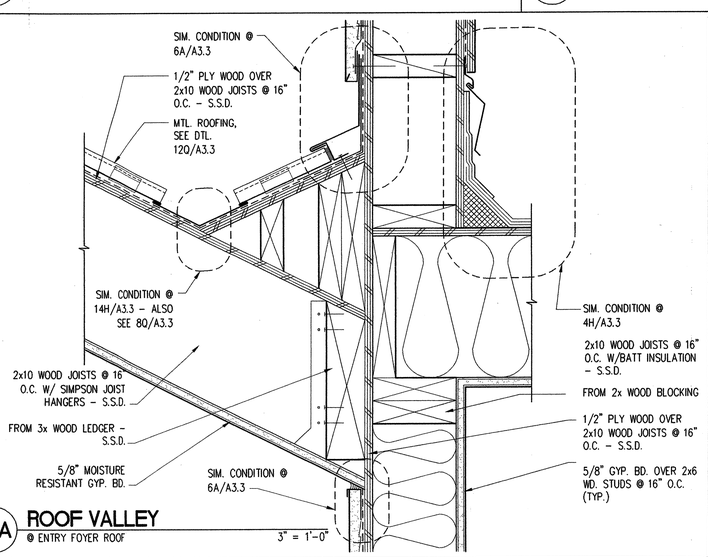

20A ROOF VALLEY

@ ENTRY FOYER ROOF — 3" = 1'-0"

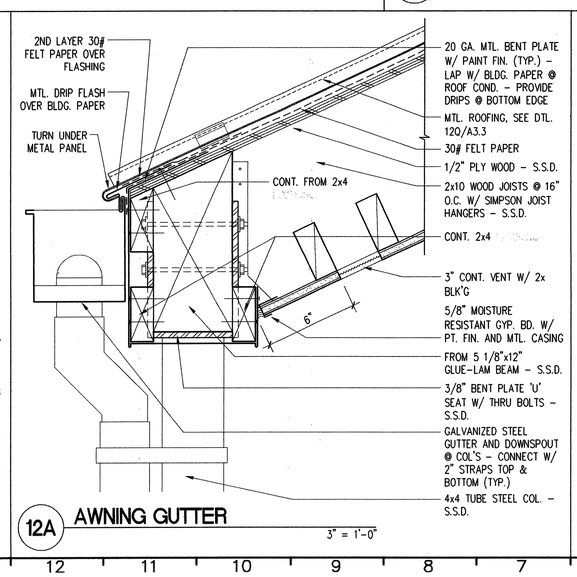

12A AWNING GUTTER

3" = 1'-0"

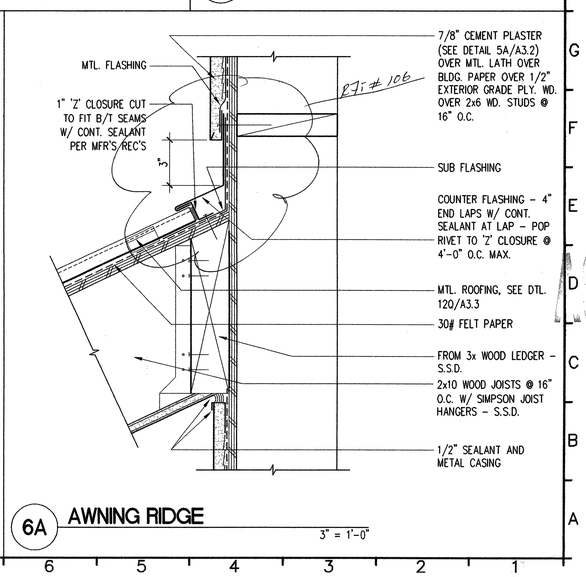

6A AWNING RIDGE

3" = 1'-0"

REVISIONS: (△ INDICATES REVISIONS MADE TO THIS SHEET)

NO.:	DATE	REASON	BY

ISSUE FOR PROGRESS REVIEW	01/15/01
ISSUE FOR PLAN CHECK	01/25/01
ISSUE FOR FINAL REVIEW	05/09/01
ISSUE FOR BID	
ISSUE FOR CONSTRUCTION	

SEAL:

LICENSED ARCHITECT — JAMES G. CIANFICHI — No. C-13346 — REN. 10-31-01 — STATE OF CALIFORNIA

ARCHITECT: CONSULTANT:

CONSULTANT:

ARCHITECT:

CIANFICHI
ARCHITECTURE • PLANNING

30 ANNE COURT
WALNUT CREEK, CA. 94598
TEL.: (925) 256-8638
FAX.: (925) 256-8652

PROJECT:

CHILD DEVELOPMENT CENTER
CAÑADA COLLEGE

4200 FARM HILL BLVD.
REDWOOD CITY, CA 94061

SAN MATEO COUNTY COMMUNITY COLLEGE DISTRICT

STAMP: IDENTIFICATION STAMP DIVISION OF THE STATE ARCHITECT
APPL01 103529
AC W FLS DS PM
DATE 5/14/01 Redate 9/14/01
APPL. NUMBER:

KEY PLAN:

AS BUILTS

SHEET TITLE:

ROOF DETAILS

DRAWN BY: GL	PROJECT NO.: 304.99
CHECKED BY: BA	DATE: 01-25-2001
APPL NO.:	SHEET: A3.3
DATA NO.:	NO.: OF: