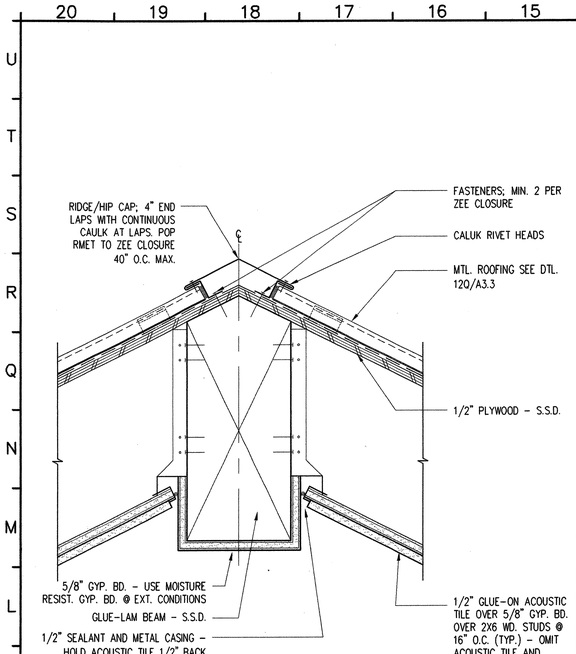

20K **ROOF RIDGE**
@ ENTRY FOYER ROOF (INT./EXT.) 3" = 1'-0"

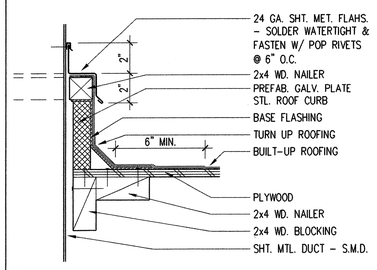

14Q **DUCT PENETRATION**
N.T.S.

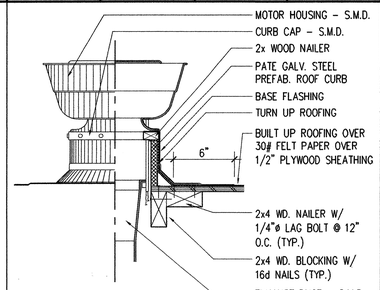

8Q **MOTOR HOUSING**
N.T.S.

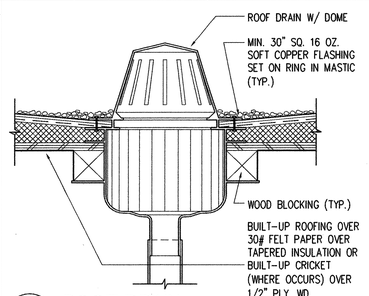

4Q **ROOF DRAIN**
N.T.S.

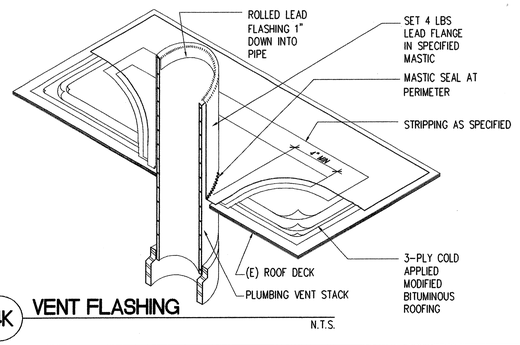

14K **VENT FLASHING**
N.T.S.

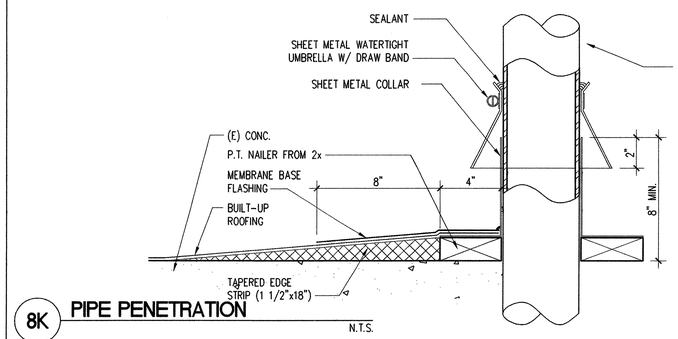

8K **PIPE PENETRATION**
N.T.S.

20E **NOT USED**
N.T.S.

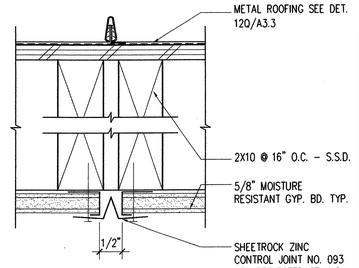

20A **AWNING CEILING REVEAL**
6" = 1'-0"

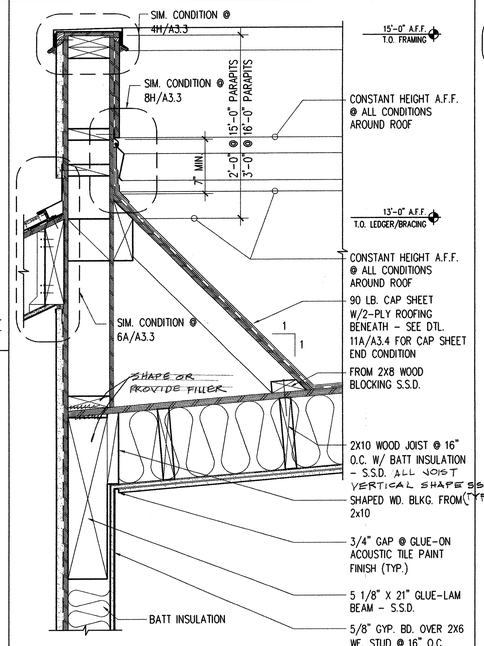

16A **ROOF PARAPET BRACING**
@ 15'-0" PARAPIT W/ AWNING 1-1/2" = 1'-0"

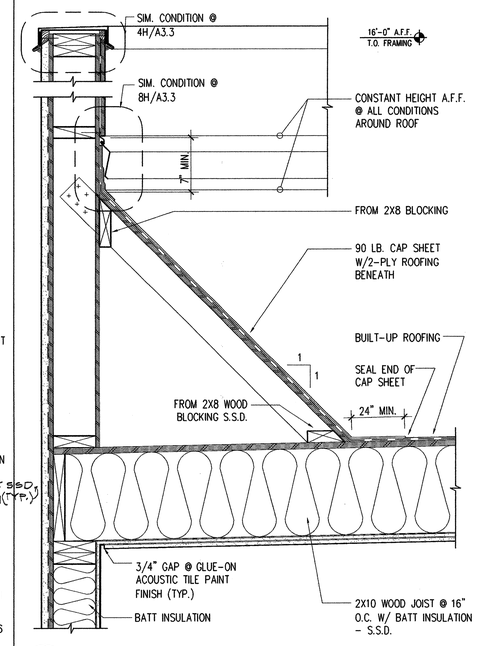

11A **ROOF PARAPET BRACING**
@ 16'-0" PARAPIT W/O AWNING 1-1/2" = 1'-0"

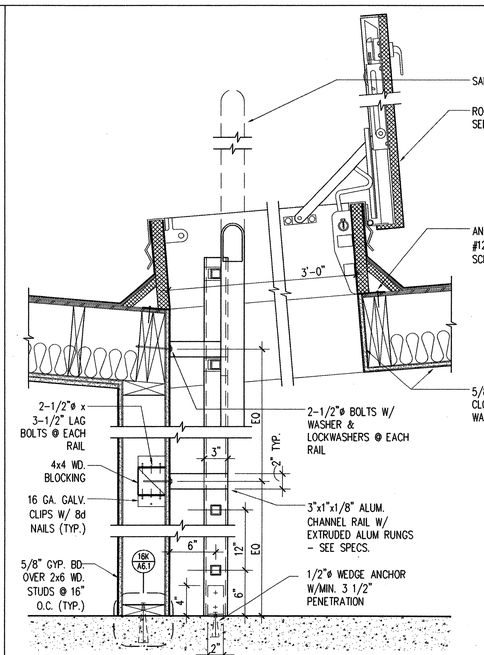

6A **ROOF HATCH**
1-1/2" = 1'-0"

REVISIONS: (△ INDICATES REVISIONS MADE TO THIS SHEET)

NO.:	DATE	REASON	BY

ISSUE FOR PROGRESS REVIEW	01/15/01
ISSUE FOR PLAN CHECK	01/25/01
ISSUE FOR FINAL REVIEW	05/09/01
ISSUE FOR BID	
ISSUE FOR CONSTRUCTION	

SEAL:

LICENSED ARCHITECT — JOSEPH D. CIANFICHI — No. C-5310 — REN. 10-31-01 — STATE OF CALIFORNIA

ARCHITECT: CONSULTANT:

CONSULTANT:

ARCHITECT:
CIANFICHI
ARCHITECTURE • PLANNING
30 ANNE COURT
WALNUT CREEK, CA. 94598
TEL.: (925) 256-8638
FAX.: (925) 256-8652

PROJECT:
CHILD DEVELOPMENT CENTER
CAÑADA COLLEGE

4200 FARM HILL BLVD.
REDWOOD CITY, CA 94061

SAN MATEO COUNTY COMMUNITY COLLEGE DISTRICT

STAMP: IDENTIFICATION STAMP
DIVISION OF THE STATE ARCHITECT
APPL.01 1035 29
AC FLS BS
DATE 5/9/01
APPL. NUMBER:

KEY PLAN:

AS BUILTS

SHEET TITLE:
ROOF DETAILS

DRAWN BY: GL	PROJECT NO.: 304.99
CHECKED BY: BA	DATE: 01-25-2001
APPL NO.:	SHEET: A3.4
DATA NO.:	NO.: OF: