FINISH SCHEDULE

ROOMS NO.	ROOMS NAME	FLOOR FIN.	FLOOR BASE	WALLS NORTH MAT.	WALLS NORTH FIN.	WALLS EAST MAT.	WALLS EAST FIN.	WALLS SOUTH MAT.	WALLS SOUTH FIN.	WALLS WEST MAT.	WALLS WEST FIN.	WAINSCOT	CLG. FIN.	REMARKS
PACIFIC HEIGHTS														
122	CORRIDOR	(E)	RTS-2	BR	-	BR	-	GB	P	BR	-	-	(E)	9
				PL	P	PL	P	PL	P	PL	P			
123	COSMOTOLOGY	(E)	(E)	BR	-	BR	-	GB	P	GB	P	-	(E)	7
				GB	P	PL	P	PL	P	PL	P			
124	REST RM	CT	(E)	(E)	(E)	(E)	(E)	(E)	(E)	(E)	(E)	-	(E)	1, 2, 3, 7
125	OFFICE	(E)	RTS-1	GB	P	GB	P	GB	P	BR	-	-	ACT	7
126	OFFICE	(E)	RTS-1	GB	P	GB	P	GB	P	BR	-	-	ACT	7
127	OFFICE	(E)	RTS-1	GB	P	GB	P	GB	P	BR	-	-	ACT	7
128	WAITING AREA	VCT-1	RTS-1	BR	-	GB	P	GB	P	BR	-	-	ACT	7
129	VEST.	(E)	(E)	GB	P	GB	P	PL	P	BR	-	-	-	7
130	STOR.	(E)	(E)	BR	-	BR	-	PL	P	PL	P	-	(E)	7
301	CLASSROOM	(E)	(E)	PL	P	BR	-	BR	-	PL	P	-	AT	7
				GB	P									
302	MECH RM	(E)	(E)	(E)	(E)	(E)	(E)	(E)	(E)	(E)	(E)	-	(E)	7
303	REST RM	CT-N	CTB-2	(E)	-	CT	-	(E)	-	(E)	-	CT-N	GC	1, 2, 3, 7
				CT	-			GB		GB				
304	STORAGE RM	(E)	(E)	(E)	(E)	(E)	(E)	(E)	(E)	(E)	(E)	-	(E)	7
305	SPA RM	(E)	RTS-1	PL	P	PL	P	BR	P	PL	P	-	ACT-E	7, 8
				GB	P	GB	P			GB	P			
306	FACIAL RM	(E)	RTS-1	PL	P	GB	P	BR	-	PL	P	-	ACT-E	7, 8
				GB	P			PL	P	GB	P			
306A	DRESSING RM	(E)	(E)	PL	P	GB	P	GB	P	GB	P	-	ACT-E	7, 8
307	OFFICE	(E)	(E)	PL	P	PL	P	BR	P	PL	P	-	ACT-E	7, 8
				GB	P									
308	CLASSROOM	(E)	(E)	PL	P	PL	P	BR	-	PL	P	-	ACT-E	7, 8
				GB	P									
309	UNIFORM STOR. CL.	(E)	(E)	PL	P	PL	P	BR	-	BR	-	-	PC	1, 2, 3, 7
310	REST RM	CT	CTB-1	CT	-	CT	-	CT	-	BR	-	-	PC	
				PL										
311	VEST	(E)	(E)	PL	P	PL	P	PL	P	WD	P	-	AT	7
312	REST RM	CT	CTB-1	CT	-	CT	-	CT	-	BR	-	-	PC	
				PL										
313	JANITOR CLOSET	(E)	(E)	BR	-	PL	P	PL	-	BR	-	-	PC	3,
										PL	P			
314	CLASSROOM	(E)	(E)	BR	-	PL	P	PL	P	PL	P	-	ACT-E	7, 8
								GB	P					
315	OFFICE	(E)	(E)	BR	-	PL	P	PL	P	PL	P	-	ACT-E	7, 8
								GB	P					
316	CLASSROOM	(E)	(E)	BR	-	PL	P	PL	P	PL	P	-	ACT-E	7, 8
								GB	P					
317	CLASSROOM	(E)	(E)	BR	-	BR	-	PL	P	PL	P	-	ACT-E	7, 8
								GB	P					
401	CLASSROOM	(E)	(E)	PL	P	BR	-	BR	-	PL	P	-	ACT-E	7, 8
				GB	P									
402	CLASSROOM	(E)	(E)	PL	P	PL	P	BR	-	PL	P	-	ACT-E	7, 8
				GB	P									
403	CLASSROOM	(E)	(E)	PL	P	PL	P	BR	-	PL	P	-	ACT-E	7, 8
				GB	P									
405	OFFICE	(E)	(E)	PL	P	PL	P	BR	-	PL	P	-	ACT-E	7, 8
				GB	P									
406	STORAGE	(E)	(E)	PL	P	PL	P	BR	-	BR	-	-	PC	3,
407	REST RM	CT	CTB-1	CT	-	CT	-	CT	-	BR	-	-	PC	
				PL										
408	VEST	(E)	(E)	PL	P	PL	P	PL	P	WD	P	-	AT	7
409	REST RM	CT	CTB-1	CT	-	CT	-	CT	-	BR	-	-	PC	
				PL										
410	JANITOR CLOSET	(E)	(E)	BR	-	PL	P	PL	-	BR	-	-	PC	3, 7
										PL	P			
411	CLASSROOM	(E)	(E)	BR	-	PL	P	PL	P	PL	P	-	ACT-E	7, 8
								GB	P	GB	P			
412	CLASSROOM	(E)	(E)	BR	-	PL	P	PL	P	PL	P	-	ACT-E	7, 8
								GB	P					
413	CLASSROOM	(E)	RTS-1	BR	-	PL	P	PL	P	PL	P	-	ACT-E	7, 8
						GB	P	GB	P					
414	OFFICE	VCT-1	RTS-1	GB	P	PL	P	PL	P	GB	P	-	ACT-E	7, 8
								GB	P					
414A	CLASSROOM	VCT-1	RTS-1	GB	P	PL	P	PL	P	PL	P	-	ACT-E	7, 8
						GB	P	GB	P	GB	P			
414B	OFFICE	VCT-1	RTS-1	BR	-	PL	P	PL	P	PL	P	-	ACT-E	7, 8
						GB	P	GB	P	GB	P			
414C	MECH. ROOM	VCT-1	RTS-1	BR	-	GB	P	GB	P	GB	P	-	ACT-E	7, 8
318	CORRIDOR	(E)	(E)	PL	P	PL	P	PL	P	PL	P	-	AT	7, 9
				GB	P			GB	P					
404	CORRIDOR	(E)	(E)	PL	P	PL	P	PL	P	PL	P	-	AT	7, 9
				GB	P			GB	P					

Paint to (E) Floor Finish RFI 004

MATERIALS & FINISHES LEGEND

SELECTED COLORS AND MATERIALS ARE PER COLLEGE FINISH STANDARDS.

FLOOR	
C	CONCRETE, EXISITNG
CT	CERAMIC TILE, EXISTING
CT-N	CERAMIC TILE, NEW
CT-1	CARPET TILE PER SPECS.
VCT-1	VINYL COMPOSITION TILE
VCT-2	EXISTING 9"x9" TILE

BASE	
RTS-1	RUBBER TOP SET BASE - BURKE BASE 523
	~~JSONWOOD - RUBBER 4" TOE KICK~~
CTB-1	CERAMIC TILE BASE, EXISTING
CTB-2	CERAMIC TILE BASE, NEW

WALL	
AT	ACOUSTICAL TILE, GLUE-ON
BR	BRICK, EXISTING
C	CONCRETE
CT	CERAMIC TILE, EXISTING
CT-N	CERAMIC TILE, NEW
(E)	EXISTING
GB	GYPSUM BOARD
G	GYPSUM BOARD, EXISTING
GL	GLASS
PL	PLASTER, EXISTING
WD	WOOD PANEL FINISH, EXISTING

CEILING	
ACT	ACOUSTIC CEILING - USG ASTRO CLIMAPLUS SQUARE EDGE - SQ 8241 - FLAT WHITE - USG DONN CENTRIGETEE DXT 9/16" HEAVY DUTY SUSPENSION
ACT-E	EXISTING ACOUSTICAL SUSPENDED CEILING
AT	ACOUSTICAL TILE, GLUE ON
GC	GYPSUM BOARD CEILING
PC	PLASTER CEILING, EXISTING

DOOR SCHEDULE FOOTNOTES

DOOR HARDWARE (TYP. @ ALL DOORS)

1. EXIT DOORS ARE OPERABLE FROM THE INSIDE WITHOUT THE USE OF A KEY OR ANY SPECIAL KNOWLEDGE OR EFFORT.
   NOTE: MANUALLY OPERATED EDGE OR SURFACE-MOUNTED FLUSH BOLTS AND SURFACE BOLTS ARE PROHIBITED.
2. OPERABLE WITH A SINGLE EFFORT (EX. LEVER TYPE, PANIC BAR OR PUSH-PULL TYPE).
3. OPENING HARDWARE IS CENTERED BETWEEN 30" AND 44" ABOVE FINISH FLOOR.
4. DOOR CLOSERS, IF PRESENT, MUST BE SET SO THAT IT TAKES AT LEAST 3 SECONDS TO CLOSE FROM AN OPEN POSITION OF 70° TO WITHIN 3" OF THE LATCH.
5. ALL NEW & EXISTING DOORS TO RECEIVE DOOR STOPS, LOCATE FLOOR MOUNT STOPS 4" MAX. FROM WALL.
6. ALL EXTERIOR DOORS TO RECEIVE CLOSERS U.O.N.

CLEAR SPACE AT DOORS / SIGNAGE @ DOORS (TYP. @ ALL DOORS)

GENERAL - REGARDLESS OF THE OCCUPANT LOAD, THERE SHALL BE A FLOOR OR LANDING ON EACH SIDE OF A DOOR.

1. FLOOR OR LANDING ON EACH SIDE OF THE DOOR IS LEVEL AND CLEAR.
2. LEVEL AREA IN THE DIRECTION OF THE DOOR SWING IS A MINIMUM OF 60" IN LENGTH.
3. LEVEL AREA OPPOSITE THE DIRECTION OF THE DOOR SWING IS A MINIMUM OF 44"-48" IN LENGTH, DEPENDENT UPON DIRECTION OF APPROACH AND EXISTENCE OF LATCH AND CLOSER.
4. SURFACE SLOPE OF THE LEVEL AREA DOES NOT EXCEED 1:50 GRADIENT 2%.
5. FOR INTERIOR DOORS, PROVIDE MINIMUM 18" ON STRIKE SIDE CLEARANCE ON PULL SIDE OF DOOR.
6. FOR EXTERIOR DOORS, PROVIDE MINIMUM 24" ON STRIKE SIDE CLEARANCE ON PULL SIDE OF DOOR.
7. PROVIDE MINIMUM 12" ON LATCH SIDE CLEARANCE ON PULL SIDE OF DOOR IF DOOR IS EQUIPPED WITH BOTH A LATCH AND A CLOSER.
8. ROOM SIGNS TO BE INSTALLED ADJACENT TO EACH DOOR, TYP. @ INTERIOR AND EXTERIOR,PULL SIDE OF DOOR.
9. LOCATE TACTILE EXIT SIGNS AT PUSH SIDE OF DOOR & OTHER SIGNS AT PULL SIDE OF DOOR, U.O.N.

THRESHOLDS (TYP. AT ALL DOORS)

1. FLOOR(S) OR LANDING(S) ARE NOT MORE THAN 1/2" LOWER THAN THE TOP OF THE THRESHOLD OR DOORWAY.
2. CHANGE IN LEVEL BETWEEN 1/4" AND 1/2" IS BEVELED AT GRADIENT OF 1:2.
   NOTE. A 1/4" MAXIMUM VERTICAL EDGE IS ALLOWABLE AT THRESHOLD.
3. DOORMATS ARE SECURELY ATTACHED (ANCHORED OR RECESSED).
4. MAXIMUM HEIGHT OF DOORMATS IS 1/2".

DOOR FOOTNOTES (AS NOTED IN SCHEDULE)

1. MINIMUM 3'-0" WIDTH, 6'-8" IN HEIGHT, U.O.N.
2. OPENS A MINIMUM OF 90°.
3. CLEAR WIDTH OF DOORWAY IS 32" MINIMUM.
4. DOUBLE DOORS/AUTOMATIC DOORS - AT LEAST ONE DOOR MUST COMPLY WITH 1, 2 AND 3 ABOVE.
5. BOTTOM 10" OF DOOR HAS A SMOOTH UNINTERRUPTED SURFACE (KICK PLATE) ON THE PUSH SIDE OF DOOR.
6. EFFORT TO OPERATE DOORS IS WITHIN PRESSURE ALLOWED. THE CLOSER MUST BE A MINIMUM 3 SECONDS FROM 70° OPEN POSITION.
   INTERIOR DOORS - 5 POUNDS MAXIMUM PRESSURE TO OPERATE.
   EXTERIOR DOORS - 5 POUNDS MAXIMUM PRESSURE TO OPERATE.
   FIRE DOORS - 15 POUNDS MAXIMUM PRESSURE TO OPERATE WHEN ALLOWED BY AUTHORITY HAVING JURISDICTION.
7. REMOVE (E) LOCKING HARDWARE ON ALL DOORS TO RECEIVE (N) LOCKING HARDWARE. RETURN (E) MATERIAL TO THE DISTRICT.
8. ADD FUSIBLE LINK TO THE EXISTING METAL LOUVERS.
9. NOT USED.
10. REPLACE ANY DAMAGED OR MISSING HARDWARE DUE TO THE REMOVAL OF DOORS. FOR REFERENCE SEE HARDWARE GROUP.
11. PANIC HARDWARE REQUIRED.
12. VERIFY IN FIELD (V.I.F.) ALL CONDITIONS. PROVIDE DOORS AND TRIM AT HEAD AND JAMB. PROVIDE ADDITIONAL BACKING AS NEEDED FOR SUPPORT TO STRUCTURE. PATCH AND REPAIR TRIM AT HEAD AND JAMBS WHERE DAMAGED.
13. FIELD VERIFY MAXIMUM SWING OF DOOR. VERIFY MAXIMUM CLOSER ARC W/ CLOSER MANUFACTURER PRIOR TO INSTALLATION.
14. GLAZING IN AND ADJACENT TO DOORS SHALL BE TEMPERED GLASS, PER CBC.
15. NOT USED.
16. NOT USED.
17. NOT USED.
18. NEW ADA COMPLIANT THRESHOLDS - SEE SPECIFICATIONS SECTION SECTION 08700 "HARDWARE". REMOVE (E) THRESHOLD WHERE OCCURS; PATCH & REPAIR ALL ADJACENT SURFACES AS REQUIRED FOR INSTALLATION OF (N) THRESHOLD.
19. NOT USED.
20. NOT USED.
21. NOT USED.
22. NOT USED.
23. NOT USED.
24. (E) SALVAGED DOOR, RELOCATE PER PLAN.
25. (E) PROVIDE RETROFIT KIT & LEVER HARDWARE.
26. SIGNAGE. SEE DTL. 4/A9.4.
27. NOT USED.
28. SIGNAGE. SEE DTL. 13/A9.4.
29. SIGNAGE. SEE DTL. 16/A9.4.
30. (E) PUSH/PULL DOOR HARDWARE TO REMAIN.

DOOR ELEVATIONS

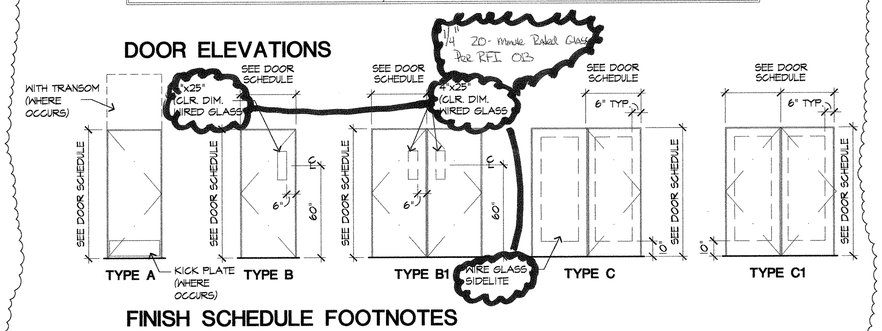

FINISH SCHEDULE FOOTNOTES

1. CLEAN THE (E) WALL FINISHES
2. CLEAN THE (E) FLOOR TILE
3. PAINT (E) OR (N) CEILING
4. PAINT (E) CONCRETE WAFFLE SLAB STRUCTURE. COLOR TO MATCH (E) ADJACENT WALL COLOR.
5. NO PAINT AT CEILING.
6. CLEAN & PATCH (E) FINISH @ WOOD PANELS & PASS-THRU DOORS
7. PROVIDE ROOM I.D. SIGNAGE PER DETAILS 14/A9.4. LOCATE TO COMPLY WITH 2001 C.B.C. REQS.
8. REPLACE DAMAGED OR MISSING CEILING TILES W/ (N) TO MATCH (E)
9. PATCH & REPAIR ALL DISTURBED AREAS. PAINT WALLS TO MATCH (E) @ (N) WALL INFILL WHERE OCCURS.

DOOR SCHEDULE

RM./DOOR NO.	TYPE	DOOR SIZE - WIDTH X HEIGHT X THICKNESS	DOOR MAT.	DOOR FIN.	FRAME MAT.	FRAME FIN.	UL	DETAIL HEAD	DETAIL JAMB	DETAIL SILL	HRDWR. GRP.	FOOTNOTES
PACIFIC HEIGHTS												
122B	BI	3'-0" X 6'-8" X 1 3/4"	H.M.	P	MTL	P	20	20/A9.4	20/A9.4	4/A9.4	7	1, 5, 11
123A	B	3'-0" X 6'-8" X 1 3/4"	WD	P	MTL	P	20	1/A9.4	1/A9.4	-	5	6, 14, 11
123B	A	PR. 3'-0" X 6'-8" X 1 3/4"	H.M.	P	MTL	P	20	20/A9.4	20/A9.4	4/A9.4	6A	4, 5, 12, 13, 14, 18, 11
124	-	3'-0" X 6'-8" X 1 3/4"	-	P	-	P	20	-	-	-	10	-
125	B	3'-0" X 6'-8" X 1 3/4"	WD	P	MTL	P	-	1/A9.4	1/A9.4	-	2A	6, 14
126	B	3'-0" X 6'-8" X 1 3/4"	WD	P	MTL	P	-	1/A9.4	1/A9.4	-	2A	6, 14
127	B	3'-0" X 6'-8" X 1 3/4"	WD	P	MTL	P	-	1/A9.4	1/A9.4	-	2A	6, 14
128A	B	3'-0" X 6'-8" X 1 3/4"	WD	P	MTL	P	-	1/A9.4	1/A9.4	-	2B	6, 14
128B	BI	PR. 3'-0" X 6'-8" X 1 3/4"	WD	P	MTL	P	20	-	-	-	6A	4, 6, 14
128C	-	PR. 3'-0" X 6'-8" X 1 3/4"	-	P	-	P	20	-	-	-	10	-
129	BI	PR. 3'-0" X 6'-8" X 1 3/4"	WD	P	MTL	P	20	20/A9.4	20/A9.4	-	6C	4, 6, 14, 11
130	-	(E) 3'-0" X 6'-8" X 1 3/4"	-	P	-	P	20	-	-	-	3	6, 7, 13, 25
301A	-	(E) 3'-0" X 6'-8" X 1 3/4"	-	P	-	P	20	-	-	-	2	6, 7, 13, 25
301B	-	(E) 3'-0" X 6'-8" X 1 3/4"	-	P	-	P	-	-	-	-	-	28

DOOR SCHEDULE-CONTINUED

RM./DOOR NO.	TYPE	DOOR SIZE - WIDTH X HEIGHT X THICKNESS	DOOR MAT.	DOOR FIN.	FRAME MAT.	FRAME FIN.	UL	DETAIL HEAD	DETAIL JAMB	DETAIL SILL	HRDWR. GRP.	FOOTNOTES
PACIFIC HEIGHTS - CONTINUED												
302	-	(E) 3'-0" X 6'-8" X 1 3/4"	-	P	-	P	20	-	-	-	3A	7
303	A	3'-0" X 6'-8" X 1 3/4"	WD	P	MTL	P	-	1/A9.4	1/A9.4	-	4A	6, 13
304	-	(E) 3'-0" X 6'-8" X 1 3/4"	-	P	-	P	20	-	-	-	8	-
305A	-	(E) 3'-0" X 6'-8" X 1 3/4"	-	P	-	P	20	-	-	-	2	6, 7, 13, 25
305B	-	(E) 3'-0" X 6'-8" X 1 3/4"	-	P	-	P	-	-	-	-	8	28
306A	B	3'-0" X 6'-8" X 1 3/4"	WD	P	MTL	P	20	1/A9.4	1/A9.4	-	1	6
307A	-	(E) 3'-0" X 6'-8" X 1 3/4"	-	P	-	P	20	-	-	-	9	6, 7, 13, 25
307B	-	(E) 3'-0" X 6'-8" X 1 3/4"	-	P	-	P	-	-	-	-	8	28
308A	-	(E) 3'-0" X 6'-8" X 1 3/4"	-	P	-	P	20	-	-	-	2	6, 7, 13, 25
308B	-	(E) 3'-0" X 6'-8" X 1 3/4"	-	P	-	P	-	-	-	-	8	28
309A	-	(E) 3'-0" X 6'-8" X 1 3/4"	-	P	-	P	-	-	-	-	9	-
309B	-	(E) 3'-0" X 6'-8" X 1 3/4"	-	P	-	P	-	-	-	-	3	6, 7, 25
310	-	(E) 3'-0" X 6'-8" X 1 3/4"	-	P	-	P	20	-	-	-	10	-
311	C	3'-0" X 6'-8" X 1 3/4"	H.M.	P	MTL	P	20	1/A9.4	1/A9.4	-	7	6, 12, 13, 18, 11
312	-	(E) 3'-0" X 6'-8" X 1 3/4"	-	P	-	P	20	-	-	-	10	-
313	-	(E) 3'-0" X 6'-8" X 1 3/4"	-	P	-	P	20	-	-	-	3A	-
314A	-	(E) 3'-0" X 6'-8" X 1 3/4"	-	P	-	P	20	-	-	-	2	6, 7, 13, 25
314B	-	(E) 3'-0" X 6'-8" X 1 3/4"	-	P	-	P	-	-	-	-	8	28
315A	-	(E) 3'-0" X 6'-8" X 1 3/4"	-	P	-	P	20	-	-	-	9	6, 7, 13, 25
315B	-	(E) 3'-0" X 6'-8" X 1 3/4"	-	P	-	P	-	-	-	-	8	28
316A	-	(E) 3'-0" X 6'-8" X 1 3/4"	-	P	-	P	20	-	-	-	2	6, 7, 13, 25
316B	-	(E) 3'-0" X 6'-8" X 1 3/4"	-	P	-	P	-	-	-	-	8	28
317A	-	(E) 3'-0" X 6'-8" X 1 3/4"	-	P	-	P	20	-	-	-	2	6, 7, 13, 25
317B	-	(E) 3'-0" X 6'-8" X 1 3/4"	-	P	-	P	-	-	-	-	8	28
318	BI	PR. 3'-0" X 6'-8" X 1 3/4"	WD	P	-	P	60	1/A9.4	1/A9.4	-	6	4, 6, 14, 11
401A	-	(E) 3'-0" X 6'-8" X 1 3/4"	-	P	-	P	20	-	-	-	2	6, 7, 13, 25
401B	-	(E) 3'-0" X 6'-8" X 1 3/4"	-	P	-	P	-	-	-	-	8	28
402A	-	(E) 3'-0" X 6'-8" X 1 3/4"	-	P	-	P	20	-	-	-	2	6, 7, 13, 25
402B	-	(E) 3'-0" X 6'-8" X 1 3/4"	-	P	-	P	-	-	-	-	8	28
403A	-	(E) 3'-0" X 6'-8" X 1 3/4"	-	P	-	P	20	-	-	-	2	6, 7, 13, 25
403B	-	(E) 3'-0" X 6'-8" X 1 3/4"	-	P	-	P	-	-	-	-	8	28
404	BI	PR. 3'-0" X 6'-8" X 1 3/4"	WD	P	-	P	60	1/A9.4	1/A9.4	-	6	4, 6, 14, 11
405A	-	(E) 3'-0" X 6'-8" X 1 3/4"	-	P	-	P	20	-	-	-	9	6, 7, 13, 25
405B	-	(E) 3'-0" X 6'-8" X 1 3/4"	-	P	-	P	-	-	-	-	8	28
406A	-	(E) 3'-0" X 6'-8" X 1 3/4"	-	P	-	P	-	-	-	-	8	-
406B	-	(E) 3'-0" X 6'-8" X 1 3/4"	-	P	-	P	-	-	-	-	3	6, 7, 13, 25
407	-	(E) 3'-0" X 6'-8" X 1 3/4"	-	P	-	P	20	-	-	-	10	-
408	C	3'-0" X 6'-8" X 1 3/4"	H.M.	P	MTL	P	20	1/A9.4	1/A9.4	4/A9.4	7	6, 12, 13, 18, 11
409	-	(E) 3'-0" X 6'-8" X 1 3/4"	-	P	-	P	20	-	-	-	10	-
410	-	(E) 3'-0" X 6'-8" X 1 3/4"	-	P	-	P	20	-	-	-	3B	6, 7, 13, 25
411A	-	(E) 3'-0" X 6'-8" X 1 3/4"	-	P	-	P	20	-	-	-	2	6, 7, 13, 25
411B	-	(E) 3'-0" X 6'-8" X 1 3/4"	-	P	-	P	-	-	-	-	8	28
412A	-	(E) 3'-0" X 6'-8" X 1 3/4"	-	P	-	P	20	-	-	-	2	6, 7, 13, 25
412B	-	(E) 3'-0" X 6'-8" X 1 3/4"	-	P	-	P	-	-	-	-	8	28
413A	B	3'-0" X 6'-8" X 1 3/4"	WD	P	MTL	P	20	1/A9.4	1/A9.4	-	1A	6, 14
413B	-	(E) 3'-0" X 6'-8" X 1 3/4"	-	P	-	P	20	-	-	-	8	28
414A	-	(E) 3'-0" X 6'-8" X 1 3/4"	-	P	-	P	-	-	-	-	9	6, 7, 13, 25
414B	A	3'-0" X 6'-8" X 1 3/4"	WD	P	MTL	P	-	1/A9.4	1/A9.4	-	2A	-
414C	A	3'-0" X 6'-8" X 1 3/4"	WD	P	MTL	P	-	1/A9.4	1/A9.4	-	3C	-

Review "As-Built" Hardware Schedule for final configuration of Doors/Frames & Hardware

Sugimura & Associates Architects
Architecture • Planning • Interiors
Landscape Architecture
2155 South Bascom Ave. Suite 200
Campbell, CA 95008
408-879-0600 Fx 408-377-6066

COPYRIGHT © 2003 Sugimura & Associates Architects

LICENSED ARCHITECT PATRICK X. MALONEY C 26311 REN. FEB. 28 2005 STATE OF CALIFORNIA

DESIGN REVIEW STAMP
DIV. OF THE STATE ARCHITECT
OFFICE OF REGULATION SERVICES
APP. NO.
AC. ___ FLS ___ SS.
DATE
FILE NO.
Division of the State Architect
Regional Office
1515 Clay Street, Suite 1201
Oakland, CA 94612

SCHEDULES

SKYLINE COLLEGE SWING SPACE
PERMIT PACKAGE #3
SKYLINE COLLEGE
3300 COLLEGE DRIVE
SAN BRUNO, CA 94066

REVISIONS

NO.	ITEM	DATE
1	DSA BACKCHECK	5/28/04
2	CONSTRUCTION ISSUE	6/10/04
4	ADDENDUM 4	8/21/04
5	CONFORM SET	9/9/04
6	As-Built	3/1/05

CLIENT APPROVAL:

DRAWN BY: KH
CHECKED BY:
JOB NO: 2145.002
DATE: 13 FEB 2004

A3.0

OF SHEETS