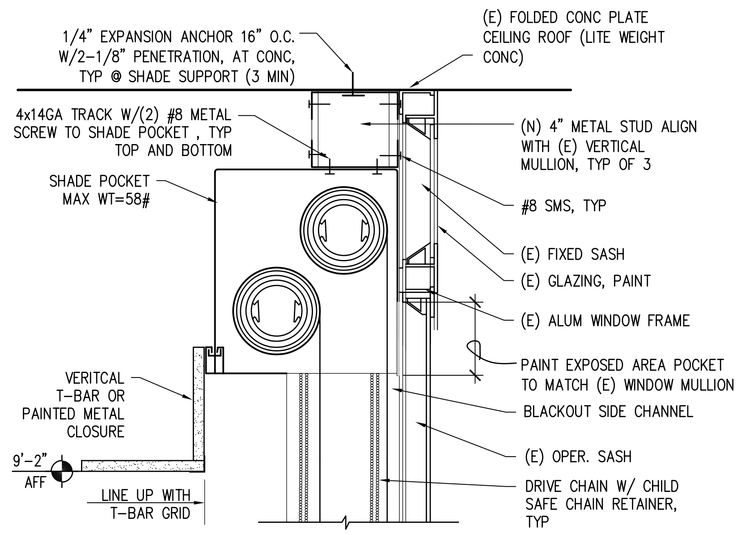

1U TYP. CEILING AT (E) HORIZONTAL MULLION - SECOND FLOOR
SCALE: 3"=1'-0"

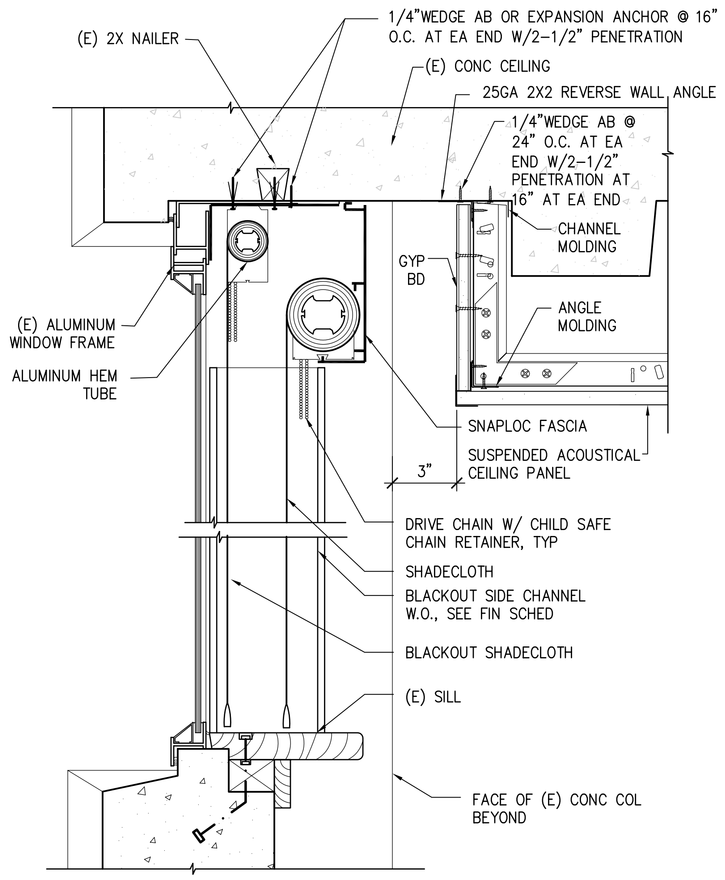

1J DUAL ROLLERS BLACKOUT SHADE
SCALE: 3"=1'-0"

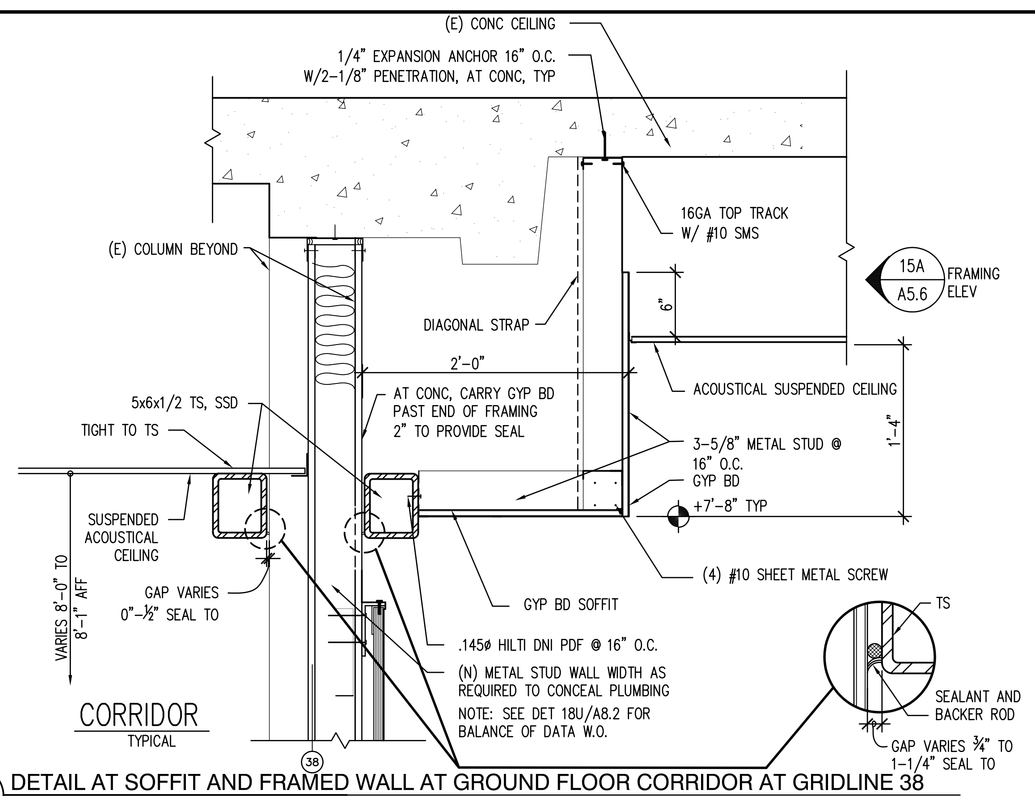

1A DETAIL AT SOFFIT AND FRAMED WALL AT GROUND FLOOR CORRIDOR AT GRIDLINE 38
SCALE: 1-1/2"=1'-0"

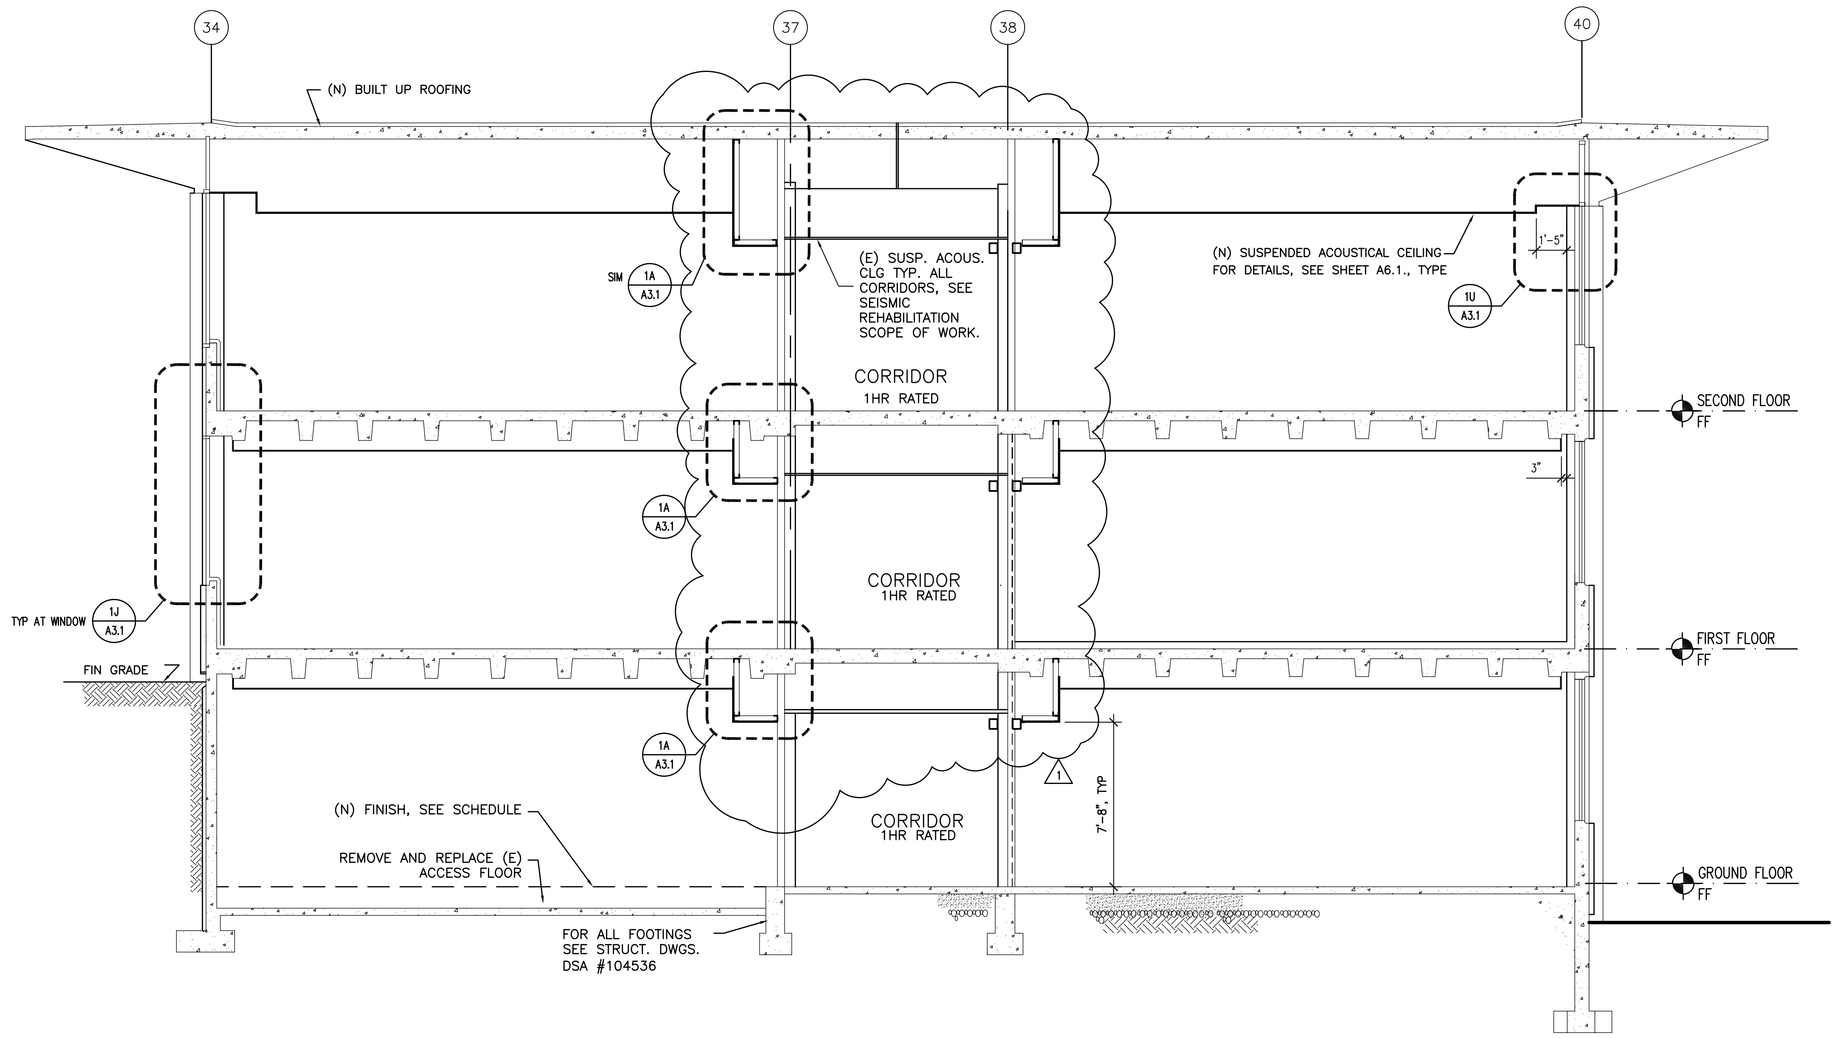

12N BUILDING SECTION
SCALE: 1/4"=1'-0"

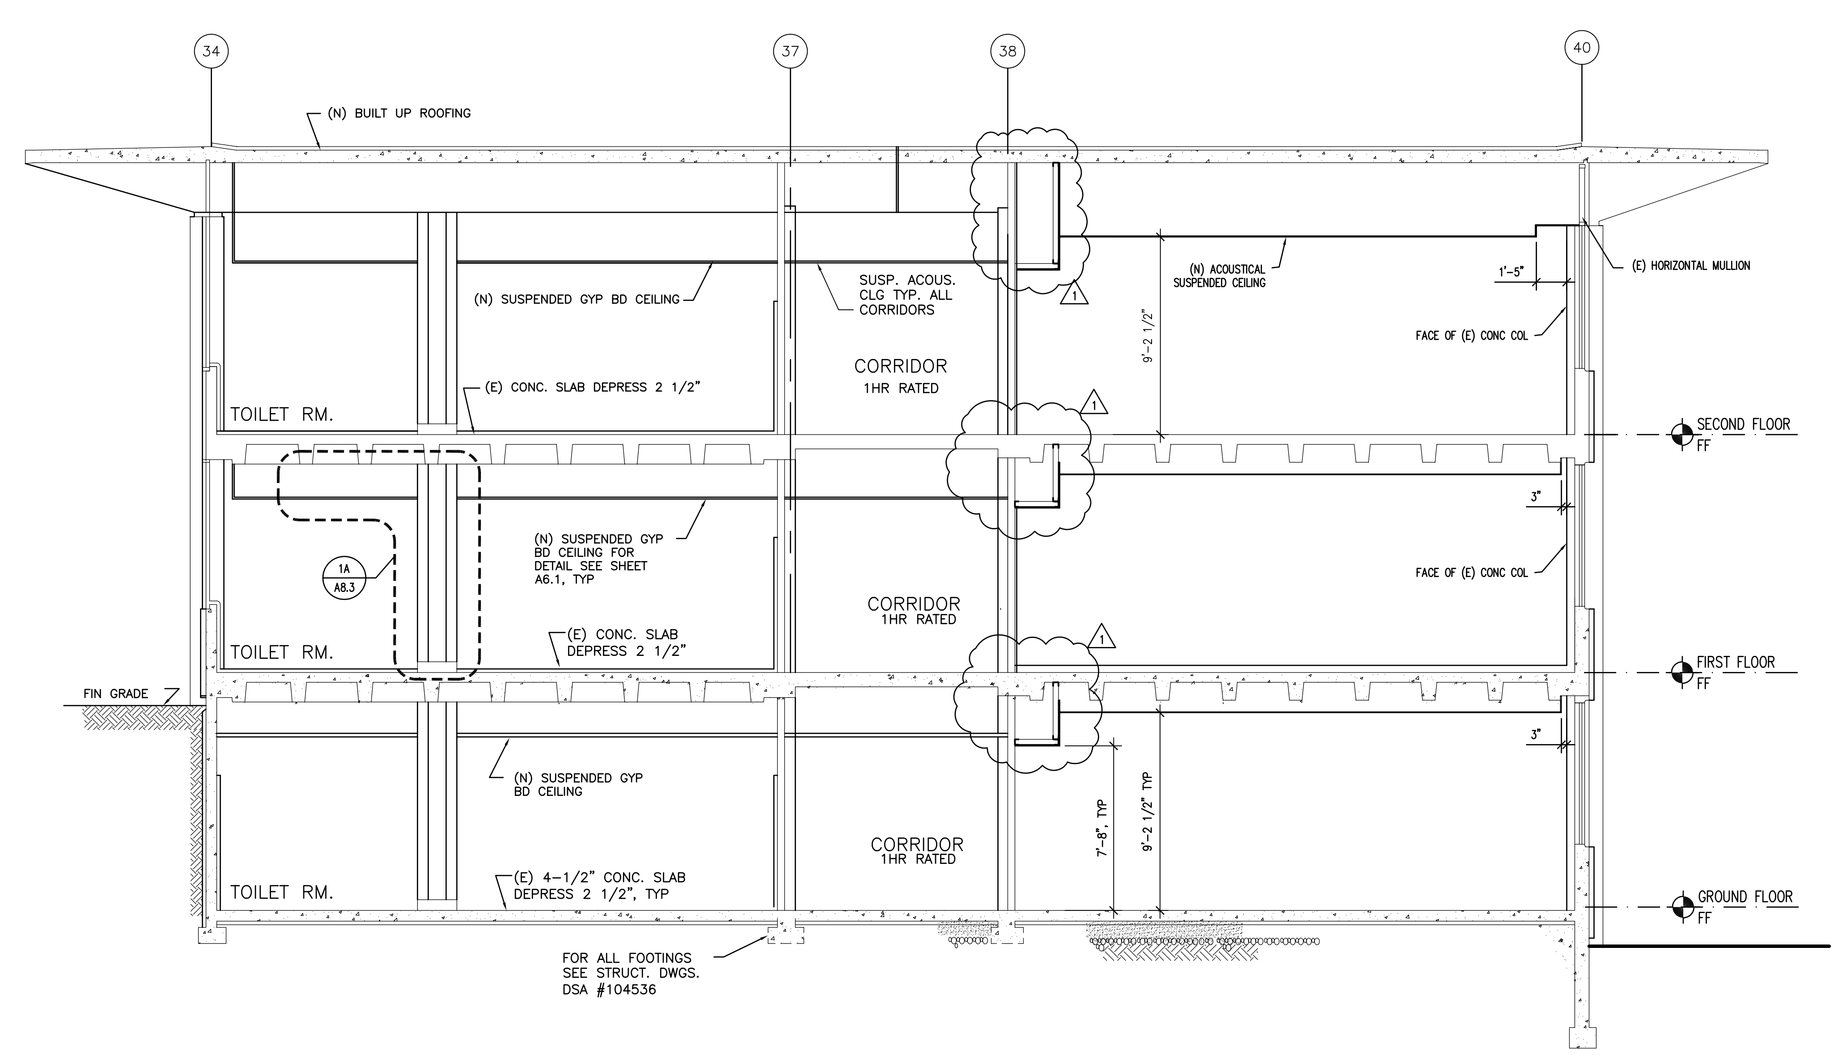

12A BUILDING SECTION
SCALE: 1/4"=1'-0"

REVISION	DESCRIPTION	INITIAL	DATE
1	ADDENDUM	TKB	4/1/04
	PRE-APPLICATION REVIEW		02/06/04
	ISSUED FOR PLAN CHECK		03/03/04
	ISSUED FOR PERMIT		03/03/04
	ISSUED FOR BID		
	ISSUED FOR CONSTRUCTION		

SEAL:

LICENSED ARCHITECT THOMAS K. BUTT No. C 7,389 REN. 3-31-07 STATE OF CALIFORNIA

CONSULTANT:

INTERACTIVE RESOURCES
ARCHITECTURE • PLANNING • ENGINEERING
117 PARK PLACE
POINT RICHMOND
CALIFORNIA 94801
(510) 236-7435
(FAX) 232-5325
http://www.intres.com

PROJECT:

BUILDING NO. 18 (NORTH HALL) MODERNIZATION

COLLEGE OF SAN MATEO
1700 WEST HILLSDALE BLVD.
SAN MATEO, CA 94402

SAN MATEO CO. COMMUNITY COLLEGE DISTRICT

IDENTIFICATION STAMP
DIV. OF THE STATE ARCHITECT
OFFICE OF REGULATION SERVICES
APPL 106047
AC ____ FLS ____ SS ____
DATE ____

APPROVED
DIV. OF THE STATE ARCHITECT
APPL 106047
AC ____ FLS ____ SS ____
DATE ____

SHEET TITLE:

SECTIONS

PROJ. NO.	2002-066.02
PREPARATION AND REVIEW	
DRAWN BY	BA
DESIGNER	TKB
PROJ. MGR.	TKB
PEER REVIEW	

SHEET NUMBER:

MOD
A3.1

NUMBER: OF: