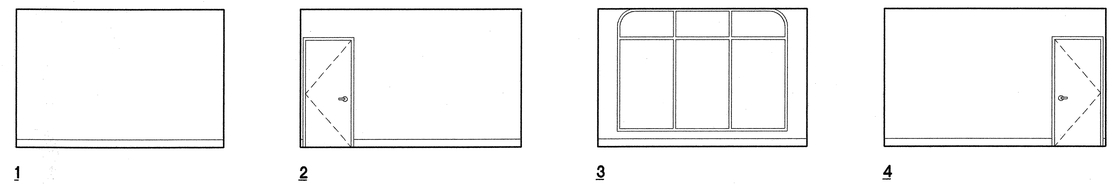

20N CONFERENCE ROOM - 09
1/4" = 1'-0"

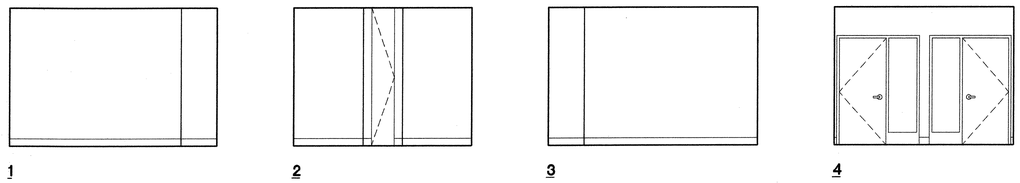

20J ISOLATION - 10/11
1/4" = 1'-0"

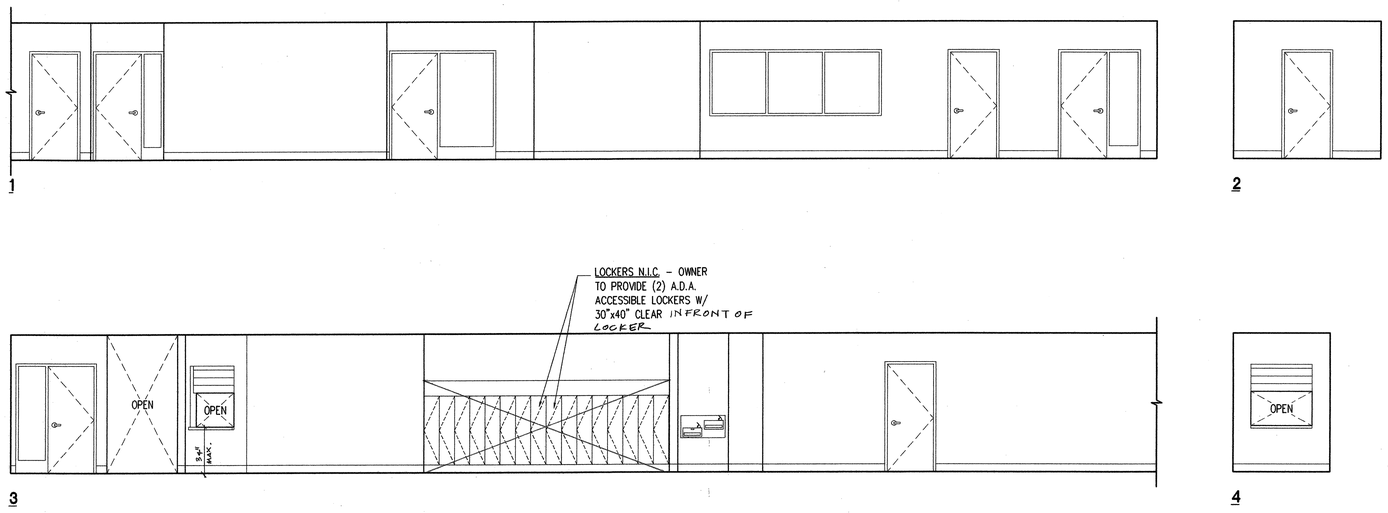

20A HALLWAY - 12
1/4" = 1'-0"

AS-BUILTS

REVISIONS: (△ INDICATES REVISIONS MADE TO THIS SHEET.)

NO.:	DATE	REASON	BY

ISSUE FOR PROGRESS REVIEW	01/15/01
ISSUE FOR PLAN CHECK	01/25/01
ISSUE FOR FINAL REVIEW	05/09/01
ISSUE FOR BID	
ISSUE FOR CONSTRUCTION	

SEAL:

LICENSED ARCHITECT
PAUL D. CIANFICHI
No. C-33110
REN. 10-31-03
STATE OF CALIFORNIA

ARCHITECT:
CONSULTANT:

CONSULTANT:

ARCHITECT:

CIANFICHI
ARCHITECTURE • PLANNING
30 ANNE COURT
WALNUT CREEK, CA. 94598
TEL.: (925) 256-8638
FAX.: (925) 256-8652

PROJECT:

CHILD DEVELOPMENT CENTER
CAÑADA COLLEGE

4200 FARM HILL BLVD.
REDWOOD CITY, CA 94061

SAN MATEO COUNTY COMMUNITY COLLEGE DISTRICT

STAMP:

APPL. NUMBER:

KEY PLAN/IDENTIFICATION STAMP
DIVISION OF THE STATE ARCHITECT
APPL 01 103529
AC CWP FLS. SS. Redate
DATE 5/9/01 5/21/01

SHEET TITLE:

INTERIOR ELEVATIONS

DRAWN BY: GL	PROJECT NO.: 304.99
CHECKED BY: BA	DATE: 01-25-2001
APPL NO.:	SHEET: A4.4
DATA NO.:	NO.: OF: