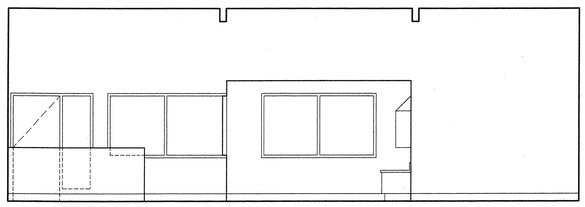

1

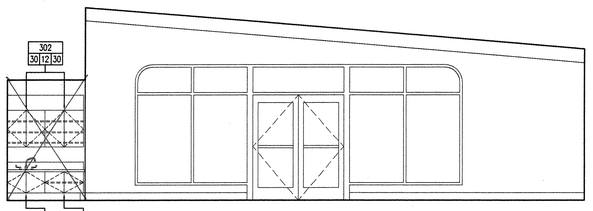

2

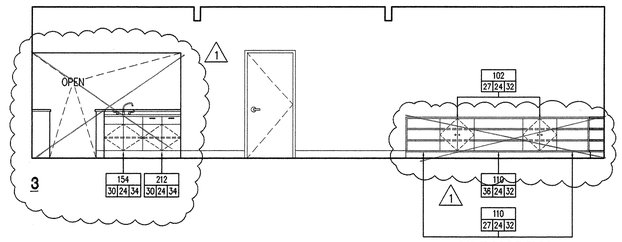

3

2 ADJUSTABLE SHELVES TYP.

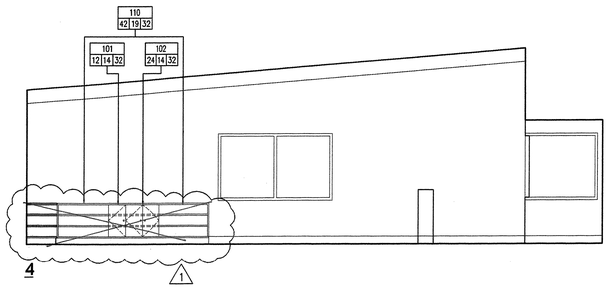

4

20J PRESCHOOLER - 28

1/4" = 1'-0"

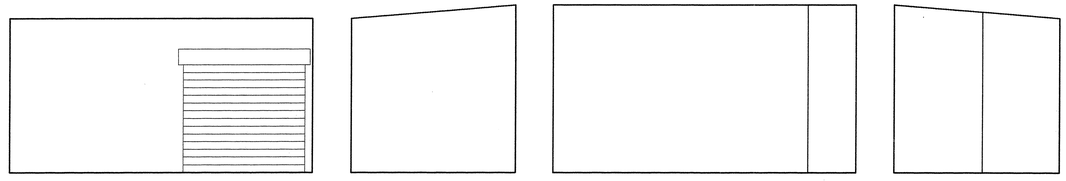

1 2 3 4

13J OUTDOOR STORAGE - 29

1/4" = 1'-0"

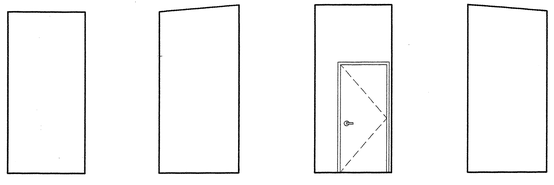

1 2 3 4

20E ELECTRICAL - 29A

1/4" = 1'-0"

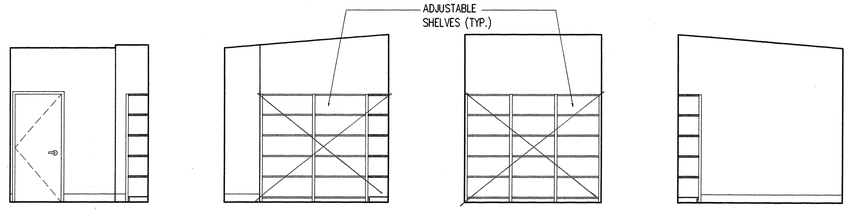

1 2 3 4

10E EQUIPMENT/STORAGE - 31

1/4" = 1'-0"

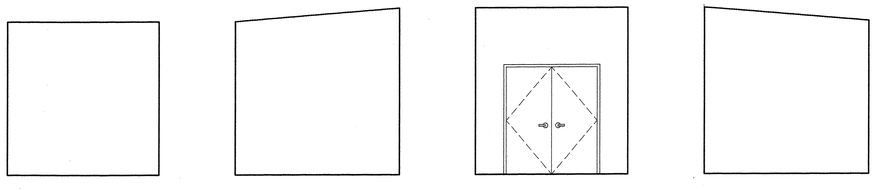

1 2 3 4

20A MECHANICAL - 33

1/4" = 1'-0"

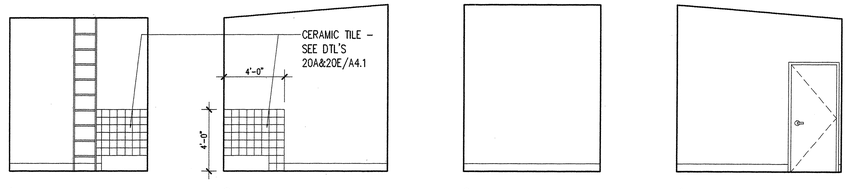

1 2 3 4

10A CUSTODIAN - 34

1/4" = 1'-0"

A4-7

REVISIONS: (△ INDICATES REVISIONS MADE TO THIS SHEET)			
NO.:	DATE	REASON	BY
1	10/15/01	ADDENDUM #1	
ISSUE FOR PROGRESS REVIEW			01/15/01
ISSUE FOR PLAN CHECK			01/25/01
ISSUE FOR FINAL REVIEW			05/09/01
ISSUE FOR BID			
ISSUE FOR CONSTRUCTION			

SEAL:

LICENSED ARCHITECT
ANN B. CIANFICHI
No. C-24510
EXP. REN. 10-31-01
STATE OF CALIFORNIA

ARCHITECT:
CONSULTANT:

CONSULTANT:

ARCHITECT:

CIANFICHI
ARCHITECTURE • PLANNING

30 ANNE COURT
WALNUT CREEK, CA. 94598
TEL.: (925) 256-8638
FAX.: (925) 256-8652

PROJECT:

CHILD DEVELOPMENT CENTER
CAÑADA COLLEGE

4200 FARM HILL BLVD.
REDWOOD CITY, CA 94061

SAN MATEO COUNTY COMMUNITY COLLEGE DISTRICT

STAMP:

APPROVED
DIV OF THE STATE ARCHITECT

AC BR F/LS BM SS MT

APPL NO. 01-103525 DATE 3/5/02

APPL. NUMBER:

KEY PLAN:

AS-BUILTS

SHEET TITLE:

INTERIOR ELEVATIONS

DRAWN BY:	PROJECT NO.:
GL	304.99
CHECKED BY:	DATE:
BA	01-25-2001
APPL NO.:	SHEET:
DATA NO.:	A4.8a
	NO.: OF: