RFP-39

FCD - 47
FILE NO. 43-C1
APPL.NO. 01-110074
EXHIBIT 31 PHASE 3

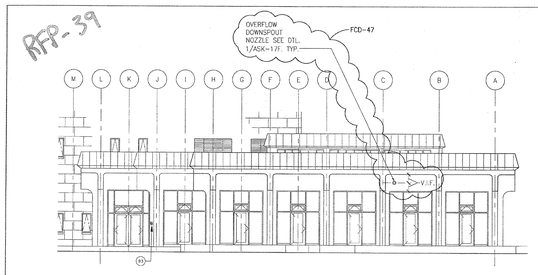

1 NORTH ELEVATION
REF. 1/A5.1

SCALE: 1/8" = 1'-0"

BC|A
architecture
planning
interiors
1901 Broadway
San Jose, California 95125
(408) 293-8300
(F) 293-8302
www.bcarchitects.com

Title:
NEW OVERFLOW DRAIN

Project Name:
CATAÑA COLLEGE – BUILDINGS 5 & 6 RENOVATIONS
SAN MATEO COUNTY COMMUNITY COLLEGE DISTRICT
FILE NO. 43-C1 APPL. 01-110074
4200 FARM HILL BOULEVARD
REDWOOD CITY, CA 94061

Revision:
FCD No.
47

Date:
07/11/02
Drawing Number:
Scale:
AS NOTED
Project Number:
2002
ASK- 17B

RFP-39

FCD - 47
FILE NO. 43-C1
APPL.NO. 01-110074
EXHIBIT 31 PHASE 3

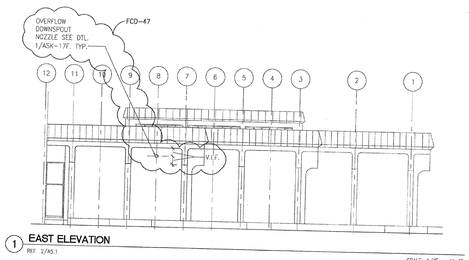

1 EAST ELEVATION
REF. 2/A5.1

SCALE: 1/8" = 1'-0"

BC|A
architecture
planning
interiors
1901 Broadway
San Jose, California 95125
(408) 293-8300
(F) 293-8302
www.bcarchitects.com

Title:
NEW OVERFLOW DRAIN

Project Name:
CATAÑA COLLEGE – BUILDINGS 5 & 6 RENOVATIONS
SAN MATEO COUNTY COMMUNITY COLLEGE DISTRICT
FILE NO. 43-C1 APPL. 01-110074
4200 FARM HILL BOULEVARD
REDWOOD CITY, CA 94061

Revision:
FCD No.
47

Date:
07/11/02
Drawing Number:
Scale:
AS NOTED
Project Number:
2002
ASK- 17C