


DOOR SCHEDULE

NO.	DOOR	SILL	FRAME	REMARKS								
OPN'G NUM. L.	DOOR TYPE	OPN'G SIZE	THICKNESS	MATL	LACE	HAUL WANCE	MATL	DET.	MATL	JAMB DET.	HEAD DET.	
1/A	H	80" x 70"	1 3/4"	VD.		15			MET.	3"	3"	
2/A	E	80" x 70"	1 3/4"	VD.		15			MET.	3"	3"	WEATHERSTRIP FRAME, AUTO. DOOR BOTTOM LOUVER: 24" x 12"
3/A	A	80" x 70"	1 3/4"	VD.		9			MET.	3"	3"	
4/A	A	26" x 70"	1 3/4"	VD.		15			MET.	3"	3"	
5/A	A	26" x 70"	1 3/4"	VD.		9			MET.	3"	3"	
6/A	H	80" x 70"	1 3/4"	VD.		15			MET.	3"	3"	
7/A	J	80" x 70"	1 3/4"	VD.		21			MET.	3"	3"	
8/A	A	80" x 70"	1 3/4"	VD.		13			MET.	3"	3"	
9/A	A	80" x 70"	1 3/4"	VD.		13			MET.	3"	3"	
10/A	J	80" x 70"	1 3/4"	VD.		18			MET.	3"	3"	
11/A	A	80" x 70"	1 3/4"	VD.		15			MET.	3"	3"	
12/A	A	80" x 70"	1 3/4"	VD.		15			MET.	3"	3"	
13/A	A	80" x 70"	1 3/4"	VD.		15			MET.	3"	3"	
14/A	J	80" x 70"	1 3/4"	VD.		18			MET.	3"	3"	
15/A	A	80" x 70"	1 3/4"	VD.		13			MET.	3"	3"	
16/A	A	80" x 70"	1 3/4"	VD.		15			MET.	3"	3"	
17/A	H	80" x 70"	1 3/4"	VD.		15			MET.	3"	3"	
18/A	H	80" x 70"	1 3/4"	VD.		15			MET.	3"	3"	
19/A	H	80" x 70"	1 3/4"	VD.		15			MET.	3"	3"	
20/A	H	80" x 70"	1 3/4"	VD.		15			MET.	3"	3"	LOWERS: 20" x 10" - FUSE LINK
21/A	A	26" x 70"	1 3/4"	VD.		20			MET.	3"	3"	LOWERS: 20" x 10" - FUSE LINK
22/A	A	26" x 70"	1 3/4"	VD.		20			MET.	3"	3"	LOWERS: 20" x 10" - FUSE LINK
23/A	A	26" x 70"	1 3/4"	VD.		6			MET.	3"	3"	
24/A	A	26" x 70"	1 3/4"	VD.		18			MET.	3"	3"	LOWERS: 24" x 10" - FUSE LINK
25/A	A	26" x 70"	1 3/4"	VD.		15			MET.	3"	3"	LOWERS: 24" x 10" - FUSE LINK
26/A	A	26" x 70"	1 3/4"	VD.		10			MET.	3"	3"	
27/A	A	26" x 70"	1 3/4"	VD.		19			MET.	3"	3"	LOWERS: 25" x 10"
28/A	A	26" x 70"	1 3/4"	VD.		10			MET.	3"	3"	
29/A	A	26" x 70"	1 3/4"	VD.		18			MET.	3"	3"	LOWERS: 24" x 10"
30/A	A	26" x 70"	1 3/4"	VD.		6			MET.	3"	3"	LOWERS: 24" x 10"
31/A	A	26" x 70"	1 3/4"	VD.		15			MET.	3"	3"	
32/A	H	80" x 70"	1 3/4"	VD.		15			MET.	3"	3"	
33/A	H	80" x 70"	1 3/4"	VD.		15			MET.	3"	3"	
34/A	H	80" x 70"	1 3/4"	VD.		15			MET.	3"	3"	
35/A	H	80" x 70"	1 3/4"	VD.		15			MET.	3"	3"	
36/A	H	80" x 70"	1 3/4"	VD.		15			MET.	3"	3"	
37/A	A	26" x 70"	1 3/4"	VD.		25			MET.	3"	3"	
38/A	A	26" x 70"	1 3/4"	VD.		25			MET.	3"	3"	
39/A	A	26" x 70"	1 3/4"	VD.		6			MET.	3"	3"	
40/A	A	26" x 70"	1 3/4"	VD.		6			MET.	3"	3"	
41/A	A	26" x 70"	1 3/4"	VD.		6			MET.	3"	3"	
42/A	A	26" x 70"	1 3/4"	VD.		6			MET.	3"	3"	

ROOM FINISH SCHEDULE

ROOM NO.	FINISH	FLOOR	BASE	WAINSCOT	WALLS	CEILING	REMARKS
NO.	NO.	NO.	NO.	NO.	NO.	NO.	
427	JANITORY	CONC.	HEBR.	R	PLAS. GLOSS	SEMI-GLOSS	* SEE LATH & PLAS. EACH SIDE OF PARTITIONS
428	ELEVATOR	VAT.	WAX	R	PLAS. GLOSS	SEMI-GLOSS	WALLS TO UNDERSIDE OF STRUCT. SLAB ABOVE SEE 10
429	WOMEN	CERT.	GR.T.	GR.T.	PLAS. GLOSS	SEMI-GLOSS	
430	WOMEN	CERT.	GR.T.	GR.T.	PLAS. GLOSS	SEMI-GLOSS	* ACT. ABOVE CERT.
431	EQUIPMENT	CERT.	GR.T.	GR.T.	PLAS. GLOSS	SEMI-GLOSS	* ACT. ABOVE CERT.
432	MEN	CERT.	GR.T.	GR.T.	PLAS. GLOSS	SEMI-GLOSS	
433	MEN	CERT.	GR.T.	GR.T.	PLAS. GLOSS	SEMI-GLOSS	* ACT. ABOVE CERT.
434	OFFICE	VAT.	WAX	R	PLAS. GLOSS	SEMI-GLOSS	
435	LABORATORY	VAT.	WAX	R	PLAS. GLOSS	SEMI-GLOSS	
436	LABORATORY	VAT.	WAX	R	PLAS. GLOSS	SEMI-GLOSS	
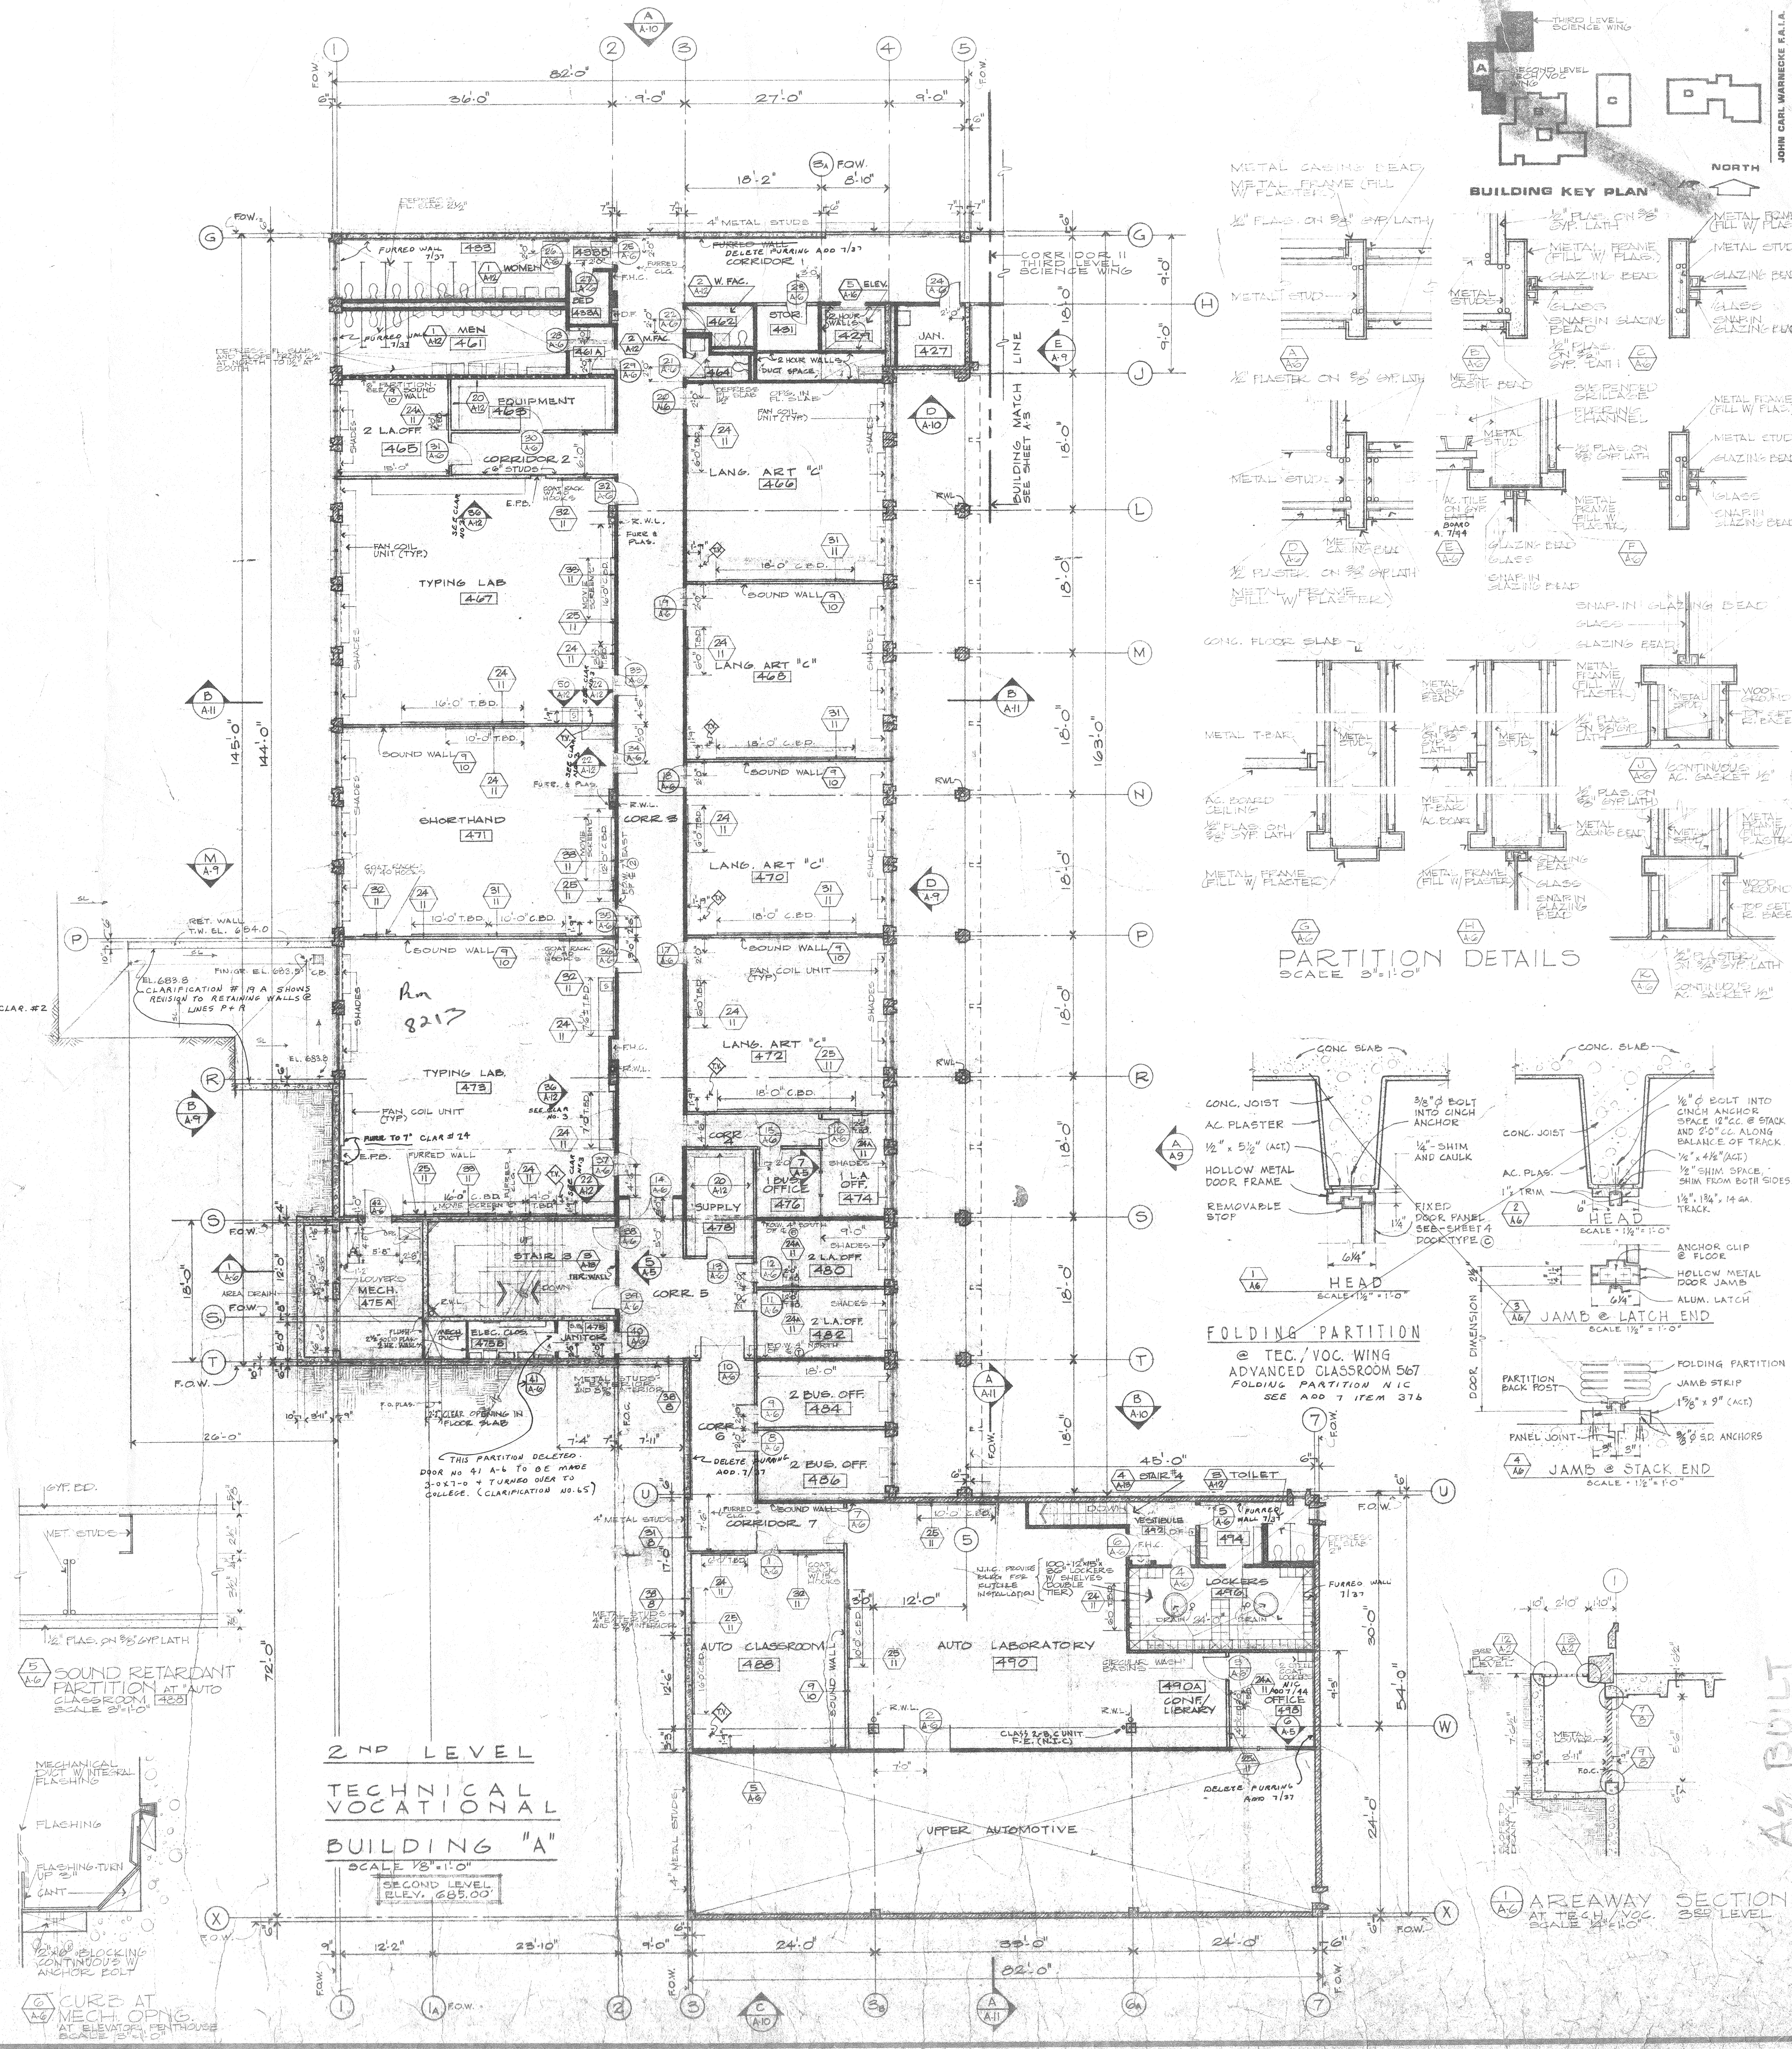

JOHN CARL WARNECKE AND ASSOCIATES
 ARCHITECTS AND PLANNING CONSULTANTS
 81 NEW MONTGOMERY STREET
 SAN FRANCISCO

LEADER THOMPSON
 STRUCTURAL ENGINEER
 D. KELLER & GARRON
 ELECTRICAL ENGINEERS
 J. CARL WARNECKE
 CIVIL ENGINEER

DATE: 1/16/67
 SCALE: AS NOTED
 JOB NO. 64-118
 CHECK BY: E.F.J.
 SHEET NUMBER: 16
 OF 25 SHEETS
 REVISION NO.

BUILDING A
 TECH. VOC. 2ND LEVEL PLAN - FINISH & DOOR SCHEDULE
 COLLEGE OF SAN MATEO
 SAN BRUNO, CALIFORNIA

DATE: 1/16/67
 SCALE: AS NOTED
 JOB NO. 64-118
 CHECK BY: E.F.J.
 SHEET NUMBER: 16
 OF 25 SHEETS
 REVISION NO.