


RFP-62

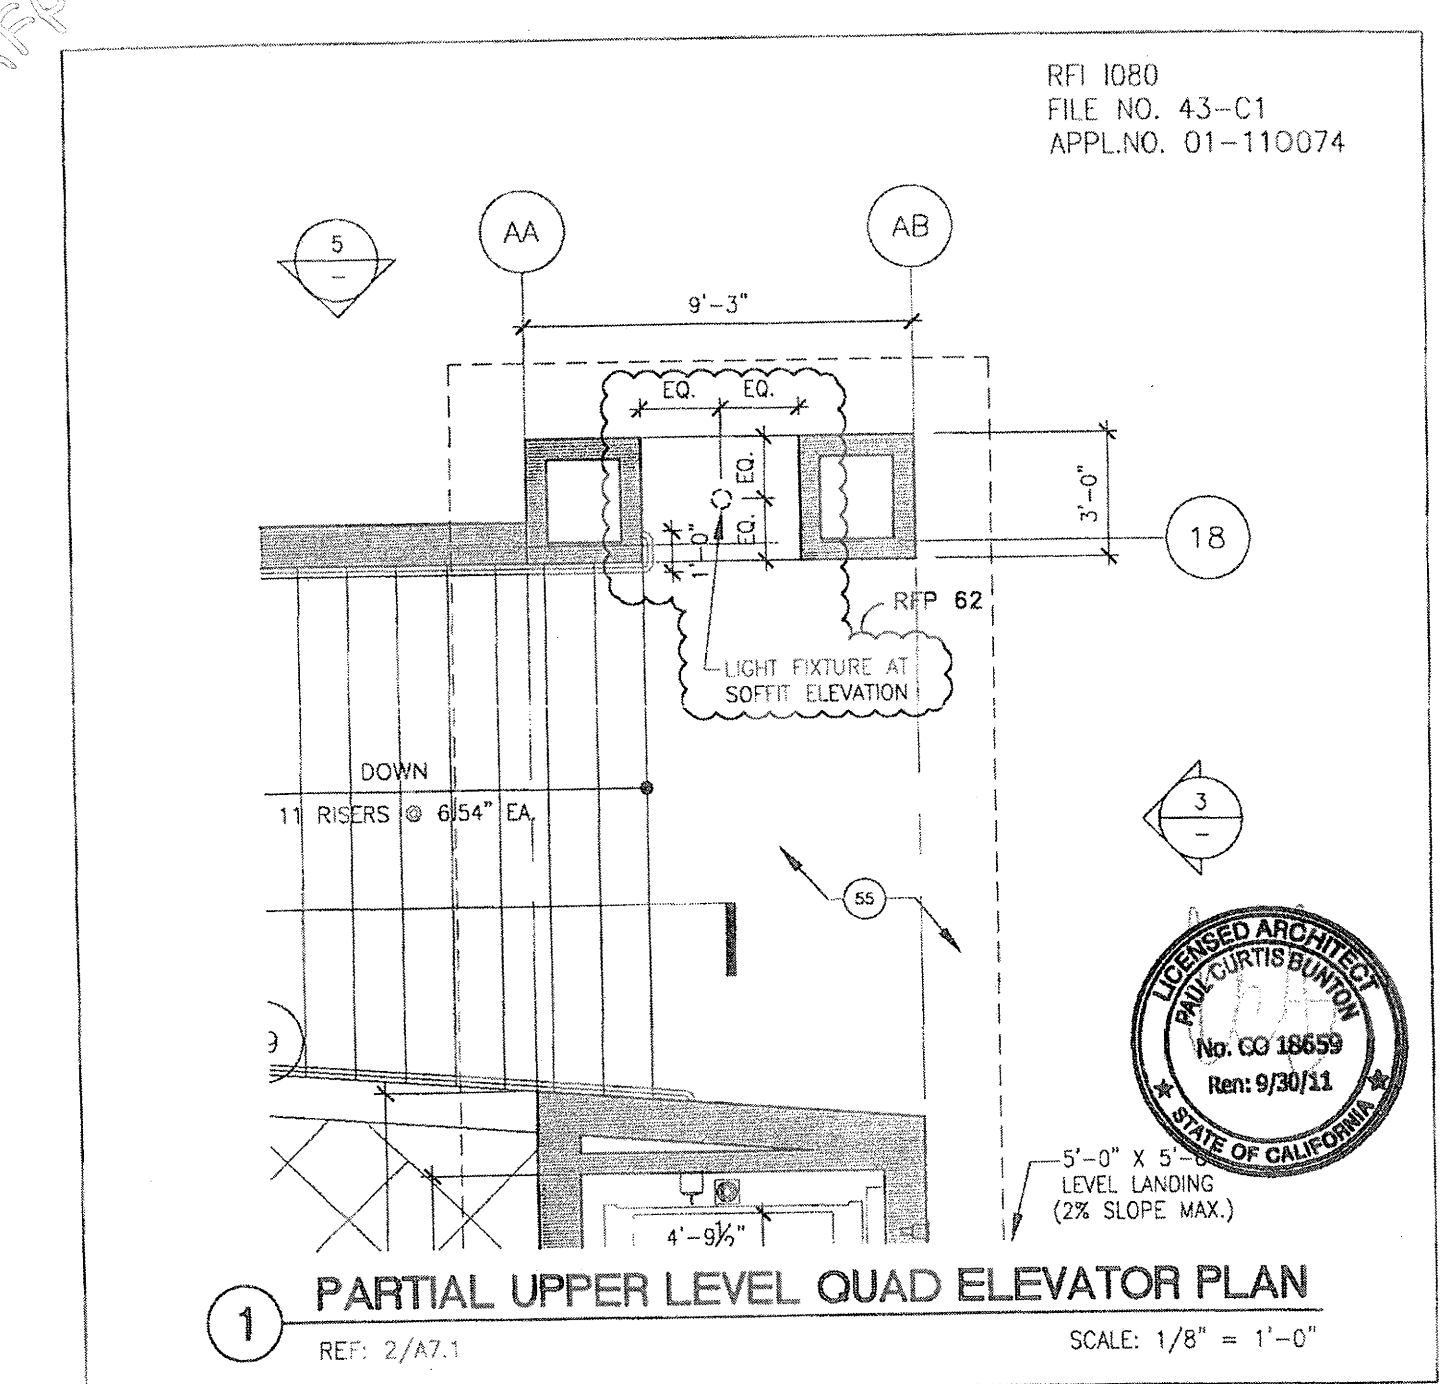

BCA architecture planning interiors	Project Name: CANADA COLLEGE - BUILDINGS 5 & 6 RENOVATIONS SAN MATEO COUNTRY COMMUNITY COLLEGE DISTRICT 4200 FARM HILL BOULEVARD REDWOOD CITY, CA 94061 111 424-0000 111 424-0005	Sheet:	REF 1080
		Drawn By:	ASK-28
111 424-0000 111 424-0005		Project Number:	0189