

**RFP-18**

RFP 18  
FILE NO. 43-C1  
APPL. NO. 01-110074

**1 WALL TYPE P3**  
REF: A10.51 SCALE: 1-1/2" = 1'-0"


**2 WALL TYPE P6**  
REF: NEW DETAIL SCALE: 1-1/2" = 1'-0"

**INTERIOR PLUMBING WALL - 1 HR. RATED**  
1/4" CERAMIC TILE ON LATEX THINSET ADHESIVE INSTALLED OVER (2) LAYERS 5/8" TYPE "X" MOISTURE-RESISTANT CYP. BD. OVER 6" STUDS 16 GA AT 16" O.C. TYP. ON THE RESTROOM SIDE, AND (1) LAYER 5/8" TYPE "X" CYP. BD. ON THE OTHER SIDE. INSTALL ALL CYP. BD. TO UNDERSIDE OF DECK ABOVE. SOUND INSULATION IN STUD CAVITY, U.O.A.  
GA FILE #MP 1072  
HEAD DETAIL: 16/A10.52  
SILL DETAIL: 16/ASK-10 RFP 18

**INTERIOR PLUMBING WALL - 1 HR. RATED**  
1/4" CERAMIC TILE ON LATEX THINSET ADHESIVE INSTALLED OVER (1) LAYER 5/8" TYPE "X" MOISTURE-RESISTANT CYP. BD. OVER 4" STUDS 16 GA AT 16" O.C. O/1" AIR GAP ADJACENT TO (E) CONC. WALL. INSTALL ALL CYP. BD. TO UNDERSIDE OF DECK ABOVE. SOUND INSULATION IN STUD CAVITY, U.O.A.  
HEAD DETAIL: 16/A10.52  
SILL DETAIL: 16/A10.52

**BCA** ARCHITECTURE PLANNING & INTERIORS  
PROJECT NAME: CARADA COLLEGE - BUILDINGS 5 & 6 RENOVATIONS  
SAN MATEO COUNTY COMMUNITY COLLEGE DISTRICT  
FILE NO. 43-C1 APPL. 01-110074  
4200 FARM HILL BOULEVARD  
REDWOOD CITY, CA 94061

REVISION: RFI113  
DATE: 02/27/20  
STATUS: AS NOTED  
PROJECT NUMBER: ASK-100

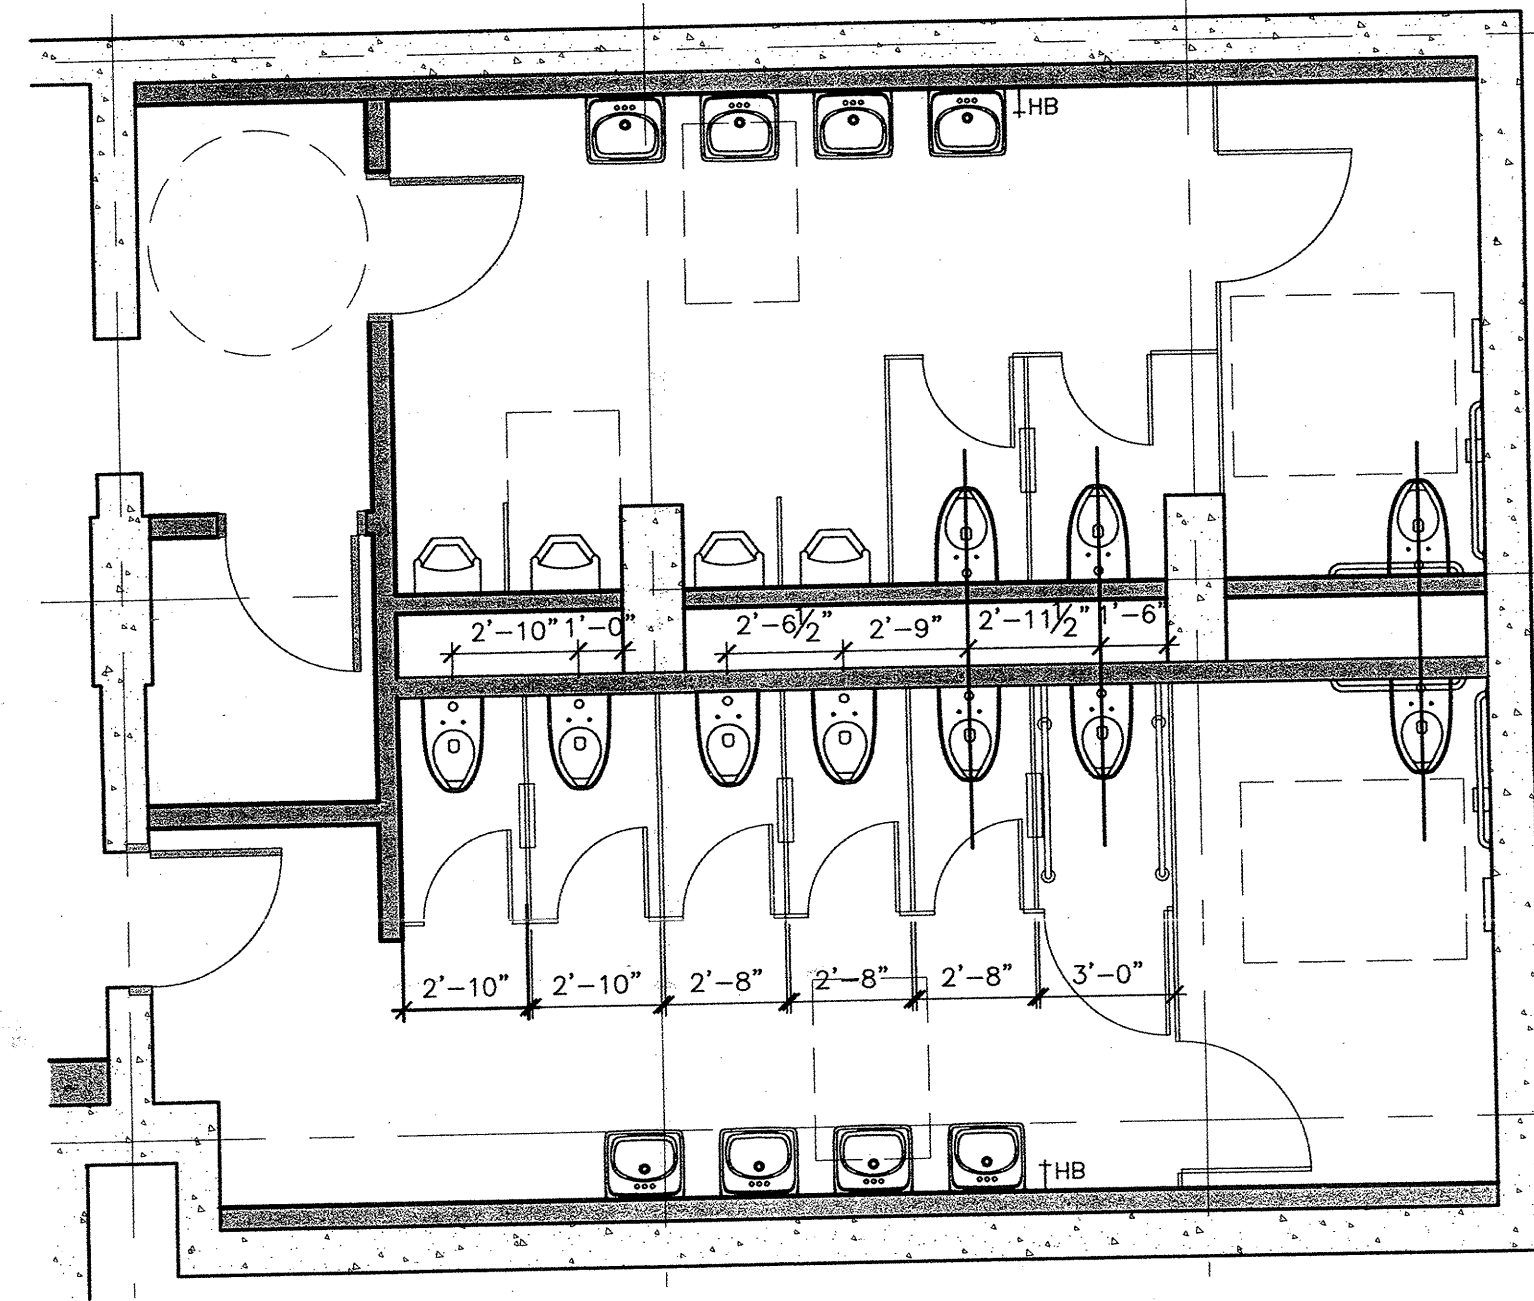

**ASX-12**

RFP 18  
FILE NO. 43-C1  
APPL. NO. 01-110074

**1 FIRST FLR. RESTRM. ENLARGED PLAN**  
REF: 1/2/2 SCALE: 1/4" = 1'-0"

**BCA** ARCHITECTURE PLANNING & INTERIORS  
PROJECT NAME: CARADA COLLEGE - BUILDINGS 5 & 6 RENOVATIONS  
SAN MATEO COUNTY COMMUNITY COLLEGE DISTRICT  
FILE NO. 43-C1 APPL. 01-110074  
4200 FARM HILL BOULEVARD  
REDWOOD CITY, CA 94061

REVISION: RFI112  
DATE: 02/27/20  
STATUS: AS NOTED  
PROJECT NUMBER: ASK-11

**RFP-18**

RFP 18  
FILE NO. 43-C1  
APPL. NO. 01-110074

**1 FIRST FLR. RESTRM. ENLARGED PLAN**  
REF: 1/2/2 SCALE: 1/4" = 1'-0"

**BCA** ARCHITECTURE PLANNING & INTERIORS  
PROJECT NAME: CARADA COLLEGE - BUILDINGS 5 & 6 RENOVATIONS  
SAN MATEO COUNTY COMMUNITY COLLEGE DISTRICT  
FILE NO. 43-C1 APPL. 01-110074  
4200 FARM HILL BOULEVARD  
REDWOOD CITY, CA 94061

REVISION: RFI113  
DATE: 02/27/20  
STATUS: AS NOTED  
PROJECT NUMBER: ASK-10A

**RFP-18**

RFP 18  
FILE NO. 43-C1  
APPL. NO. 01-110074

**1 WALL BASE**  
REF: NEW DETAIL SCALE: 1-1/2" = 1'-0"

**NOTE: PERFORM REBAR SCANS AND DO NOT CUT OR DAMAGE REBARS**

CERAMIC TILE  
THIN SET  
5/8" TYPE "X", M.R. CYP. BD.  
INSULATION  
FIRE RESISTANT SEALANT  
6" TILE BASE  
FLOOR TILE  
MORTAR BED  
DEPRESSED SLAB  
SAW CUT & PROVIDE DUNBELL PVC WATERSTOP  
BENTONITE WATERSTOP @ COLD JOINT

VARIES - SEE PLAN

SEE 9.2L/59.2 FOR BASE CONNECTION

09\_WLBS\_14

**BCA** ARCHITECTURE PLANNING & INTERIORS  
PROJECT NAME: CARADA COLLEGE - BUILDINGS 5 & 6 RENOVATIONS  
SAN MATEO COUNTY COMMUNITY COLLEGE DISTRICT  
FILE NO. 43-C1 APPL. 01-110074  
4200 FARM HILL BOULEVARD  
REDWOOD CITY, CA 94061

REVISION: RFI113  
DATE: 02/27/20  
STATUS: AS NOTED  
PROJECT NUMBER: ASK-10F

**RFP-18**

RFP 18  
FILE NO. 43-C1  
APPL. NO. 01-110074

**1 FURRED WALL BASE**  
REF: 18/A10.52 SCALE: 1-1/2" = 1'-0"

**NOTE: PERFORM REBAR SCANS AND DO NOT CUT OR DAMAGE REBARS**

(E) CONCRETE WALL  
SEE SHEET A7.2 FOR WALL TYPE  
SEE 9.2L/59.2 FOR BASE CONNECTION  
#4 REBAR, CONT.  
INT. FINISHES - SEE SCHEDULE ON SHEET A9.1  
(N) CONC. CURB  
#4 REBAR @ 18" O.C. EPOXY INTO (E) SLAB. SEE NOTE.

09\_WLBS\_05

**BCA** ARCHITECTURE PLANNING & INTERIORS  
PROJECT NAME: CARADA COLLEGE - BUILDINGS 5 & 6 RENOVATIONS  
SAN MATEO COUNTY COMMUNITY COLLEGE DISTRICT  
FILE NO. 43-C1 APPL. 01-110074  
4200 FARM HILL BOULEVARD  
REDWOOD CITY, CA 94061

REVISION: RFI113  
DATE: 02/27/20  
STATUS: AS NOTED  
PROJECT NUMBER: ASK-10E

**RFP-18**

RFP 18  
FILE NO. 43-C1  
APPL. NO. 01-110074

**1 SECOND FLOOR RESTROOM ENLARGED PLAN**  
REF: 2/2/2 SCALE: 1/4" = 1'-0"

**BCA** ARCHITECTURE PLANNING & INTERIORS  
PROJECT NAME: CARADA COLLEGE - BUILDINGS 5 & 6 RENOVATIONS  
SAN MATEO COUNTY COMMUNITY COLLEGE DISTRICT  
FILE NO. 43-C1 APPL. 01-110074  
4200 FARM HILL BOULEVARD  
REDWOOD CITY, CA 94061

REVISION: RFI113  
DATE: 02/27/20  
STATUS: AS NOTED  
PROJECT NUMBER: ASK-10B

**RFP-18**

RFP 18  
FILE NO. 43-C1  
APPL. NO. 01-110074

**1 THIRD FLOOR RESTROOM ENLARGED PLAN**  
REF: 3/2/2 SCALE: 1/4" = 1'-0"

**BCA** ARCHITECTURE PLANNING & INTERIORS  
PROJECT NAME: CARADA COLLEGE - BUILDINGS 5 & 6 RENOVATIONS  
SAN MATEO COUNTY COMMUNITY COLLEGE DISTRICT  
FILE NO. 43-C1 APPL. 01-110074  
4200 FARM HILL BOULEVARD  
REDWOOD CITY, CA 94061

REVISION: RFI113  
DATE: 02/27/20  
STATUS: AS NOTED  
PROJECT NUMBER: ASK-10C