


DOOR SCHEDULE										
NO.	SYMBOL	DOOR TYPE	OPNG. SIZE	THICK. IN.	MATL.	LABEL	HARDWARE	MATL.	DET.	REMARKS
1A/7	(1)	8070	2'	ALUM.	59	ALUM.	59	ALUM.	(1)	
1B/7	(1)	8070	2'	ALUM.	60	ALUM.	59	ALUM.	(1)	
1C/7	(1)	8070	2'	ALUM.	60	ALUM.	59	ALUM.	(1)	
1D/7	(1)	8070	2'	ALUM.	54	ALUM.	59	ALUM.	(1)	
1E/7	(1)	8070	2'	ALUM.	59	ALUM.	59	ALUM.	(1)	
1F/7	(1)	8070	2'	ALUM.	59	ALUM.	59	ALUM.	(1)	
ROOM FINISH SCHEDULE										
NO.	SYMBOL	FLOOR	BASE	WAINSCOT	WALLS	CEILING	REMARKS			
501	(1)	VAT. WAX	R		PLAS. SEMI-GLOSS	SPRAT. AC. T.				

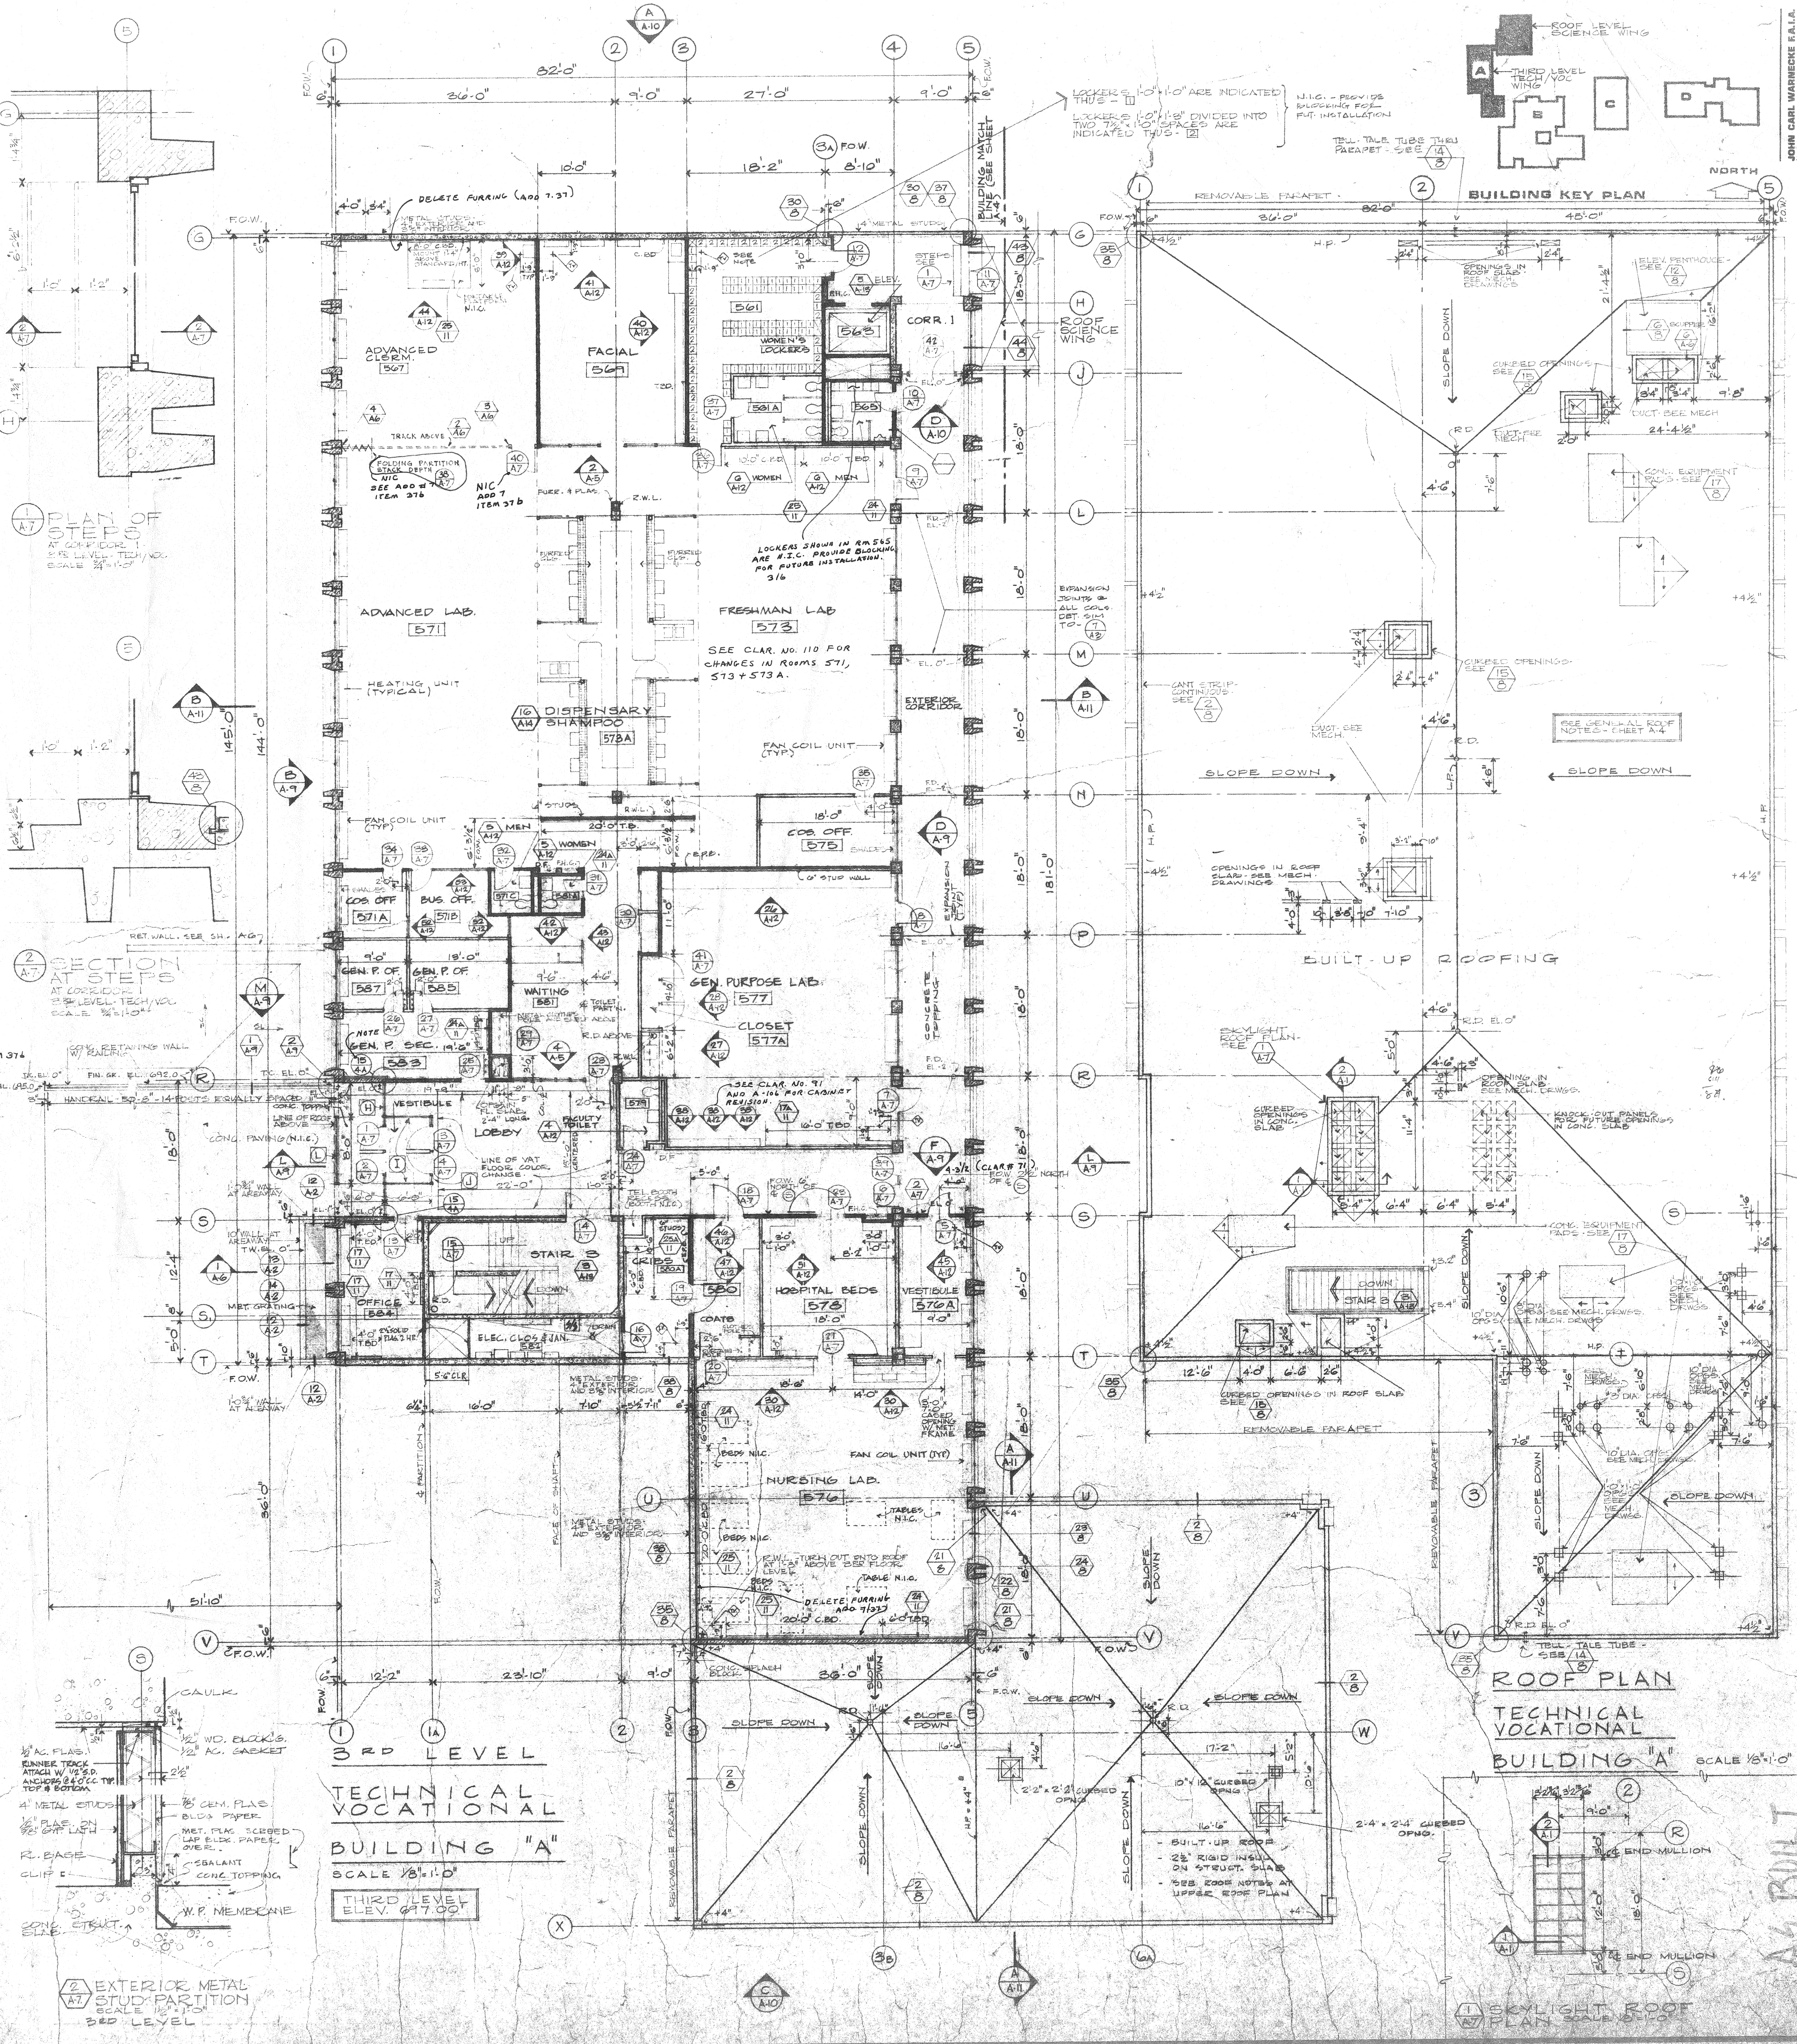

**JOHN CARL WARWECHE AND ASSOCIATES**  
**ARCHITECTS AND PLANNING CONSULTANTS**  
 61 NEW MONTGOMERY STREET  
 SAN FRANCISCO

**COLLEGE OF SAN MATEO**  
 SAN BRUNO, CALIFORNIA

**BUILDING A** SCIENCE, TECH/VOC.  
 TECH. 301: 3RD LEVEL & ROOF PLAN - FIN. & DOOR SCHEDULE

SCALE AS NOTED  
 JOB NO. 64-16  
 D.B. & E.F.  
 CHECKED  
 DATE: 11/16/67  
 NO. REVISION DESCRIPTION DATE APPROVED

OF 22 SHEETS  
 REVISION NO.