

**BCA** architecture  
planning  
interiors


**BCA** architecture  
planning  
interiors

**THE SIGNAGE RELOCATION**

Project Name: CANADA COLLEGE - BUILDINGS 5 & 6 RENOVATIONS  
SAN MATEO COUNTY COMMUNITY COLLEGE DISTRICT  
4200 FARM HILL BOULEVARD  
REDWOOD CITY, CA 94061  
FILE NO. 43-C1 APPL. 01-110074

Date: 09/01/11  
Scale: AS NOTED  
Project Number: 0703

ASK-36B

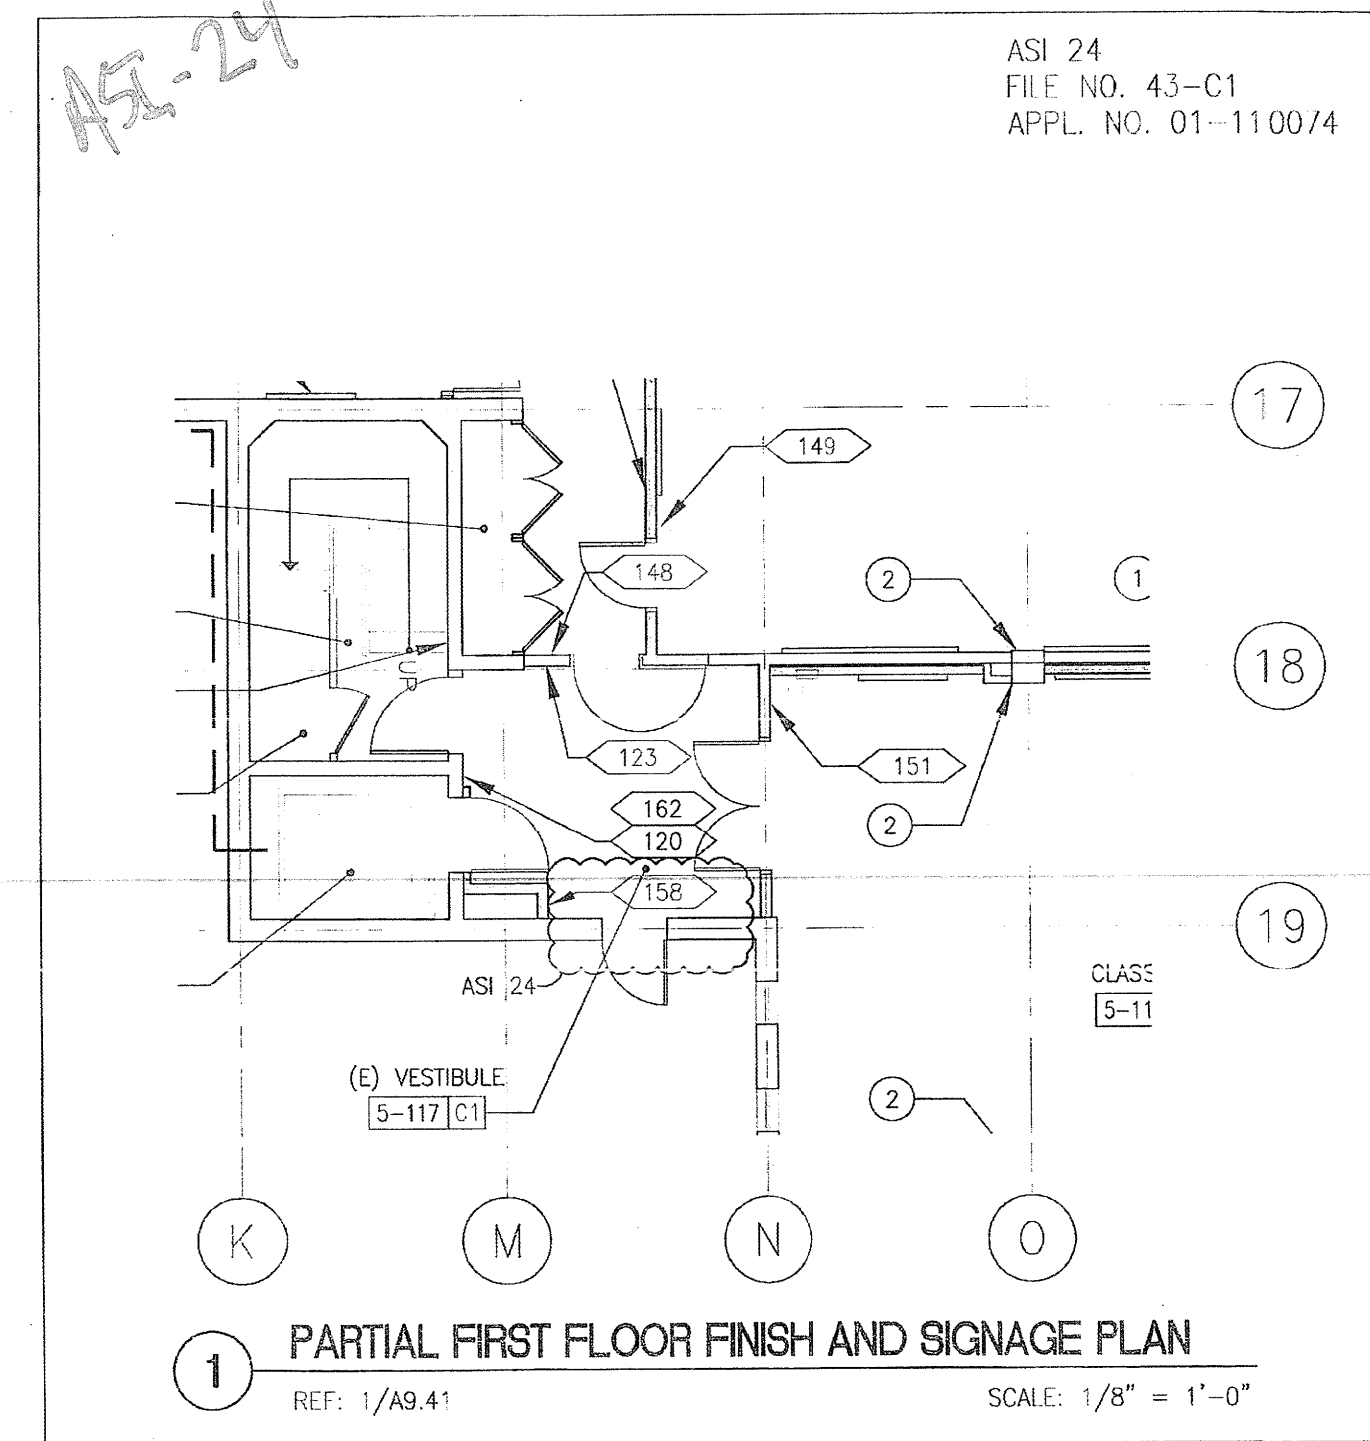

**BCA** architecture  
planning  
interiors


**BCA** architecture  
planning  
interiors

**THE SIGNAGE RELOCATION**

Project Name: CANADA COLLEGE - BUILDINGS 5 & 6 RENOVATIONS  
SAN MATEO COUNTY COMMUNITY COLLEGE DISTRICT  
4200 FARM HILL BOULEVARD  
REDWOOD CITY, CA 94061  
FILE NO. 43-C1 APPL. 01-110074

Date: 09/01/11  
Scale: AS NOTED  
Project Number: 0703

ASK-36DR

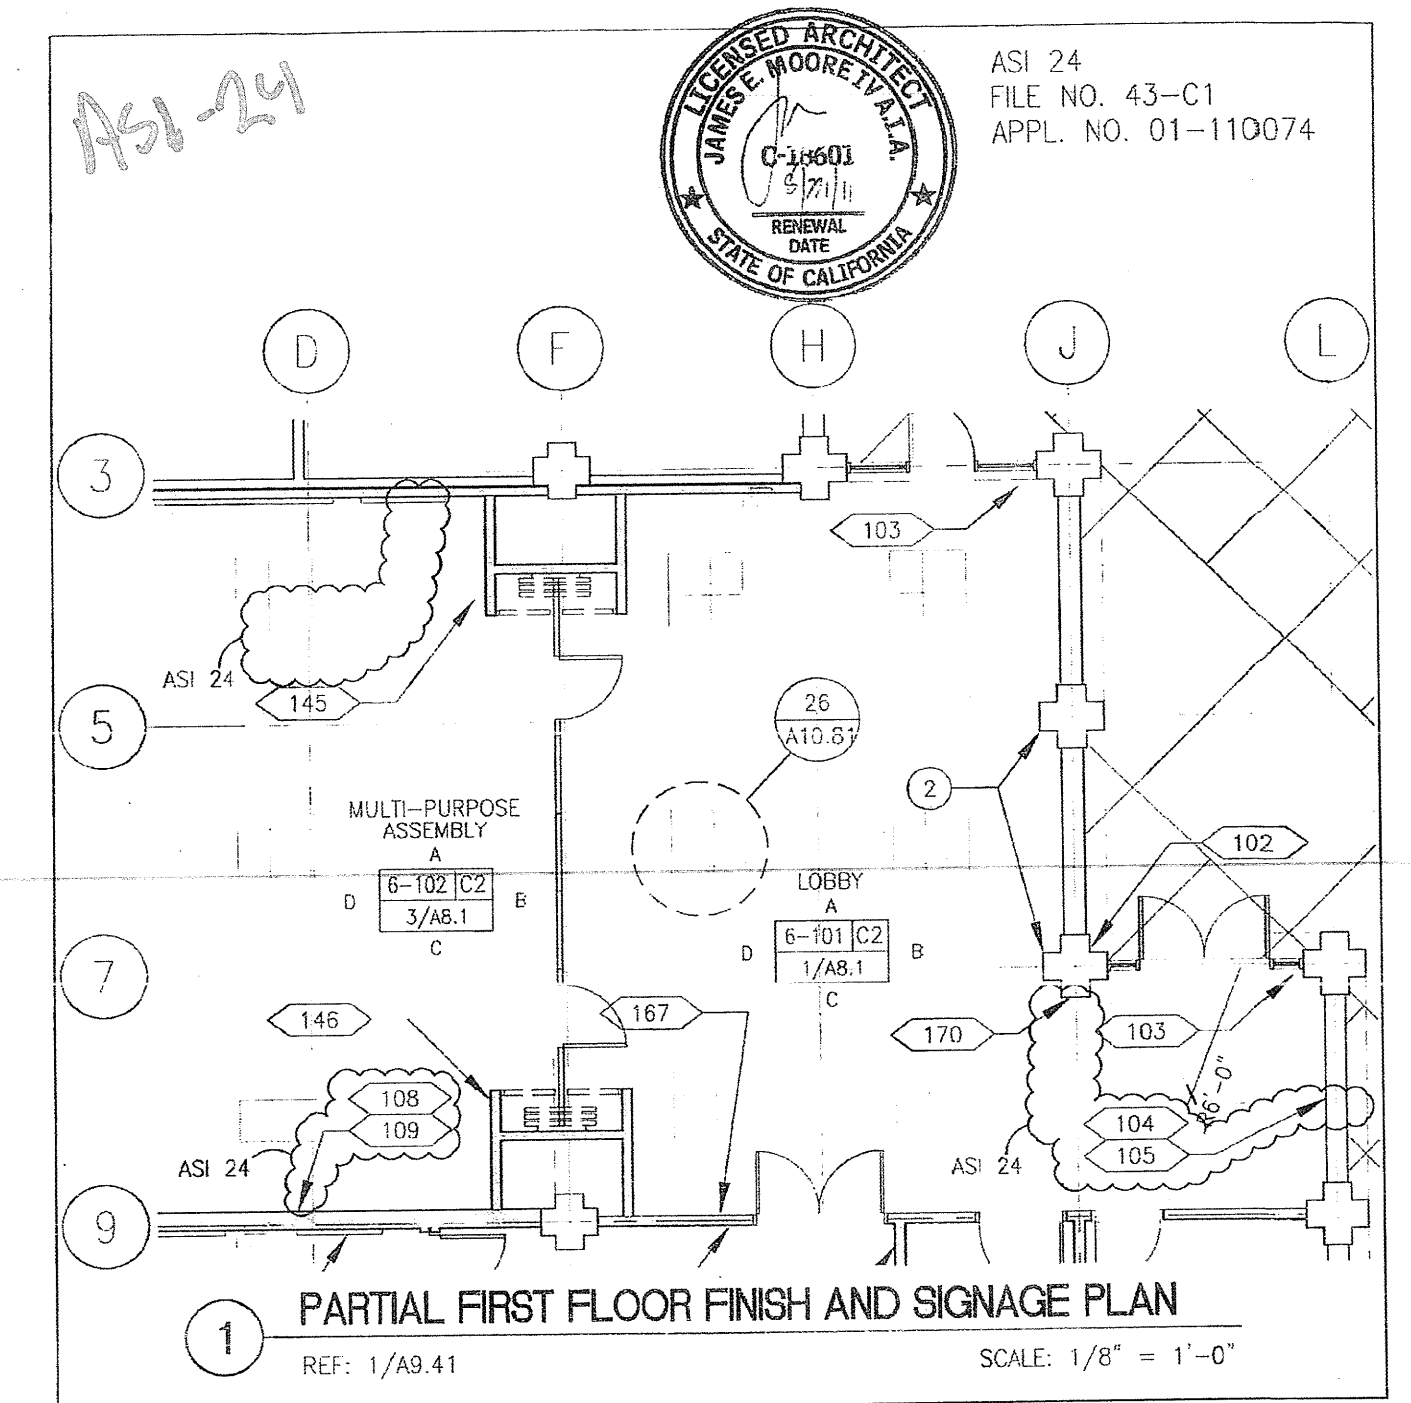

**BCA** architecture  
planning  
interiors

**BCA** architecture  
planning  
interiors

**THE SIGNAGE RELOCATION**

Project Name: CANADA COLLEGE - BUILDINGS 5 & 6 RENOVATIONS  
SAN MATEO COUNTY COMMUNITY COLLEGE DISTRICT  
4200 FARM HILL BOULEVARD  
REDWOOD CITY, CA 94061  
FILE NO. 43-C1 APPL. 01-110074

Date: 09/01/11  
Scale: AS NOTED  
Project Number: 0703

ASK-36A

