




17 CEILING AT WALL SECTION 3'-1-0"

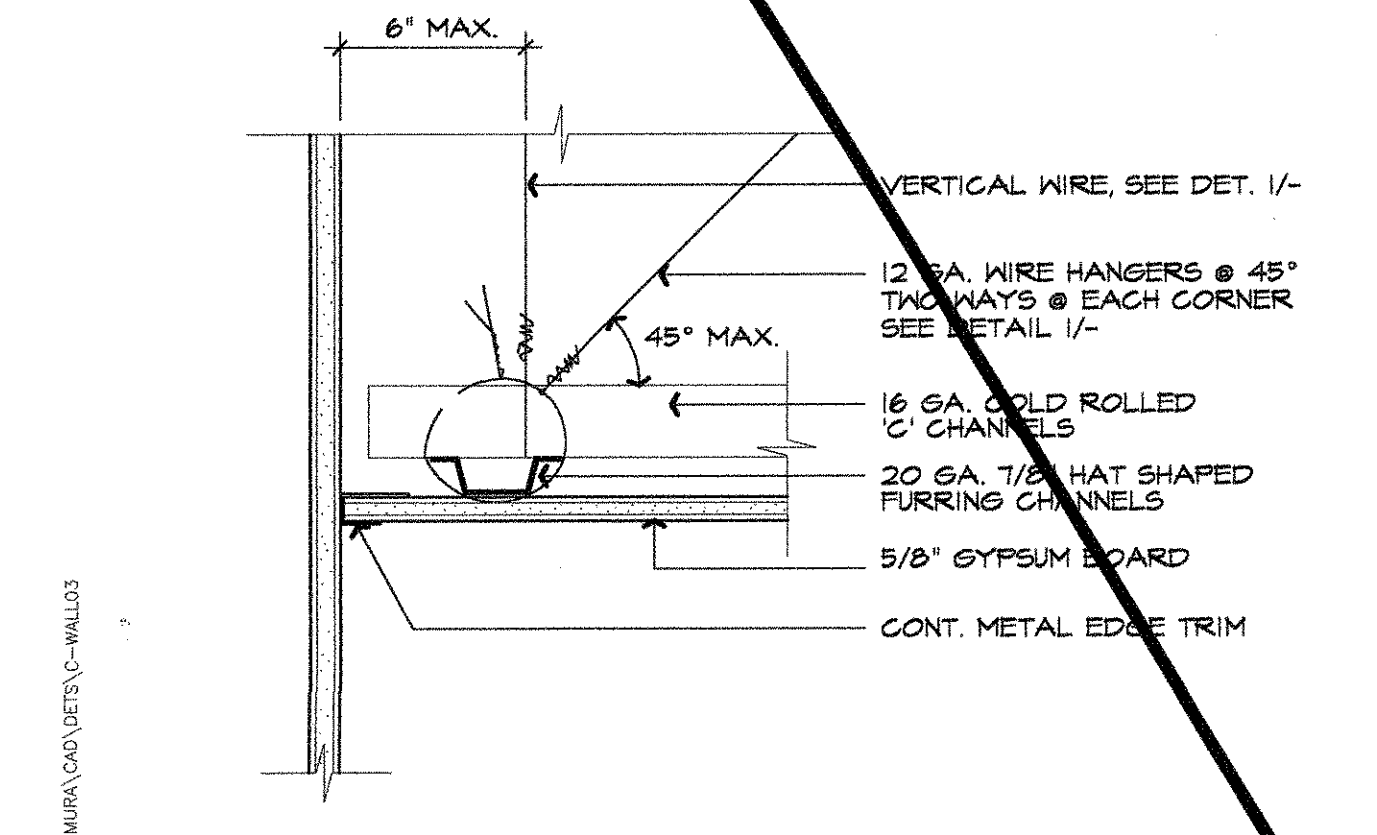


18 CEILING AT WALL SECTION 3'-1-0"

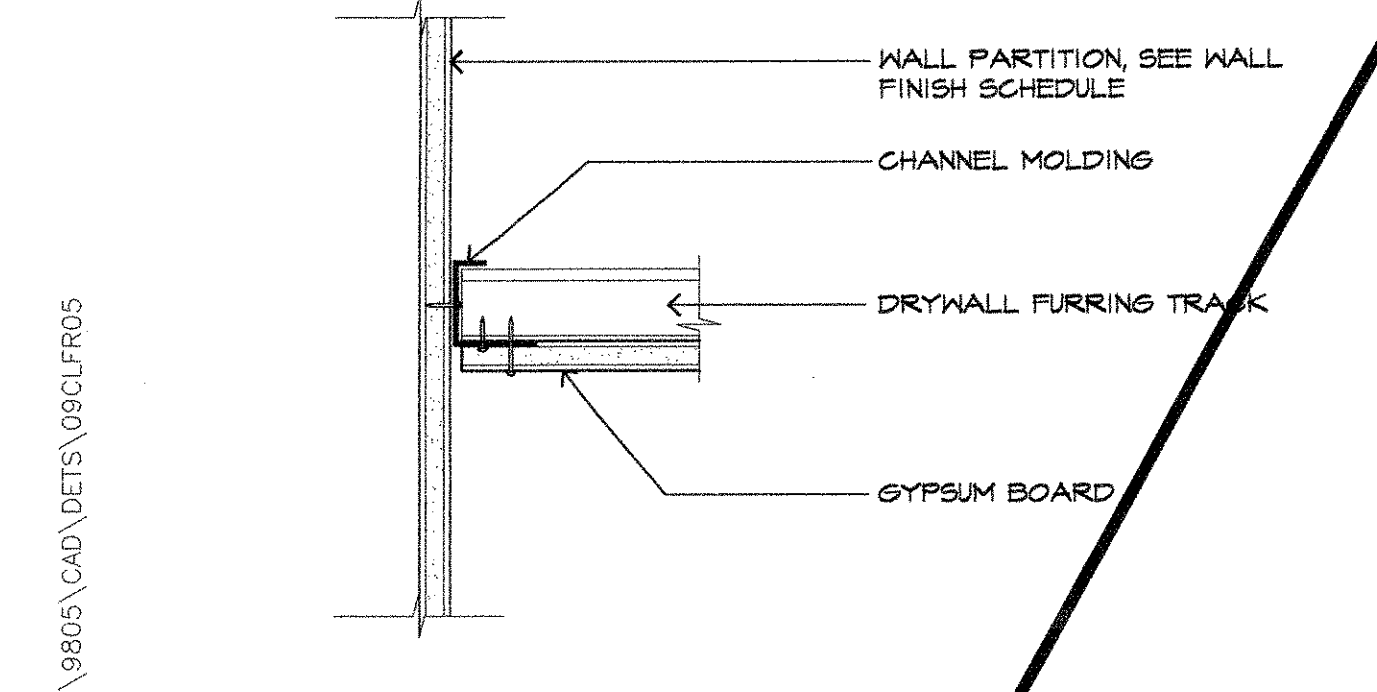


19 CLG DETAIL @ JOIST 3'-1-0"

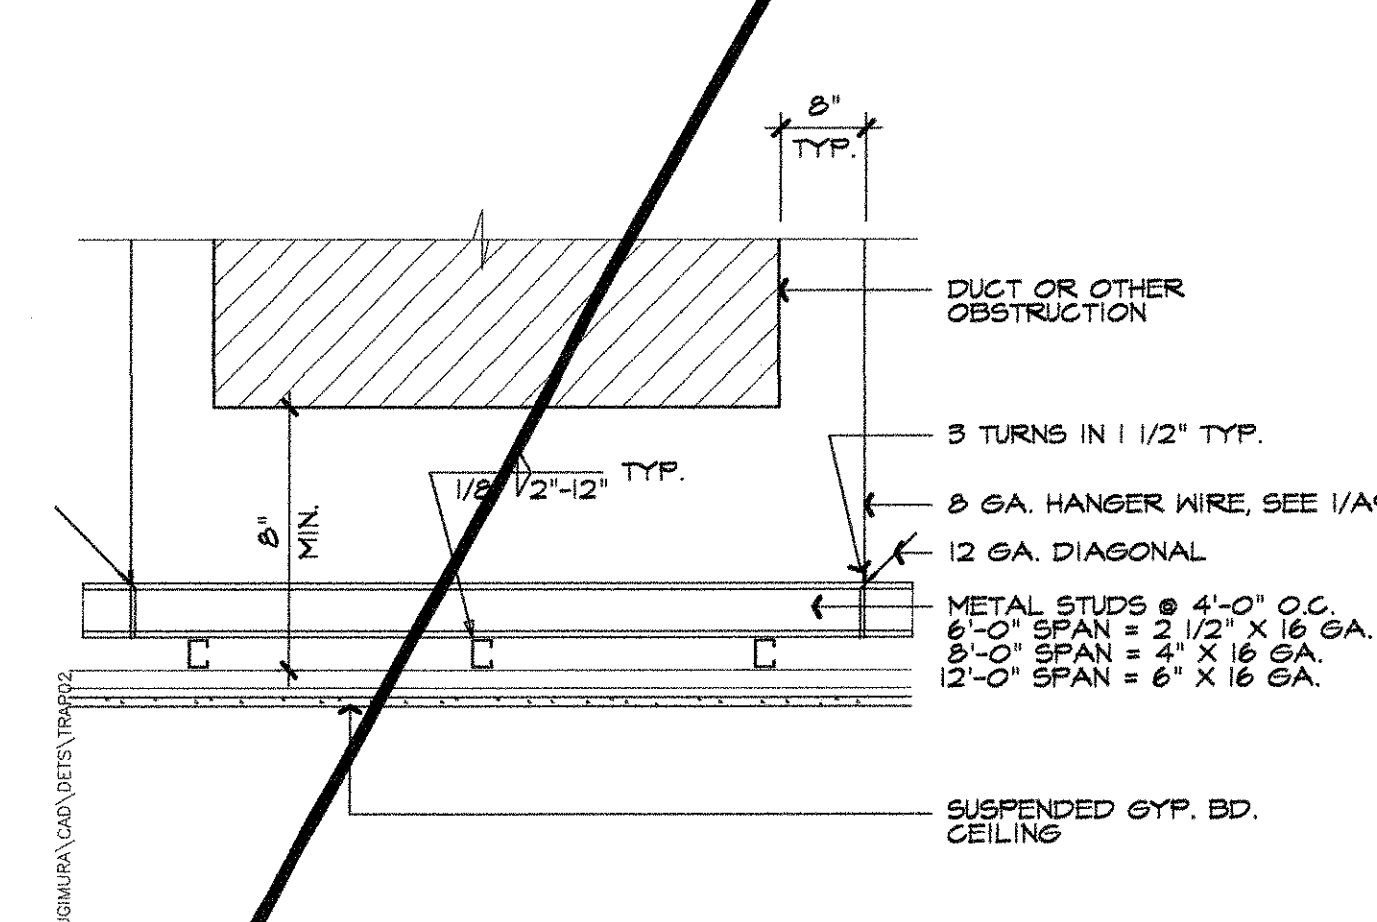


20 TRAPEZE DETAIL GYPSUM BOARD N.T.S.

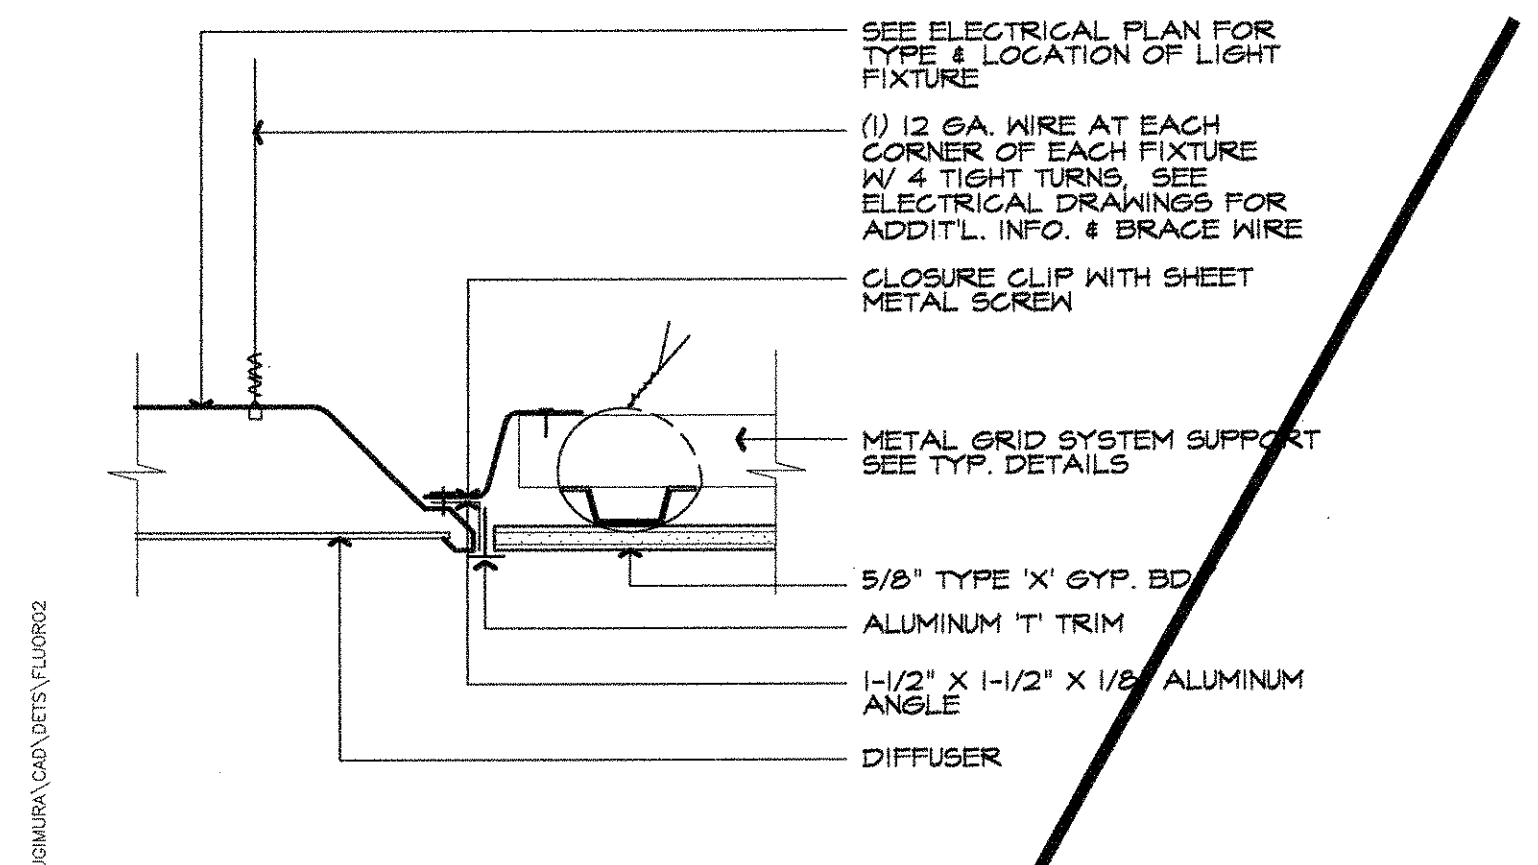


13 FLUORESCENT FIXTURE IN CEILING 3'-1-0"

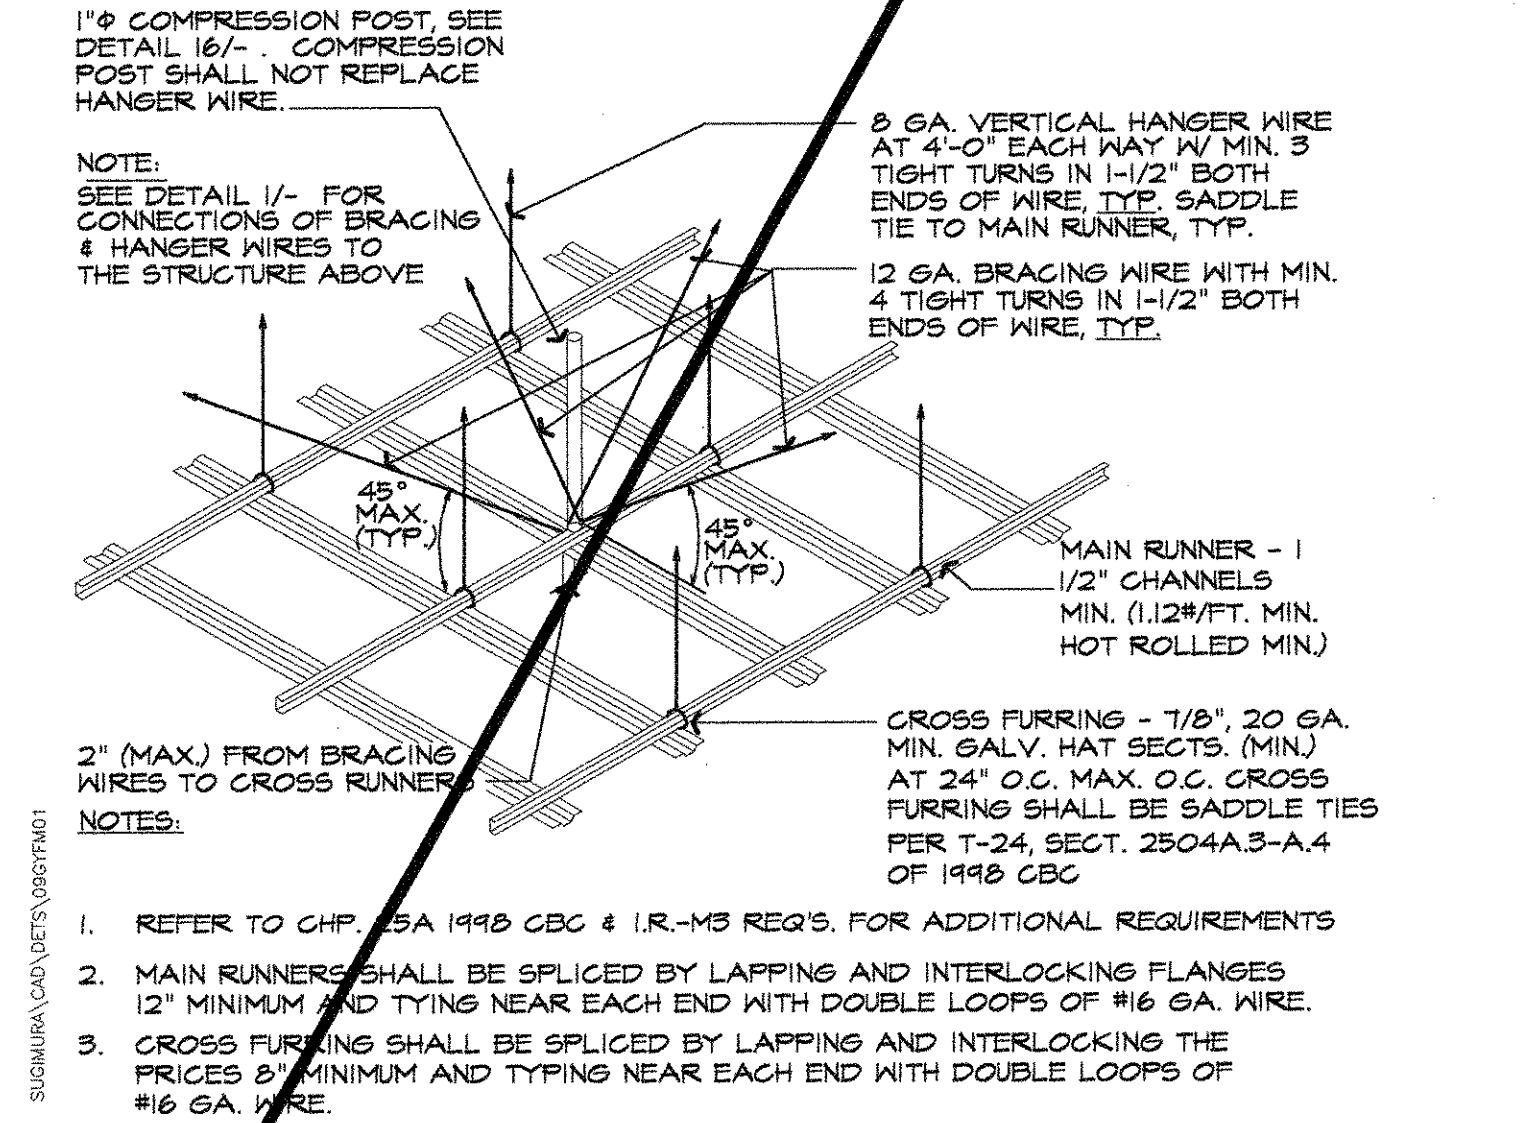


14 DIAGRAMMATIC ATTACHMENT (GYPSUM BOARD) N.T.S.

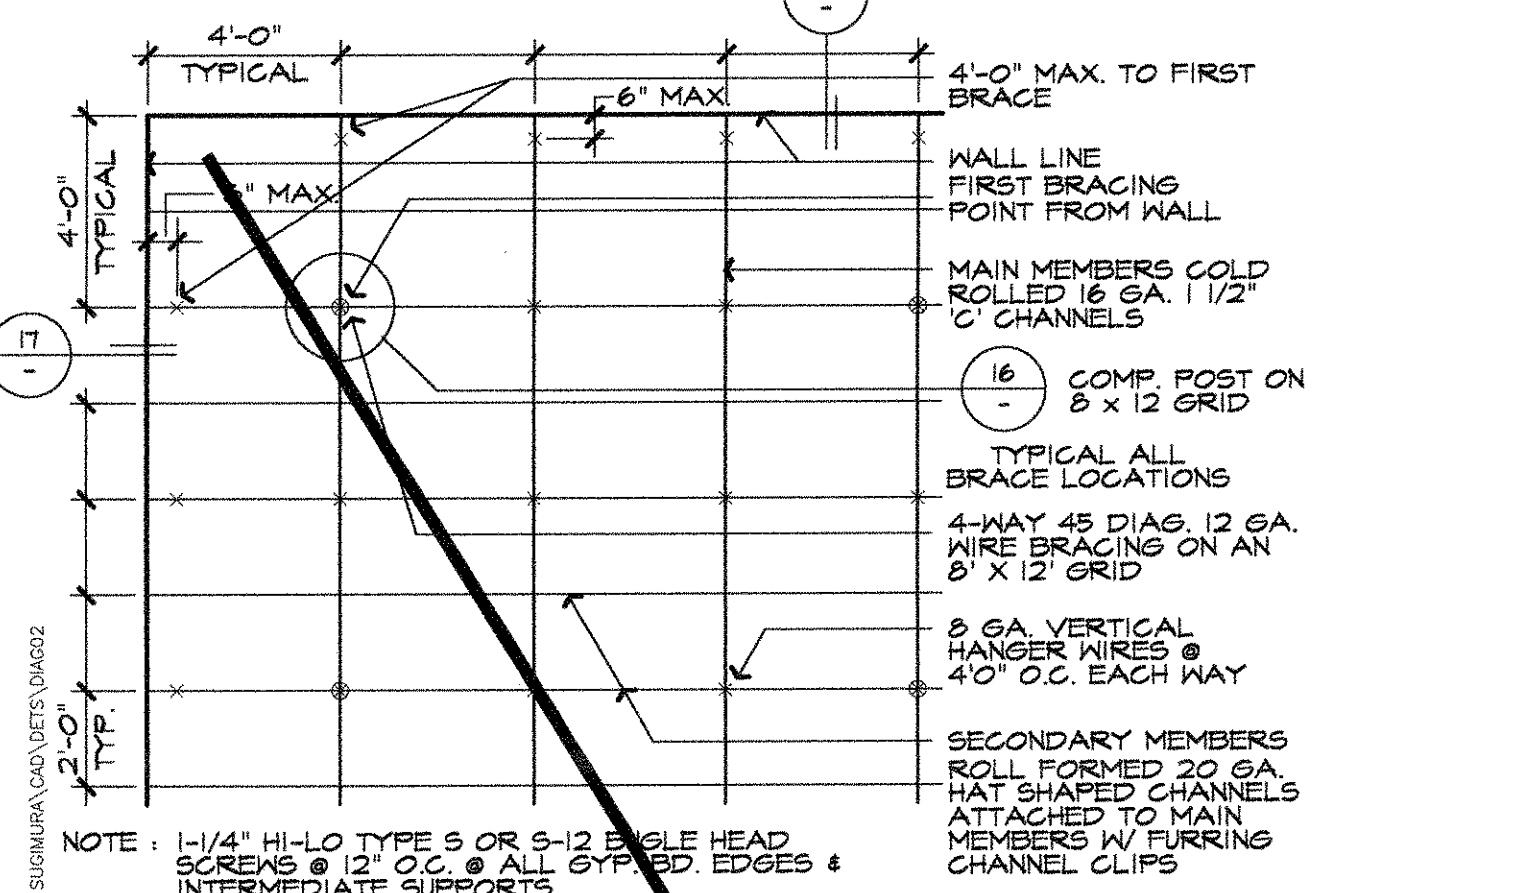


15 DIAGRAMMATIC CEILING PLAN GYPSUM BOARD N.T.S.

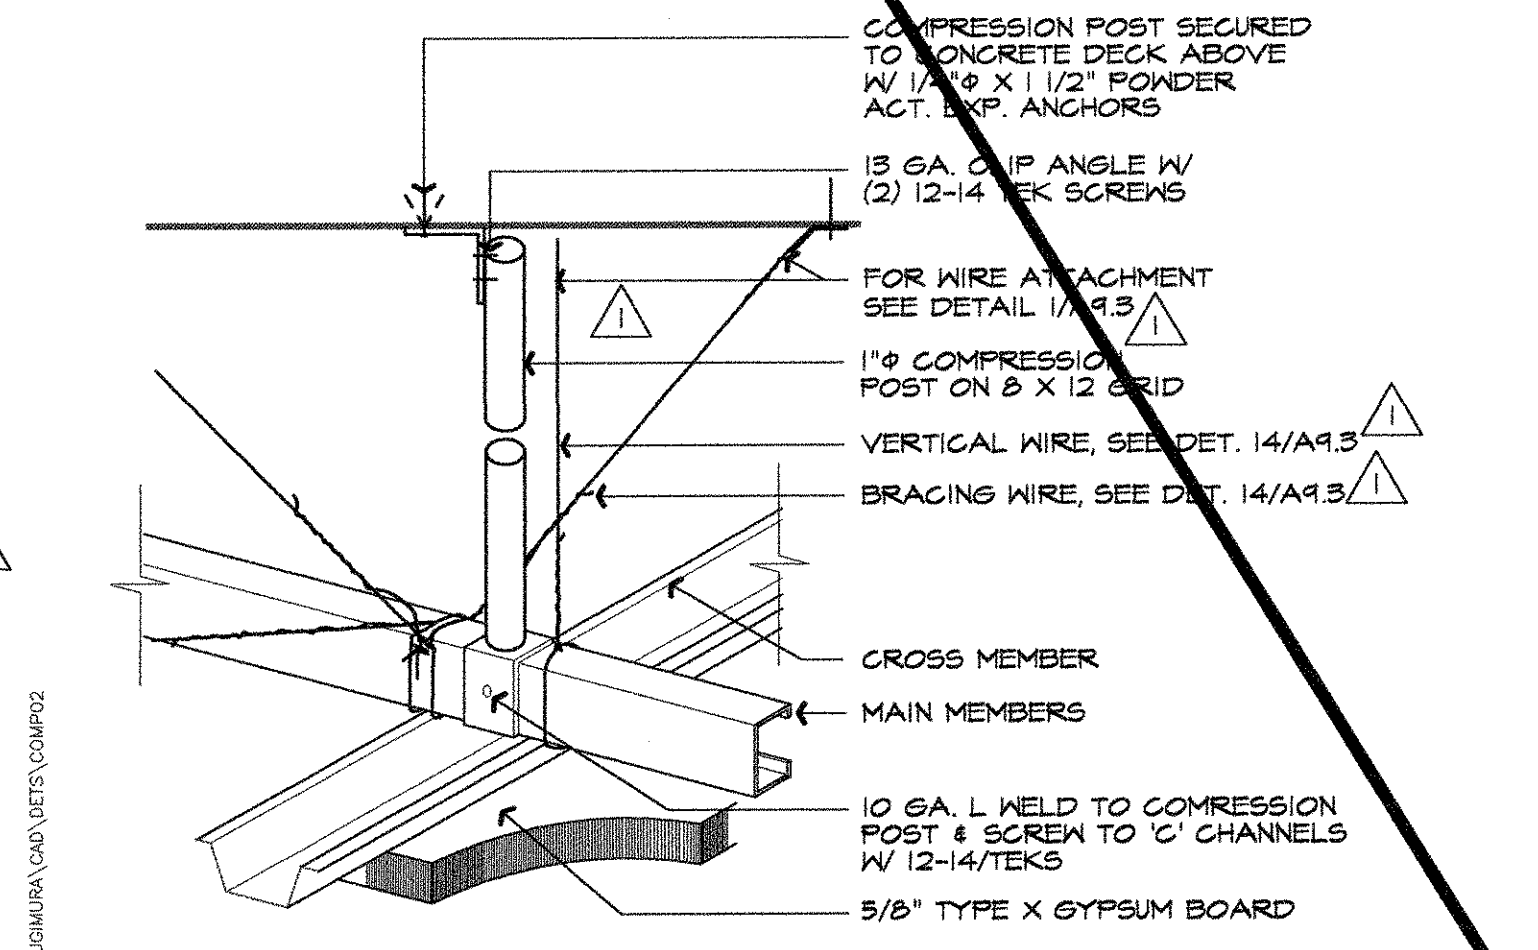


16 COMPRESSION MEMBER GYPSUM BOARD N.T.S.

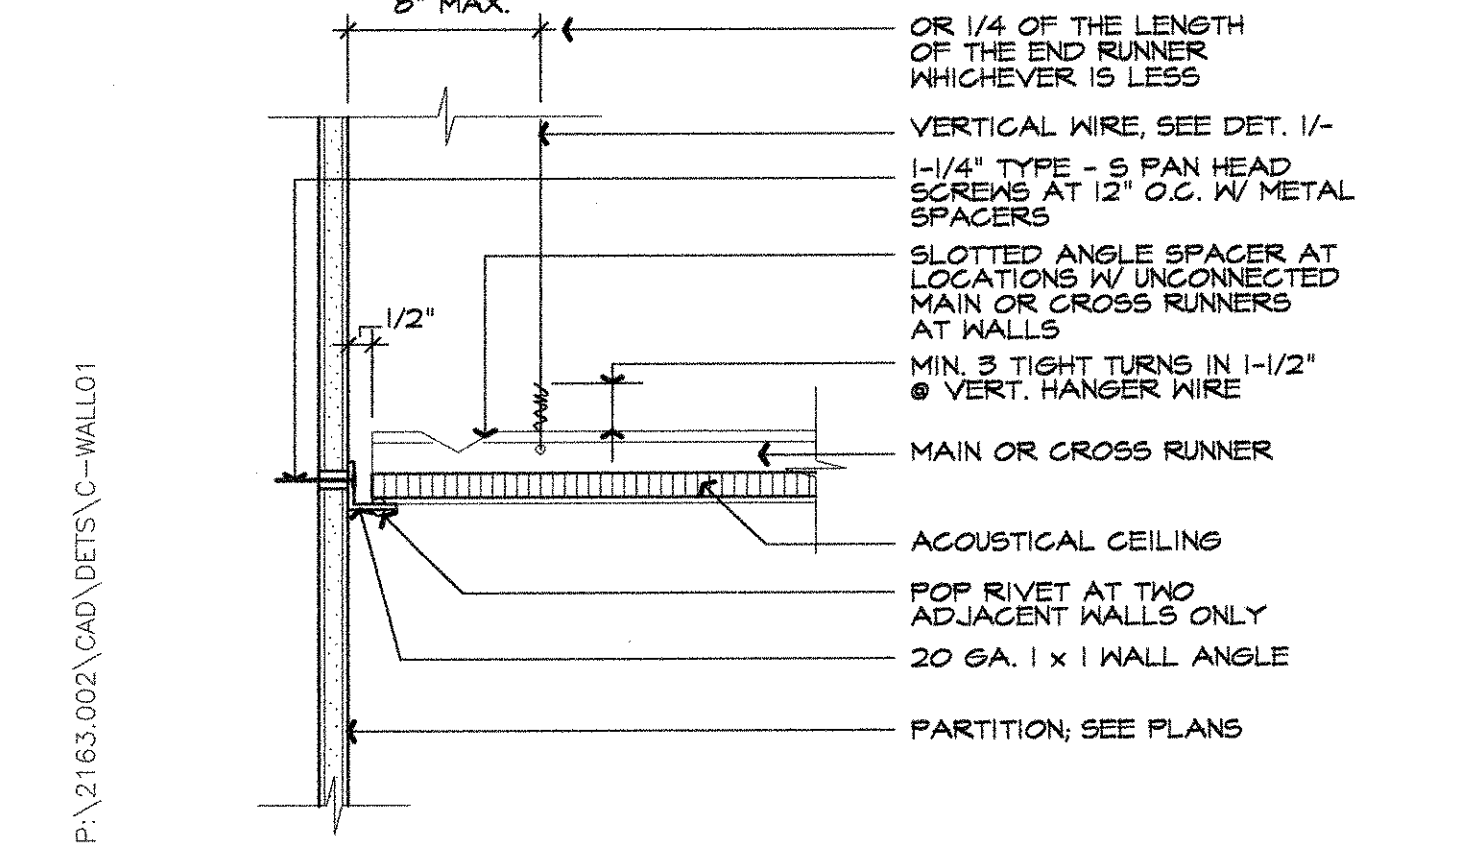


5 CEILING AT WALL SECTION (FIXED WALL @ FREE SIDE) 3'-1-0"

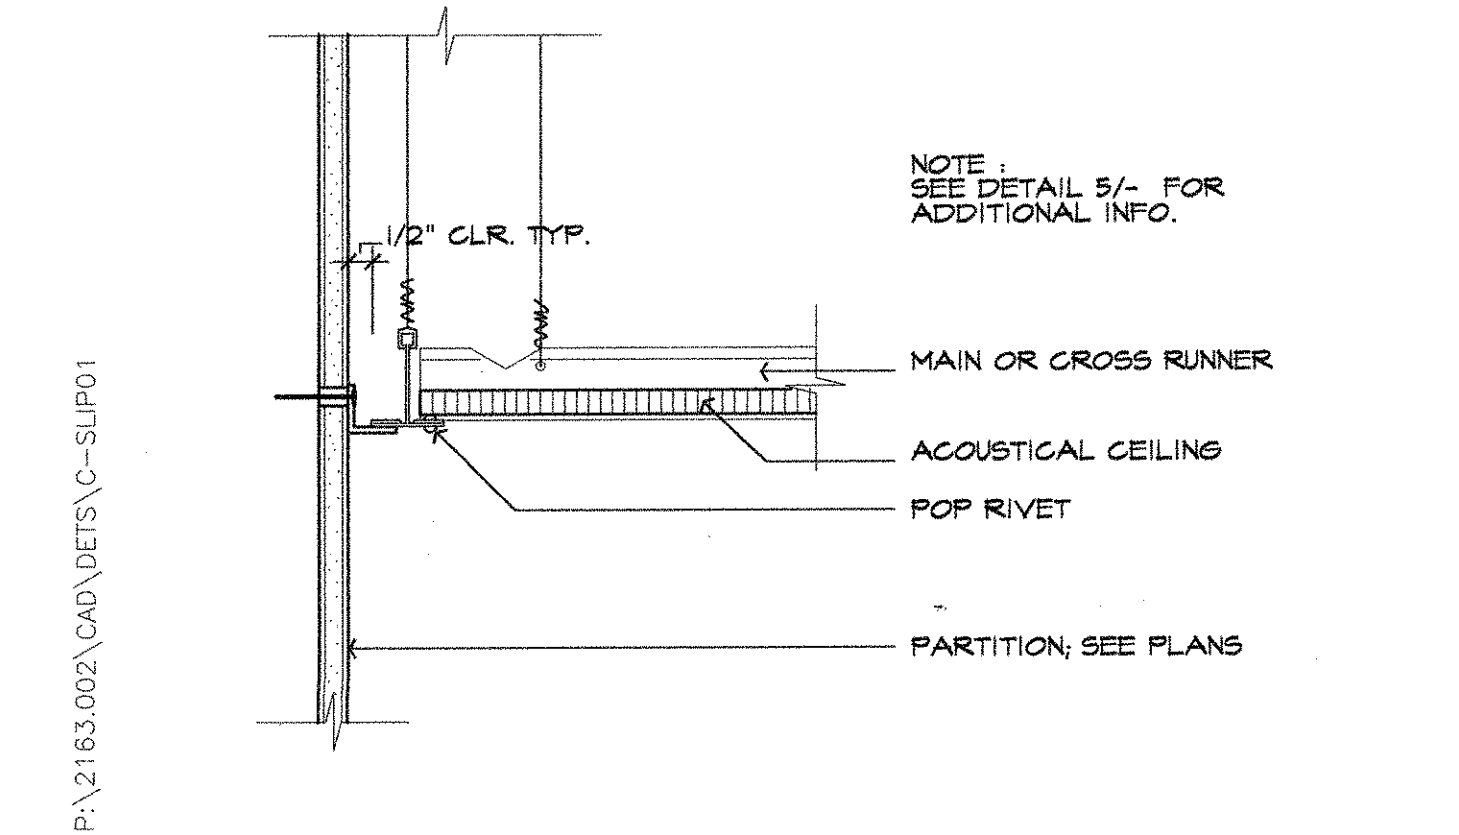


6 CEILING AT WALL (SLIP JOINT @ FREE SIDE) 3'-1-0"

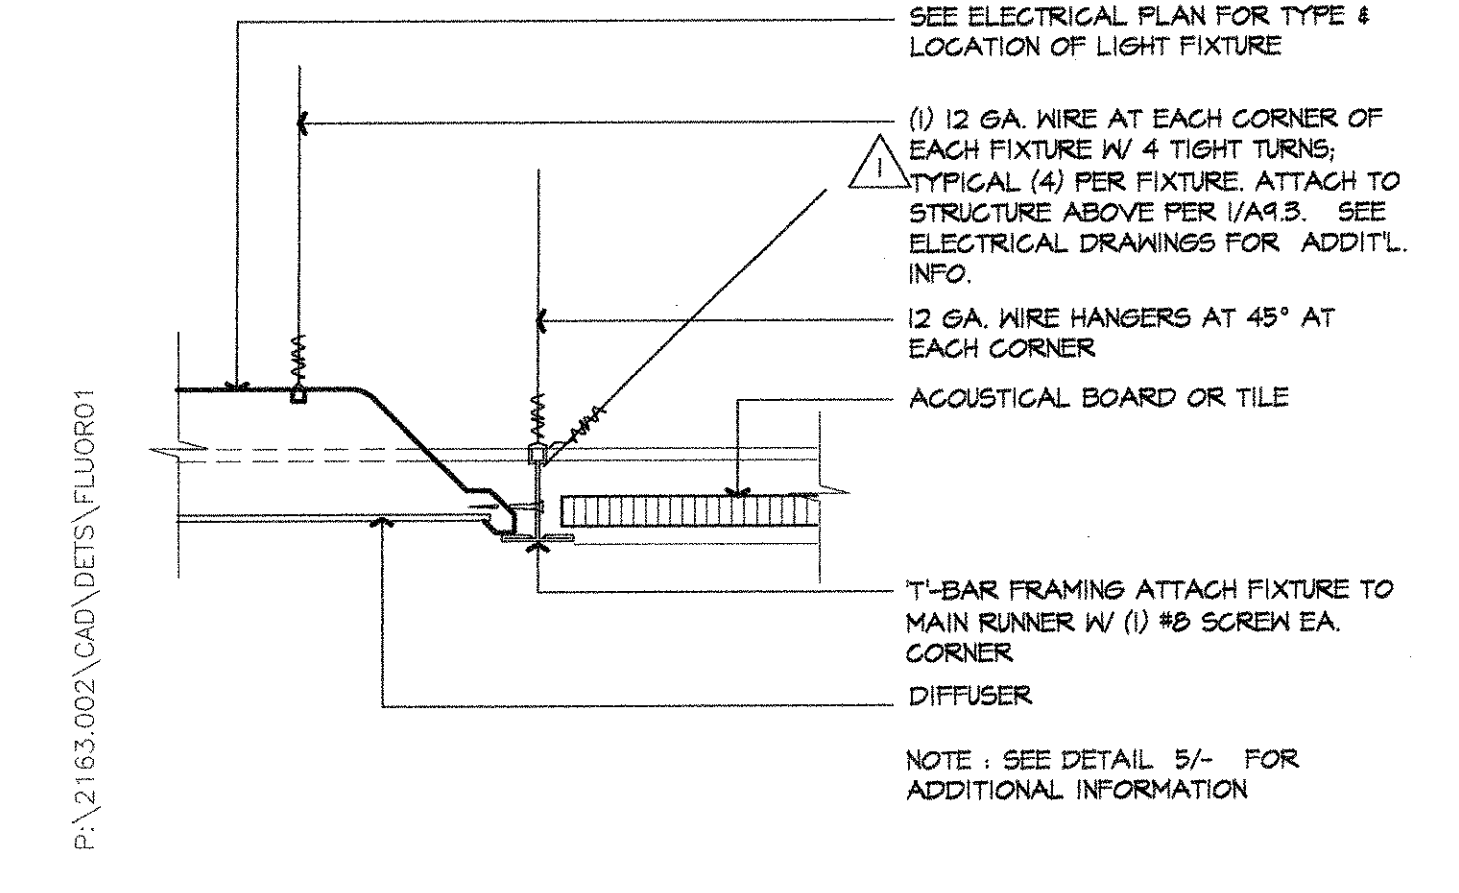


7 FLUORESCENT FIXTURE IN CEILING 3'-1-0"

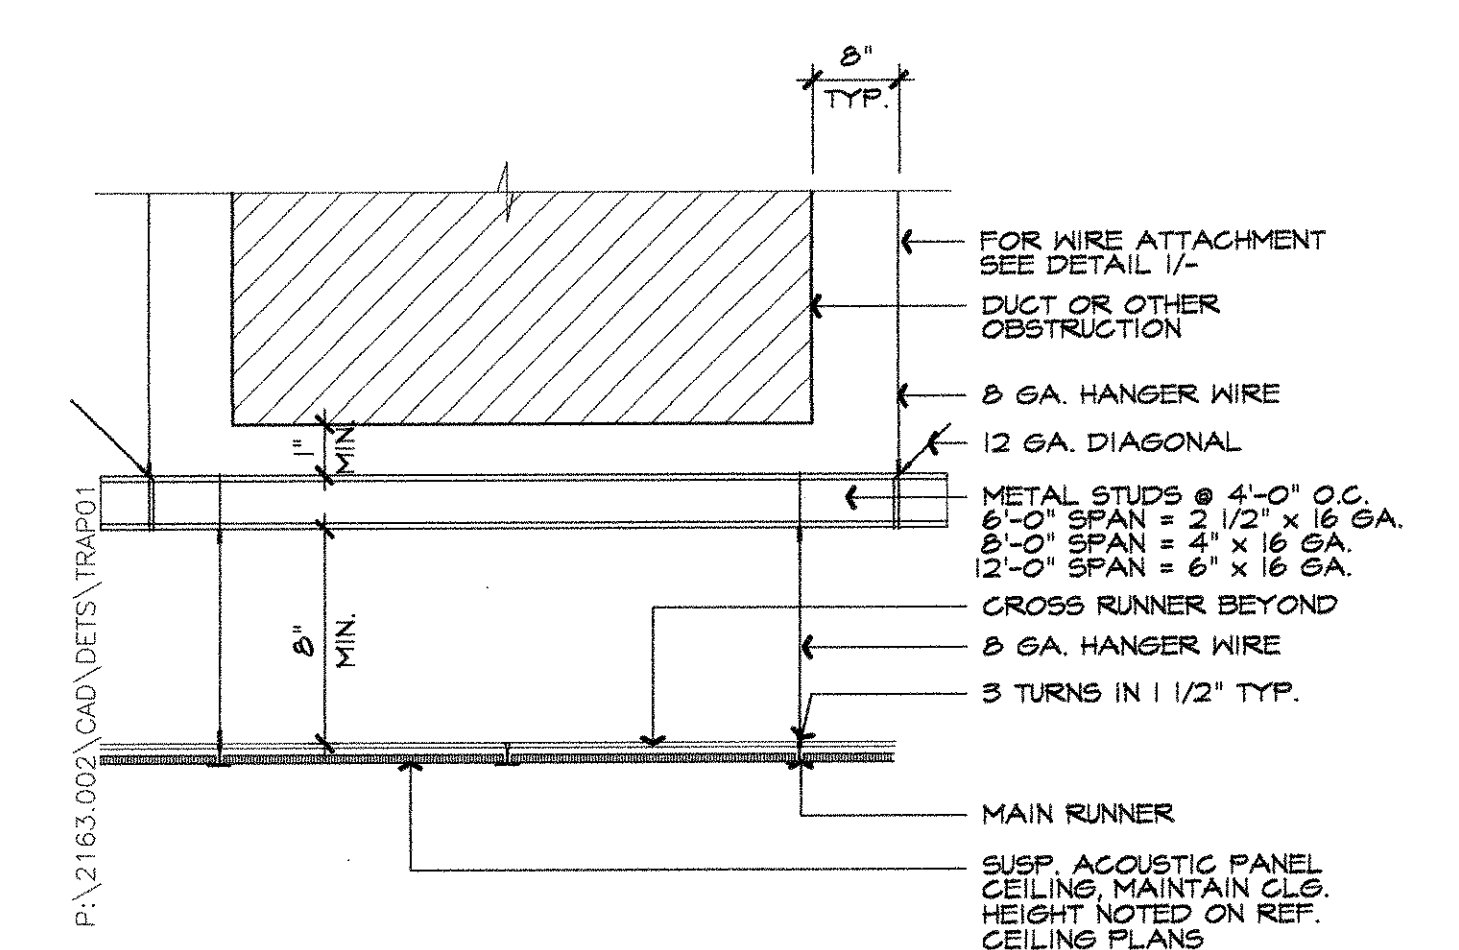


8 TRAPEZE DETAIL (ACOUSTICAL T-BAR) N.T.S.

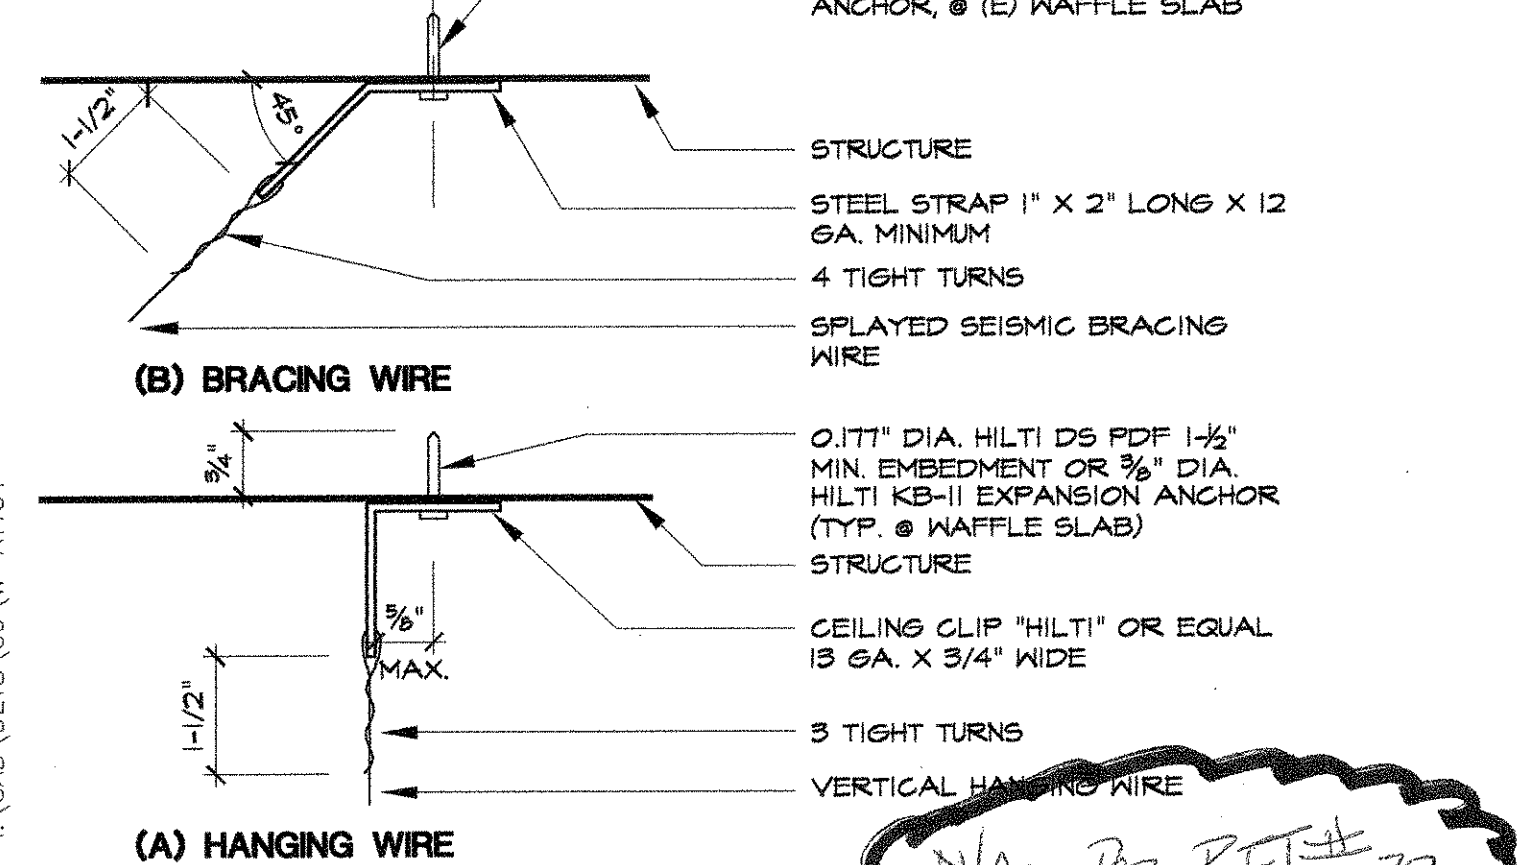


1 WIRE ATTACHMENT SEE 2/A.1 FOR ATTACH @ WOOD FRMG N.T.S.

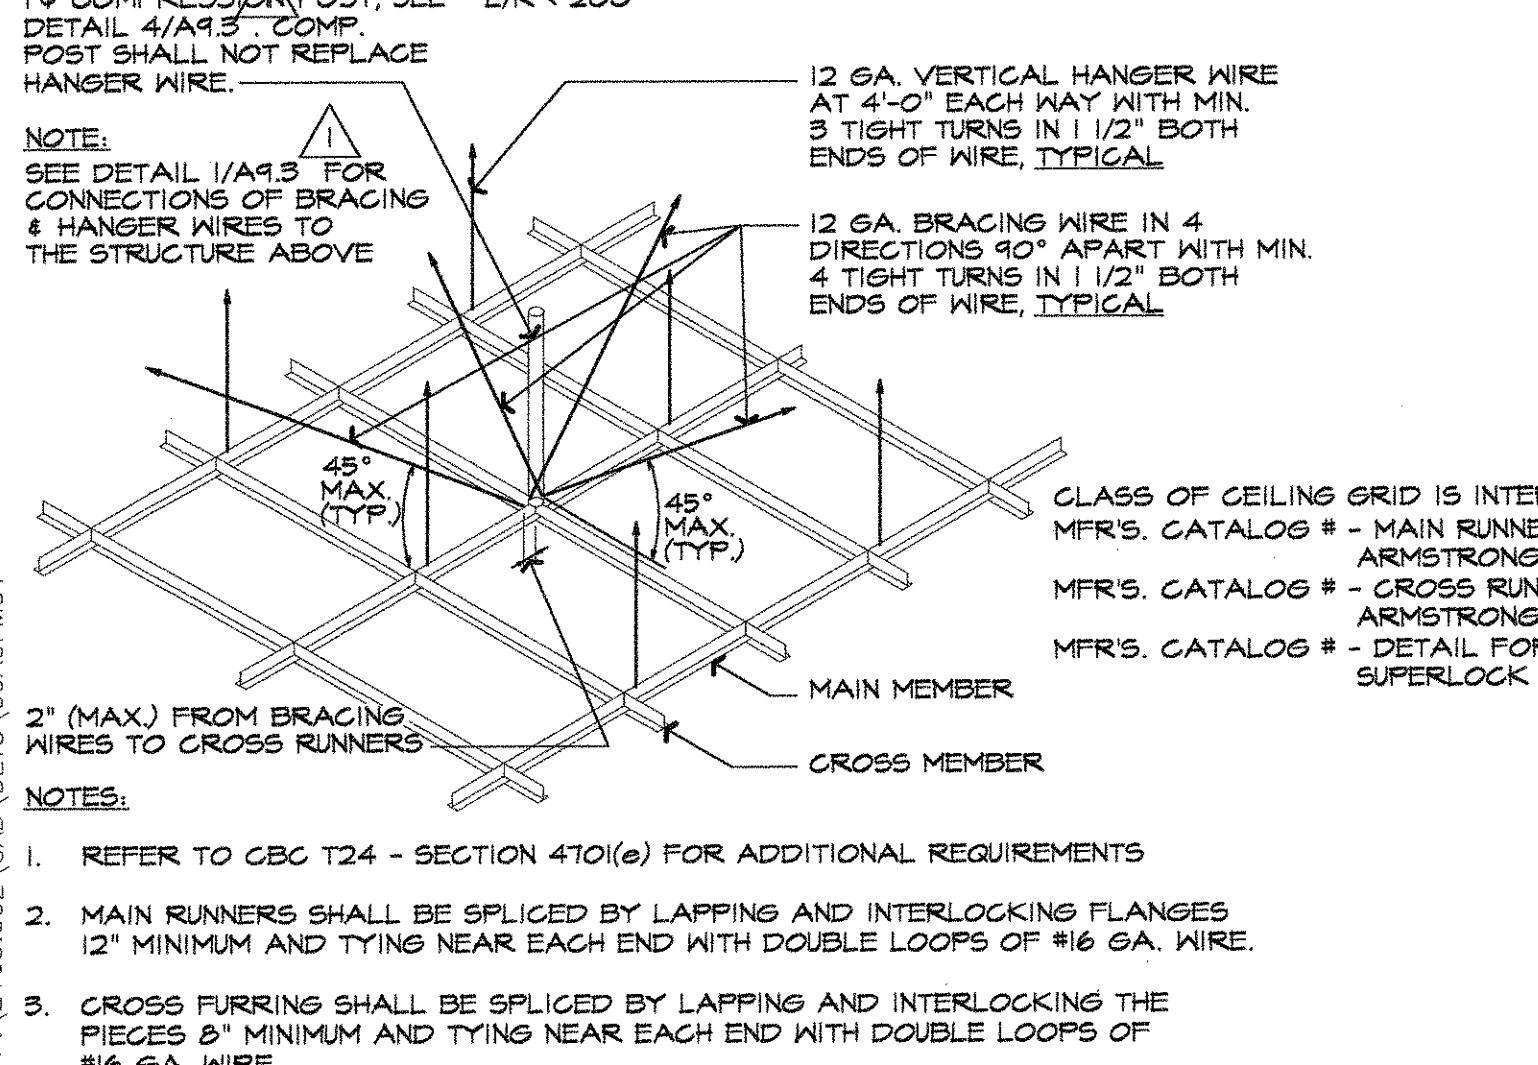

2 DIAGRAMMATIC ATTACHMENT (ACOUSTICAL T-BAR) 3'-1-0"

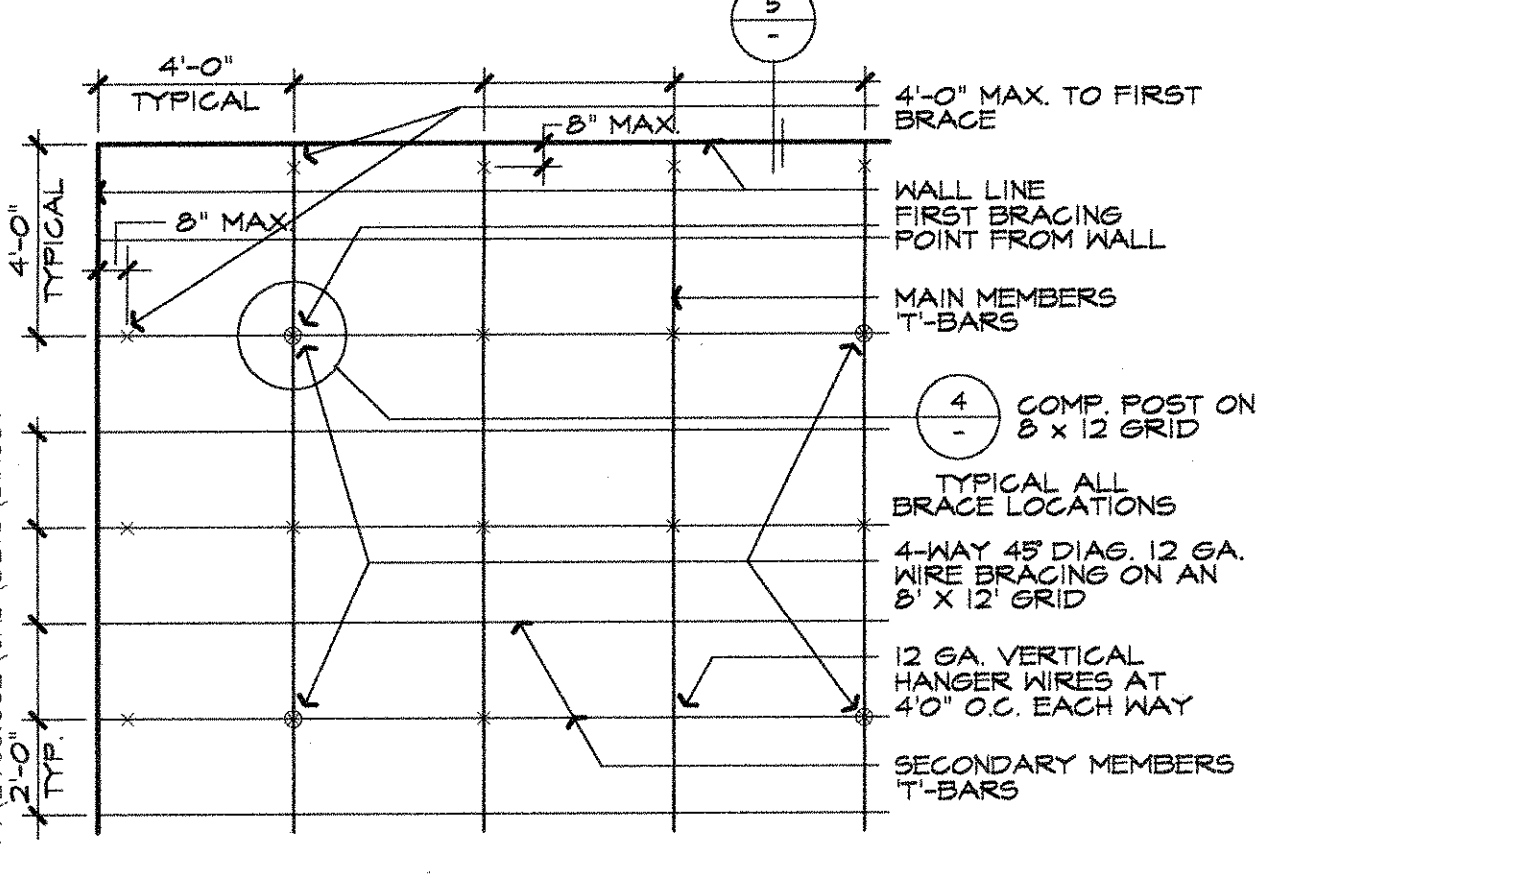

3 DIAGRAMMATIC CEILING PLAN (ACOUSTICAL T-BAR) N.T.S.

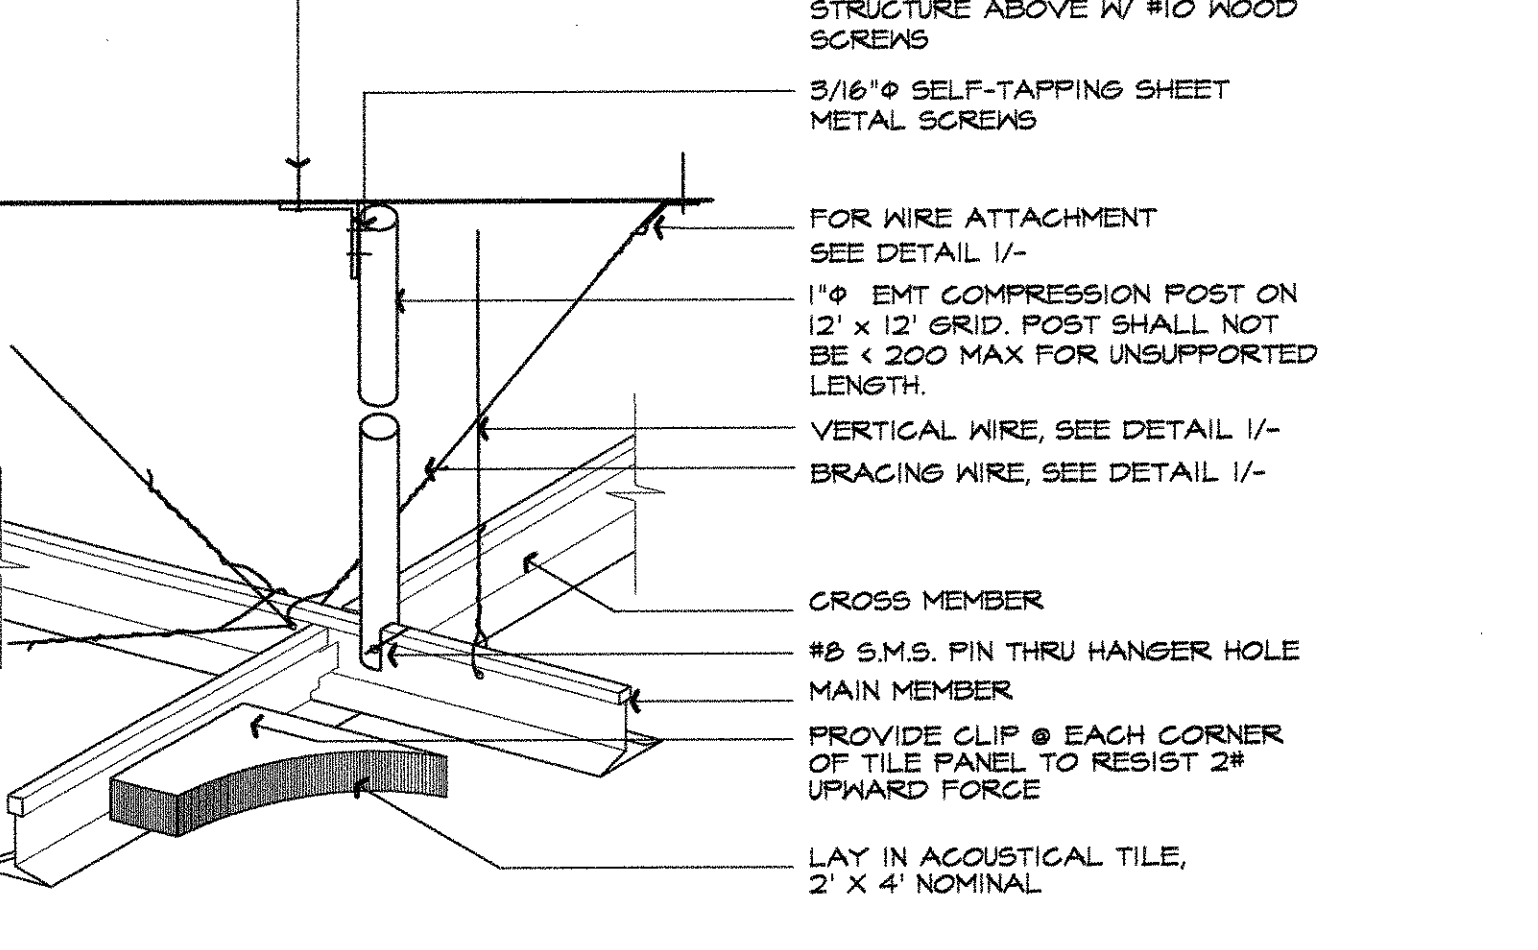


4 COMPRESSION MEMBER (ACOUSTICAL T-BAR) 3'-1-0"

**NOT USED**

**SUSPENDED GYPSUM BOARD CEILING DETAILS**

**SUSPENDED ACOUSTIC TILE CEILING DETAILS**

**Sugimura & Associates Architects**  
 Architecture • Interiors  
 Landscape Architecture  
 2155 South Bascom Ave., Suite 500  
 San Jose, CA 95128  
 408-879-0600 FAX 408-377-6086  
 COPYRIGHT © 2003 Sugimura & Associates Architects

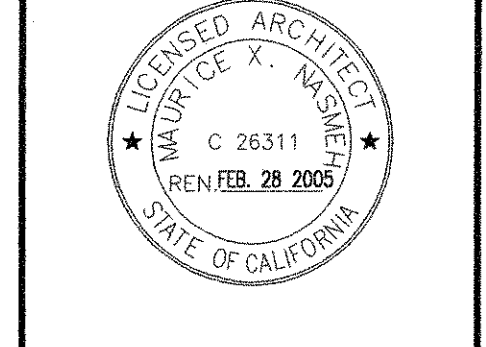

REVISED	DATE	BY

**CEILING FRAMING DETAILS**  
**BUILDING 7 AND 8**  
**SKYLINE COLLEGE SWING SPACE**  
 PERMIT PACKAGE #3  
 SKYLINE COLLEGE  
 3300 COLLEGE DRIVE  
 SAN BRUNO, CA 94068

REVISIONS		
NO.	ITEM	DATE

CLIENT APPROVAL: \_\_\_\_\_  
 DRAWN BY: KH  
 CHECKED BY: \_\_\_\_\_  
 JOB NO: 2145.002 DATE: 13 FEB 2004