


- 140D FLUSH MOUNTED END WALL PROTECTOR ▲
- 150F FLUSH MOUNTED CORNER GUARD ●
- 150BN HIGH IMPACT CORNER GUARD ●
- 160 DBN END WALL PROTECTOR ■
- STAINLESS STEEL FLUSH MOUNTED END WALL ◆

NOTES

1. REFER TO SPECIFICATION SECTION 090200 FOR INTERIOR FINISH FOR REFERENCE FOR ALL FINISH DESIGNATIONS.
2. ACCENT WALL SHALL BE EGGSHELL FINISH ONLY.
3. ALL DOOR FRAMES TO BE PAINTED WITH ADJACENT WALL COLOR SOLOR IN SEMI-GLOSS, U.O.N.
4. FLOOR FINISH TRANSITIONS TO BE LOCATED AT CENTERLINE OF DOOR LEAF, WHERE OCCURS IN CLOSED POSITION, U.O.N.
5. PROVIDE TRANSITION STRIPS IN LOCATION WHERE CHANGE IN FLOORING OCCURS.
6. PAINTED HOLLOW METAL DOOR AND FRAMES TO MATCH ADJACENT WALL PAINT COLOR, U.O.N.
7. ALL CERAMIC FLOOR TILE SHALL HAVE A 1'-0" BORDER AROUND PERIMETER OF ROOM PER SMCCCD'S STANDARDS TYP. TILE SIZE SHALL BE 2'X2'. U.O.N.
8. SEE 7/A-915 FOR AWP (ACOUSTICAL WALL PANEL) INSTALLATION DETAIL.

SYMBOLS LEGEND

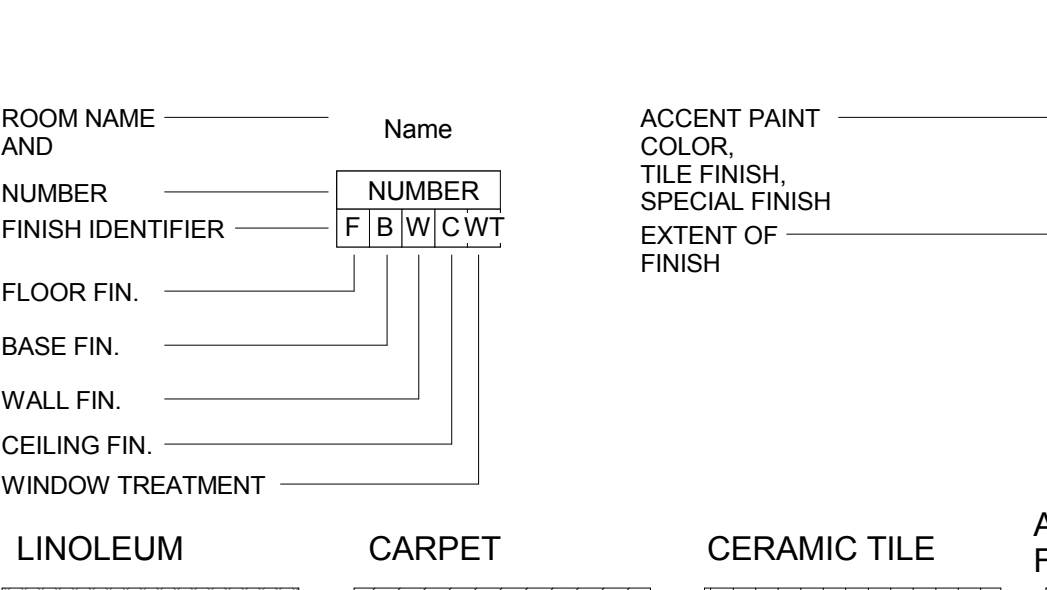

LEGEND

FLOOR FINISH	FLOOR FINISH	BASE FINISH	WALL FINISH	WALL FINISH	CEILING FINISH	WINDOW TREATMENT
0 SEE LINOLEUM FLOOR PATTERN SHEETS	13 EFM-ENTRANCE FLOOR MAT	A RB-1 RUBBER BASE	1 PT-1 PAINT, SEMI GLOSS	13 CT-2 CERAMIC TILE WITH BUILT UP BASE, PT-1 ABOVE TILE TO B.O. CEILING	A NOT USED	1 RSW-1 MANUAL
1 RFS-1 LINOLEUM	14 RFS-7 SAFETY FLOOR	B WOOD BASE PER 19/A-910	2 PT-2 PAINT, EGGSHELL	14 PT-1 TYP WITH FRP-1 4'X8' FIBERGLASS REINFORCED PANELS AT MOP SINK CORNER	B ACP-2 ACOUSTICAL PANEL CEILING	2 DOUBLE SHADE RSW-1 AND RSW-2
2 RFS-2 LINOLEUM	15 CP-2 CARPET, ROLL		3 PT-3 PAINT, EGGSHELL	* WP-1 RIGID VINYL WAINSCOT & CHAIR RAIL SEE ELEVATIONS	C GYPSUM BOARD-PT-1	3 HLB-1
3 RFS-3 LINOLEUM	16 RST-1 RUBBER STAIR TREAD		4 PT-4 PAINT, EGGSHELL	* AWP-1 ACOUSTICAL WALL PANEL SEE ELEVATIONS	D GYPSUM BOARD-PT-2	4 RSW-1 MOTORIZED
4 RFS-4 LINOLEUM	17 PRECAST CONCRETE STAIRS		5 PT-5 PAINT, EGGSHELL		E EXPOSED	
5 RFS-5 SAFETY FLOOR	18 RFS-SSAFETY FLOOR/LINOLEUM SEE FLOOR PATTERN SHEET		6 PT-6 PAINT, EGGSHELL			
6 RFS-6 SAFETY FLOOR	* ALL ELEVATOR CABS FLOORS SHALL RECEIVE LINOLEUM COLOR: NORTHERN LIGHTS		7 PT-7 PAINT, EGGSHELL			
7 CPT-1 CARPET TILE			8 GT-1 GLASS TILE			
8 CPT-2 CARPET TILE			9 PCT-1 PORCELAIN TILE			
9 CPT-3 CARPET TILE			10 NOT USED			
10 CP-1 CARPET, ROLL			11 NOT USED			
11 CT-1 CERAMIC TILE WITH TILE BORDER			12 4' X 8' PLYWOOD, 8" HEIGHT TYP ON GYPSUM BOARD FINISH PT-2 VERIFY LOCATIONS			
12 COATED CONCRETE-PEDA-GARD M						