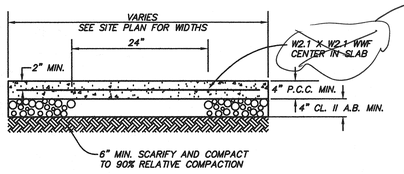

CONCRETE SIDEWALK 1
N.T.S.

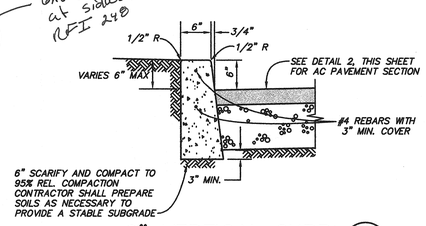

6" VERTICAL CURB 6
N.T.S.

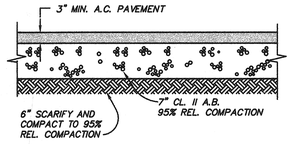

ASPHALT PAVEMENT SECTION 2
N.T.S.

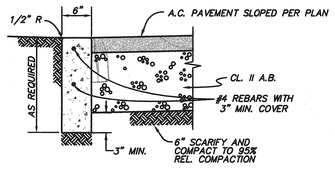

6" FLUSH CURB 7
N.T.S.

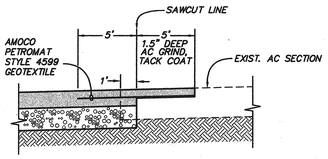

PAVEMENT CONFORM 3
N.T.S.

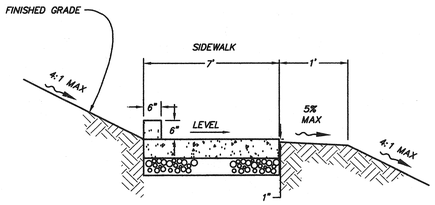

NOTE:
SEE APPROPRIATE PAVING SECTION FOR CONCRETE SIDEWALK THICKNESS.

TYPICAL SECTION 8
N.T.S.

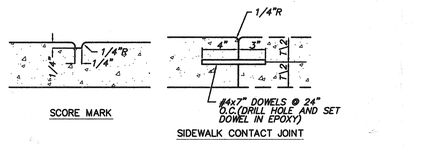

CONCRETE JOINT DETAILS 4
N.T.S.

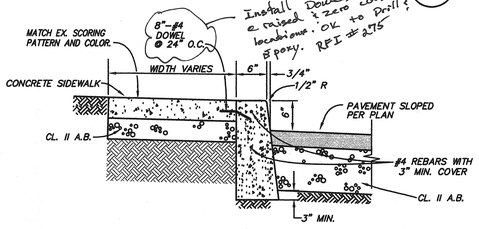

NOTE: SEE APPROPRIATE PAVING SECTION FOR AC PAVEMENT THICKNESS. SEE APPROPRIATE PAVING SECTION FOR CONCRETE SIDEWALK THICKNESS.

6" VERTICAL CURB @ SIDEWALK 5
N.T.S.

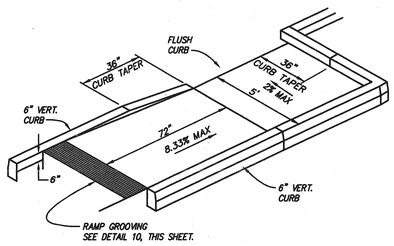

ACCESSIBLE RAMP DETAIL 9
N.T.S.

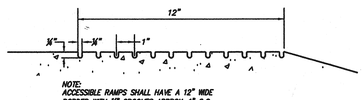

NOTE:
ACCESSIBLE RAMPS SHALL HAVE A 12" WIDE BORDER WITH ¼" GROOVES APPROX. 1" O.C.

TYPICAL ACCESSIBLE RAMP GROOVING DETAIL 10
N.T.S.

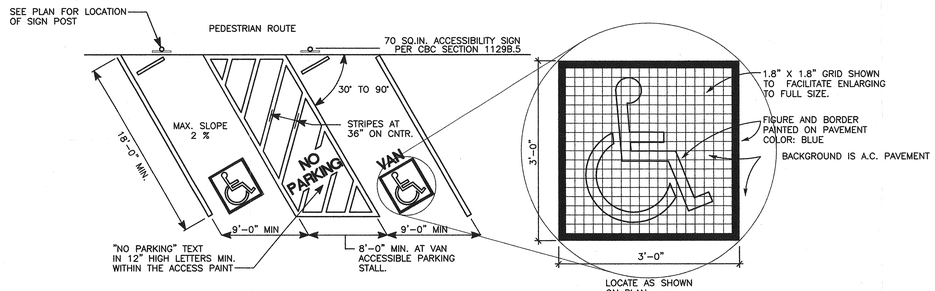

NOTE: TOW AWAY SIGNS AT ALL ENTRANCES

PARKING DETAIL 11
N.T.S.

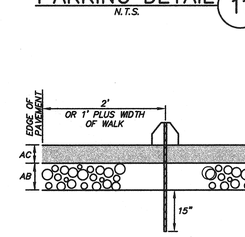

END VIEW

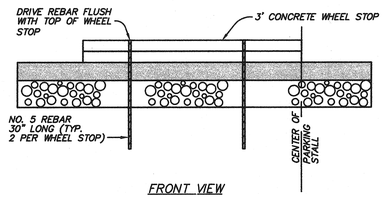

FRONT VIEW

WHEEL STOP 12
N.T.S.

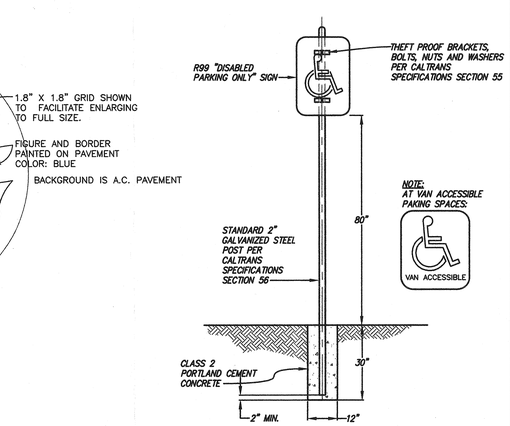

SIGN DETAIL 13
N.T.S.

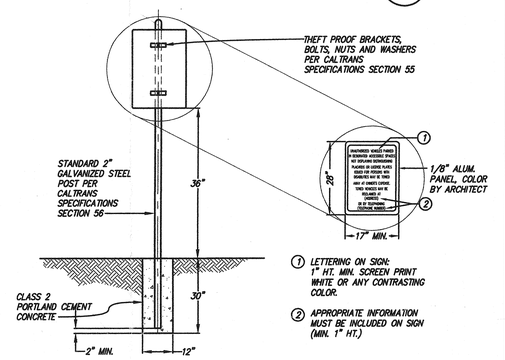

SIGN DETAIL 14
N.T.S.

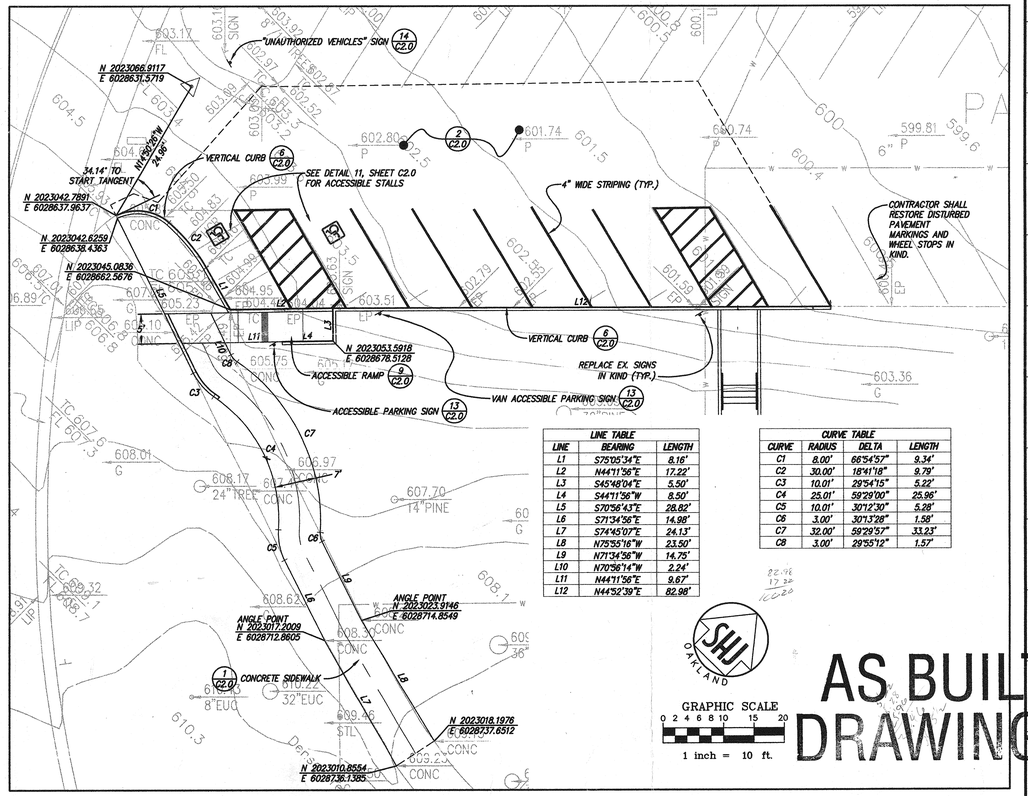

LINE TABLE		
LINE	BEARING	LENGTH
L1	S75°05'34"E	8.16'
L2	N44°11'56"E	17.22'
L3	S45°48'04"E	5.50'
L4	S44°11'56"W	8.50'
L5	S70°56'43"E	28.82'
L6	S71°34'56"E	14.98'
L7	S74°45'07"E	24.13'
L8	N75°55'16"W	23.50'
L9	N71°34'56"W	14.75'
L10	N70°56'14"W	2.24'
L11	N44°11'56"E	9.67'
L12	N44°52'39"E	82.98'

CURVE TABLE			
CURVE	RADIUS	DELTA	LENGTH
C1	8.00'	66°54'57"	9.34'
C2	30.00'	18°41'18"	9.79'
C3	10.01'	29°54'15"	5.22'
C4	25.01'	59°29'00"	25.96'
C5	10.01'	30°12'30"	5.28'
C6	3.00'	30°13'28"	1.58'
C7	32.00'	59°29'57"	33.23'
C8	3.00'	29°55'12"	1.57'

GRAPHIC SCALE
0 2 4 6 8 10 15 20
1 inch = 10 ft.

AS BUILT DRAWINGS

REVISION	DESCRIPTION	INITIAL	DATE

ISSUED FOR PROGRESS REVIEW	02/04/04
ISSUED FOR PLAN CHECK	03/03/04
ISSUED FOR PERMIT	
ISSUED FOR BID	
ISSUED FOR CONSTRUCTION	

SEAL:

CONSULTANT:

SANDIS HUMBER JONES
CIVIL ENGINEERS SURVEYORS PLANNERS
1700 Broadway, Suite 300
Oakland CA 94612
Tel (510) 873-8866 Fax (510) 873-8868

INTERACTIVE
RESOURCES
ARCHITECTURE • PLANNING • ENGINEERING
117 PARK PLACE
POINT RICHMOND
CALIFORNIA 94801
(510) 236-7435
(FAX) 232-5325
http//www.intres.com

PROJECT:

BUILDING NO. 18 (NORTH HALL) MODERNIZATION

COLLEGE OF SAN MATEO
1700 WEST HILLSDALE BLVD.
SAN MATEO, CA 94402

SAN MATEO CO. COMMUNITY COLLEGE DISTRICT

SHEET TITLE:

CIVIL CONSTRUCTION DETAILS AND SITE PLAN

PROJ. NO.	2002-066.02
PREPARATION AND REVIEW	
DRAWN BY	SEC
DESIGNER	JCL
PROJ. MGR.	ESC
PEER REVIEW	

SHEET NUMBER:

C2.0

NUMBER: OF: 4

\BUILDING 18\C2.0.dwg Date: MAR 04, 2004 Time:5:31PM