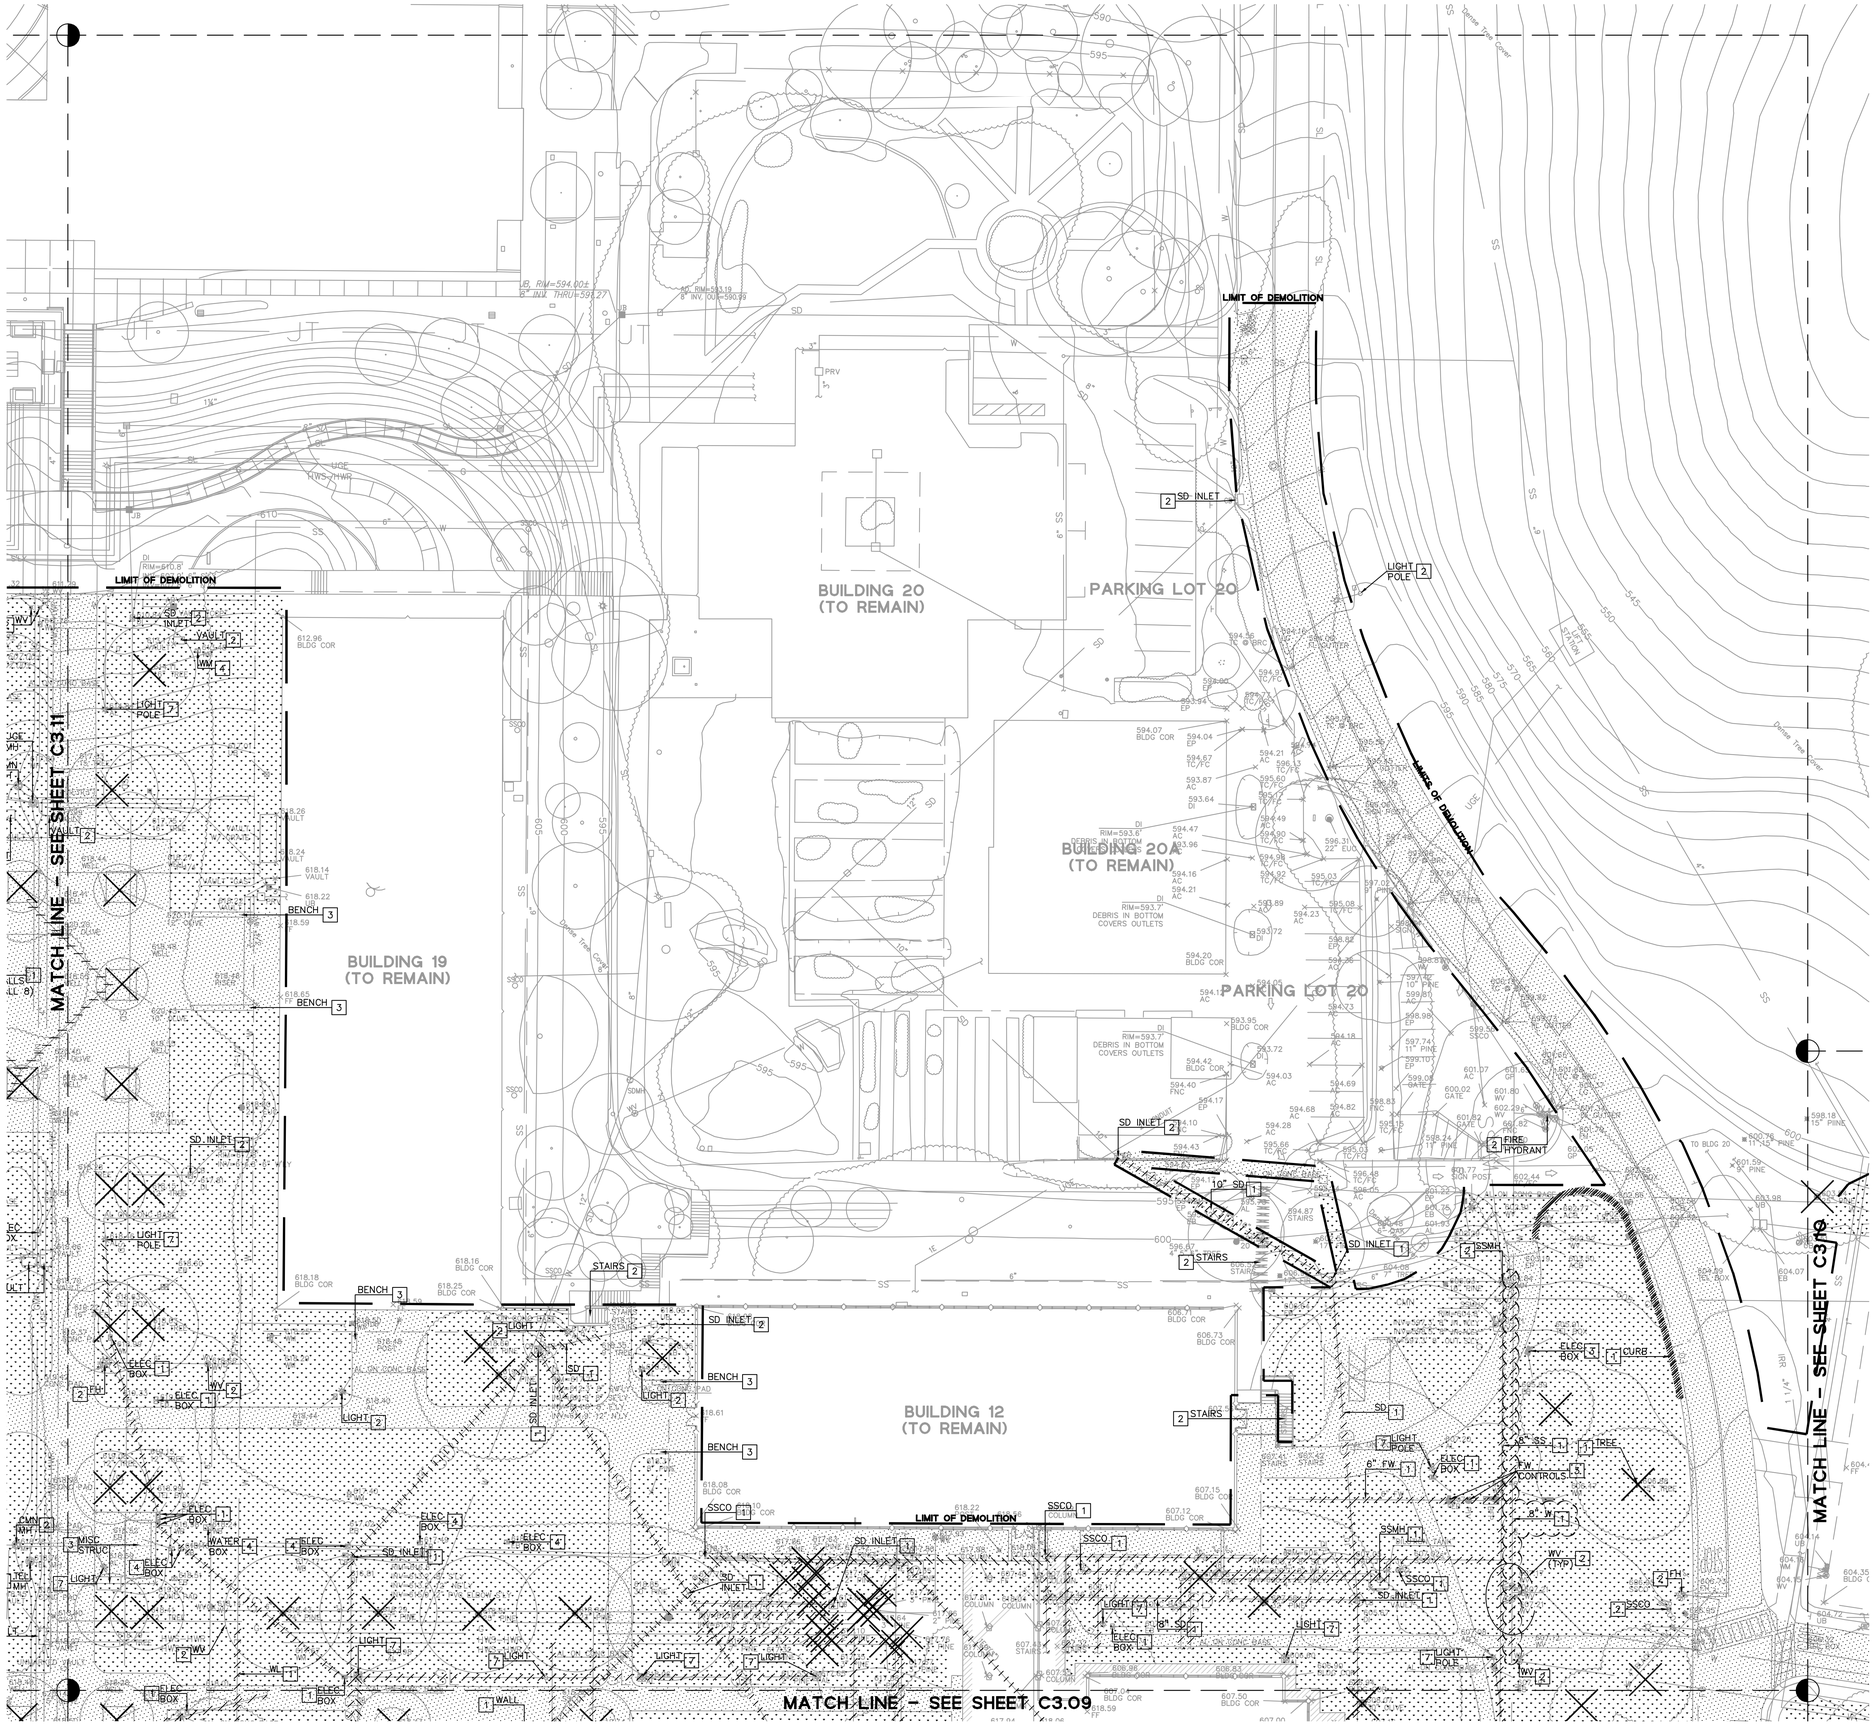


GRAPHIC SCALE

20 0 20 40

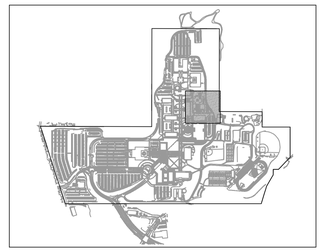

KEYMAP

## NOTES

1. SEE SHEET C3.01 FOR DEMOLITION NOTES, SYMBOLS, AND LEGEND.

## DEMOLITION SYMBOLS

1. TO BE REMOVED
2. TO REMAIN, PROTECT IN PLACE
3. TO BE RELOCATED. SALVAGED ITEMS TO BE STORED & INSTALLED UNDER DIRECTION OF ENGINEER.
4. ADJUST TO GRADE
5. GRIND OFF EXISTING STRIPING & PAVEMENT MARKINGS. SEE HORIZONTAL CONTROL SHEETS 4.01 TO 4.18 FOR PROPOSED STRIPING & PAVEMENT MARKINGS.
6. TO REMAIN, PROTECT IN PLACE. INSTALL BOLT-ON COVER.
7. TO BE REMOVED & RETURNED TO COLLEGE.

## DEMOLITION LEGEND

- HARDSCAPE TO BE DEMOLISHED & REMOVED (INCLUDING AC PAVEMENT, AB, SIDEWALK, MISC CONCRETE.)
- LANDSCAPE TO BE REMOVED
- EXISTING UTILITY TO BE DEMOLISHED & REMOVED
- EXISTING CURB TO BE DEMOLISHED & REMOVED
- SAWCUT LINE
- LIMITS OF DEMOLITION
- X TREE TO BE REMOVED
- TREE TO REMAIN

## RECORD DRAWINGS

THESE RECORD DOCUMENTS HAVE BEEN PREPARED BASED ON INFORMATION PROVIDED BY OTHERS. BKF ENGINEERS HAS NOT VERIFIED THE ACCURACY AND/OR COMPLETENESS OF THIS INFORMATION AND SHALL NOT BE RESPONSIBLE FOR ANY ERRORS OR OMISSIONS THAT MAY BE INCORPORATED HEREIN AS A RESULT. BKF ENGINEERS DOES NOT ASSUME ANY RESPONSIBILITY FOR THE FIELD MODIFICATIONS TO THE PLANS.

BY: BKF ENGINEERS DATE: JUNE 2011

McCarthy Building Companies, Inc.
343 Sansome Street, 14th Floor
San Francisco, California 94104
P 415 | 364-1339
F 415 | 397-5999

BKF ENGINEERS | SURVEYORS | PLANNERS
255 SHORELINE DRIVE, SUITE 200
REDWOOD CITY, CA 94065
PHONE: (650) 482-6300
FAX: (650) 482-6399

REGISTERED PROFESSIONAL ENGINEER
RICHARD N.T. HAGA
No. C043971
CIVIL
STATE OF CALIFORNIA

IDENTIFICATION STAMP
DIV. OF THE STATE ARCHITECT
OFFICE OF REGULATION SERVICE
APPL #: 01-110097
AC_____ FLS _____ SS _____
DATE _____

FILE NUMBER:

This and all other project documents and all ideas, arrangements and designs indicated or represented thereby are and shall remain the property of McCarthy Building Companies, Inc. (MBC) and LPA, Inc. (LPA) and cannot be lawfully used in whole or in part for any project or purpose except as described in the contractual agreement between McCarthy and the District. LPA hereby gives formal notice that any such project document use, reproduction or modification (misuse) is not only unlawful but automatically binds all parties involved with misuse to fully indemnify and defend LPA and LPA's Consultants to the maximum extent allowed under law for any claims, damages or liabilities that may be incurred by the improper use of these documents or misuse. Project documents describe design intent of work and are not a representation of as-built or existing conditions. LPA and LPA's Consultants make no representations concerning the accuracy of documents and are not responsible for any discrepancies between project documents and the existing conditions.

© Copyright 2008

College of San Mateo
Site Package
San Mateo, CA

Developed for
San Mateo County Community College District

| Revision | Description | Date |
|---|---|---|
| DSA | SUBMITTAL | 19 SEPT 2008 |
| DSA | FINAL | 09 APRIL 2009 |
| PROJECT RECORD | DRAWING | JUNE 2011 |

| | |
|---|---|
| Job. No. | 27082.30 |
| Date | 02 APRIL 2009 |
| Drawn by | MD, JT |
| Checked by | RH |
| Scale | 1"=20' |

DEMOLITION PLAN

C3.12