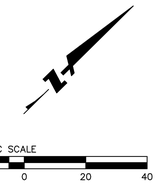

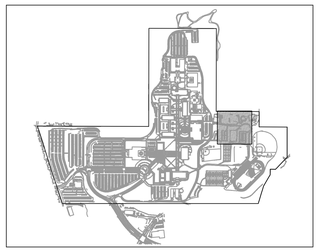

KEYMAP

NOTES

1. SEE SHEET C4.01 FOR LINE & CURVE TABLE, AND HORIZONTAL CONTROL NOTES.

MARKING, SIGNING, & STRIPING LEGEND

SYMBOL	DESCRIPTION
1	LANE LINE STRIPING, CALTRANS DETAIL 13 PER STANDARD PLAN A20A
2	CHEVRON MARKING PER SEC. 3B.101(CA) OF CALIFORNIA MUTCD
3	TYPE IV (L) ARROW PER CALTRANS STANDARD PLAN A24A
4	TYPE IV (R) ARROW PER CALTRANS STANDARD PLAN A24A
5	"PED XING" LETTERING (6' TALL LETTERS)
6	R59 (RT) SIGN WITH "RIGHT TURN ONLY"
7	"ONE-WAY" SIGN (R6-1)
8	STOP SIGN (R1-1)
9	R26(S)(CA) - "NO STOPPING ANYTIME" - SEE NOTES 4 & 6
10	BLUE REFLECTIVE MARKER
11	DETAIL 3B, CHANNELIZING LINE PER STANDARD PLAN A20D
12	THRU ARROW PER CALTRANS STANDARD PLAN A24A
13	"BUSES ONLY" SIGN
14	TYPE VII (R) ARROW PER CALTRANS STANDARD PLAN A24A (THRU/RIGHT TURN COMBINATION)
15	"VAN ACCESSIBLE" SIGNAGE, SEE DETAIL 1 ON SHEET C8.02
16	CA TYPE K-1 (OM2-1H) OBJECT MARKER WITH R4-7 "KEEP RIGHT" SIGN.
17	ACCESSIBLE STALL SIGN, SEE DETAIL 1 ON SHEET C8.02
18	4 INCH DIAGONAL STRIPING AT 36" O.C., SEE DETAIL 1 ON SHEET C8.02
19	4 INCH WHITE STRIPING FOR PARKING STALLS
20	TOW AWAY SIGNAGE, SEE DETAIL 1 ON SHEET C8.02
21	STOP BAR (12" WHITE STRIPING)
22	CROSSWALK (12" WHITE PAINT; 6' WIDE MINIMUM)
23	"NO PARKING" SIGN
24	"STOP" LETTERING (6' TALL LETTERS)
25	"YIELD" LETTERING (6' TALL LETTERS)
26	"NO PARKING" LETTERING (12" TALL LETTERS)
27	"LOADING ZONE" LETTERING (12" TALL LETTERS)
28	INTERNATIONAL SYMBOL OF ACCESSIBILITY -SEE DETAIL 1 ON SHEET C8.02
29	PERMIT PARKING SIGN - COORDINATE WITH SMCCCD
30	"BUSES ONLY" LETTERING (2.5' TALL LETTERS)
31	DIRECTIONAL SIGNAGE - SEE LANDSCAPE PLANS
32	CAMPUS MAP DIRECTORY - SEE LANDSCAPE PLANS
33	"STOP AHEAD" SIGN
34	"ONE WAY - DO NOT ENTER" SIGN
35	4 INCH WHITE DIAGONAL STRIPING AT 36" O.C.
36	"ACCESSIBLE DROP OFF/LOADING ZONE" LETTERING (2.5' TALL LETTERS)

RECORD DRAWINGS

THESE RECORD DOCUMENTS HAVE BEEN PREPARED BASED ON INFORMATION PROVIDED BY OTHERS. BKF ENGINEERS HAS NOT VERIFIED THE ACCURACY AND/OR COMPLETENESS OF THIS INFORMATION AND SHALL NOT BE RESPONSIBLE FOR ANY ERRORS OR OMISSIONS THAT MAY BE INCORPORATED HEREIN AS A RESULT. BKF ENGINEERS DOES NOT ASSUME ANY RESPONSIBILITY FOR THE FIELD MODIFICATIONS TO THE PLANS.

BY: BKF ENGINEERS DATE: JUNE 2011

McCarthy Building Companies, Inc.
343 Sansome Street, 14th Floor
San Francisco, California 94104
P 415 | 364-1339
F 415 | 397-5999

BKF ENGINEERS | SURVEYORS | PLANNERS
255 SHORELINE DRIVE, SUITE 200
REDWOOD CITY, CA 94065
PHONE: (650) 482-6300
FAX: (650) 482-6399

REGISTERED PROFESSIONAL ENGINEER RICHARD N.Y. HAGA No. C043971 CIVIL STATE OF CALIFORNIA

IDENTIFICATION STAMP
DIV. OF THE STATE ARCHITECT
OFFICE OF REGULATION SERVICE
APPL. #: 01-110097
AC. ____ FLS ____ SS ____
DATE ____

FILE NUMBER:

This and all other project documents and all ideas, aesthetics and designs appearing therein are instruments of LPA, Inc. (LPA) and cannot be lawfully used in whole or in part for any project or purpose except as described in the contractual agreement between McCarthy and the District. LPA hereby gives formal notice that any such project document use, reproduction or modification (misuse) is not only unlawful but automatically binds all parties involved with misuse to fully indemnify and defend LPA and LPA's Consultants to the maximum legal extent against any claims, damages, losses or liabilities that may result from such misuse. Project documents describe design intent of work and are not a representation of as-built or existing conditions. LPA and LPA's Consultants make no representations concerning the accuracy of documents and are not responsible for any discrepancies between project documents and the existing conditions.

© Copyright 2008

College of San Mateo
Site Package
San Mateo, CA

Developed for
San Mateo County Community College District

Revision	Description	Date

Revision	Description	Date
	DSA SUBMITTAL	19 SEPT 2008
	DSA FINAL	09 APRIL 2009
1	RFI #26	20 AUG 2009
	PROJECT RECORD DRAWING	JUNE 2011

Job. No.	27082.30
Date	02 APRIL 2009
Drawn by	MD, JT
Checked by	RH
Scale	1"=20'

0 10 20 40

HORIZONTAL CONTROL PLAN

C4.10