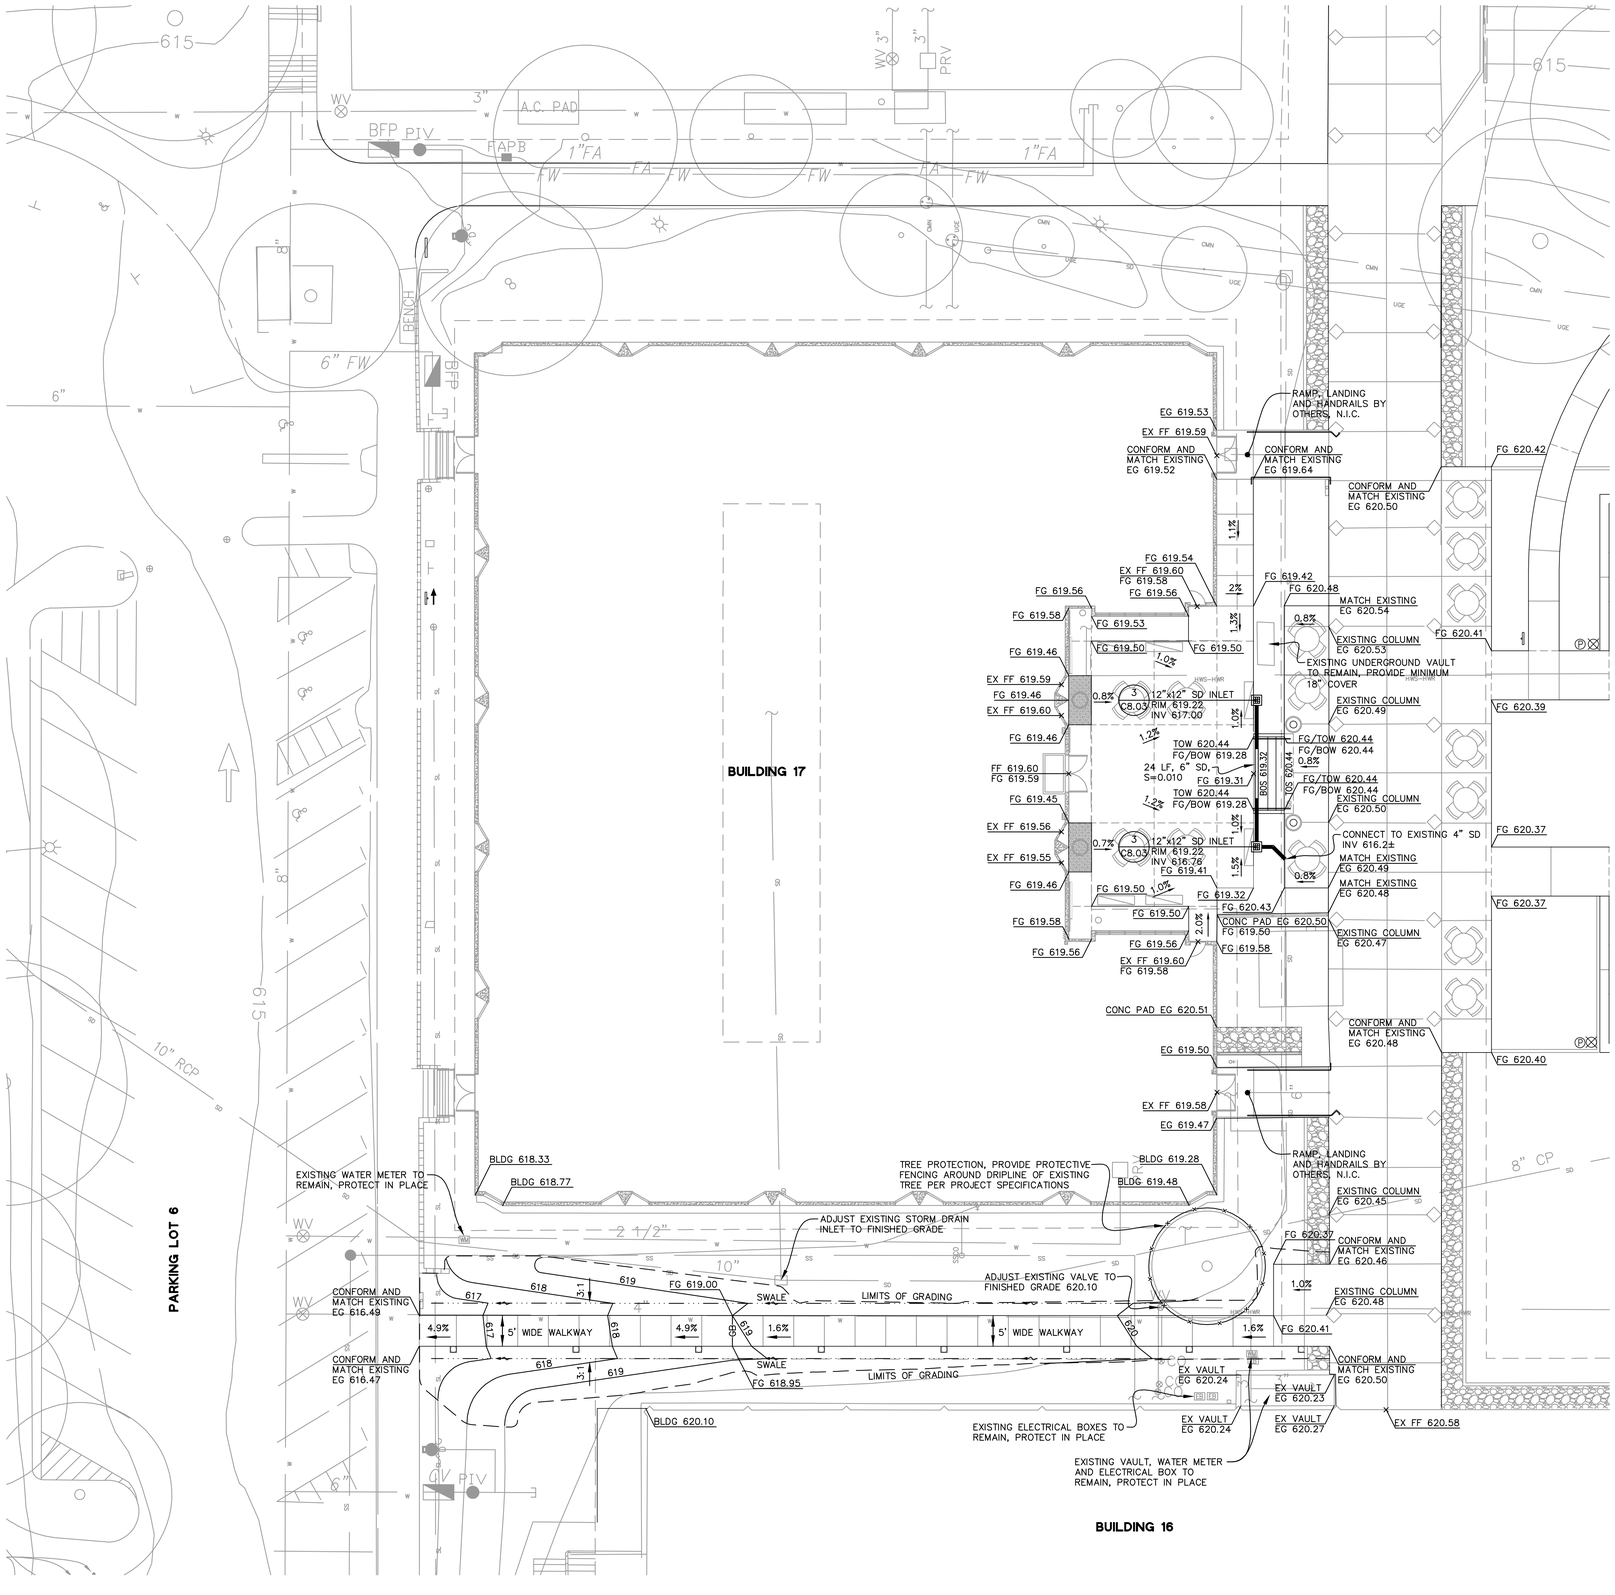

GRAPHIC SCALE

10 0 10 20

NOTES:

1. ALL EXISTING UTILITY SERVICES TO THE BUILDINGS ARE TO REMAIN IN SERVICE AT ALL TIMES DURING CONSTRUCTION ACTIVITIES.

2. GRADING QUANTITIES:
   CUT: 30 CY
   FILL: 0 CY
   NET: 30 CY EXPORT

   THE EARTHWORK QUANTITIES SHOWN ABOVE ARE IN-PLACE QUANTITIES AND HAVE BEEN ESTIMATED BY THE ENGINEER BASED ON THE FOLLOWING ASSUMPTIONS:

   A: EARTHWORK QUANTITIES DO NOT ACCOUNT FOR SITE STRIPPINGS.
   B: EARTHWORK QUANTITIES DO NOT ACCOUNT FOR UTILITY TRENCHING AND SPOILS.
   C: EARTHWORK QUANTITIES DO NOT ACCOUNT FOR SOIL STABILIZATION FACTOR AND LANDSCAPE PLANTING SOILS.

   ACTUAL QUANTITIES MAY VARY DUE TO FIELD CONDITIONS OR CONSTRUCTION TECHNIQUES. THE CONTRACTOR SHALL BE RESPONSIBLE FOR VERIFYING ALL QUANTITIES BASED ON INDEPENDENT CALCULATIONS.

RECORD DRAWINGS

THESE RECORD DOCUMENTS HAVE BEEN PREPARED BASED ON INFORMATION PROVIDED BY OTHERS. BKF ENGINEERS HAS NOT VERIFIED THE ACCURACY AND/OR COMPLETENESS OF THIS INFORMATION AND SHALL NOT BE RESPONSIBLE FOR ANY ERRORS OR OMISSIONS THAT MAY BE INCORPORATED HEREIN AS A RESULT. BKF ENGINEERS DOES NOT ASSUME ANY RESPONSIBILITY FOR THE FIELD MODIFICATIONS TO THE PLANS.

BY: BKF ENGINEERS DATE: JUNE 2011

McCarthy Building Companies, In
343 Sansome Street, 14th Floor
San Francisco, California 94104
P 415 | 364-1339
F 415 | 397-5999

BKF ENGINEERS | SURVEYORS | PLANNERS
255 SHORELINE DRIVE, SUITE 200
REDWOOD CITY, CA 94065
PHONE: (650) 482-6300
FAX: (650) 482-6399

REGISTERED PROFESSIONAL ENGINEER RICHARD N.Y. HAGA No. C043971 CIVIL STATE OF CALIFORNIA

IDENTIFICATION STAMP
DIV. OF THE STATE ARCHITECT
OFFICE OF REGULATION SERVICE
APPL. #: 01-110097
AC.____ FLS ____ SS ____
DATE ____

FILE NUMBER:

This and all other project documents and all ideas, aesthetics and design representations, plans and specifications are instruments of LPA, Inc. (LPA) and cannot be lawfully used in whole or in part for any project or purpose except as described in the contractual agreement between McCarthy and the District. LPA hereby gives formal notice that any such project document use, reproduction or modification (misuse) is not only unlawful but automatically binds all parties involved with misuse to fully indemnify and defend LPA and LPA's Consultants to the maximum extent of any and all legal costs, damages, losses or liabilities incurred as a result of such misuse by any third party misuse. Project documents describe design intent of work and are not a representation of as-built or existing conditions. LPA and LPA's Consultants make no representations concerning the accuracy of documents and are not responsible for any discrepancies between project documents and the existing conditions.

© Copyright 2008

College of San Mateo
Site Package - Courtyard 17
San Mateo, CA

Developed for
San Mateo County Community College District

Revision	Description	Date

Revision	Description	Date
	BULLETIN #6 (B17 COURTYARD)	11 DECEMBER 2009
	PROJECT RECORD DRAWING	JUNE 2011

Job. No.	27082.30
Date	09 APRIL 2009
Drawn by	MD, JT
Checked by	RH
Scale	1"=10'

GRADING AND DRAINAGE PLAN ENLARGEMENTS

C5.30 1