MATCH LINE – SEE SHEET C6.07

BUSES ONLY

BUILDING 4

PARKING LOT 2

PARKING LOT 1

CONNECT TO EXISTING 1-1/2" GAS LINE

4" PRESSURE TYPE VACUUME BREAKER

4" IRR STUB

HWS-HWR

15 LF 6" PVC FS

RELOCATED FIRE HYDRANT

CONNECT TO EX SD INLET INV 580.62

15 LF, 12" SD S=0.010

SDAD GR 583.20 INV 578.86

SDCI TC 583.65 INV 578.71

22 LF, 12" SD S=0.049

SDCI TC 583.62 INV 579.52

34 LF, 12" SD S=0.015

26 LF, 12" SD S=0.015

59 LF, 12" SD S=0.010

22 LF, 12" SD S=0.015

34 LF, 12" SD S=0.015

SDCI TC 583.72 INV 579.46

SDCI TC 583.61 INV 579.01

SDCI TC 583.60 INV 578.95

SDMH C8.04 RIM 583.11
INV 578.62 12" IN
INV 578.62 12" IN
INV 578.12 12" IN, N
INV 578.12 15" OUT

EX 15" SD

SDCI TC 584.14 INV 580.14

SDCI TC 584.14 INV 579.83

31 LF, 12" SD S=0.010

47 LF, 12" SD S=0.010

SDMH C8.04 RIM 582.75
INV 579.36 IN SW
INV 576.20 IN NW
INV 576.20 OUT

25–1"ø CURB THRU DRAINS @ 4' O.C.

62 LF, 12" SD S=0.010

SDCI TC 583.62 INV 576.93

3" FRENCH DRAIN INV 582.50

73 LF, 12" SD S=0.010

SDCI TC 581.43
INV 575.69 12" IN, W
INV 575.14 12" IN, N
INV 575.14 12" OUT

101 LF, 12" SD S=0.055

SDMH C8.04 RIM 573.85
INV 569.58 IN N
INV 567.66 IN E
INV 564.78 OUT

49 LF, 18" SD S=0.010

509 LF, 18" SD, S=0.055

SDCI C8.05 TC 574.42
INV 568.15 IN, E
INV 570.17 IN, N
INV 568.19 OUT

MATCH LINE – SEE SHEET C6.03

MATCH LINE – SEE SHEET C6.05

MATCH LINE – SEE SHEET C6.01

MATCH LINE – SEE SHEET C6.01

GRAPHIC SCALE
20 0 20 40

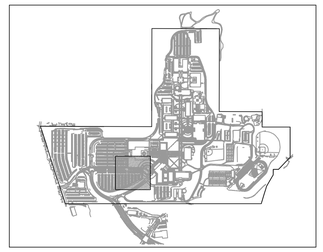

KEYMAP

NOTES

1. SEE SHEETS C8.03 THROUGH C8.05 FOR UTILITY DETAILS

RECORD DRAWINGS

THESE RECORD DOCUMENTS HAVE BEEN PREPARED BASED ON INFORMATION PROVIDED BY OTHERS. BKF ENGINEERS HAS NOT VERIFIED THE ACCURACY AND/OR COMPLETENESS OF THIS INFORMATION AND SHALL NOT BE RESPONSIBLE FOR ANY ERRORS OR OMISSIONS THAT MAY BE INCORPORATED HEREIN AS A RESULT. BKF ENGINEERS DOES NOT ASSUME ANY RESPONSIBILITY FOR THE FIELD MODIFICATIONS TO THE PLANS.

BY: BKF ENGINEERS DATE: JUNE 2011

McCarthy Building Companies, Inc.
343 Sansome Street, 14th Floor
San Francisco, California 94104
P 415 | 364-1339
F 415 | 397-5999

BKF ENGINEERS | SURVEYORS | PLANNERS
255 SHORELINE DRIVE, SUITE 200
REDWOOD CITY, CA 94065
PHONE: (650) 482-6300
FAX: (650) 482-6399

REGISTERED PROFESSIONAL ENGINEER RICHARD N.T. HAGA No. C043971 CIVIL STATE OF CALIFORNIA

IDENTIFICATION STAMP
DIV. OF THE STATE ARCHITECT
OFFICE OF REGULATION SERVICE
APPL #: 01-110097
AC. ____ FLS ____ SS ____
DATE ____
FILE NUMBER:

This and all other project documents and all ideas, arrangements and plans indicated or represented by these documents are and shall remain the property of McCarthy Building Companies, Inc. (MBC), KH Architects (KH) and LPA Inc. (LPA) and cannot be lawfully used in whole or in part for any project or purpose except as described in the contractual agreement between McCarthy and the District. LPA hereby gives formal notice that any such project document use, reproduction or modification (misuse) is not only unlawful but automatically binds all parties involved with misuse to fully indemnify and defend LPA and LPA's Consultants to the maximum extent permitted by law against any claims, losses or liabilities arising from or in any way connected to document misuse. Project documents describe design intent of work and are not a representation of as-built or existing conditions. LPA and LPA's Consultants make no representations concerning the accuracy of documents and are not responsible for any discrepancies between project documents and the existing conditions.

© Copyright 2008

College of San Mateo
Site Package
San Mateo, CA

Developed for
San Mateo County Community College District

Revision	Description	Date
	DSA SUBMITTAL	19 SEPT 2008
	DSA FINAL	09 APRIL 2009
	PROJECT RECORD DRAWING	JUNE 2011

Job. No.	27082.30
Date	02 APRIL 2009
Drawn by	MD, JT
Checked by	RH
Scale	1"=20'

UTILITY PLAN

C6.04